



FED. ROAD DIS. NO.	STATE	FED. AID PROJ. NO.	FISCAL YEAR	SHEET NO.	TOTAL SHEETS
HAWAII	HAW.	NH-083-1(26)	1994	ADD. 191	238

Note:
Contractor shall start removal of soft soil and construction of MSERW in Valley No. 1 as soon as Notice to Proceed is issued to allow for removal of soft soil, construction of MSERW and a minimum 6 month settlement period before roadway and utilities are constructed.

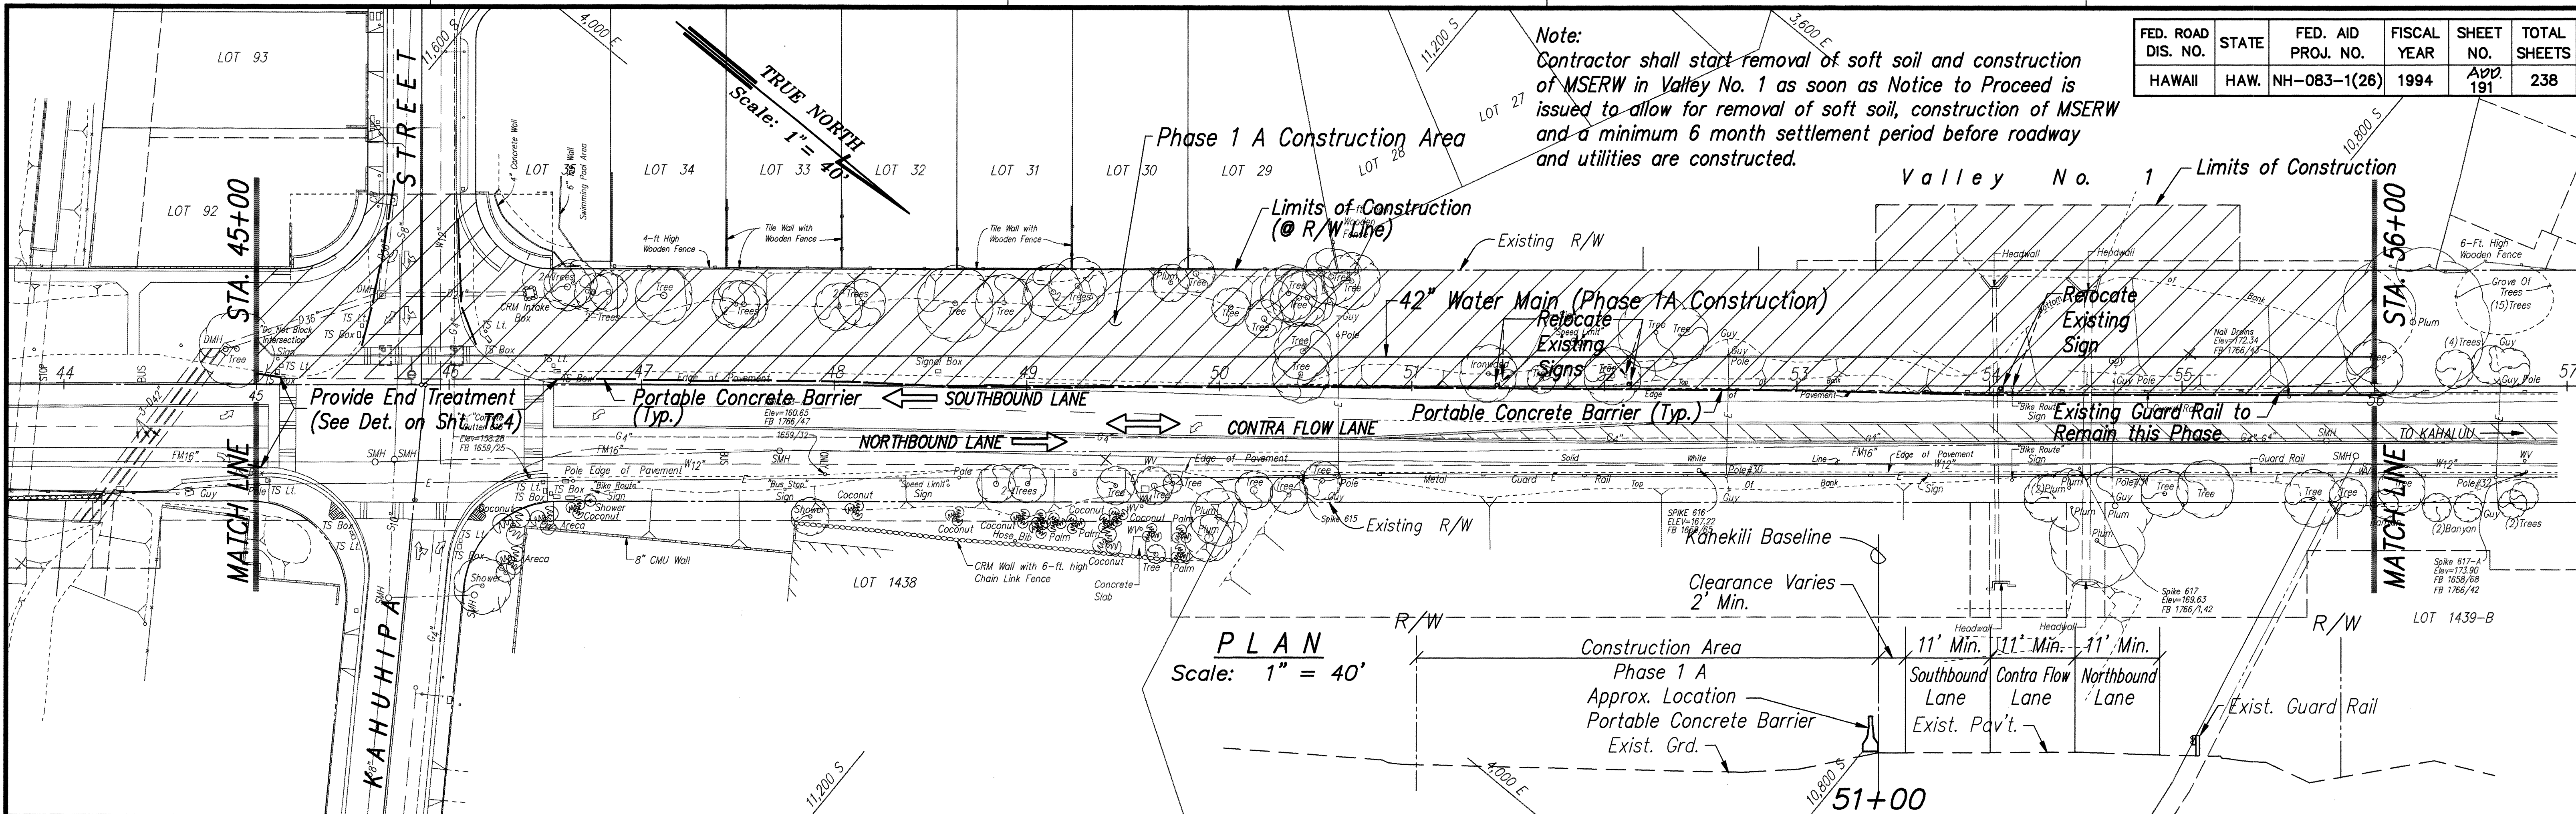

PLAN
Scale: 1" = 40'

Note:
Contractor shall start construction of MSERW in Valley No. 2 as soon as Notice of Proceed is issued to allow for the construction of MSERW and a minimum 6 month settlement period before roadway and utilities are constructed.

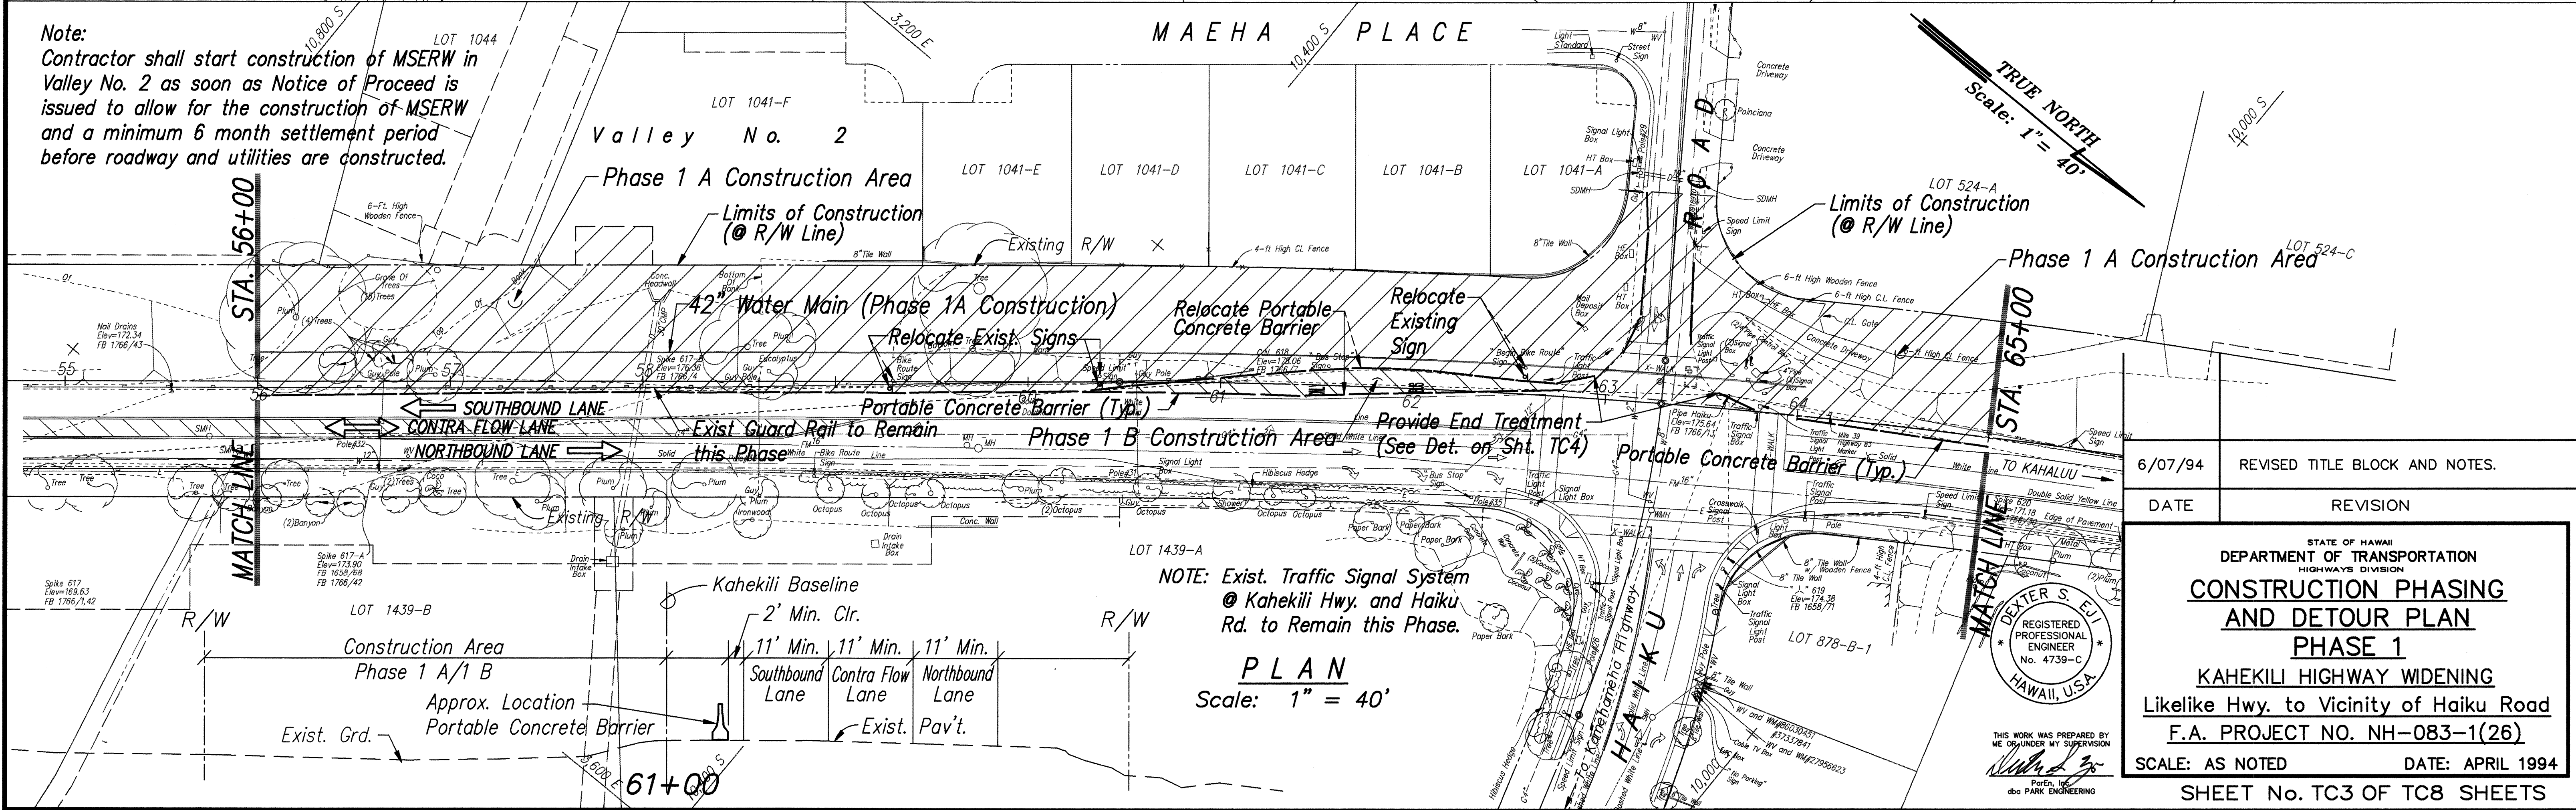

NOTE: Exist. Traffic Signal System @ Kahekili Hwy. and Haiku Rd. to Remain this Phase.

PLAN
Scale: 1" = 40'

6/07/94	REVISED TITLE BLOCK AND NOTES.
DATE	REVISION

STATE OF HAWAII
DEPARTMENT OF TRANSPORTATION
HIGHWAYS DIVISION

**CONSTRUCTION PHASING
AND DETOUR PLAN
PHASE 1**

KAHEKILI HIGHWAY WIDENING
Likelike Hwy. to Vicinity of Haiku Road
F.A. PROJECT NO. NH-083-1(26)

SCALE: AS NOTED DATE: APRIL 1994

SHEET No. TC3 OF TC8 SHEETS

AS-BUILT ADD. 191

DEXTER S. EDI
REGISTERED PROFESSIONAL ENGINEER
No. 4739-C
HAWAII, USA


THIS WORK WAS PREPARED BY
ME UNDER MY SUPERVISION
DATE: 6/21/94
PREF. 10/94
dca PARK ENGINEERING

DATE	6/21/94
SURVEY PLOTTED BY	...
DRAWN BY	...
TRACED BY	...
QUANTITIES BY	...
CHECKED BY	...
ORIGINAL PLAN	...
NO.	...



ROTATED: 129° 28' 30"
BASE PT. 0.0

LIB. STATE DOT/HAKEKILI ADDENDUM
CONSPR 9/06/93 FMS 6/21/94 GHT


FED. ROAD DIS. NO.	STATE	FED. AID PROJ. NO.	FISCAL YEAR	SHEET NO.	TOTAL SHEETS
HAWAII	HAW.	NH-083-1(26)	1994	ADD 192	238

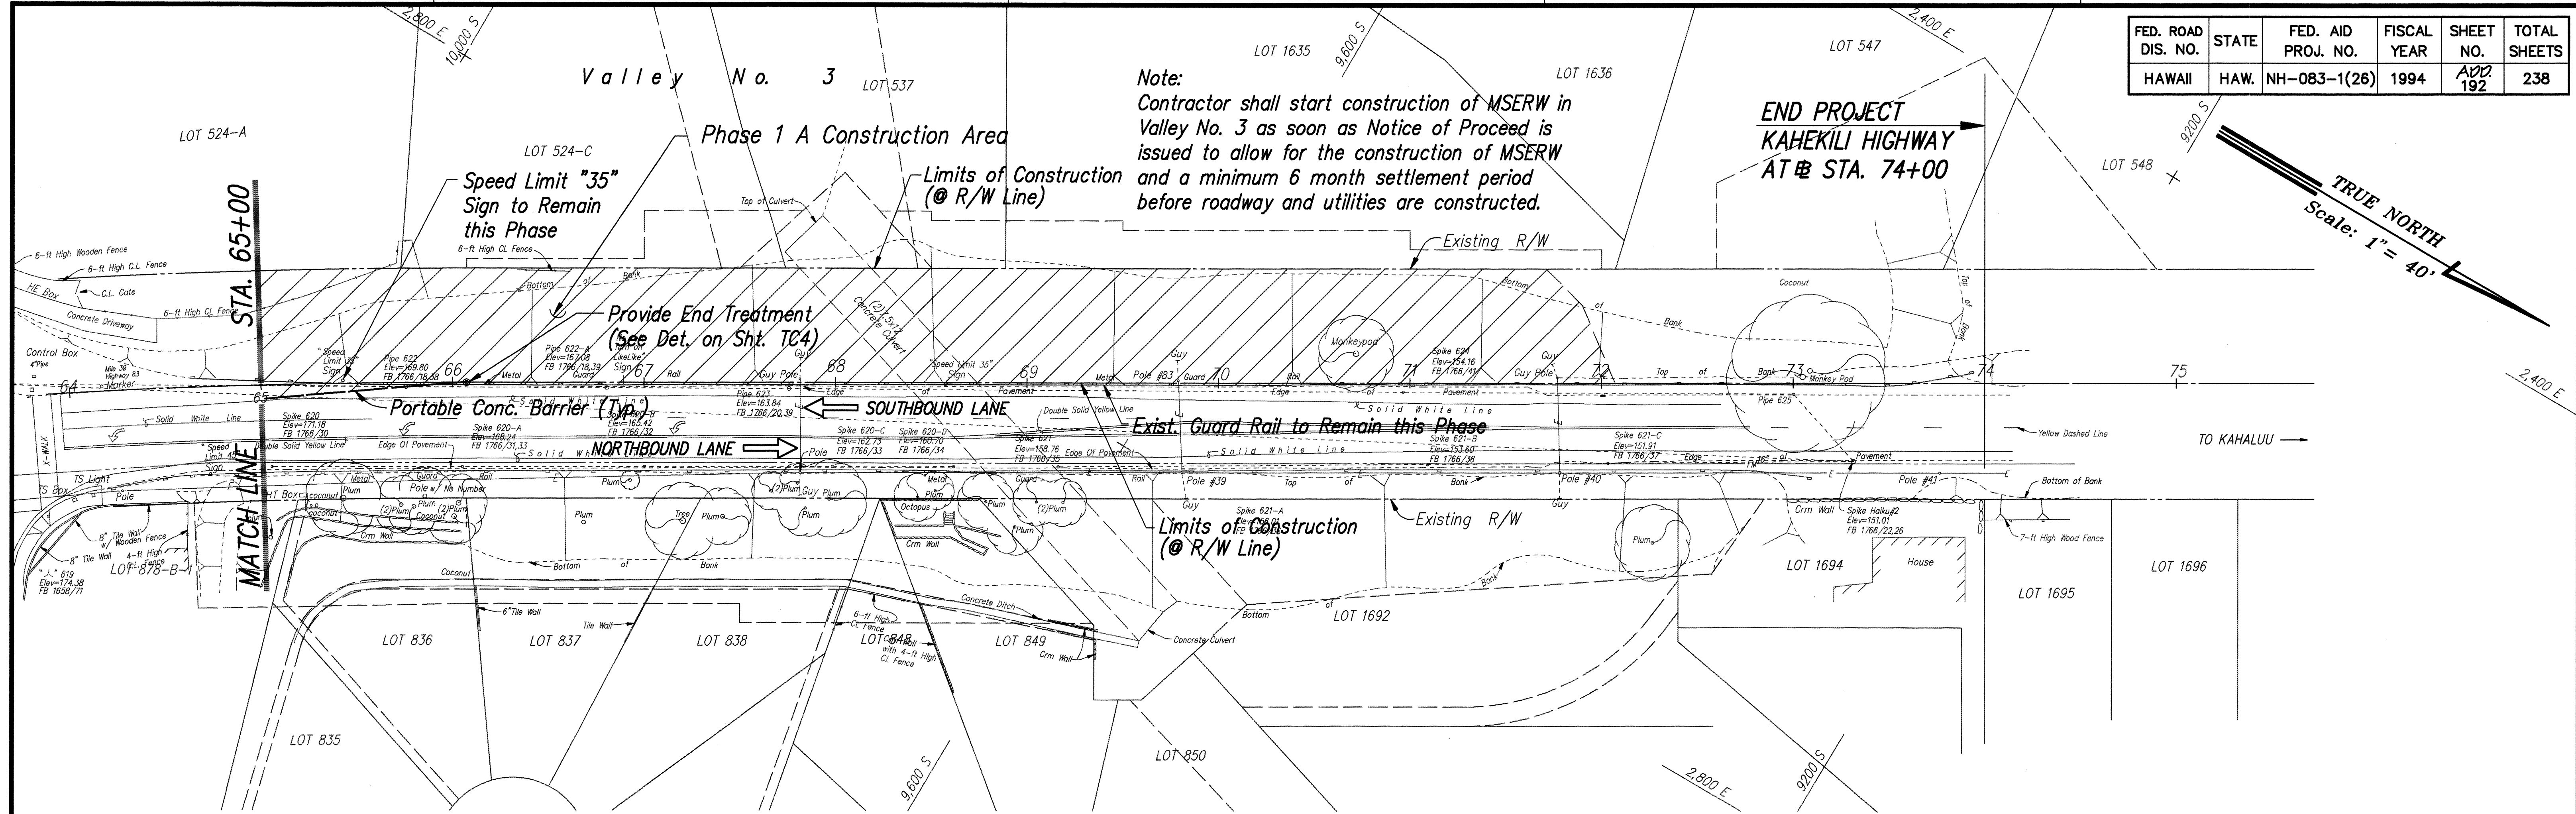

PLAN
Scale: 1" = 40'

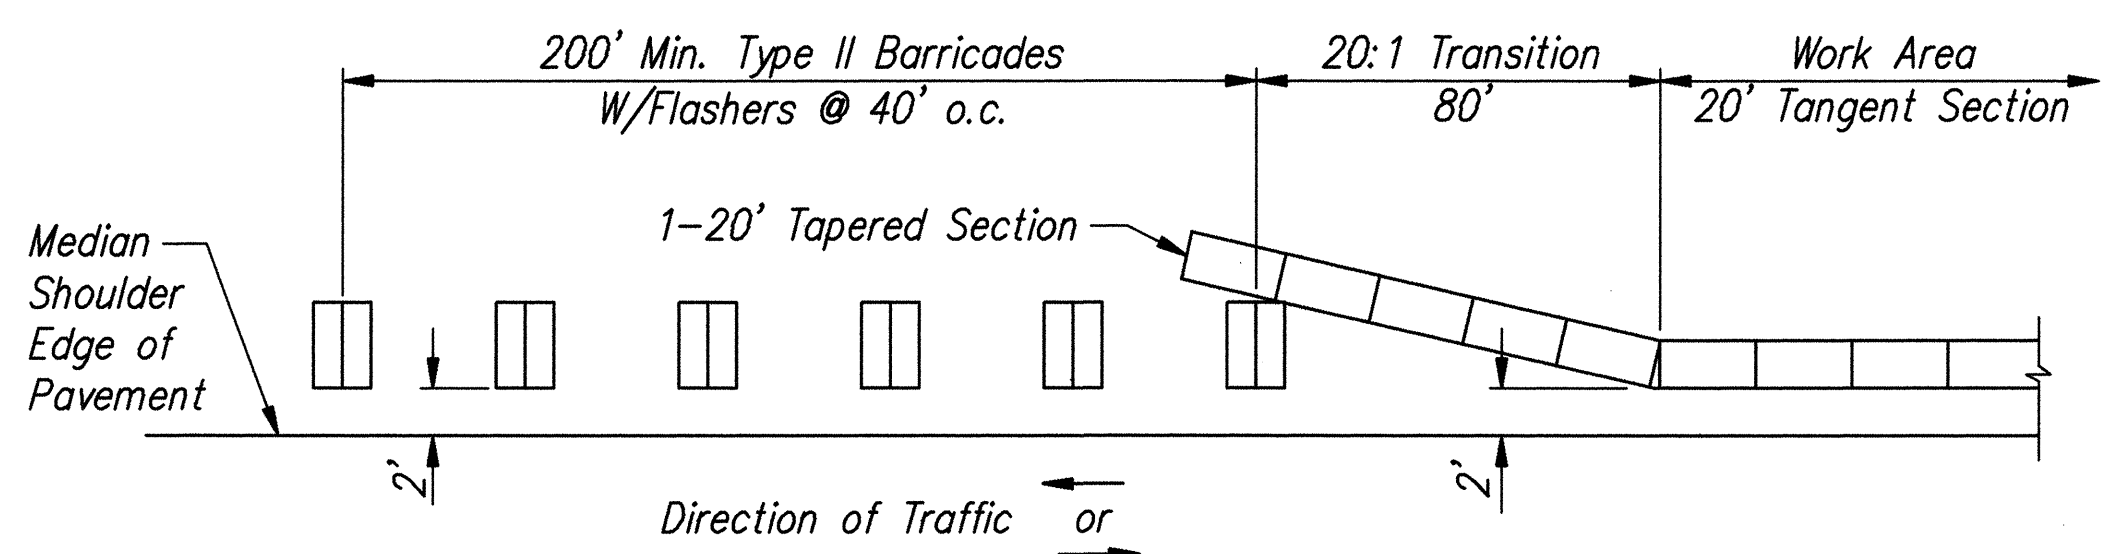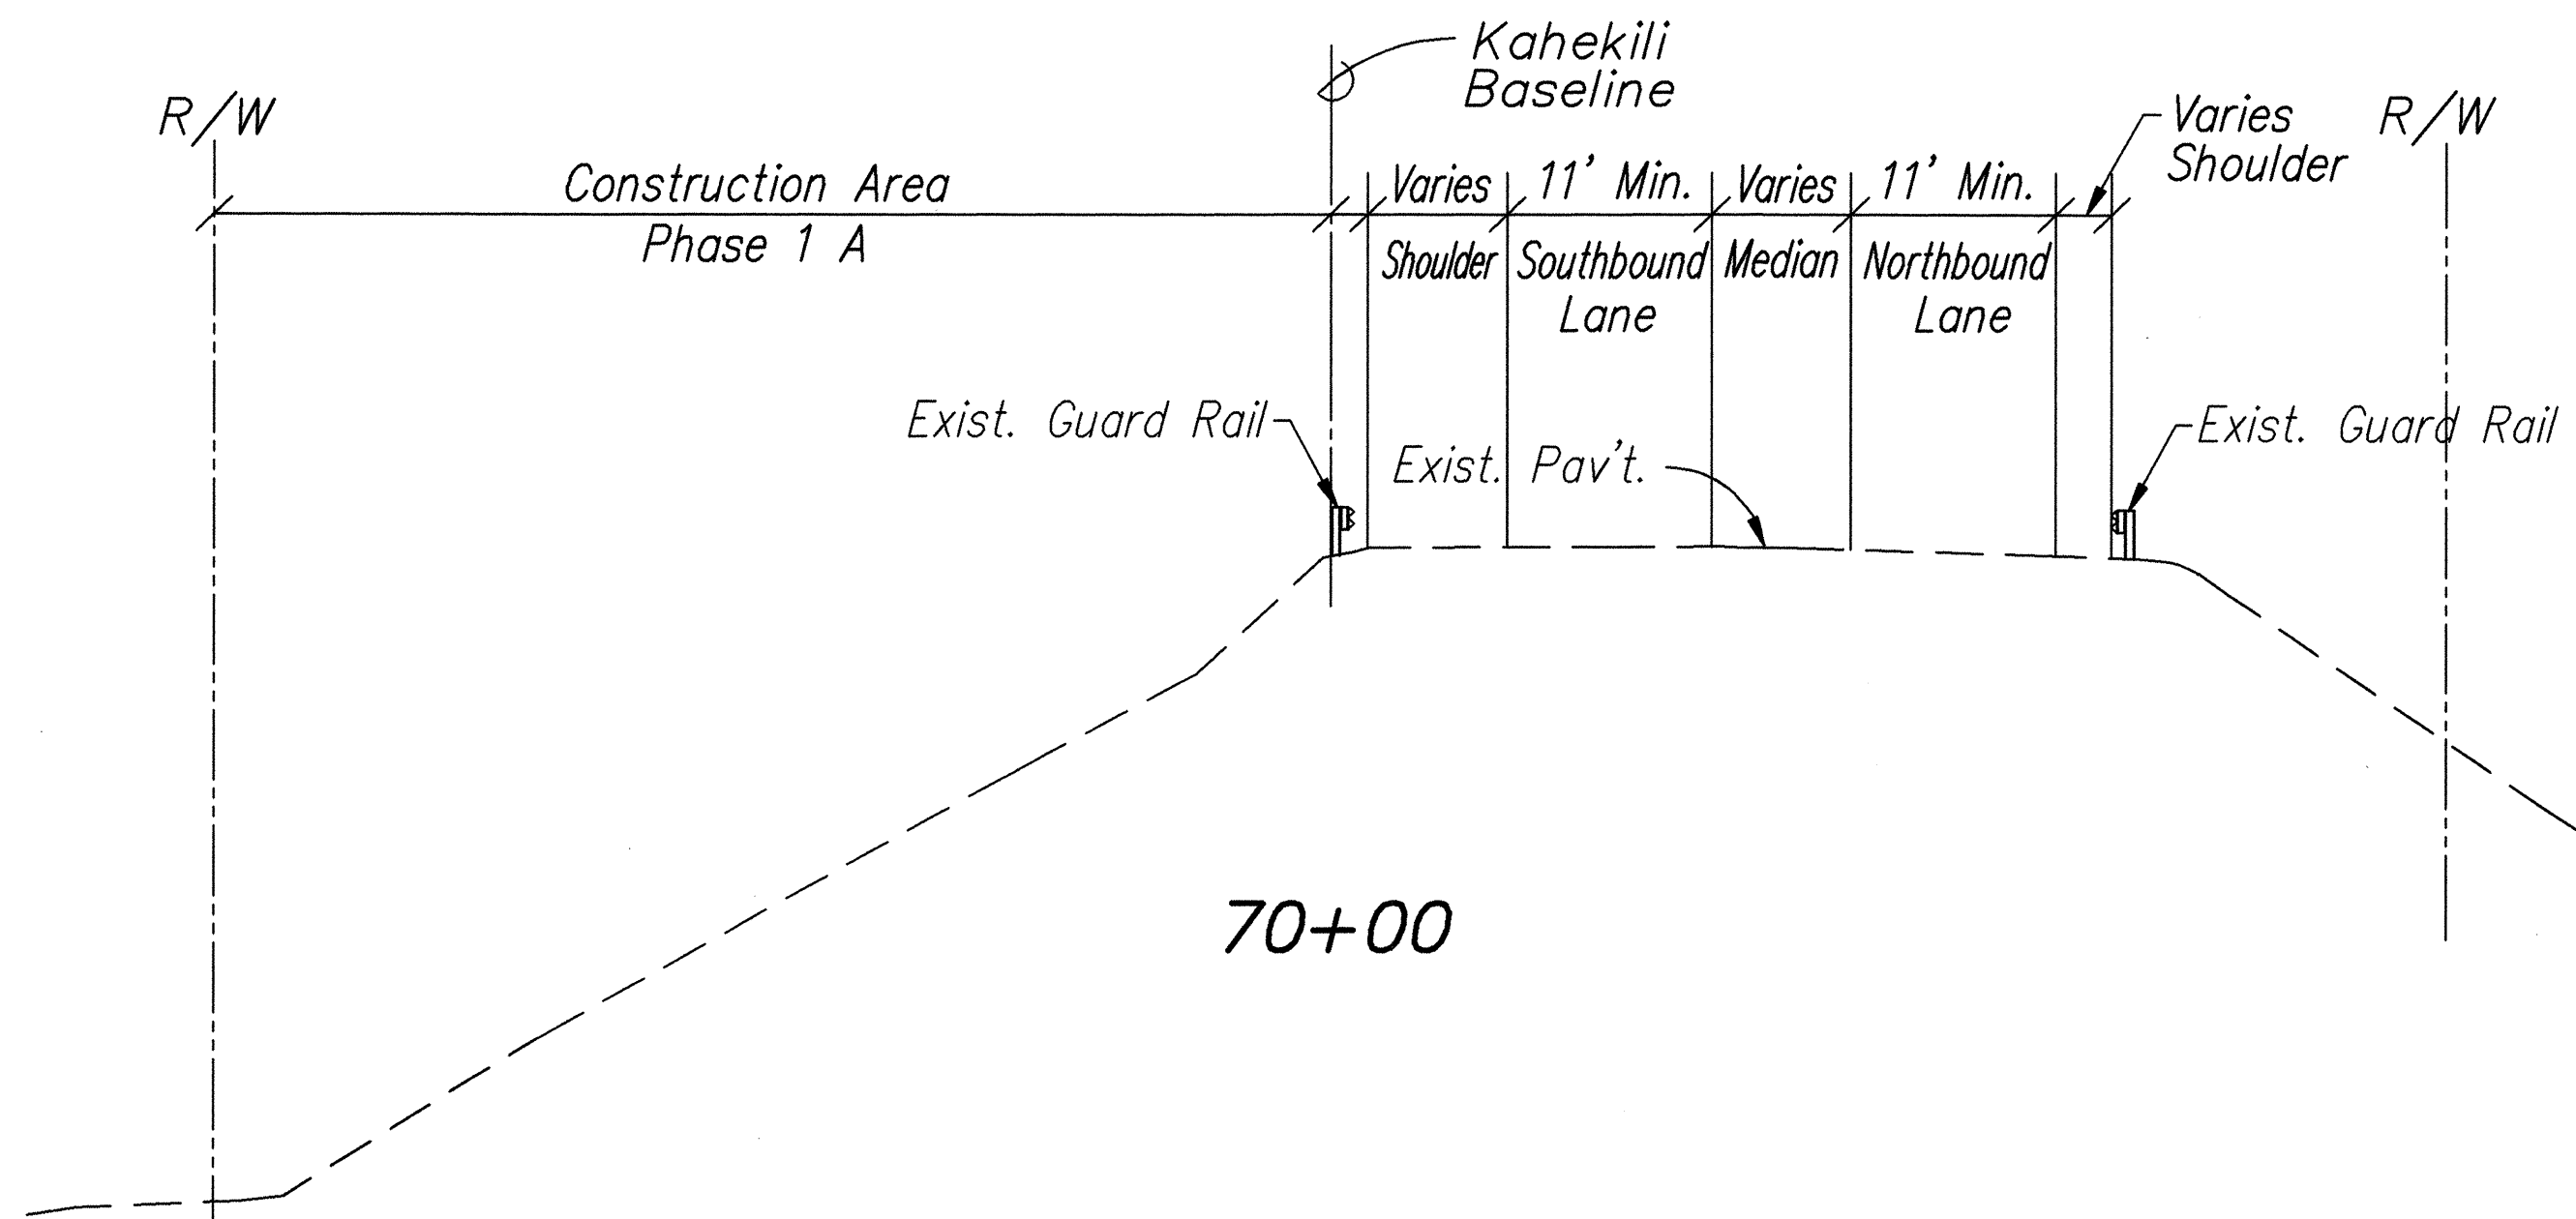

PORTABLE CONCRETE GUARD RAIL
W/TYPE II BARRICADE END TREATMENT
Not to Scale

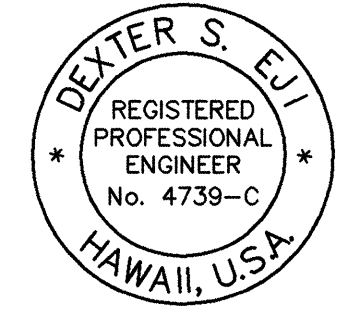

THIS WORK WAS PREPARED BY
ME OR UNDER MY SUPERVISION
[Signature]
DATE: APRIL 1994
dso PARK ENGINEERING

STATE OF HAWAII DEPARTMENT OF TRANSPORTATION HIGHWAYS DIVISION	
CONSTRUCTION PHASING AND DETOUR PLAN PHASE 1	
KAHEKILI HIGHWAY WIDENING Likelike Hwy. to Vicinity of Haiku Road F.A. PROJECT NO. NH-083-1(26)	
SCALE: AS NOTED	DATE: APRIL 1994
SHEET No. TC4 OF TC8 SHEETS	



DATE	REVISION
6/07/94	REVISED TITLE BLOCK AND NOTE.

AS-BUILT ADD. 192

DATE	REVISION
6/07/94	REVISED TITLE BLOCK AND NOTE.

ROTATED: 120° 34'
BASE PT. 0.0

FED. ROAD DIS. NO.	STATE	FED. AID PROJ. NO.	FISCAL YEAR	SHEET NO.	TOTAL SHEETS
HAWAII	HAW.	NH-083-1(26)	1994	193	238

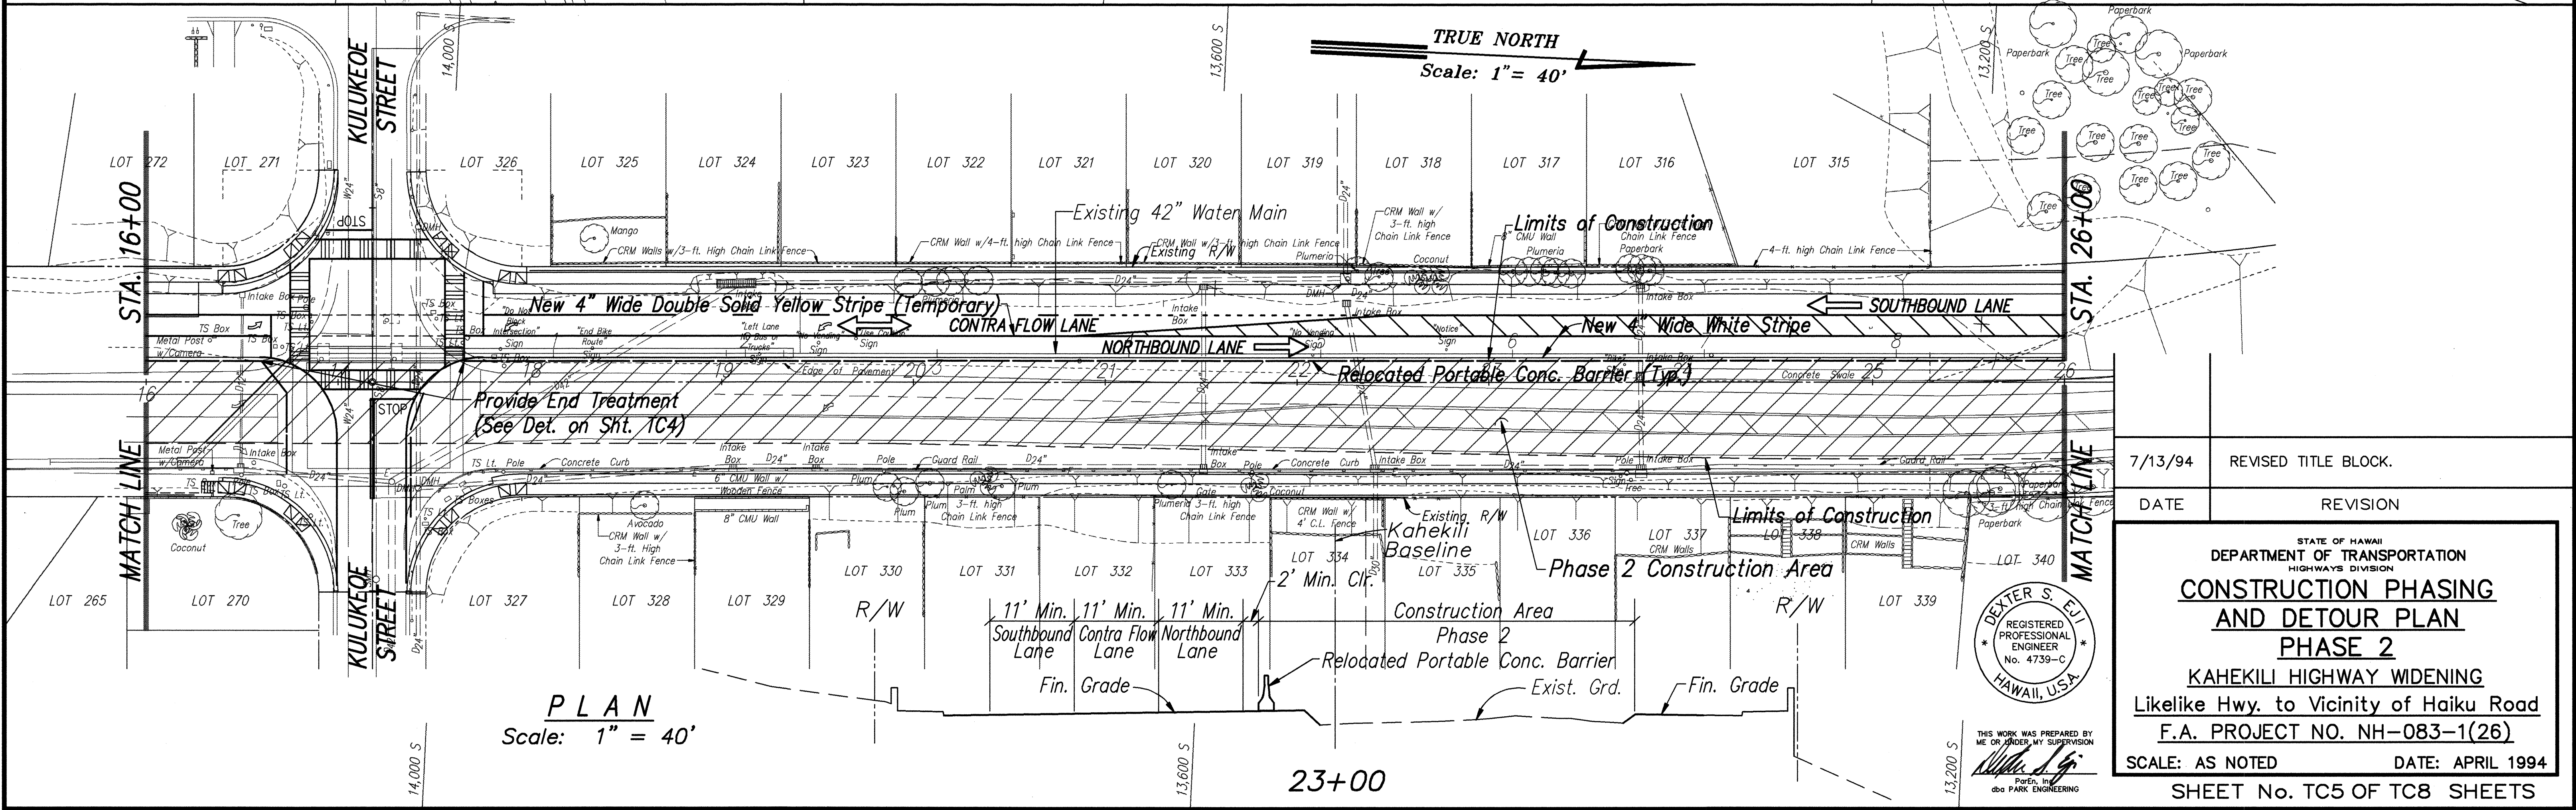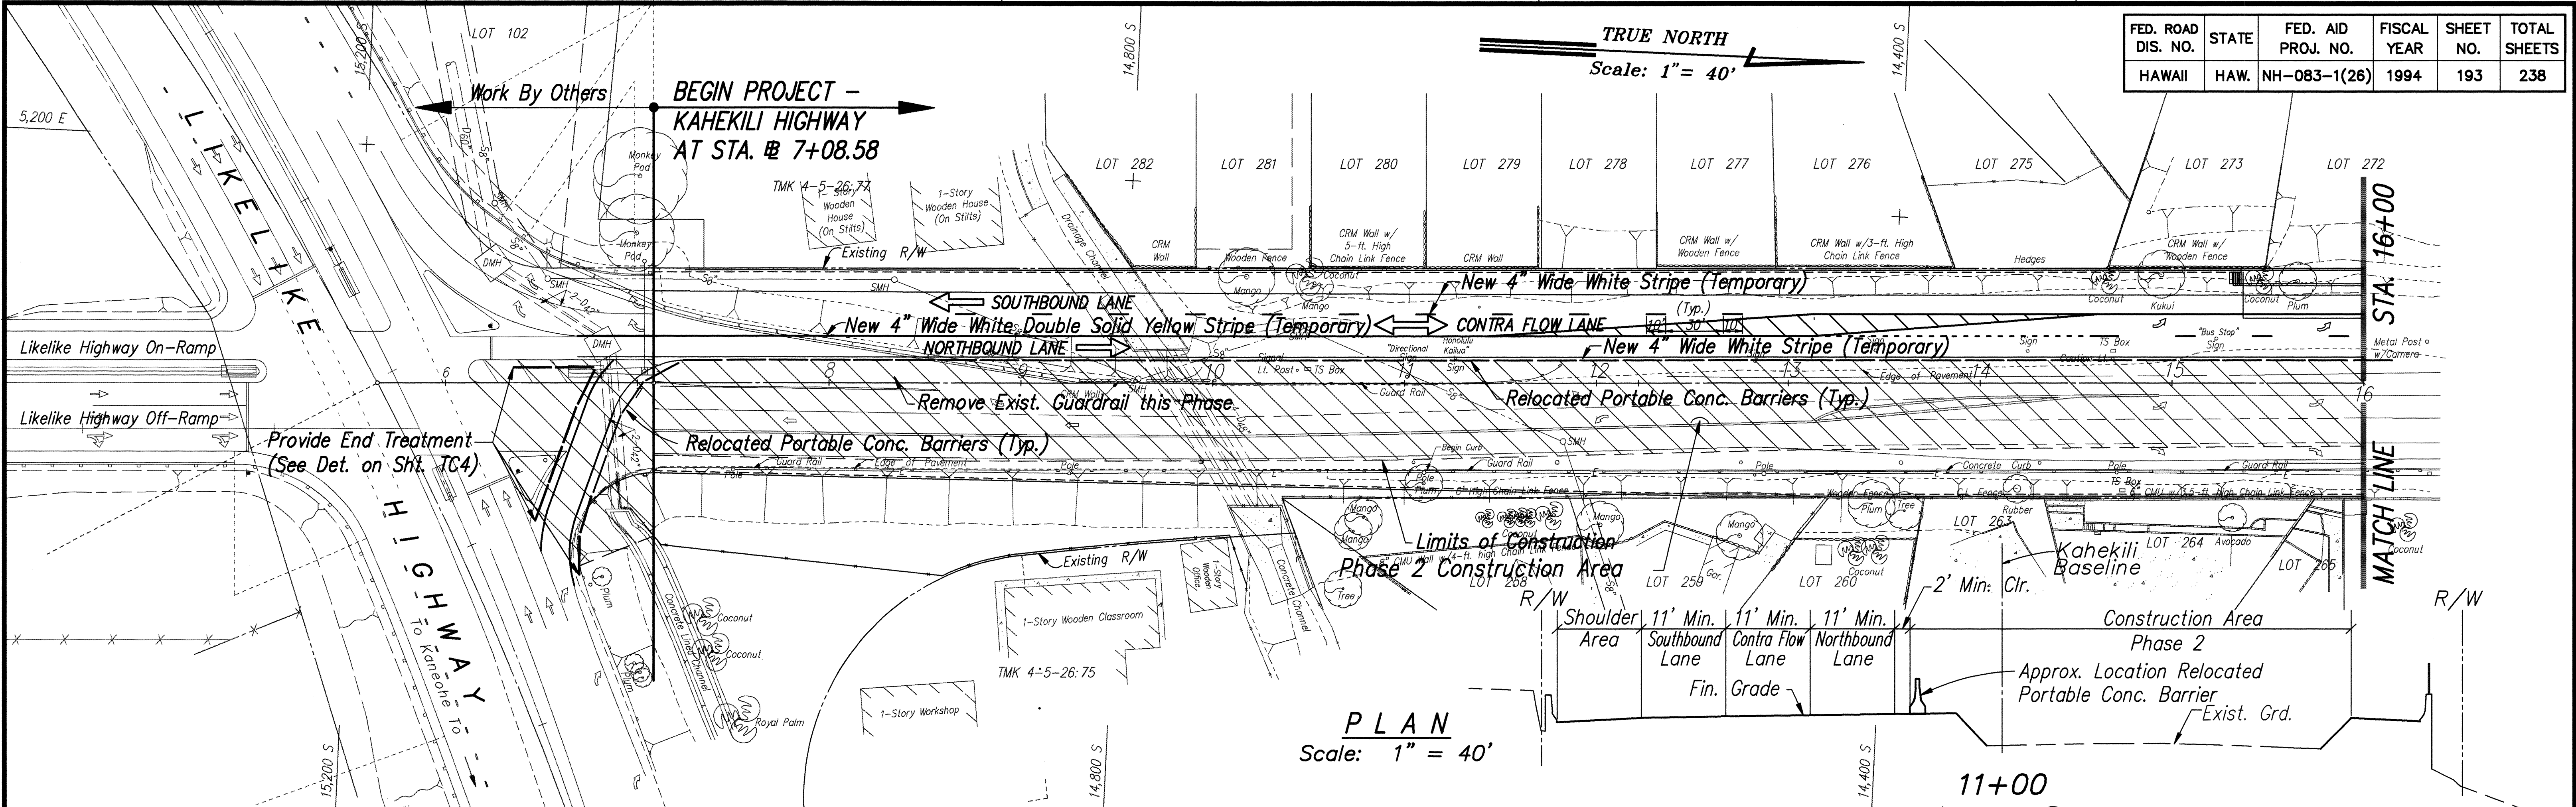

DATE	
SURVEY PLANNED BY	
DRAWN BY	
TRACED BY	
QUANTITIES BY	
CHECKED BY	
ORIGINAL PLAN	
NO.	

7/13/94
REVISI

STATE OF HAWAII
DEPARTMENT OF TRANSPORTATION
HIGHWAYS DIVISION

CONSTRUCTION PHASING
AND DETOUR PLAN
PHASE 2

KAHEKILI HIGHWAY WIDENING
Likeli Hwy. to Vicinity of Haiku Road
F.A. PROJECT NO. NH-083-1(26)

SCALE: AS NOTED
DATE: APRIL 1994



SHEET No. TC5 OF TC8 SHEETS

THIS WORK WAS PREPARED BY ME OR UNDER MY SUPERVISION

Per En. In chg
PARK ENGINEERING

LIB: STATE DOT/KAHEKILI ADDENDUM
CONSPSR 9/06/93 FMS 7/13/94 GHT

FED. ROAD DIS. NO.	STATE	FED. AID PROJ. NO.	FISCAL YEAR	SHEET NO.	TOTAL SHEETS
HAWAII	HAW.	NH-083-1(26)	1994	194	238

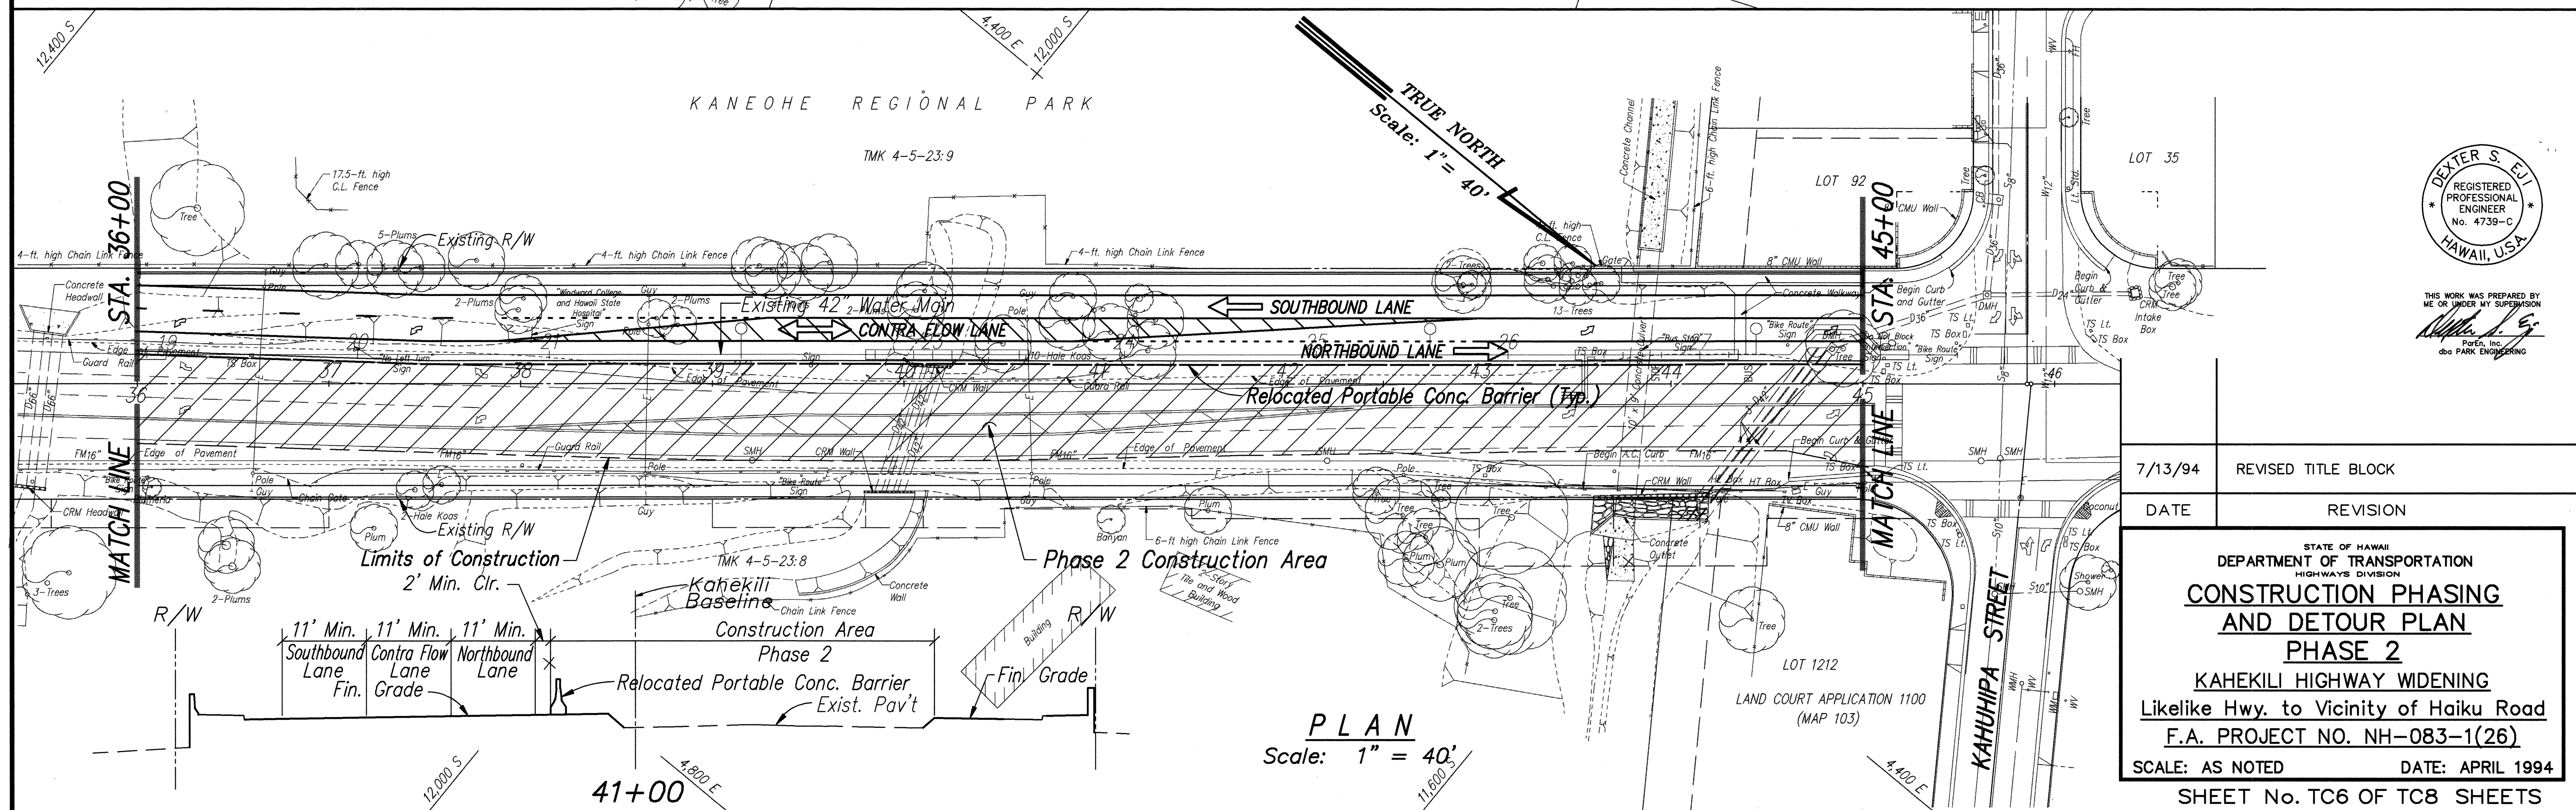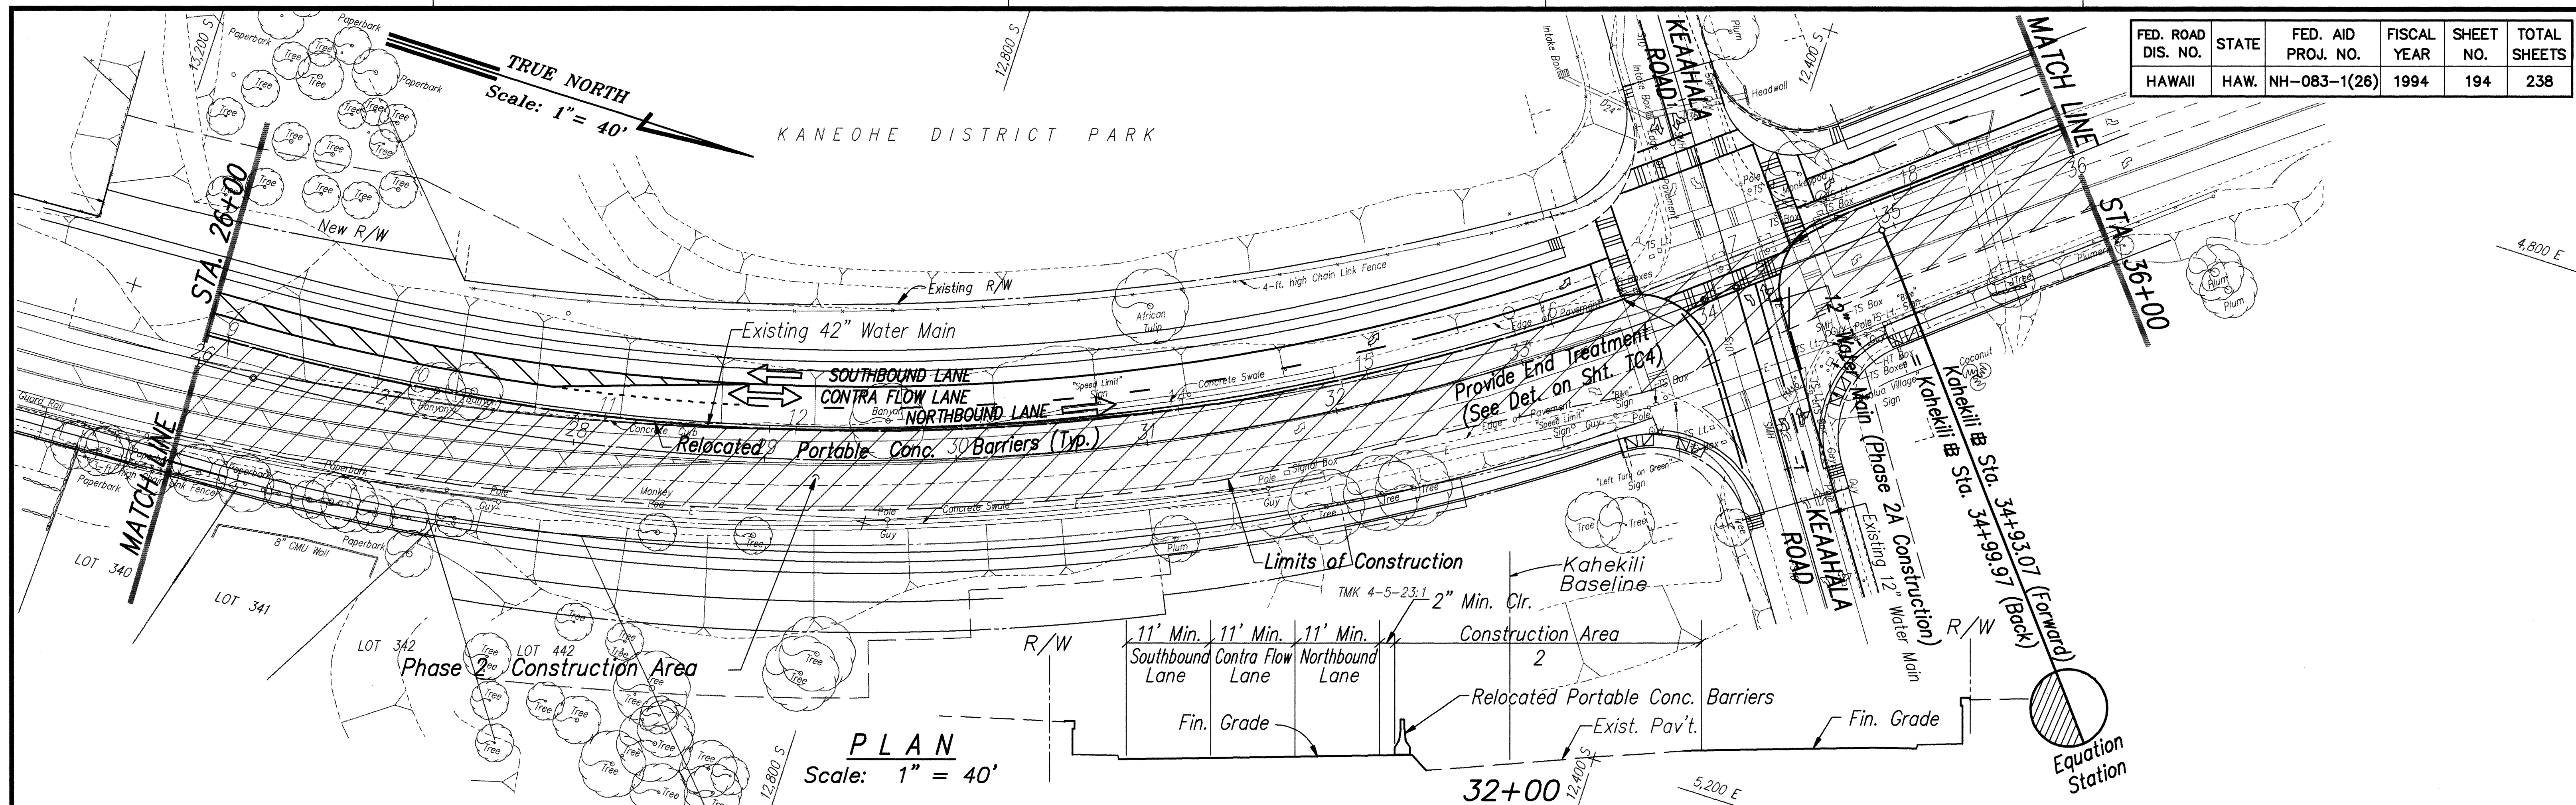

A circular professional engineer seal for Dexter S. Eji. The outer ring contains the name "DEXTER S. EJI" at the top and "HAWAII, U.S.A." at the bottom, separated by two small stars. The inner circle contains the text "REGISTERED PROFESSIONAL ENGINEER" and the number "No. 4739-C".

THIS WORK WAS PREPARED BY
ME OR UNDER MY SUPERVISION

Arthur L. E.

ParEn, Inc.
200 PARK ENGINEERING

7/13/94	REVISED TITLE BLOCK
DATE	REVISION

STATE OF HAWAII
DEPARTMENT OF TRANSPORTATION
HIGHWAYS DIVISION

CONSTRUCTION PHASING
AND DETOUR PLAN
PHASE 2

KAHEKILI HIGHWAY WIDENING
Likelike Hwy. to Vicinity of Haiku Road
F.A. PROJECT NO. NH-083-1(26)

SCALE: AS NOTED DATE: APRIL 1994



SHEET No. TC6 OF TC8 SHEETS

AS-BUILT 194 R

ORIGINAL PLAN	SURVEY PLOTTED BY _____	DATE _____
NOTEBOOK	DRAWN BY _____	_____
	TRACED BY _____	_____
	DESIGNED BY _____	_____
	QUANTITIES BY _____	_____
No. _____	CHECKED BY _____	_____

B: STATE\DOT\KAHEKILI\ADDENDUM
 ONSTR6R 9/06/93 FMS 7/13/94 GHT

FED. ROAD DIS. NO.	STATE	FED. AID PROJ. NO.	FISCAL YEAR	SHEET NO.	TOTAL SHEETS
HAWAII	HAW.	NH-083-1(26)	1994	195	238

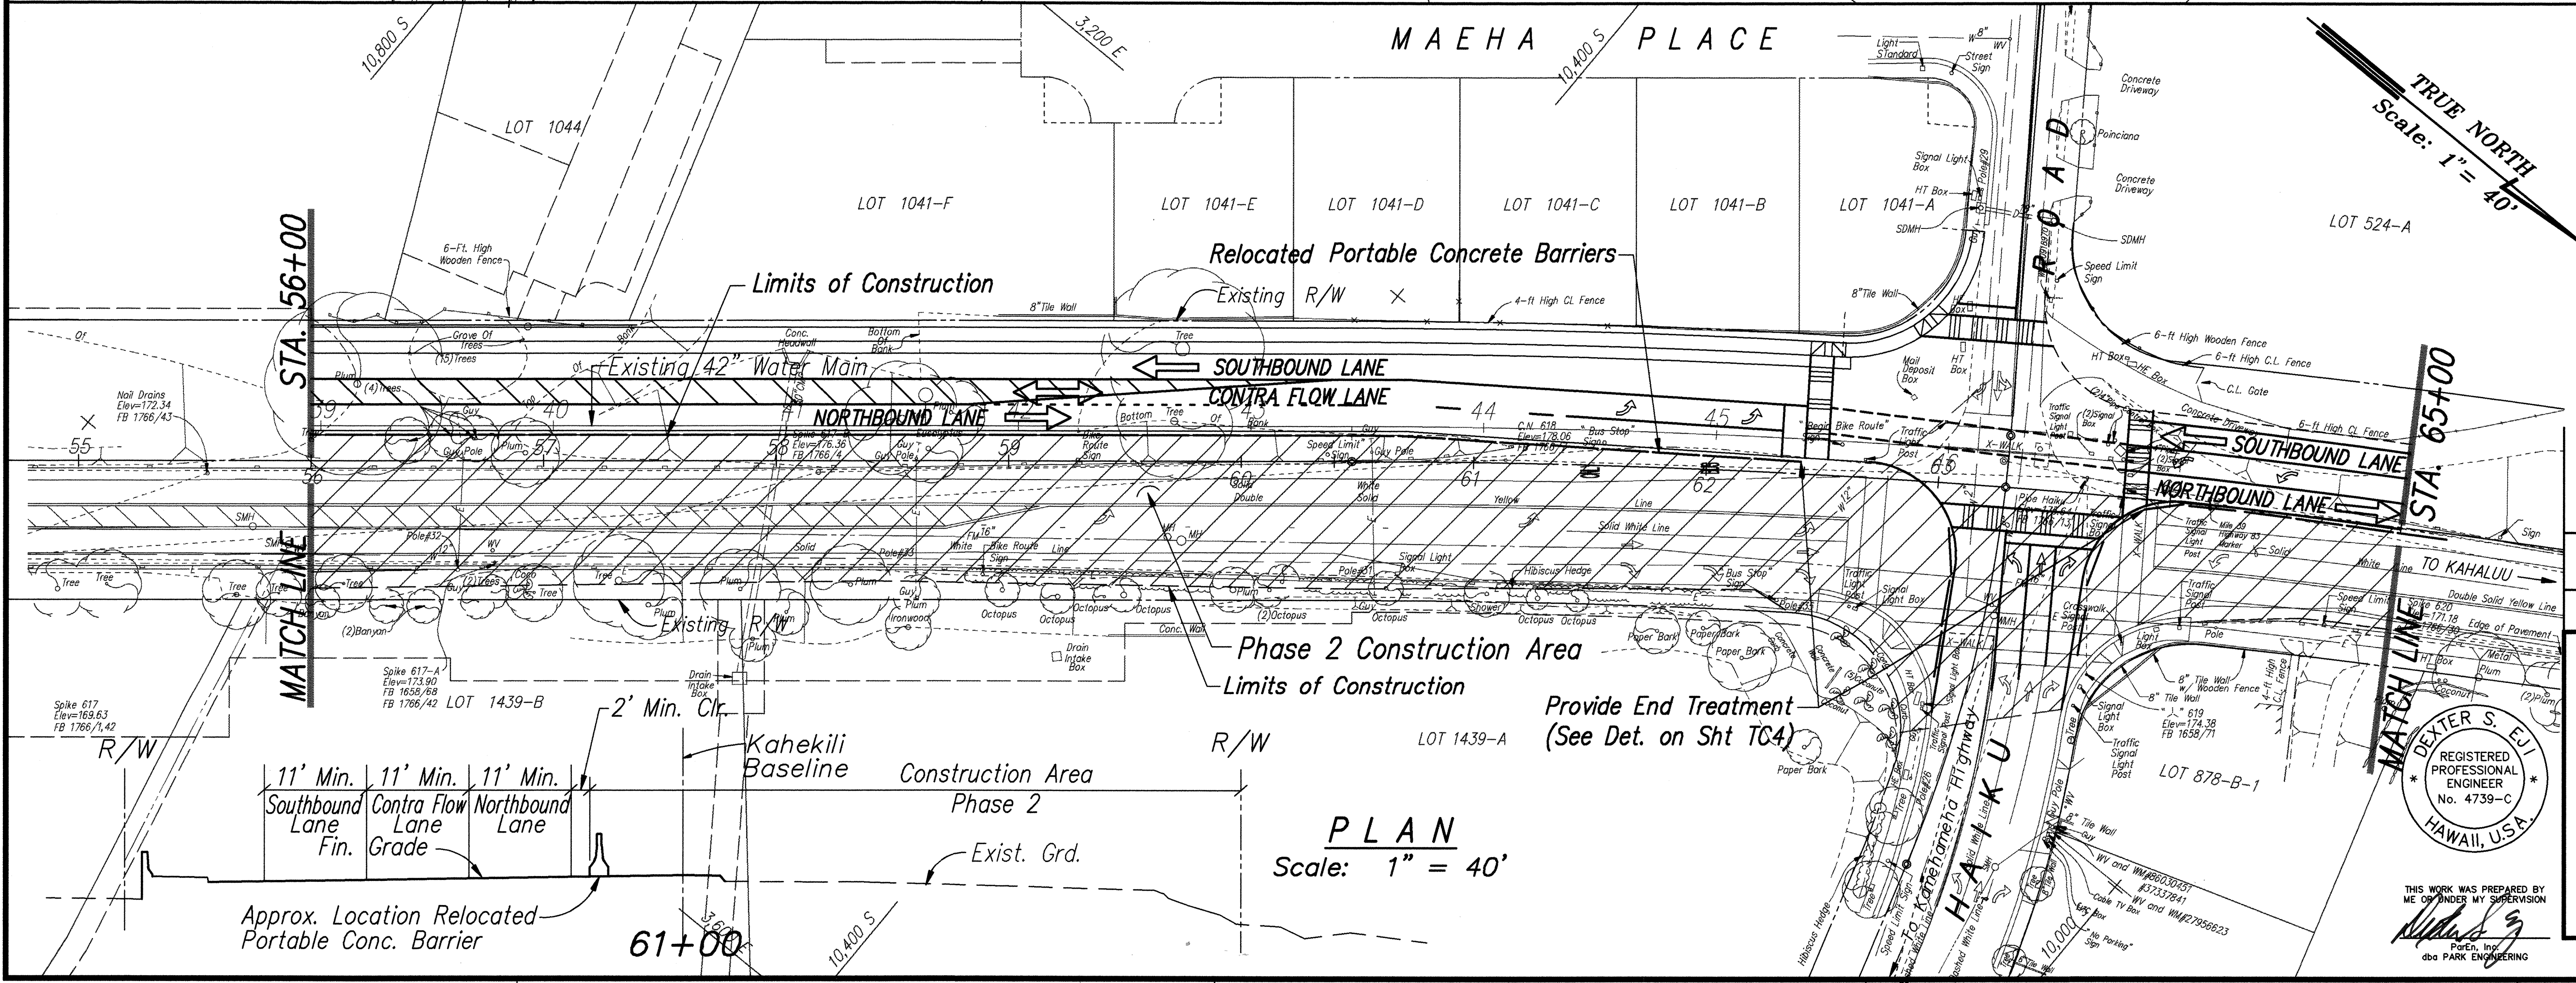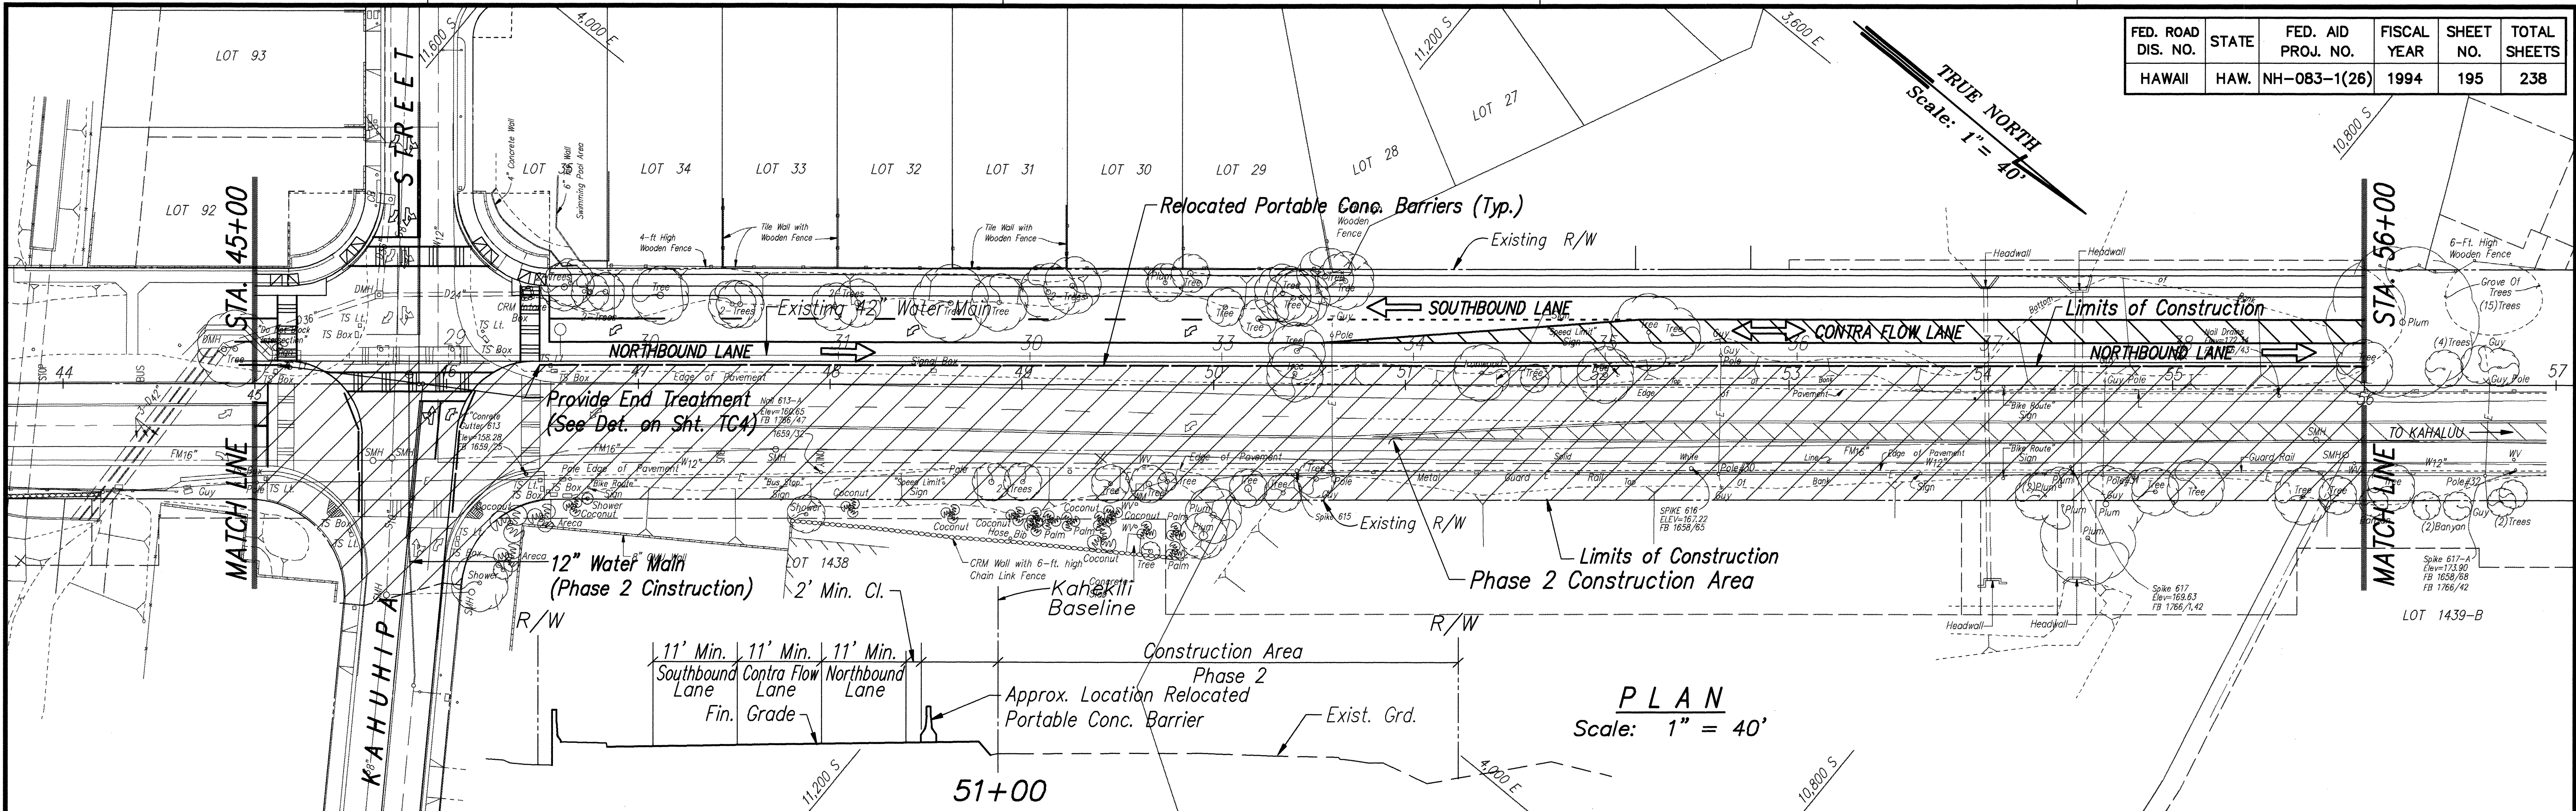

7/13/94	REVISED TITLE BLOCK.
DATE	REVISION

STATE OF HAWAII
DEPARTMENT OF TRANSPORTATION
HIGHWAYS DIVISION

**CONSTRUCTION PHASING
AND DETOUR PLAN
PHASE 2**

KAHEKILI HIGHWAY WIDENING
Likelike Hwy. to Vicinity of Haiku Road
F.A. PROJECT NO. NH-083-1(26)

SCALE: AS NOTED DATE: APRIL 1994

SHEET No. TC7 OF TC8 SHEETS

AS-BUILT 195 R

REGISTERED PROFESSIONAL ENGINEER
No. 4739-C
HAWAII, U.S.A.

DEITER S. EJI

THIS WORK WAS PREPARED BY ME OR UNDER MY SUPERVISION
DATE: 7/13/94
PARK, INC.
dba PARK ENGINEERING

SURVEY PLOTTED BY	DATE
DRAWN BY	
TRACED BY	
QUANTITIES BY	
CHECKED BY	
ORIGINAL PLAN	No.
NOTEBOOK	

ROTATED: 128° 28' 30"
BASE PT. 0.0

LIB: STATE DOT/KAHEKILI/ADDENDUM
CONSTR/PR 9/05/93 FMS 7/13/94 GHT

