



FED. ROAD DIS. NO.	STATE	FED. AID PROJ. NO.	FISCAL YEAR	SHEET NO.	TOTAL SHEETS
HAWAII	HAW.	NH-083-1(26)	1994	ADD 8	238

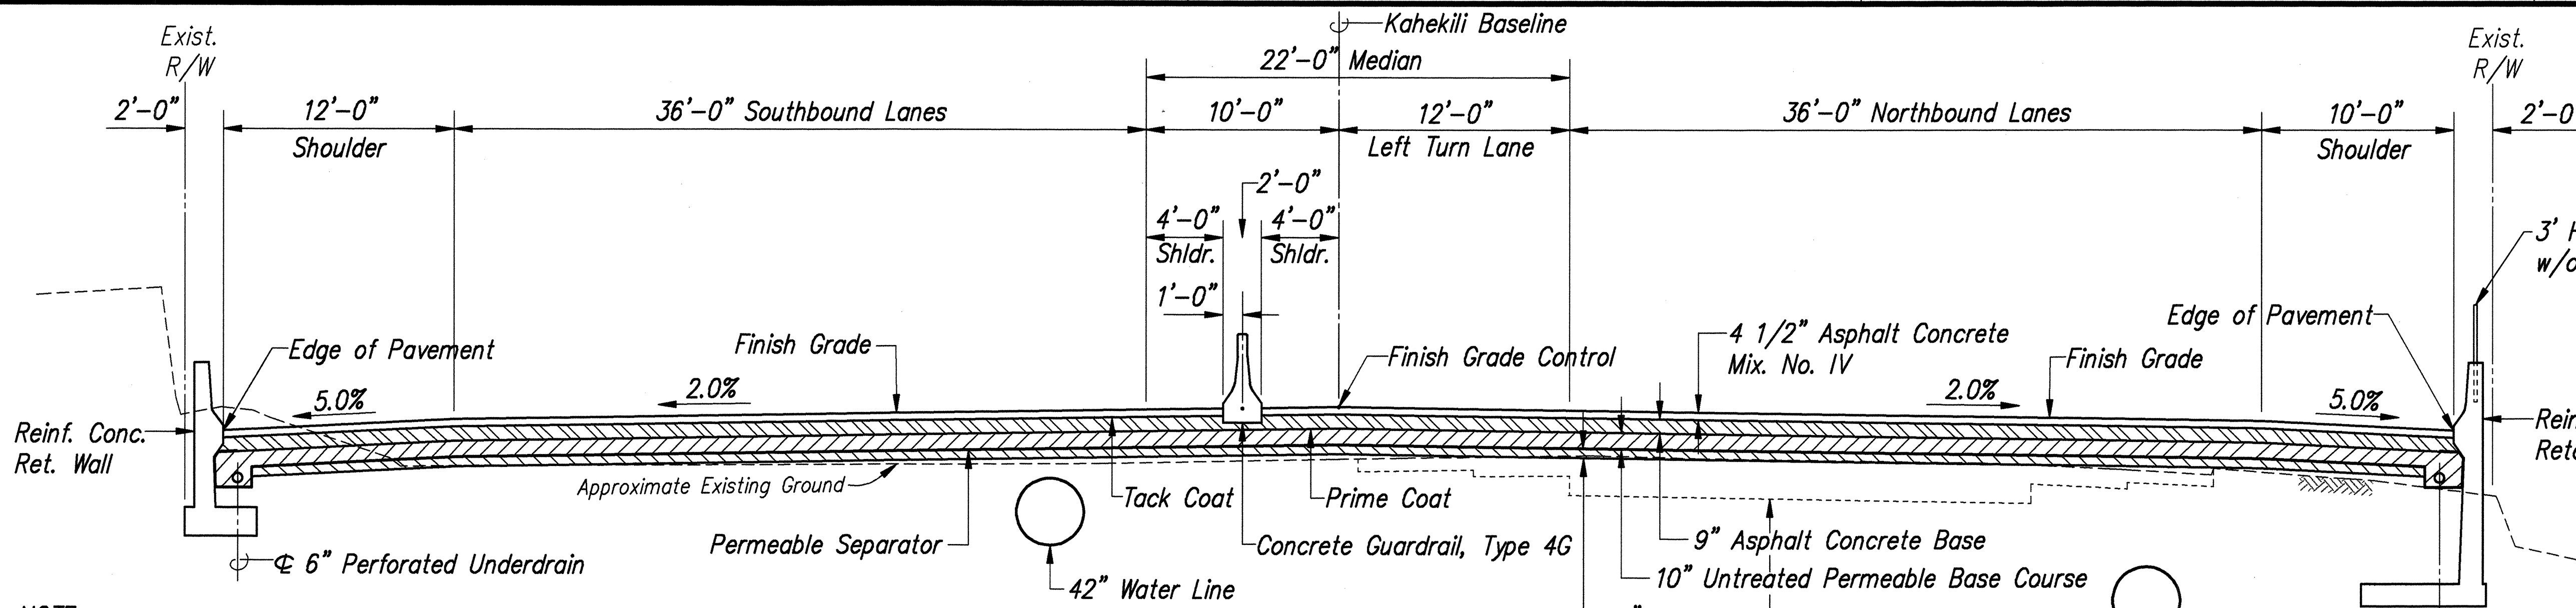

NOTE:
The Contractor shall pave the last lift (1 1/2-inch) of Asphalt Concrete Pavement Mix No. IV on the Northbound Lanes, Southbound Lanes and Shoulder between Likelike Highway and Sta. 72+00 after Phase 2 Construction is completed or when directed by the Engineer. Tack Coat shall not be measured for payment but shall be considered incidental to Item 401.0400 Asphalt Concrete Pavement Mix No. IV of the proposal and no payment shall be made.


TANGENT AND LEFT TURN SECTION
(Station 14+30 to Kulukeoe St.)
Scale: 1" = 5'-0"

Note: Drain Line Section not shown.

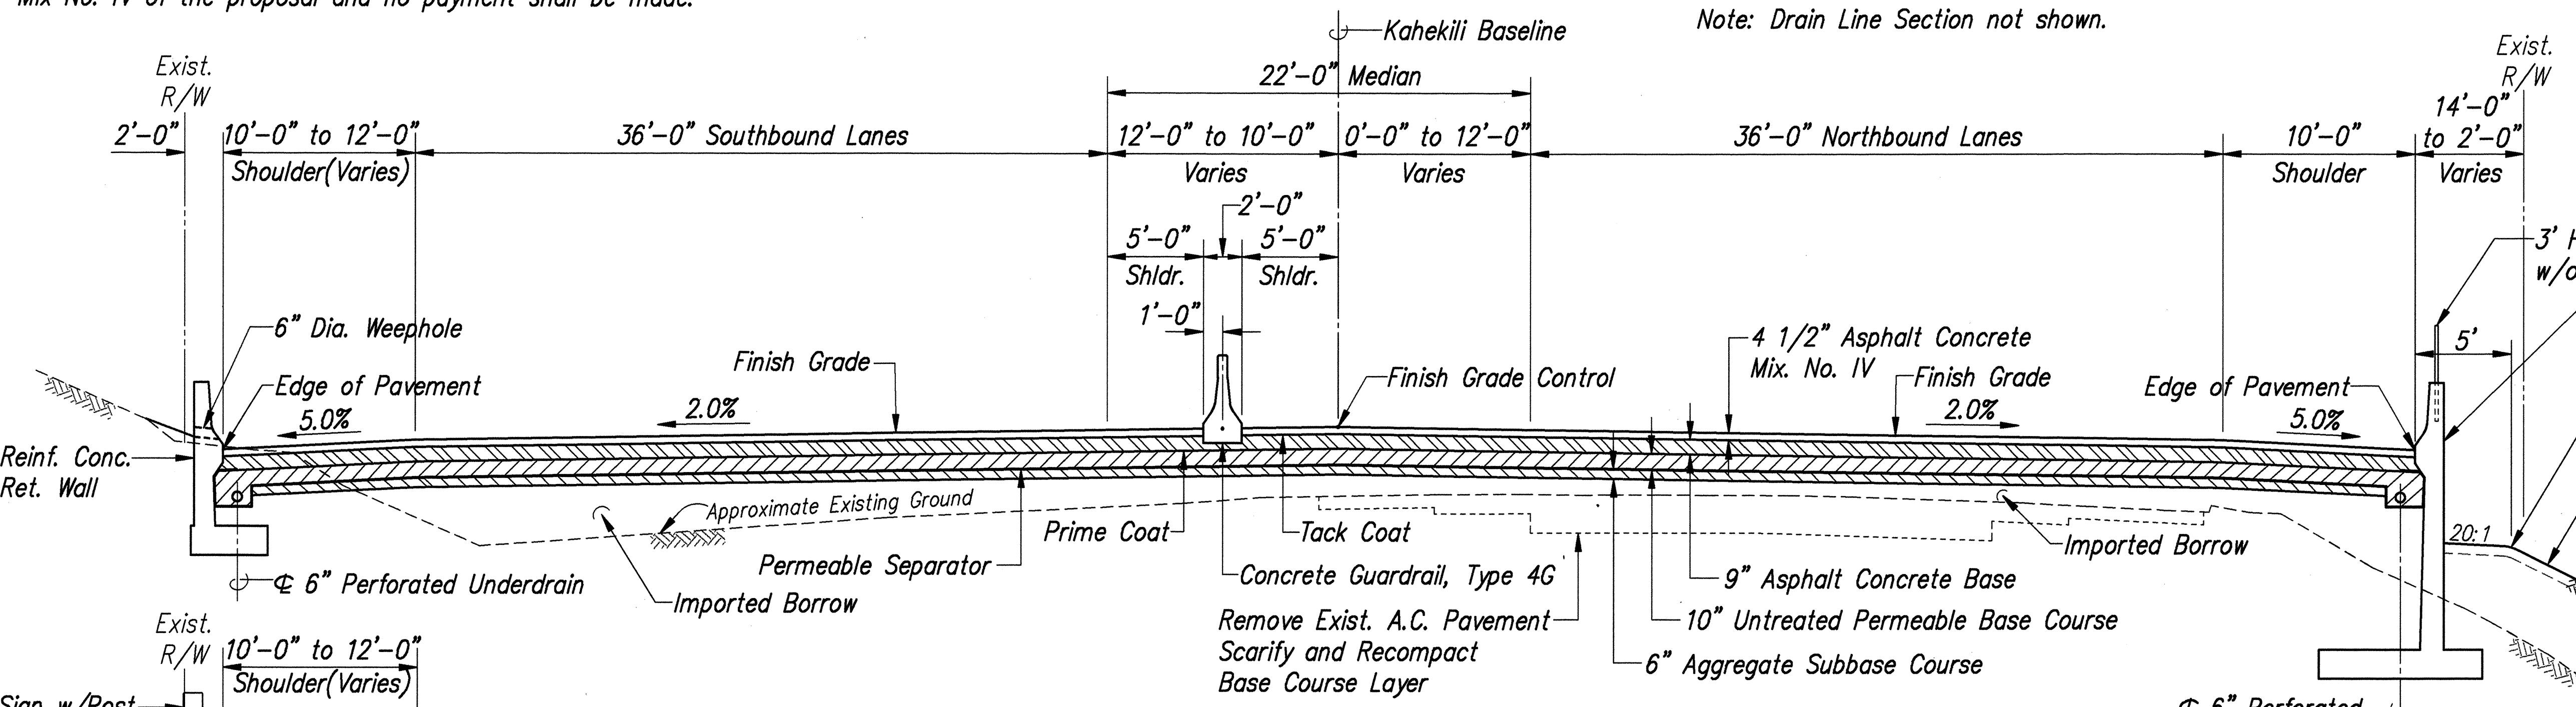

TANGENT SECTION
(Station 7+08.58 to Station 12+60)
Scale: 1" = 5'-0"

NOTE:
Where Structure Backfill for R.C. Wall and MSERW happen to be the same area with roadway embankment, payment will be made for only one material, not for both. This note applies to all applicable sheets.

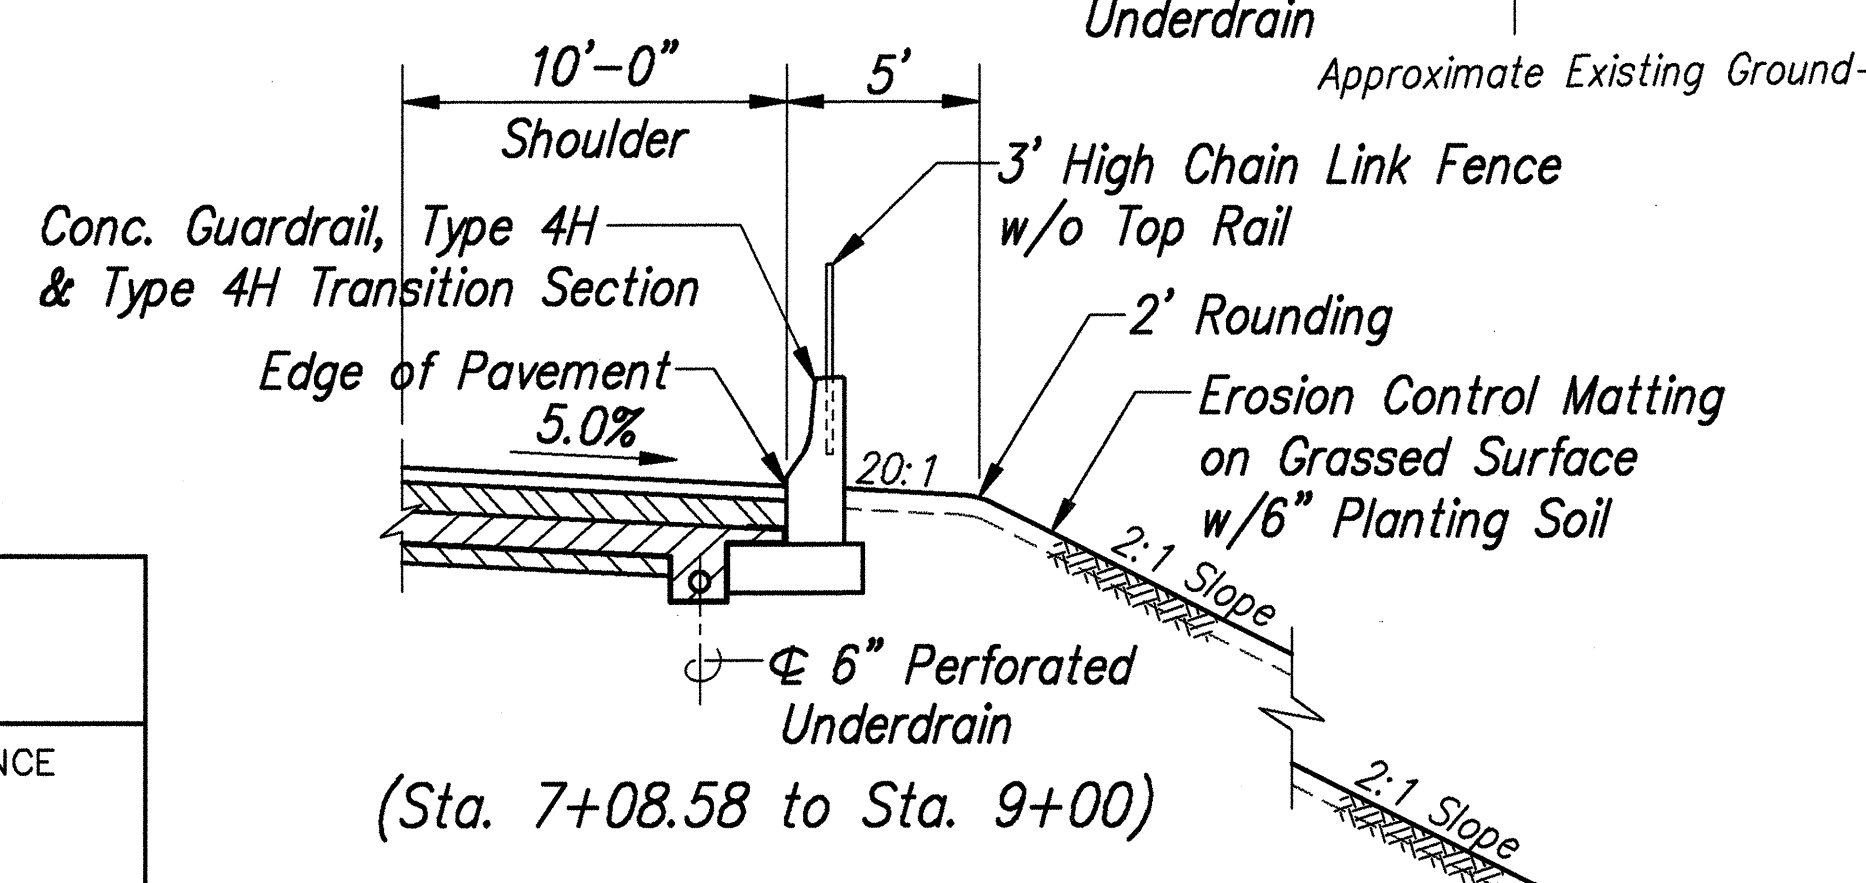

STATE OF HAWAII
DEPARTMENT OF TRANSPORTATION
HIGHWAYS DIVISION

TYPICAL ROADWAY SECTIONS

KAHEKILI HIGHWAY WIDENING
Likelike Hwy. to Vicinity of Haiku Road
F.A. PROJECT NO. NH-083-1(26)
SCALE: AS NOTED DATE: APRIL 1994

SHEET No. T8 OF T13 SHEETS
AS-BUILT ADD. 8

DESIGNED BY	DATE
DRAWN BY	
CHECKED BY	
APPROVED BY	
ORIGINAL PLAN	
NOTES	
REVISION	





6/07/94	DELETED 3' HIGH CHAIN LINK FENCE ON RETAINING WALL, LEFT SIDE. ADDED PAVING NOTE.
DATE	REVISION

REGISTERED PROFESSIONAL ENGINEER
No. 4739-C
HAWAII, USA

THIS WORK WAS PREPARED BY ME OR UNDER MY SUPERVISION
DATE: 6/21/94
Dexter S. Fujiwara, Inc.
dba PARK ENGINEERING

ROTATED BASE PL.

FED. ROAD DIS. NO.	STATE	FED. AID PROJ. NO.	FISCAL YEAR	SHEET NO.	TOTAL SHEETS
HAWAII	HAW.	NH-083-1(26)	1994	9	238

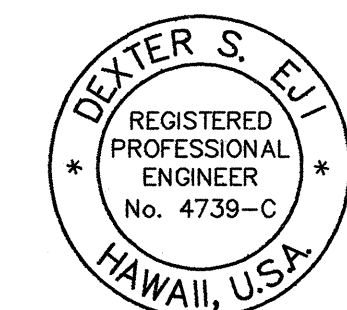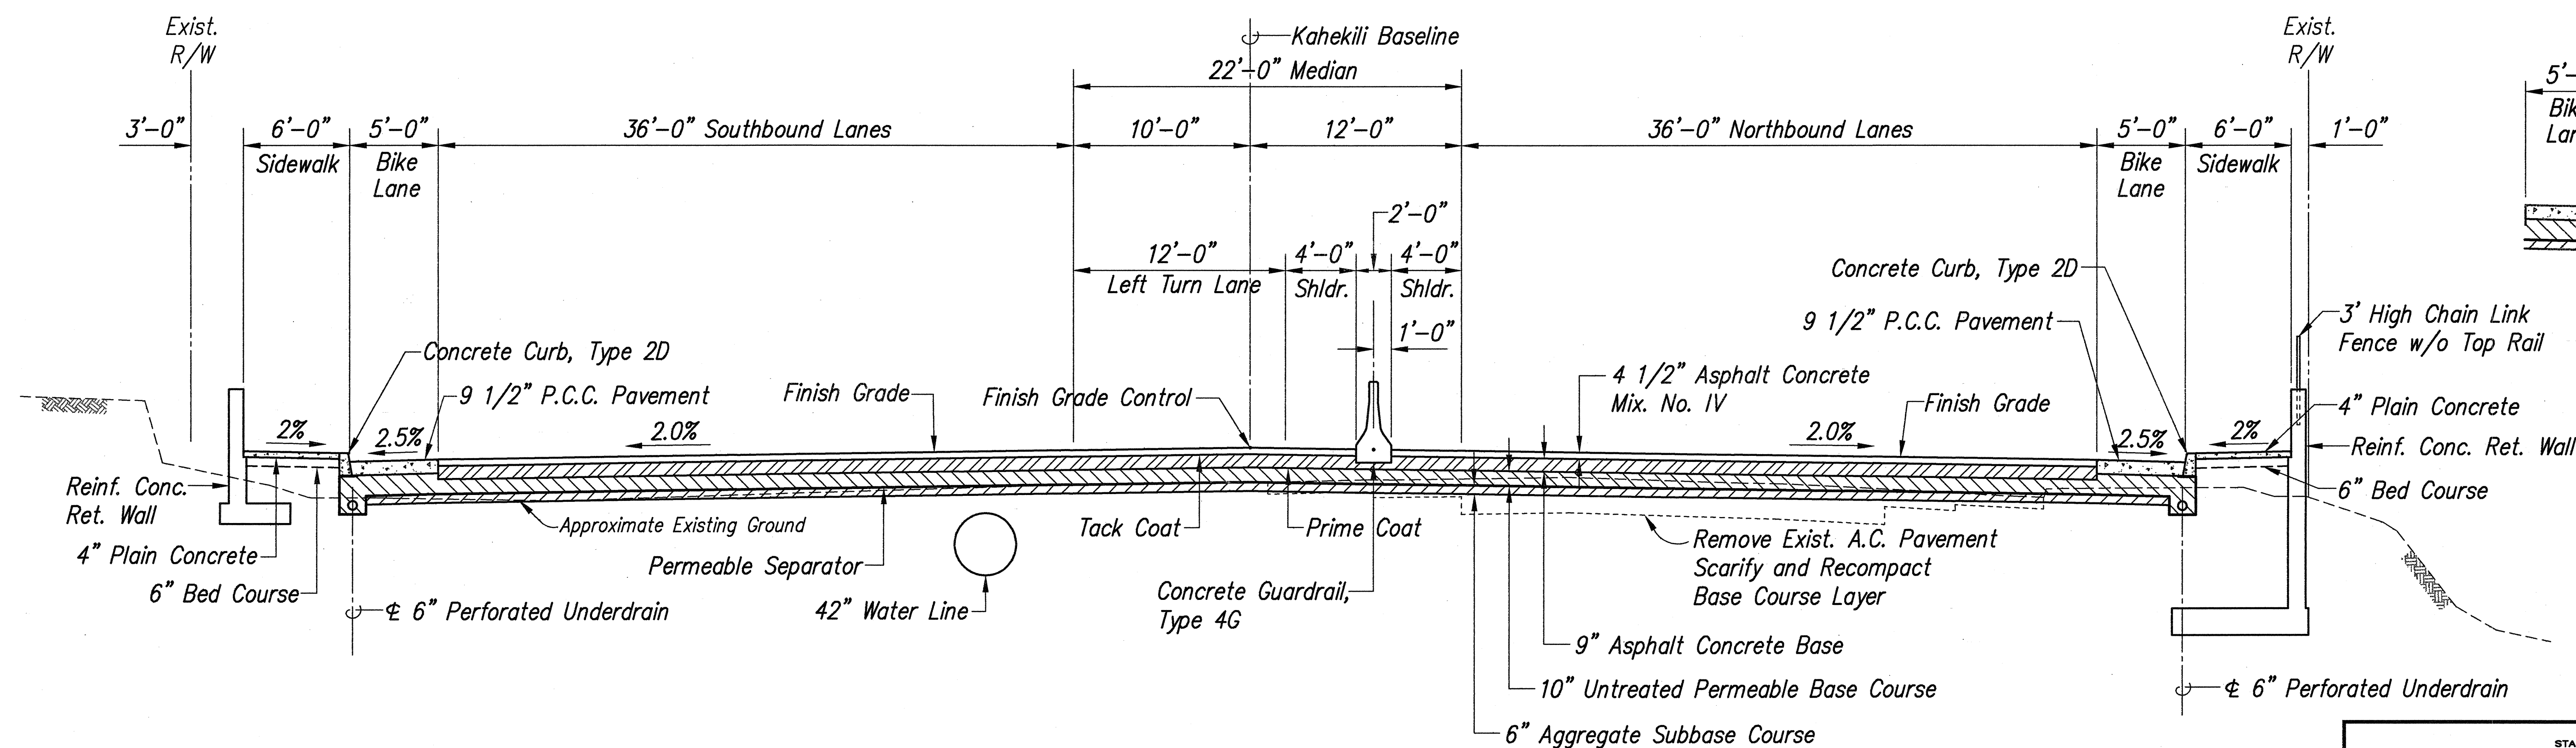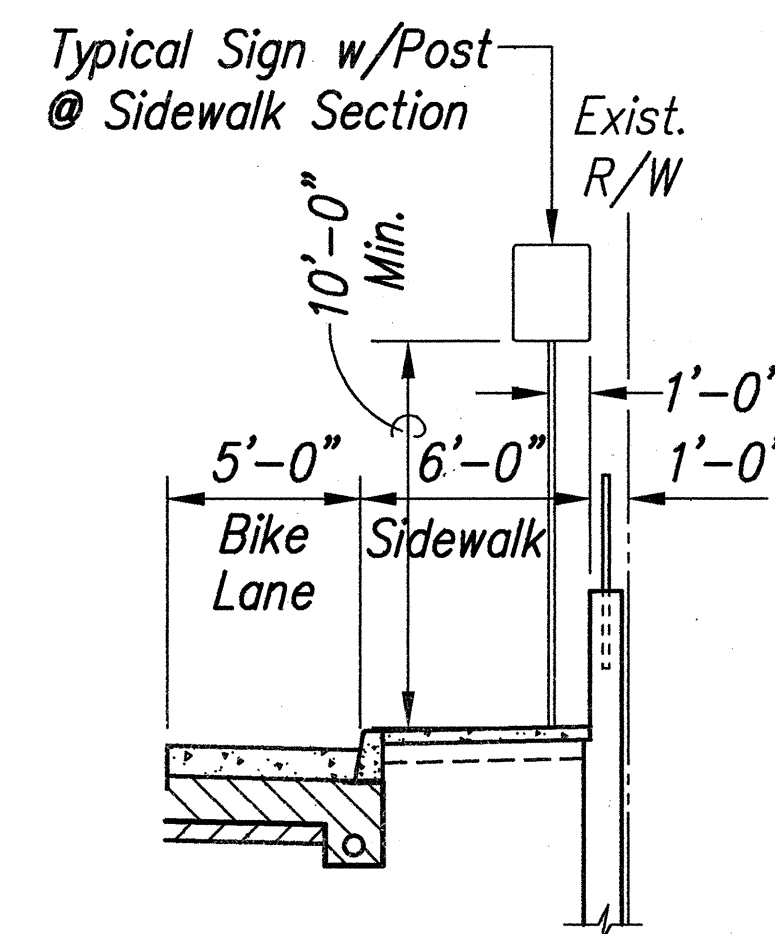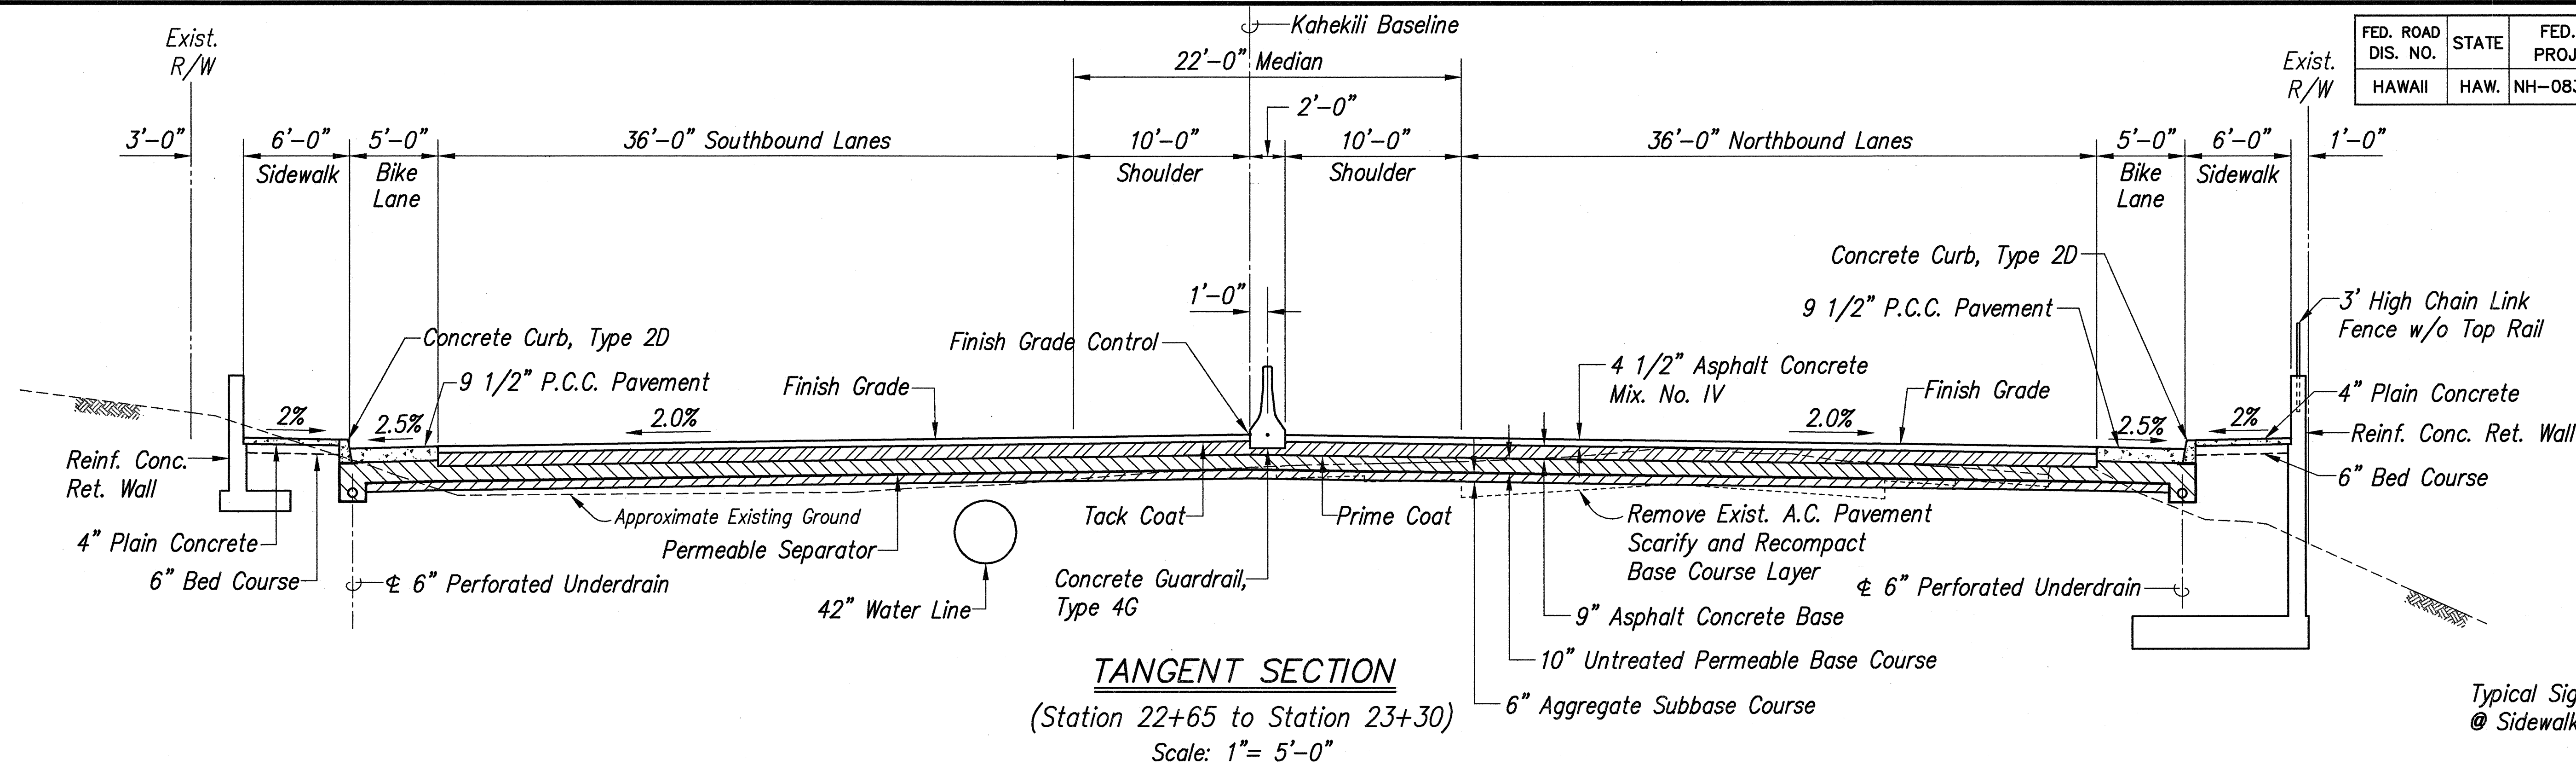

THIS WORK WAS PREPARED BY ME OR UNDER MY SUPERVISION
Dexter S. Fujiwara
P.E., Inc.
dba PARK ENGINEERING

STATE OF HAWAII
DEPARTMENT OF TRANSPORTATION
HIGHWAYS DIVISION



TYPICAL ROADWAY SECTIONS

KAHEKILI HIGHWAY WIDENING
Likelike Hwy. to Vicinity of Haiku Road
F.A. PROJECT NO. NH-083-1(26)

SCALE: AS NOTED DATE: APRIL 1994
SHEET No. T9 OF T13 SHEETS

DESIGNED BY	DATE
DRAWN BY	
CHECKED BY	
IN CHARGE	
REVIEWED BY	
APPROVED BY	

FED. ROAD DIS. NO.	STATE	FED. AID PROJ. NO.	FISCAL YEAR	SHEET NO.	TOTAL SHEETS
HAWAII	HAW.	NH-083-1(26)	1994	10	238

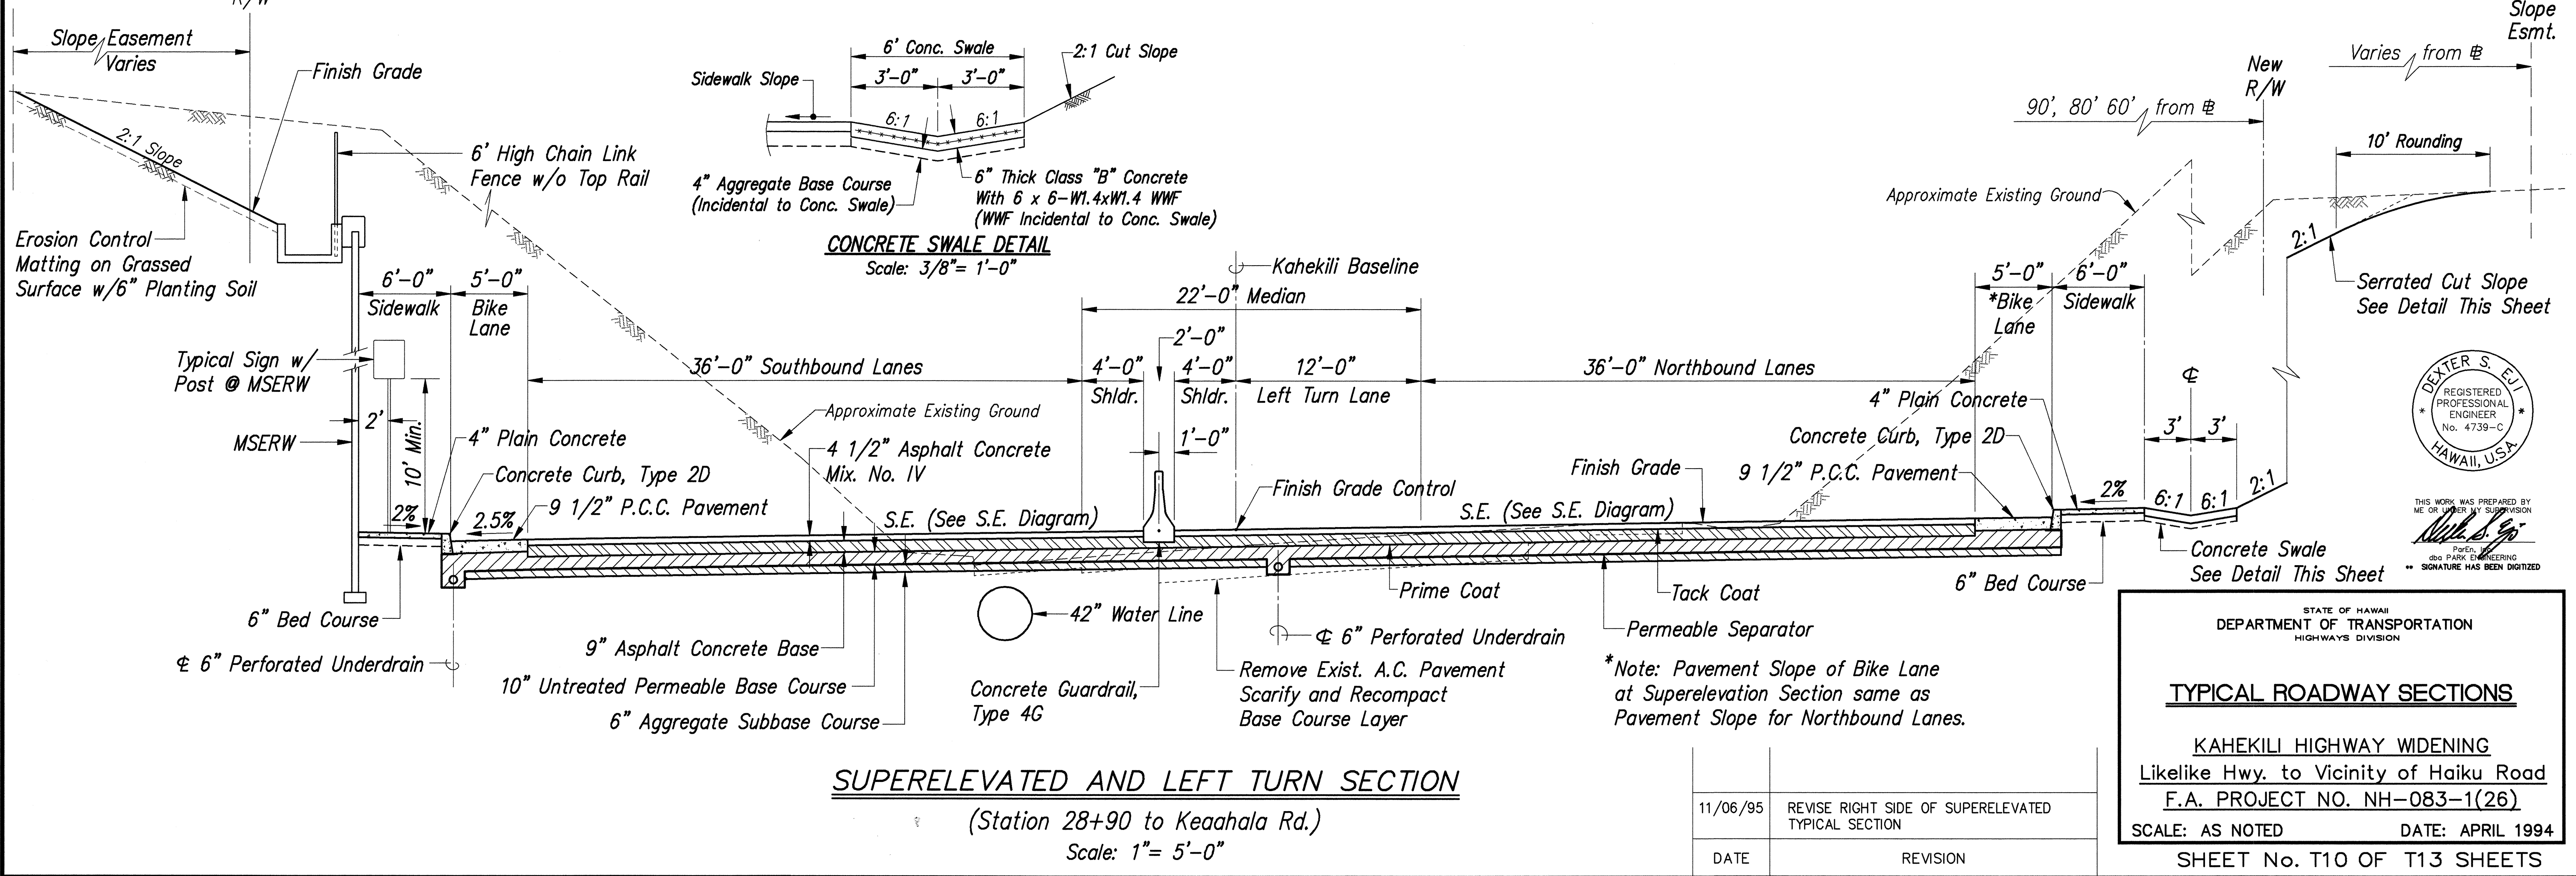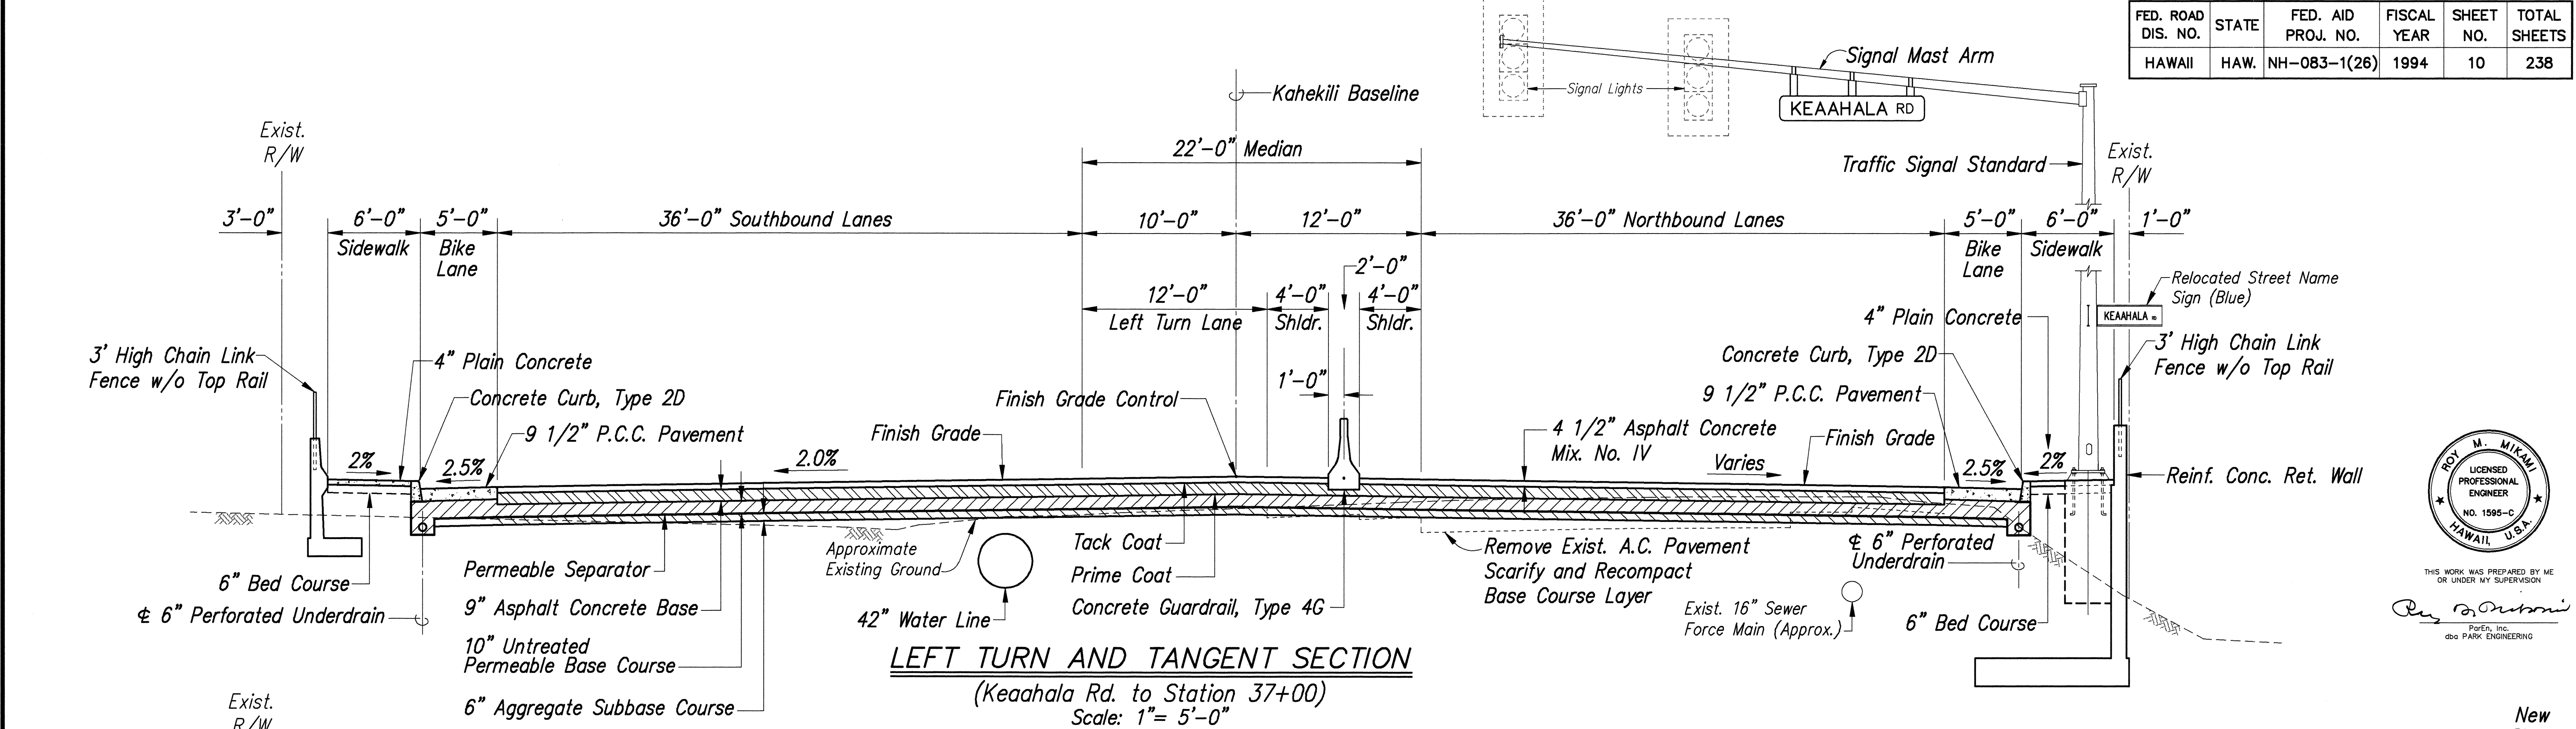

Professional Engineer Seal for Roy M. Mikami, No. 1595-C, State of Hawaii. Includes a signature and the text "THIS WORK WAS PREPARED BY ME OR UNDER MY SUPERVISION".


Professional Engineer Seal for Dexter S. Eji, No. 4739-C, State of Hawaii. Includes a signature and the text "THIS WORK WAS PREPARED BY ME OR UNDER MY SUPERVISION".

STATE OF HAWAII DEPARTMENT OF TRANSPORTATION HIGHWAYS DIVISION
TYPICAL ROADWAY SECTIONS
KAHEKILI HIGHWAY WIDENING
Likelike Hwy. to Vicinity of Haiku Road
F.A. PROJECT NO. NH-083-1(26)
SCALE: AS NOTED DATE: APRIL 1994
SHEET No. T10 OF T13 SHEETS
AS-BUILT C.O. 10


DATE	11/06/95
DESIGNED BY	REVISION
DRAWN BY	REVISION
CHECKED BY	REVISION
NOTED BY	REVISION
QUANTITIES BY	REVISION
NO.	REVISION

11/06/95	REVISE RIGHT SIDE OF SUPERELEVATED TYPICAL SECTION
DATE	REVISION


FED. ROAD DIS. NO.	STATE	FED. AID PROJ. NO.	FISCAL YEAR	SHEET NO.	TOTAL SHEETS
HAWAII	HAW.	NH-083-1(26)	1994	11	238

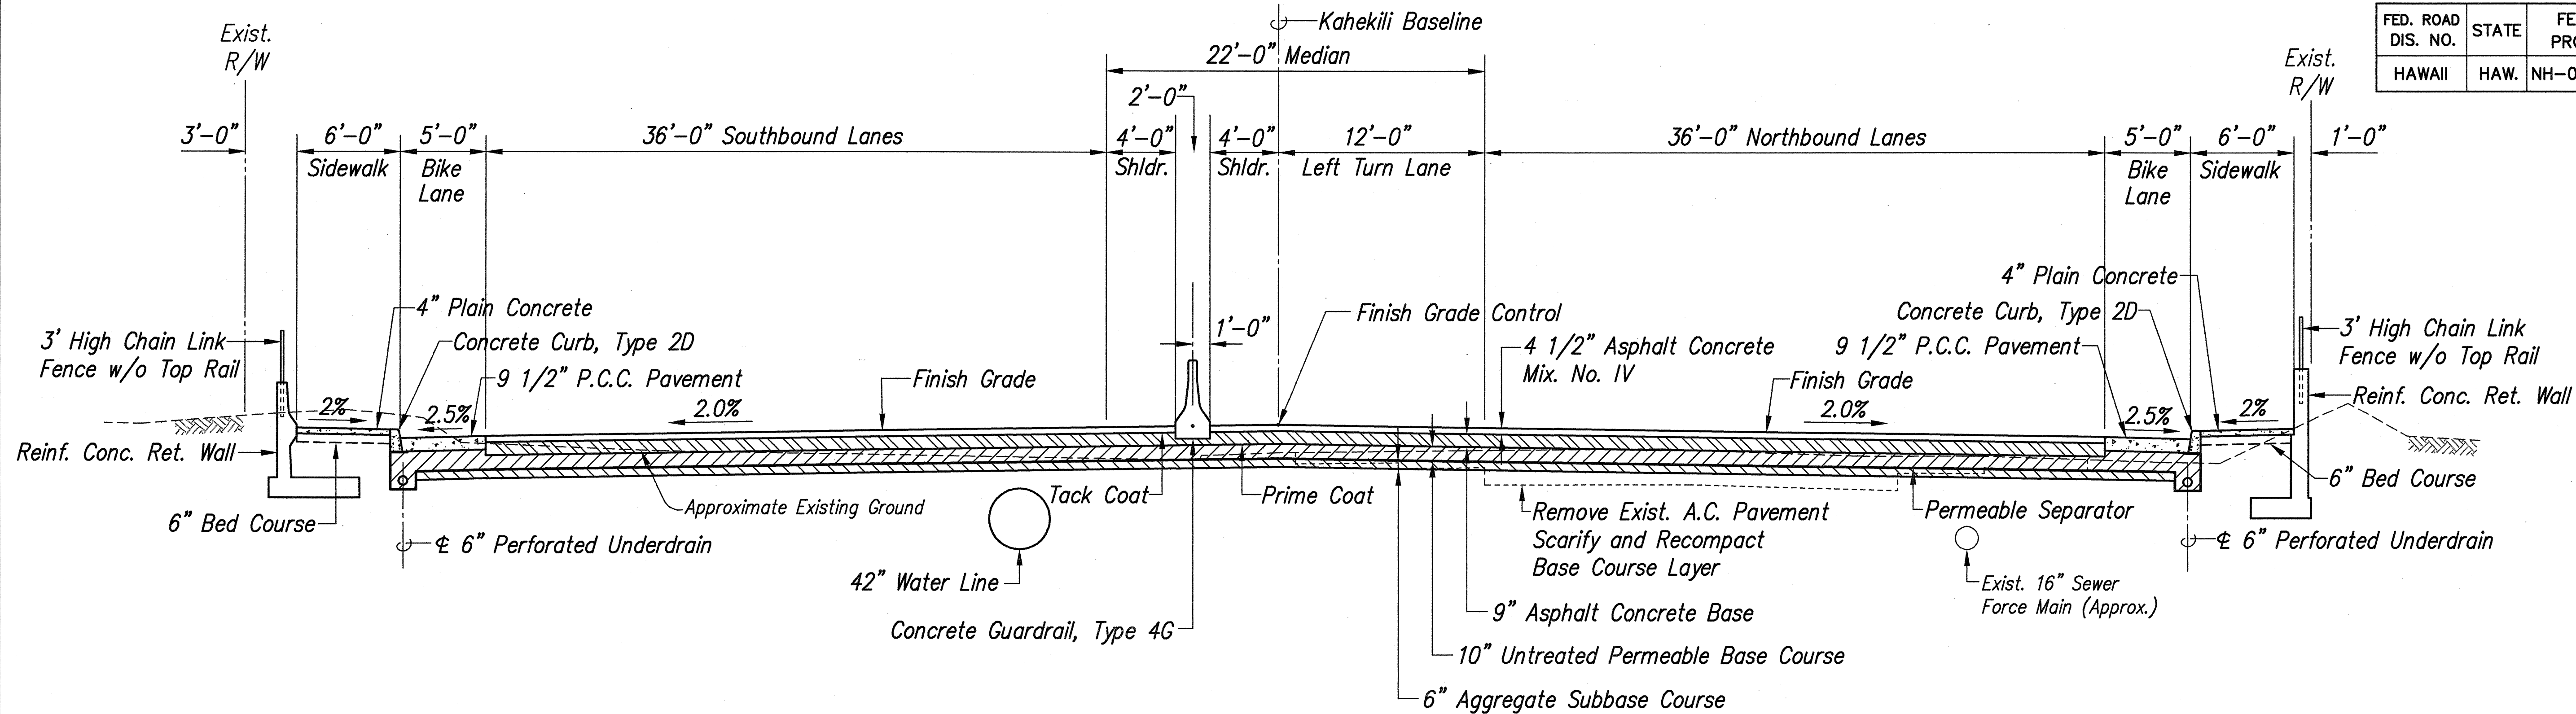

TANGENT AND LEFT TURN SECTION
(Station 42+00 to Kahuhipa St.)
Scale: 1" = 5'-0"

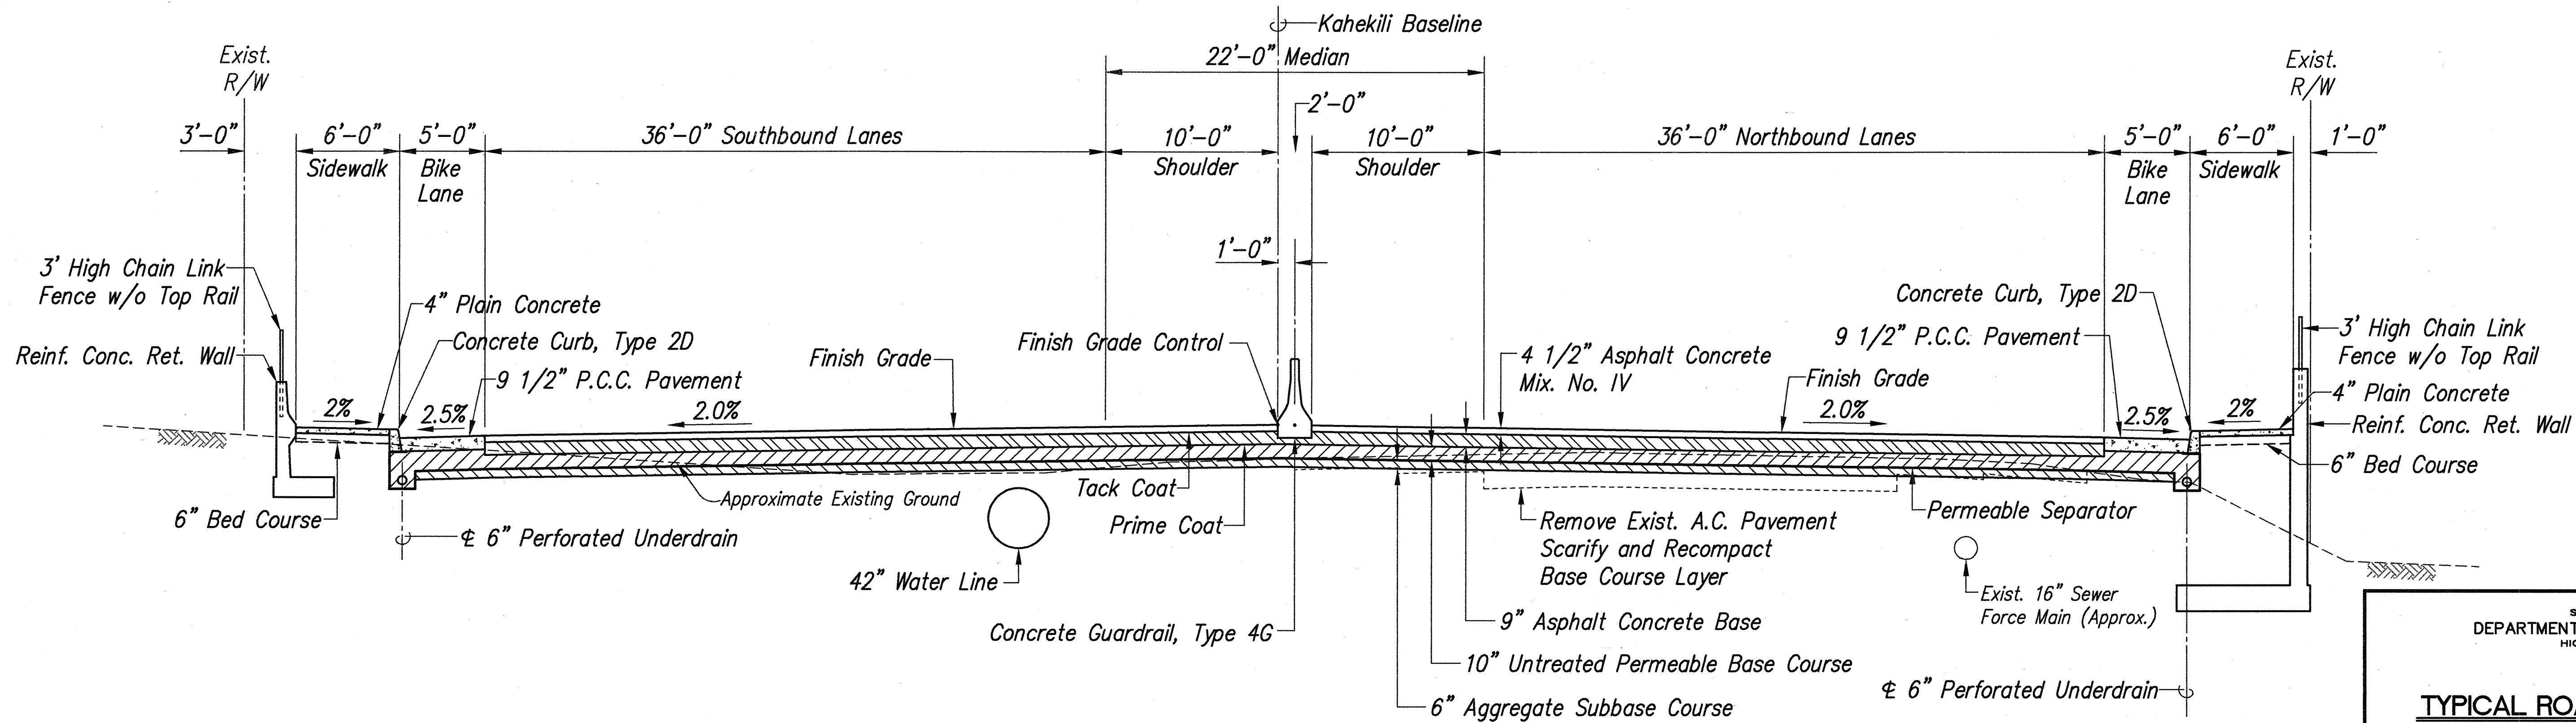

TANGENT SECTION
(Station 38+80 to Station 40+20)
Scale: 1" = 5'-0"

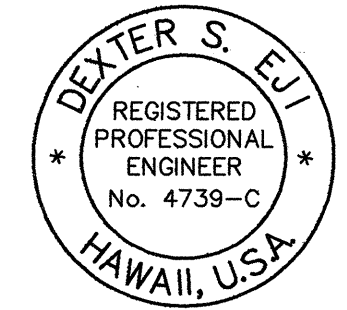

THIS WORK WAS PREPARED BY ME OR UNDER MY SUPERVISION
DATE: 5/16/94
dso PARK ENGINEERING

STATE OF HAWAII
DEPARTMENT OF TRANSPORTATION
HIGHWAYS DIVISION

TYPICAL ROADWAY SECTIONS


KAHEKILI HIGHWAY WIDENING
Likelike Hwy. to Vicinity of Haiku Road
F.A. PROJECT NO. NH-083-1(26)

SCALE: AS NOTED DATE: APRIL 1994


SHEET No. T11 OF T13 SHEETS

DATE	_____
SURVEY PLANNED BY	_____
DRAWN BY	_____
CHECKED BY	_____
QUANTITIES BY	_____
NOTES	_____
NO.	_____


FED. ROAD DIS. NO.	STATE	FED. AID PROJ. NO.	FISCAL YEAR	SHEET NO.	TOTAL SHEETS
HAWAII	HAW.	NH-083-1(26)	1994	12	238

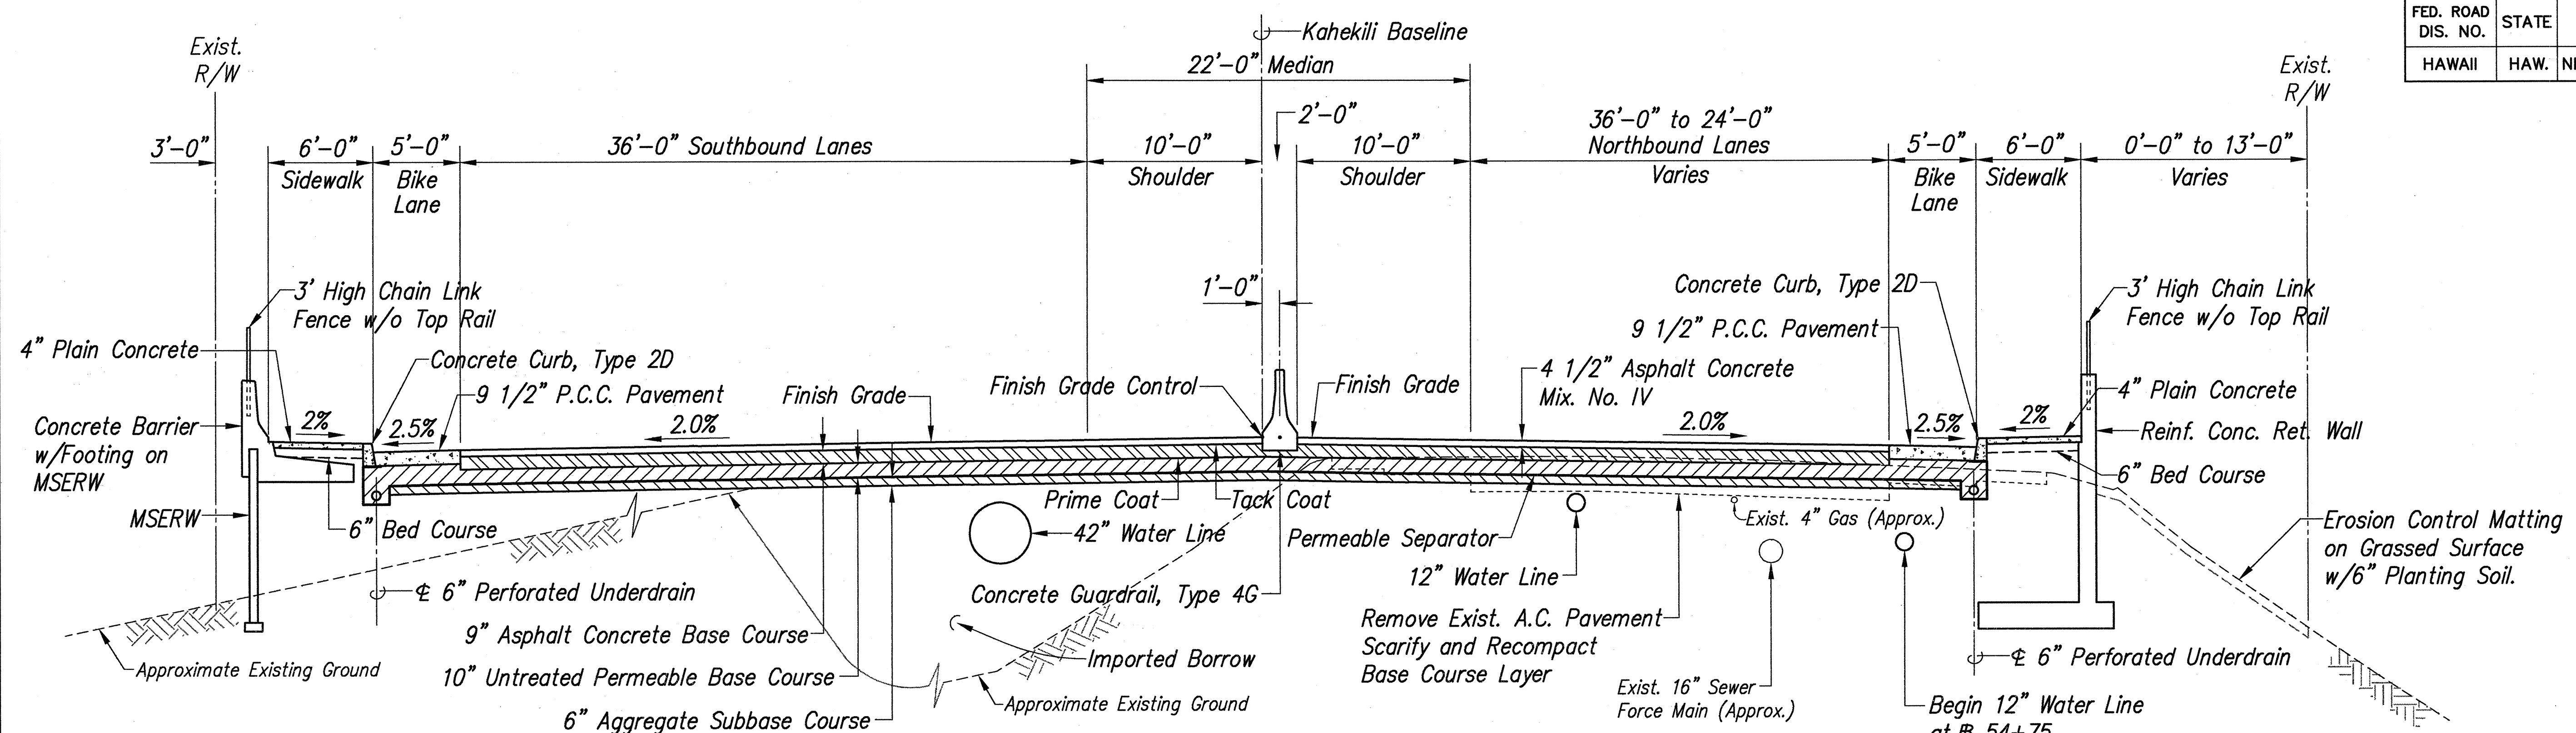

TANGENT SECTION
(Station 50+00 to Station 59+00)
Scale: 1"= 5'-0"

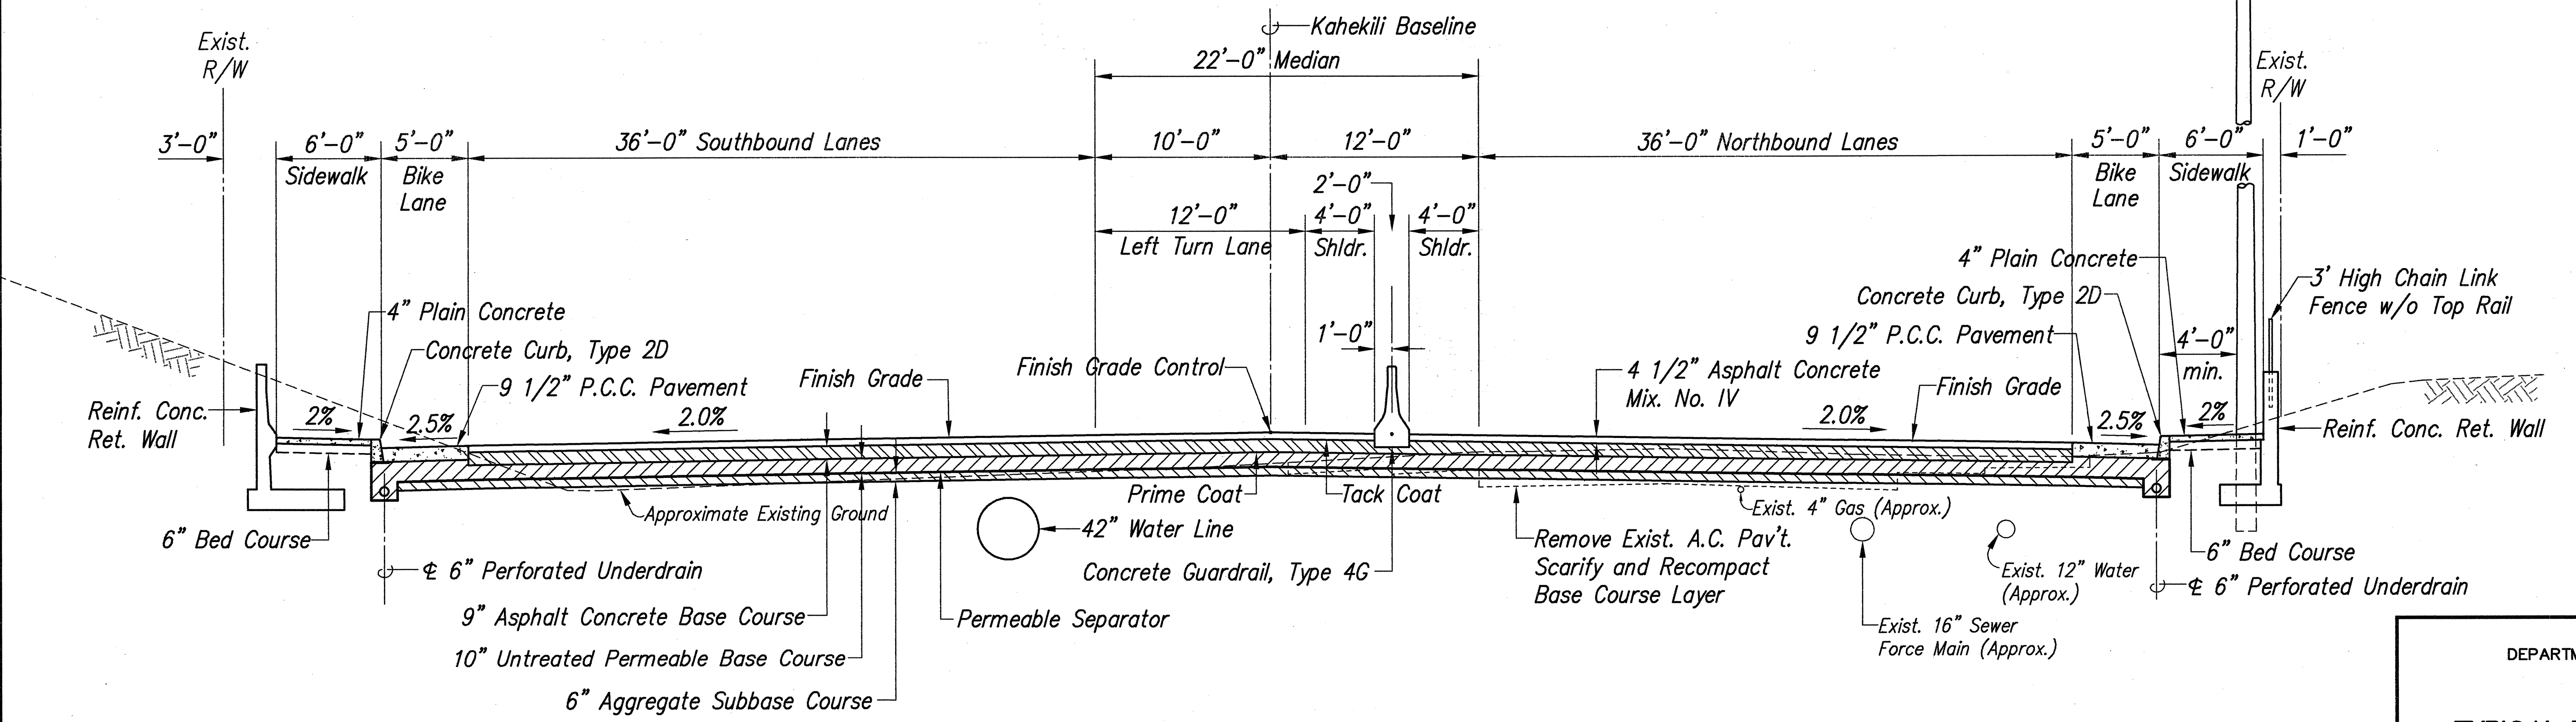

LEFT TURN AND TANGENT SECTION
(Kahuhipa St. to Station 50+00)
Scale: 1"= 5'-0"

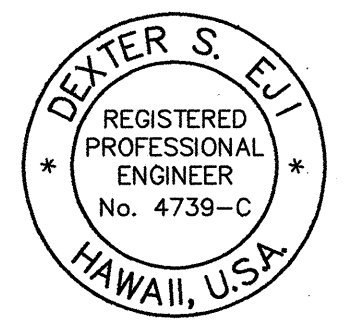

THIS WORK WAS PREPARED BY ME OR UNDER MY SUPERVISION
Dexter S. Eli
Dexter S. Eli
dso PARK ENGINEERING

STATE OF HAWAII
DEPARTMENT OF TRANSPORTATION
HIGHWAYS DIVISION




TYPICAL ROADWAY SECTIONS

KAHEKILI HIGHWAY WIDENING
Likelike Hwy. to Vicinity of Haiku Road
F.A. PROJECT NO. NH-083-1(26)

SCALE: AS NOTED DATE: APRIL 1994

SHEET No. T12 OF T13 SHEETS

FED. ROAD DIS. NO.	STATE	FED. AID PROJ. NO.	FISCAL YEAR	SHEET NO.	TOTAL SHEETS
HAWAII	HAW.	NH-083-1(26)	1994	13	238

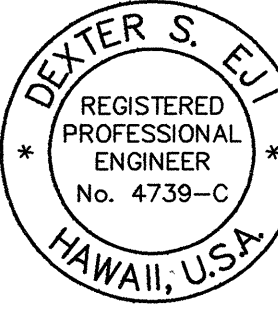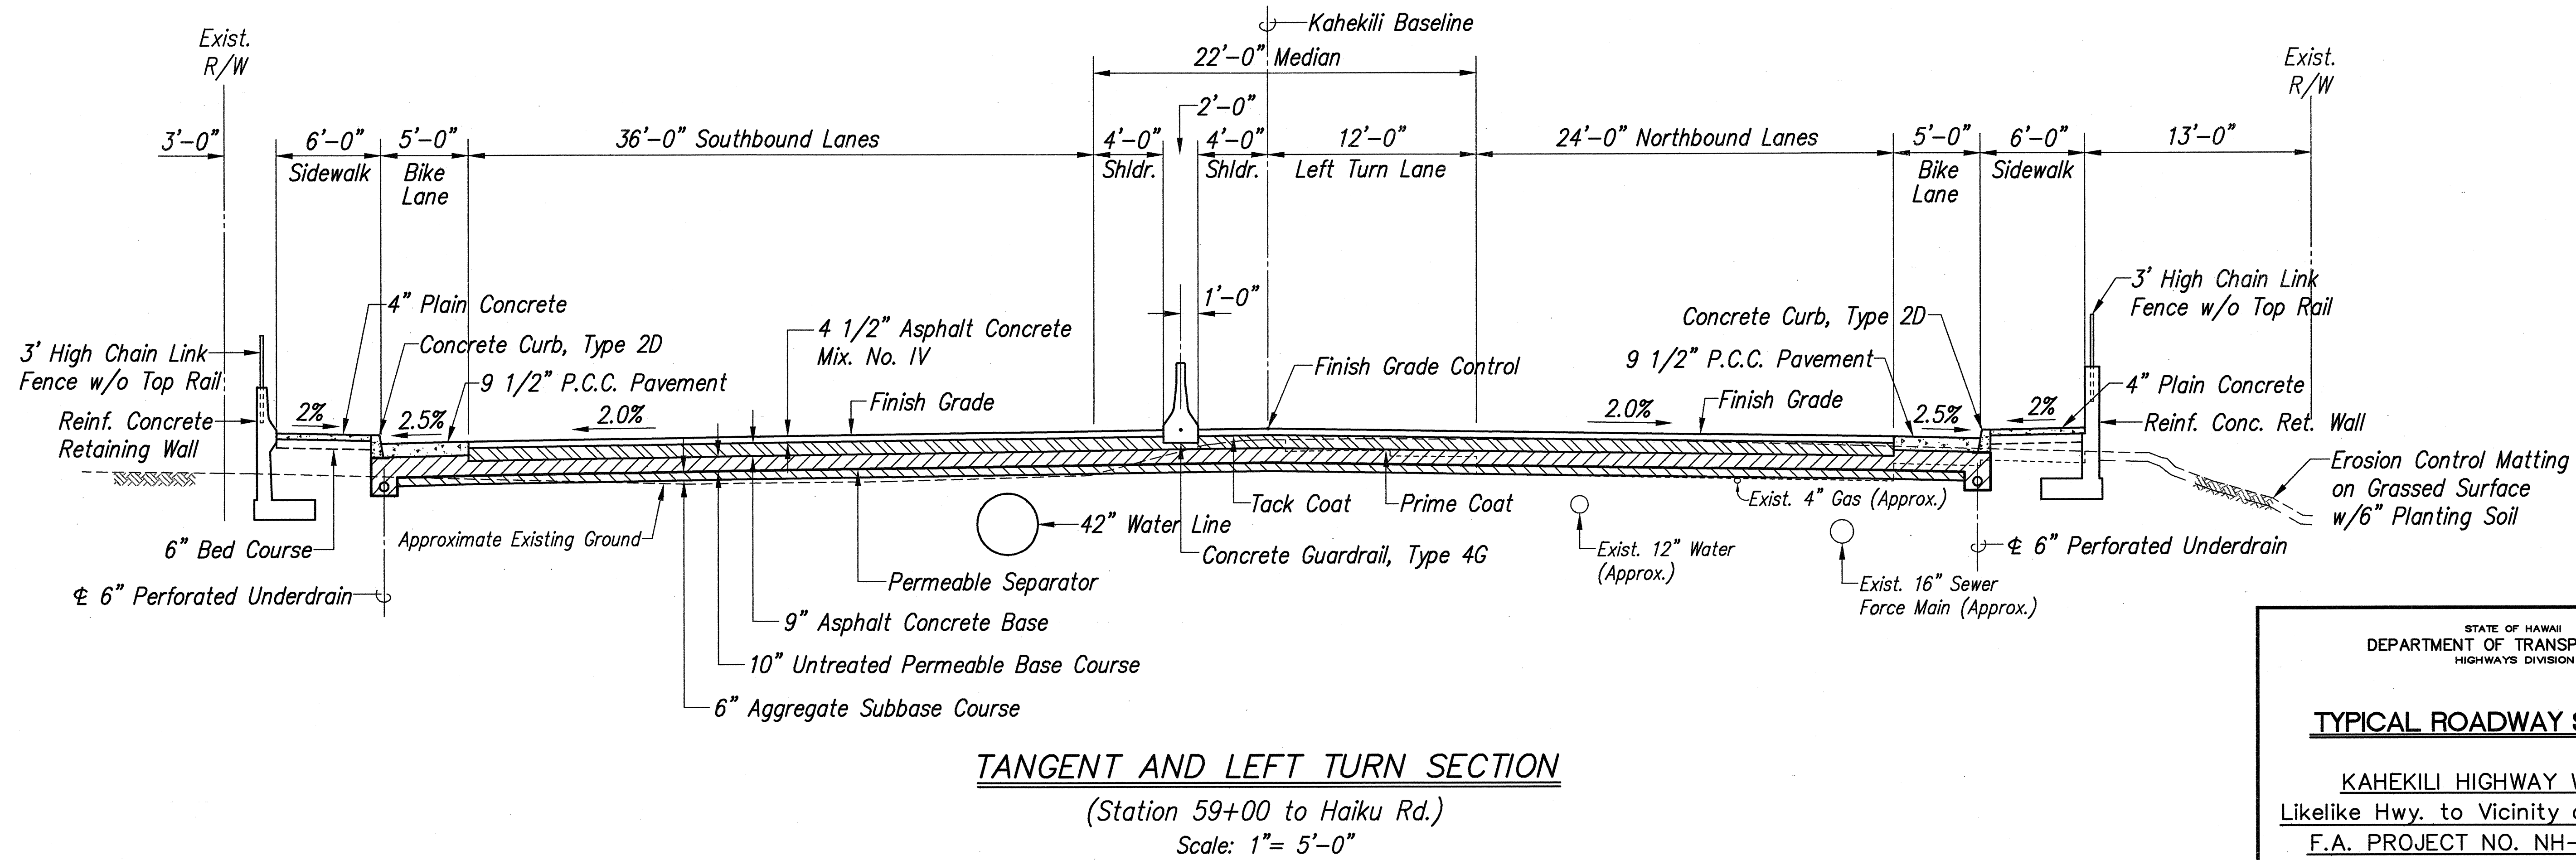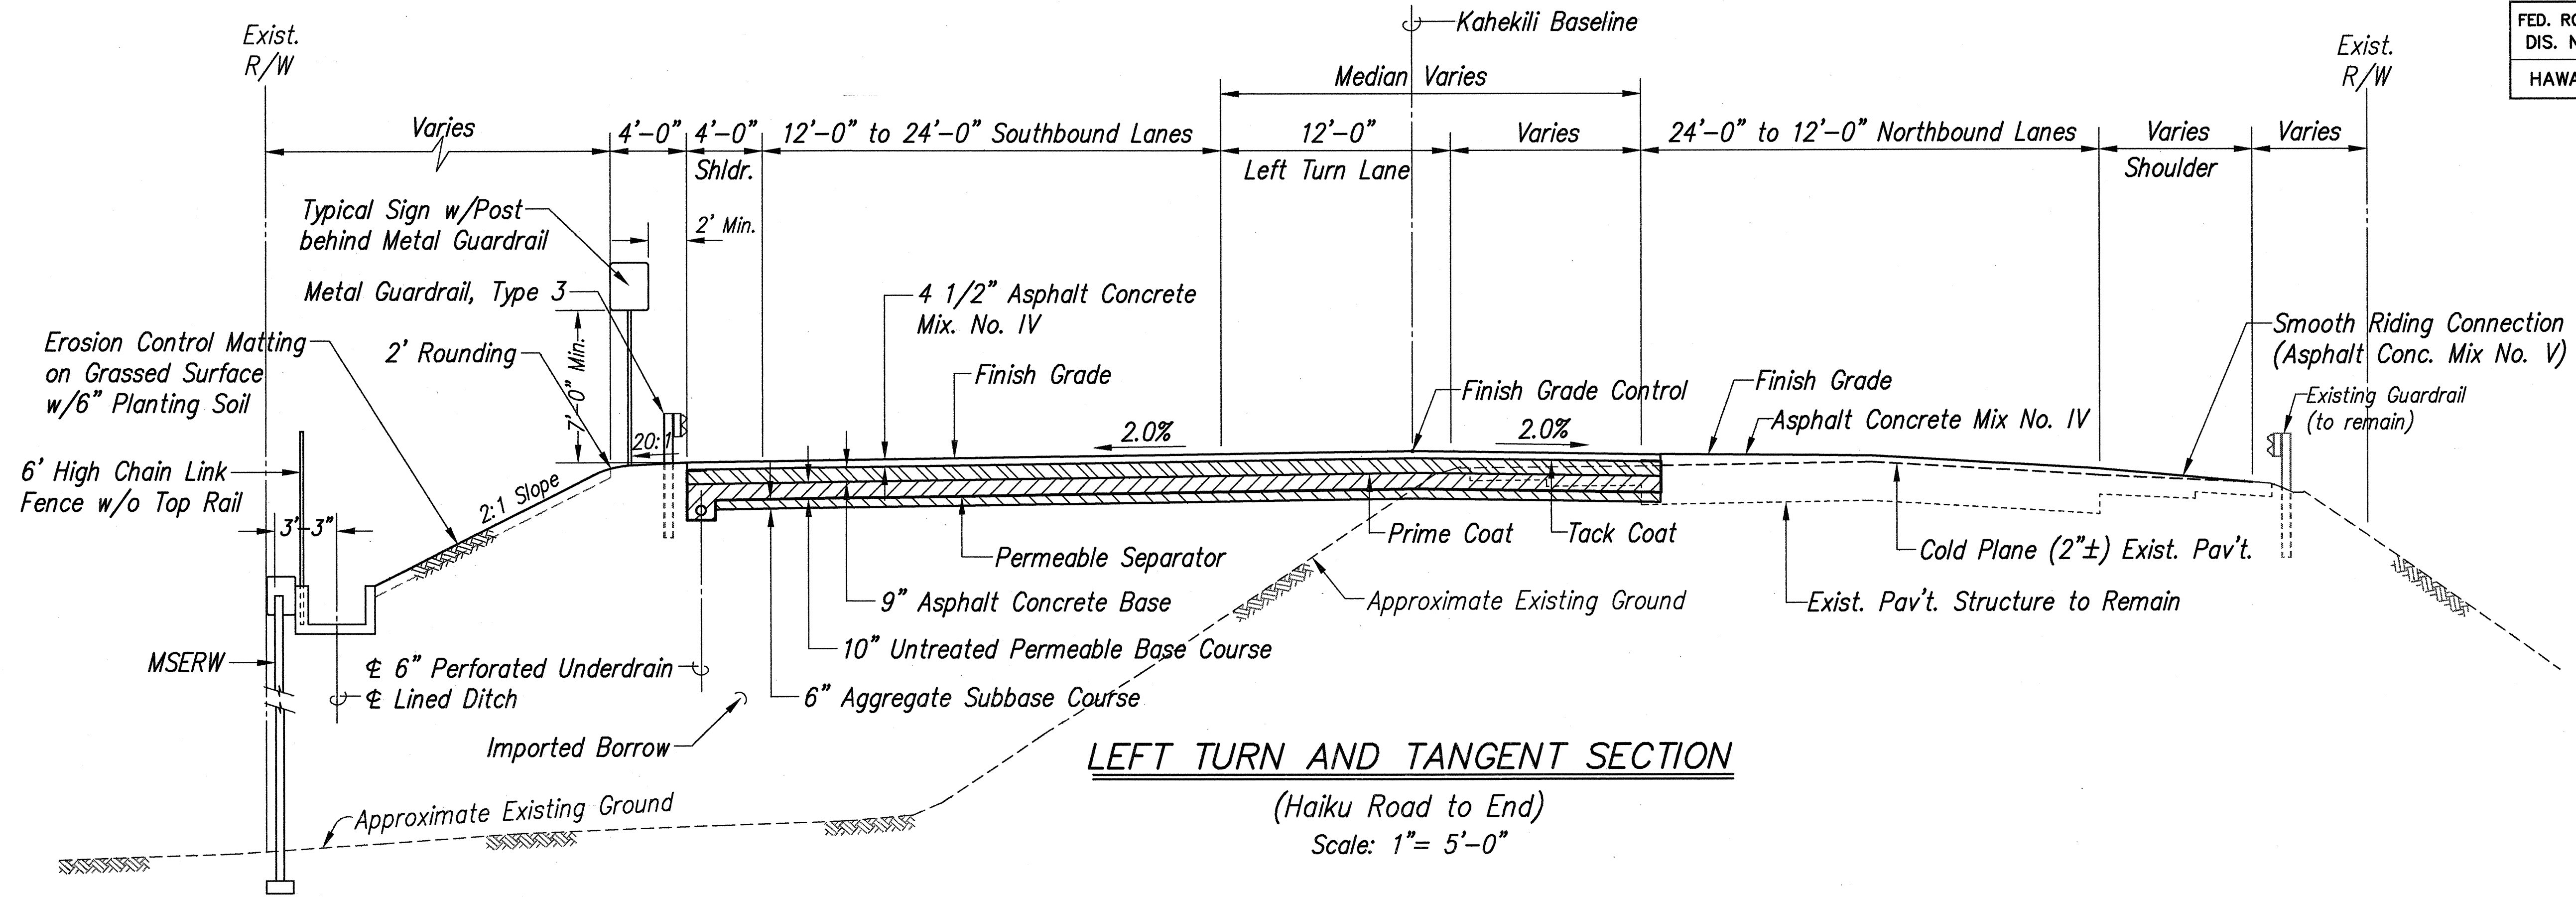

THIS WORK WAS PREPARED BY ME OR UNDER MY SUPERVISION
Date: 4/15/94
dso PARK ENGINEERING

STATE OF HAWAII
DEPARTMENT OF TRANSPORTATION
HIGHWAYS DIVISION

TYPICAL ROADWAY SECTIONS

KAHEKILI HIGHWAY WIDENING
Likelike Hwy. to Vicinity of Haiku Road
F.A. PROJECT NO. NH-083-1(26)

SCALE: AS NOTED DATE: APRIL 1994

SHEET No. T13 OF T13 SHEETS

DATE	_____
SURVEY PLOTTED BY	_____
DRAWN BY	_____
CHECKED BY	_____
ORIGINAL PLAN	_____
NOTES	_____
NO.	_____