
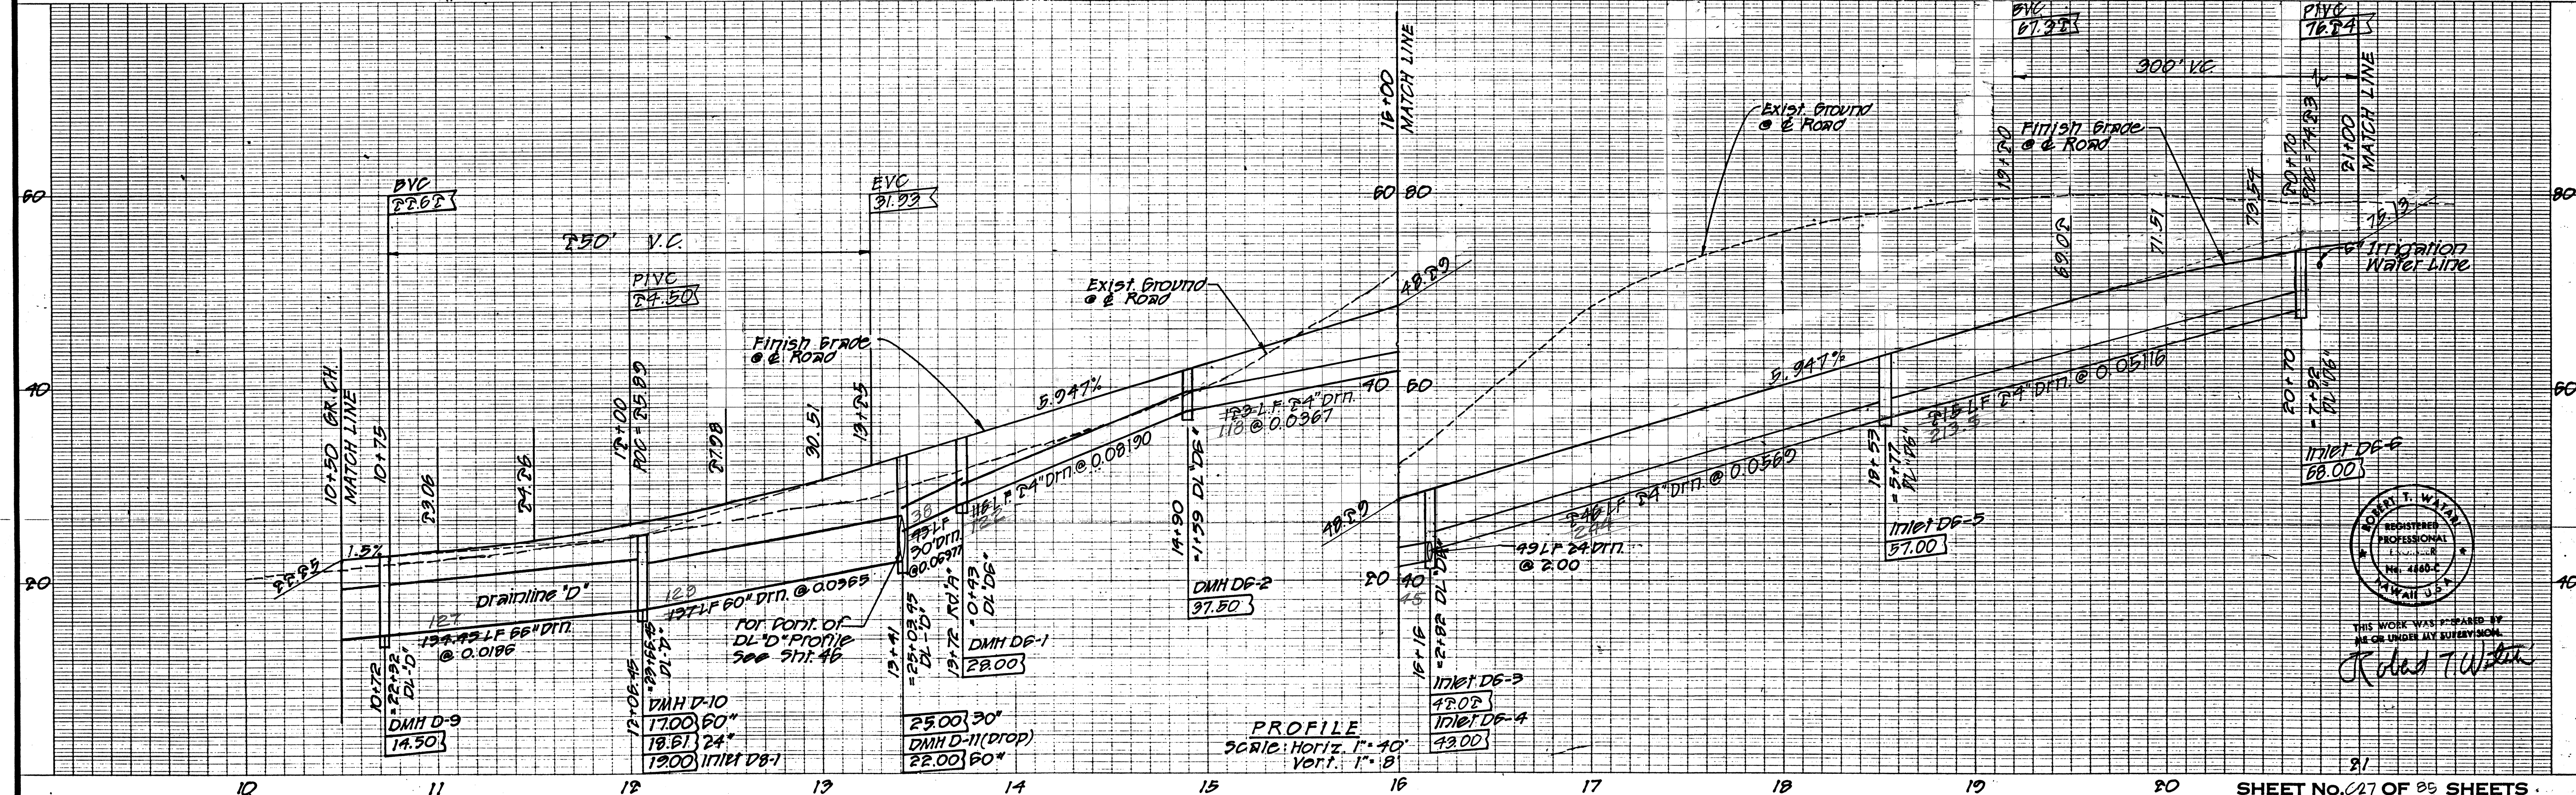


FED. ROAD DIST. NO.	STATE	PROJ. NO.	FISCAL YEAR	SHEET NO.	TOTAL SHEETS
HAWAII	HAW.	83A-01-02	1992	28	168

CURVE DATA

	A3	A5
Δ	43° 42'	117° 49' 21"
Δ/2	21° 51'	58° 54' 40"
R	823.13	69.50
T	390.06	115.78
C	612.70	119.04
L	627.81	142.32

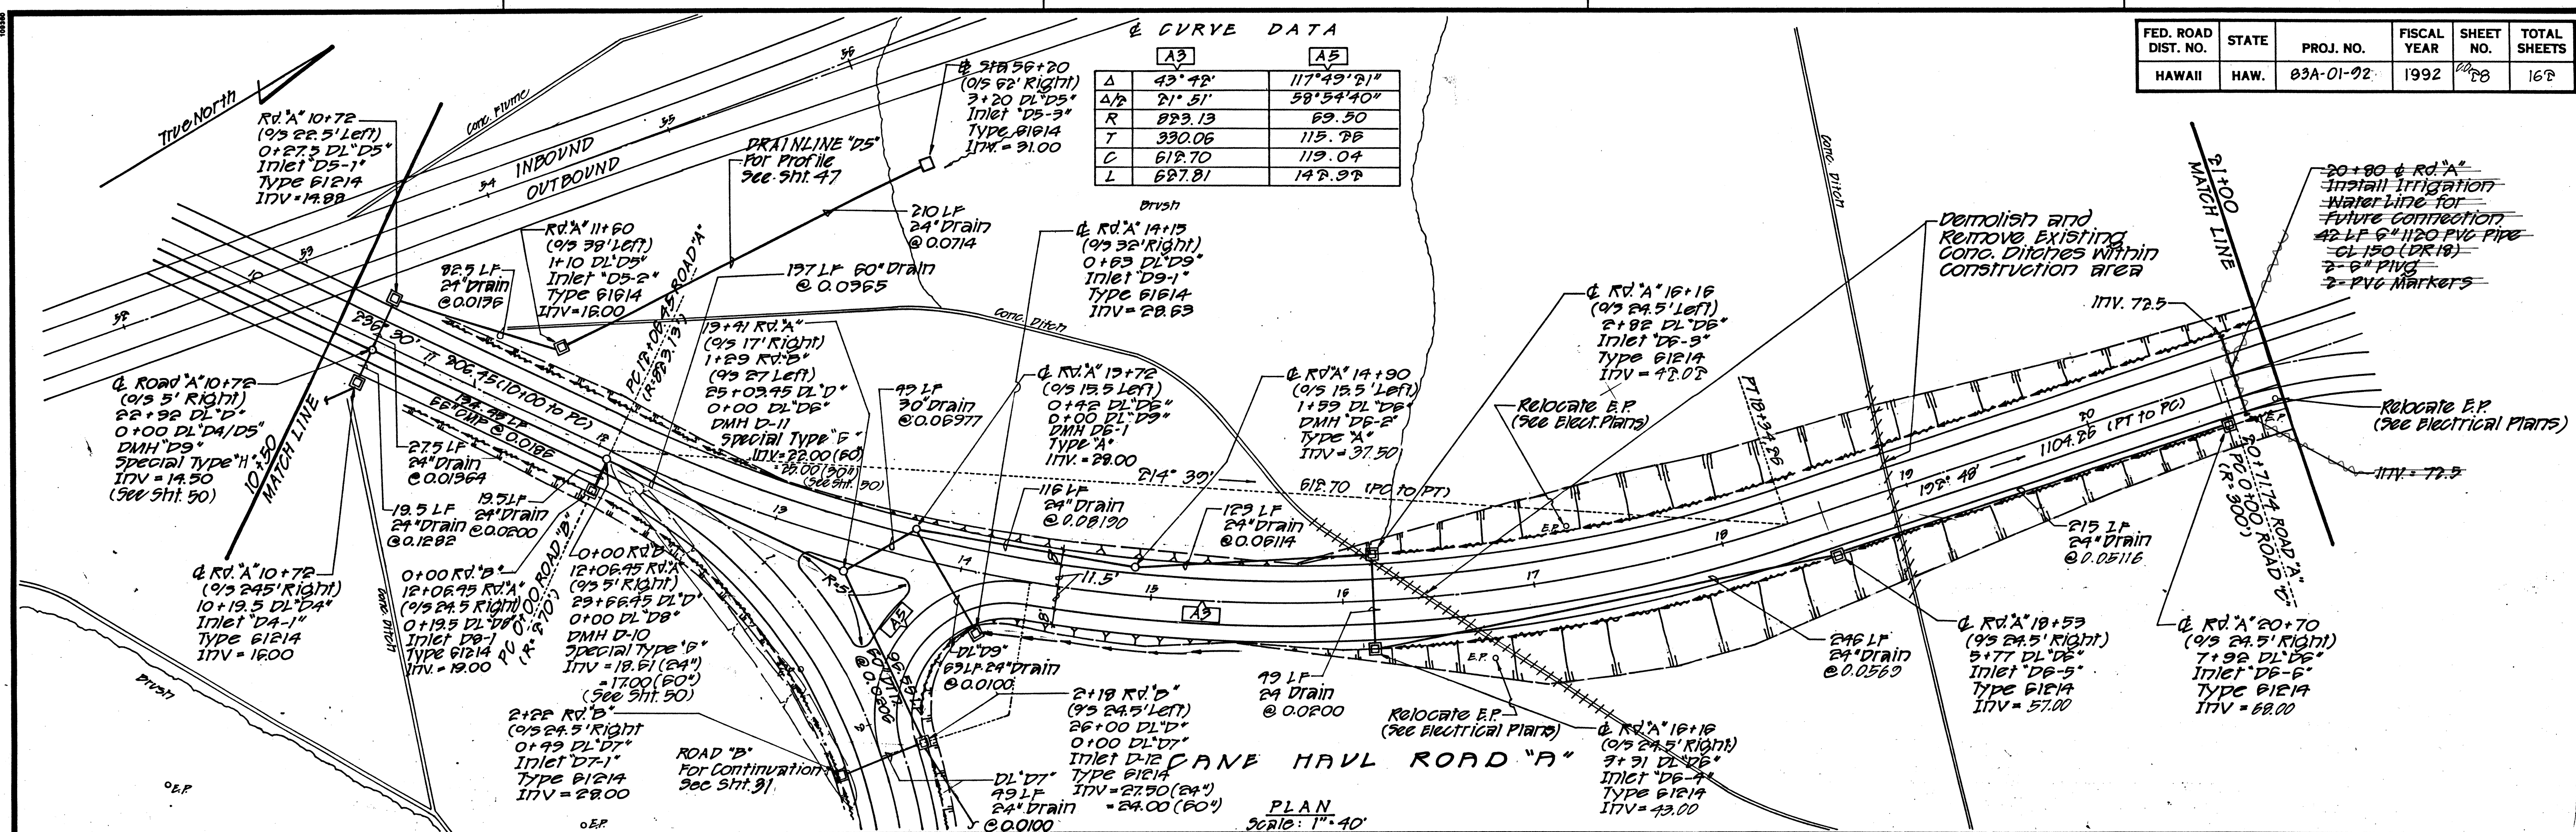

DATE	...
DESIGNED BY	...
CHECKED BY	...
NOTED BY	...
QUANTITIES BY	...
CHECKED BY	...
NO.	...





THIS WORK WAS PREPARED BY ME OR UNDER MY SUPERVISION.
Robert T. Wain


FED. ROAD DIST. NO.	STATE	PROJ. NO.	FISCAL YEAR	SHEET NO.	TOTAL SHEETS
HAWAII	HAW.	83A-01-02	1992	22	162

D1

Δ	90°00'
$\Delta/2$	45°00'
R	20.00
T	20.00
C	28.28
L	31.42

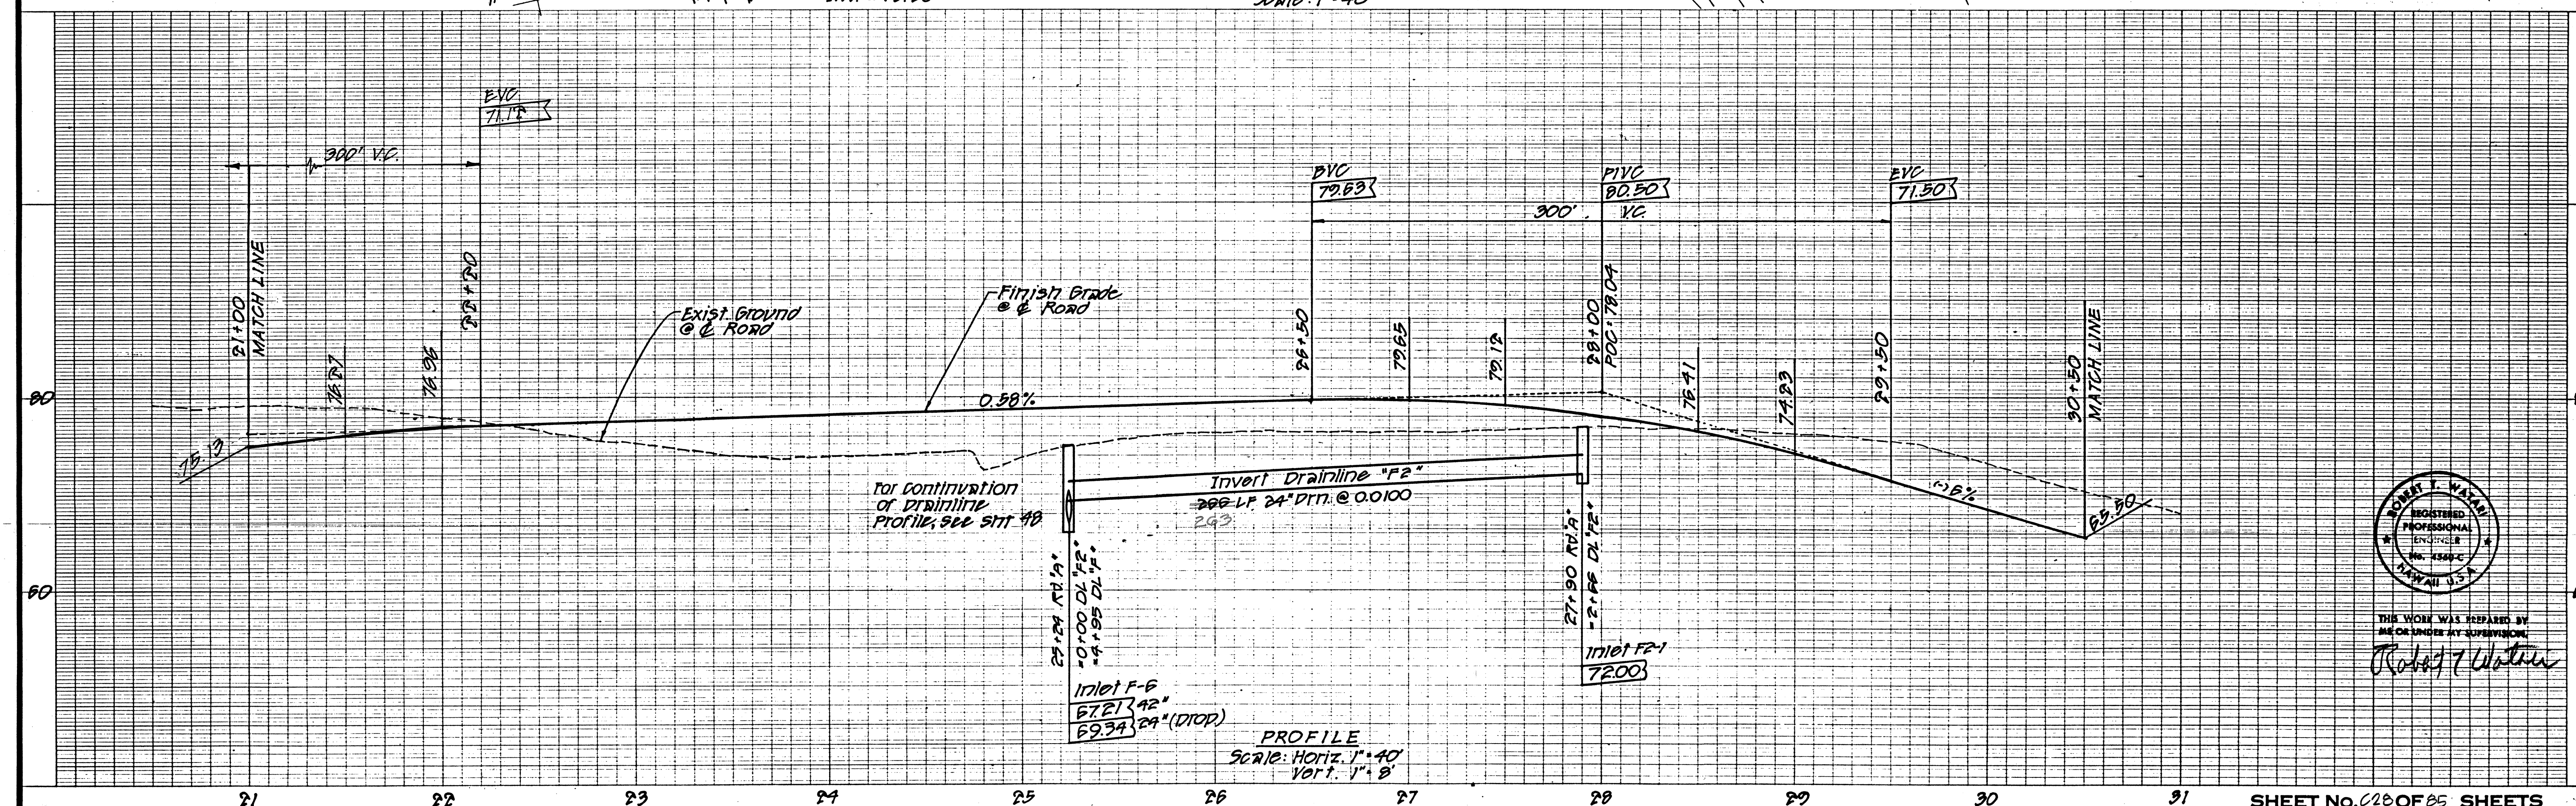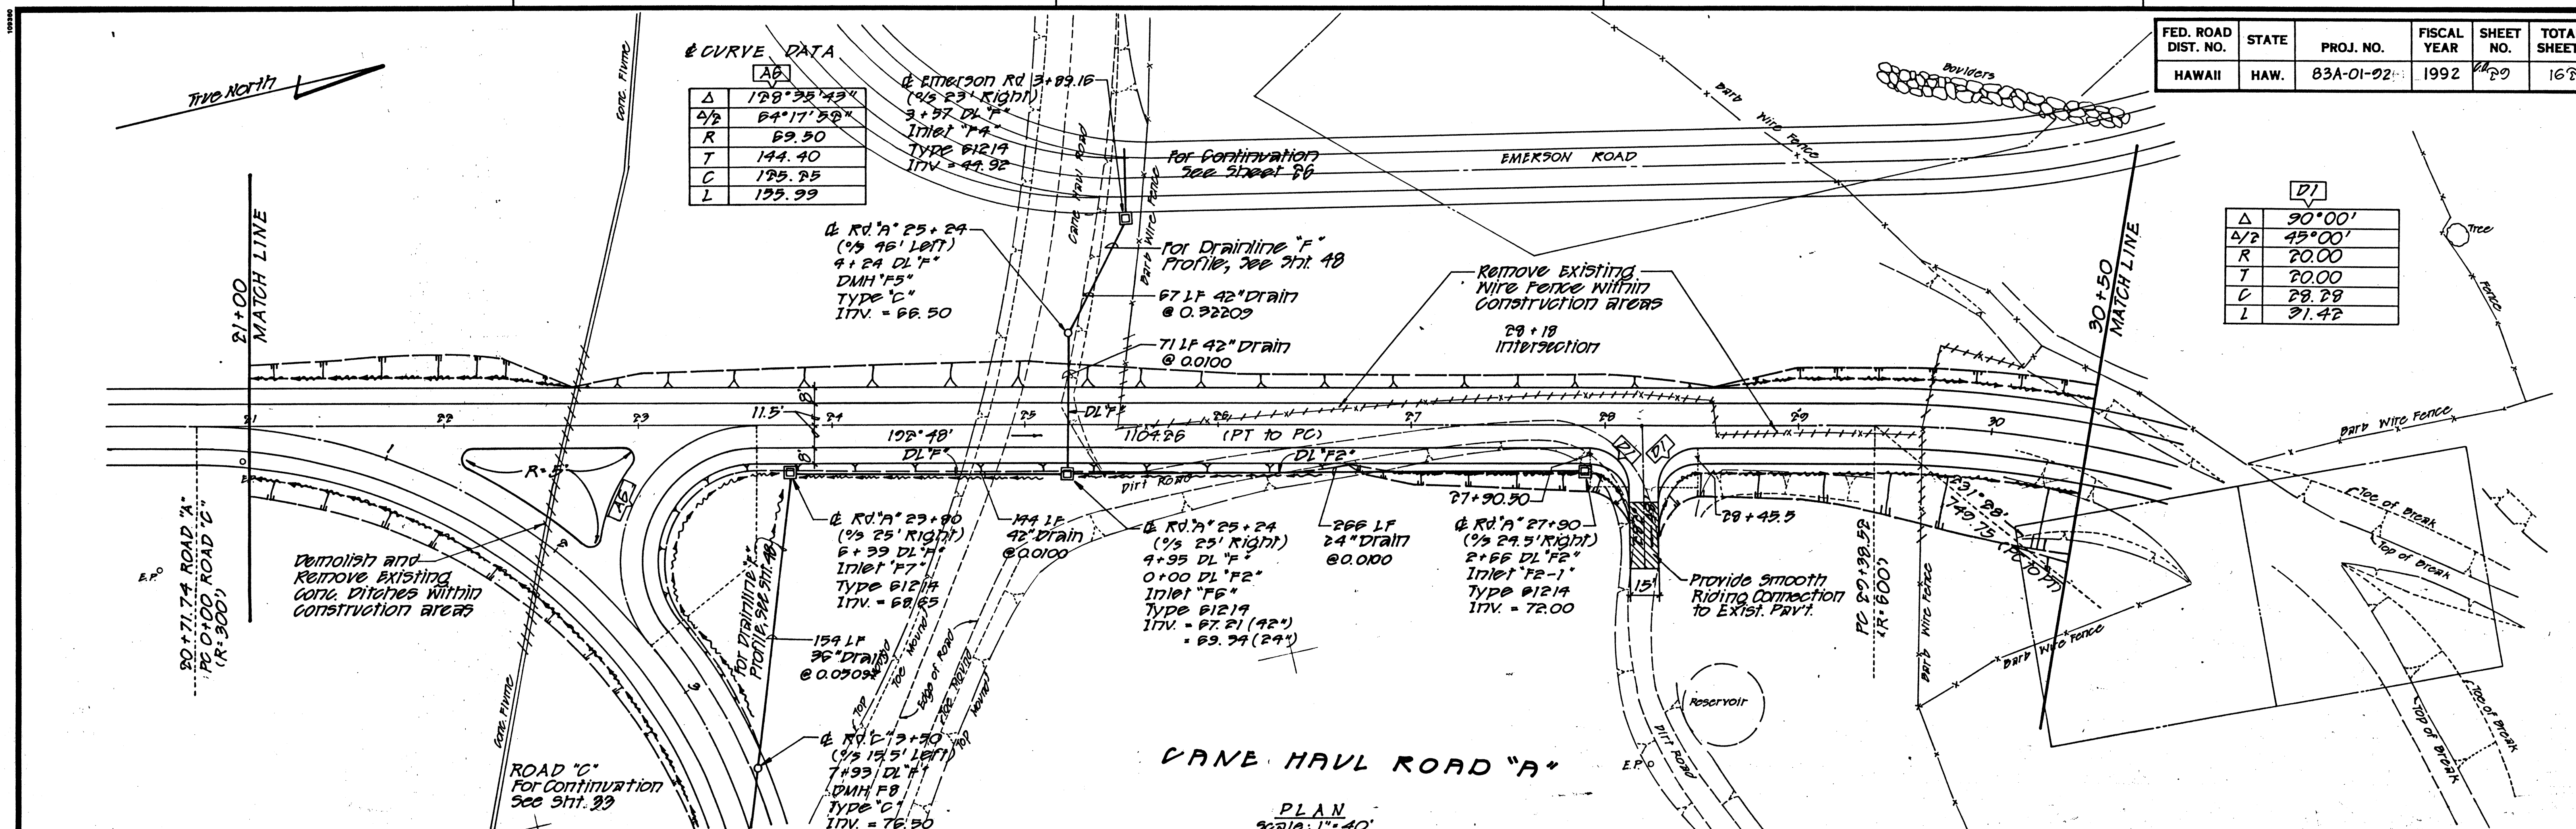

ORIGINAL PLAN	SURVEY PLOTTED BY _____ DATE _____
NOTE BOOK	DRAWN BY _____
	TRACED BY _____
	DESIGNED BY _____
	QUANTITIES BY _____
No. _____	CHECKED BY _____

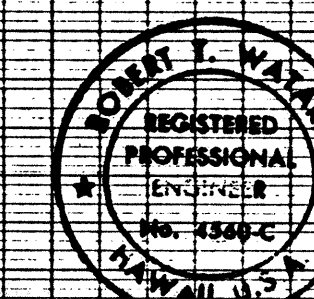

THIS WORK WAS PREPARED BY
ME OR UNDER MY SUPERVISION.
Robert W. Watson

