




FED. ROAD DIST. NO.	STATE	PROJ. NO.	FISCAL YEAR	SHEET NO.	TOTAL SHEETS
HAWAII	HAW.	83B-01-96M	1996	4	5

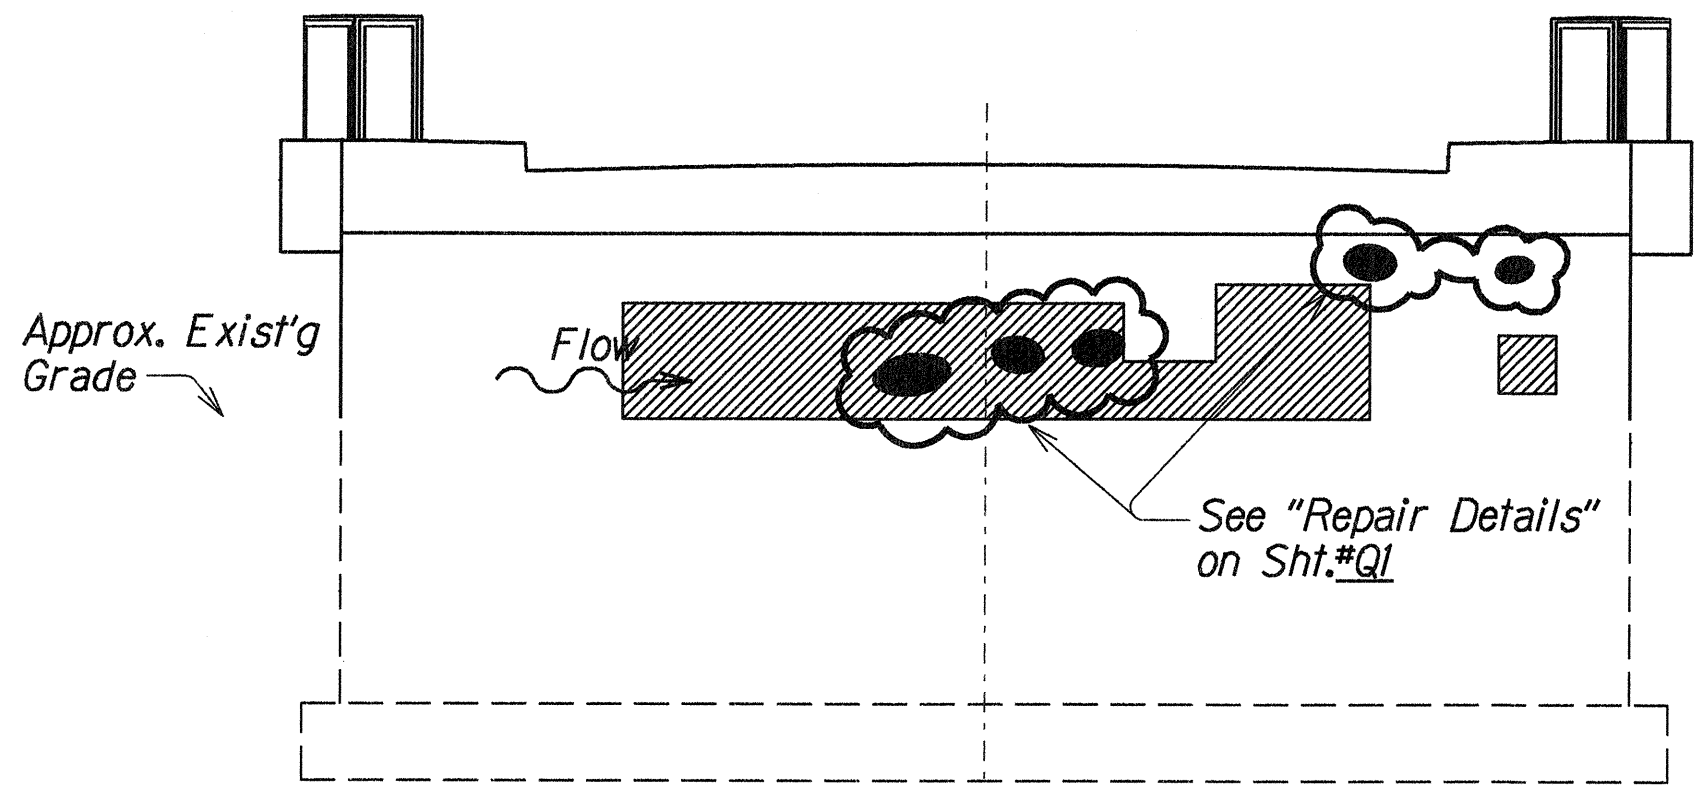


HALEIWA ABUTMENT ELEVATION
Scale: 1" = 5'-0"

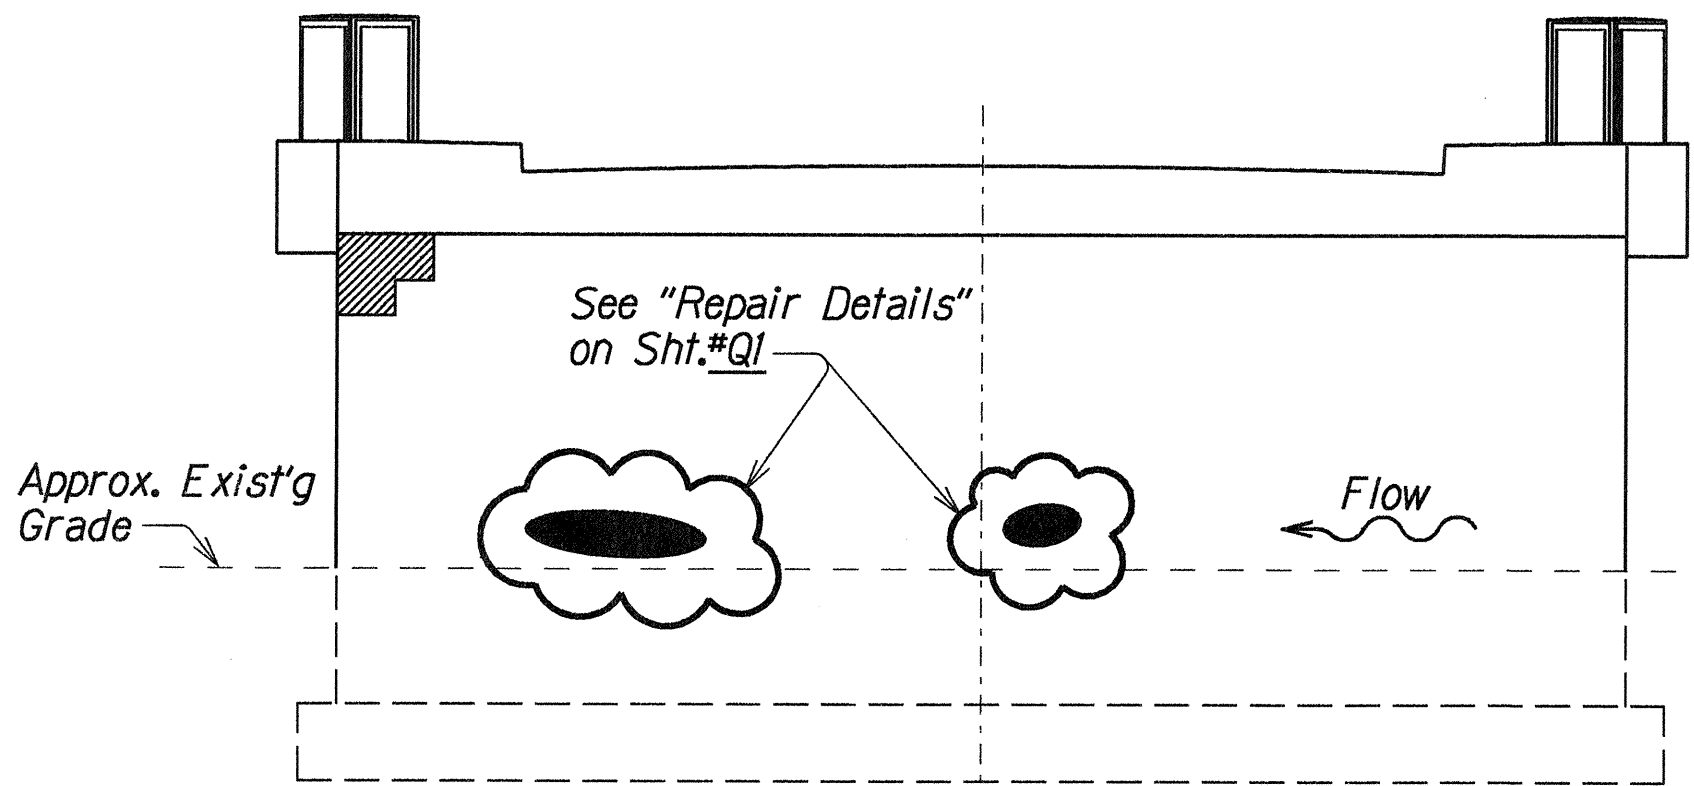


PUPUKEA ABUTMENT ELEVATION
Scale: 1" = 5'-0"

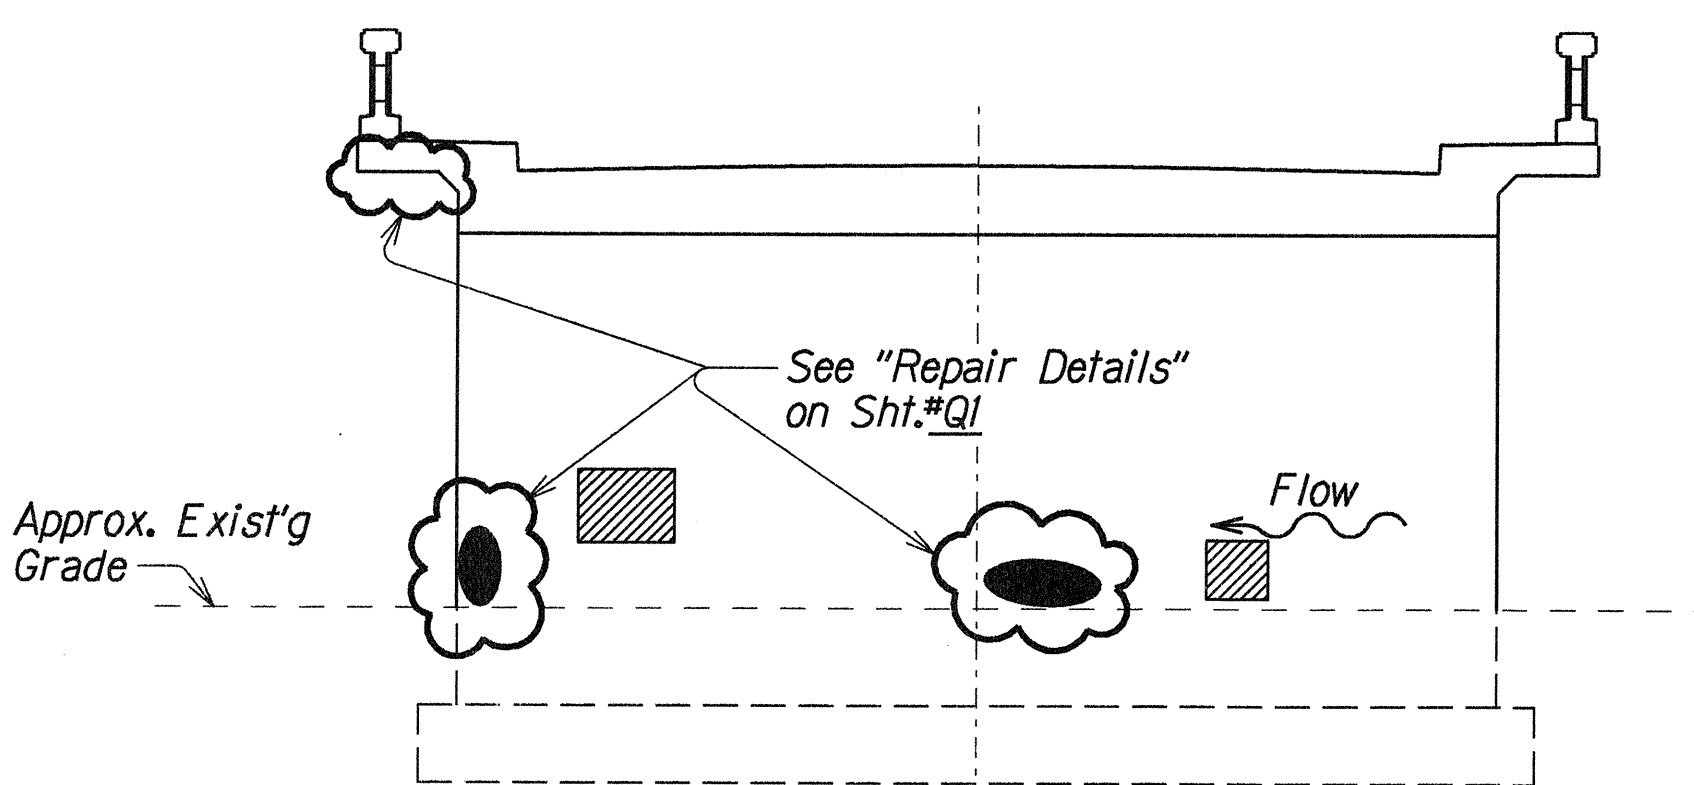


HALEIWA SIDE PIVOT WALL ELEVATION
Scale: 1" = 5'-0"

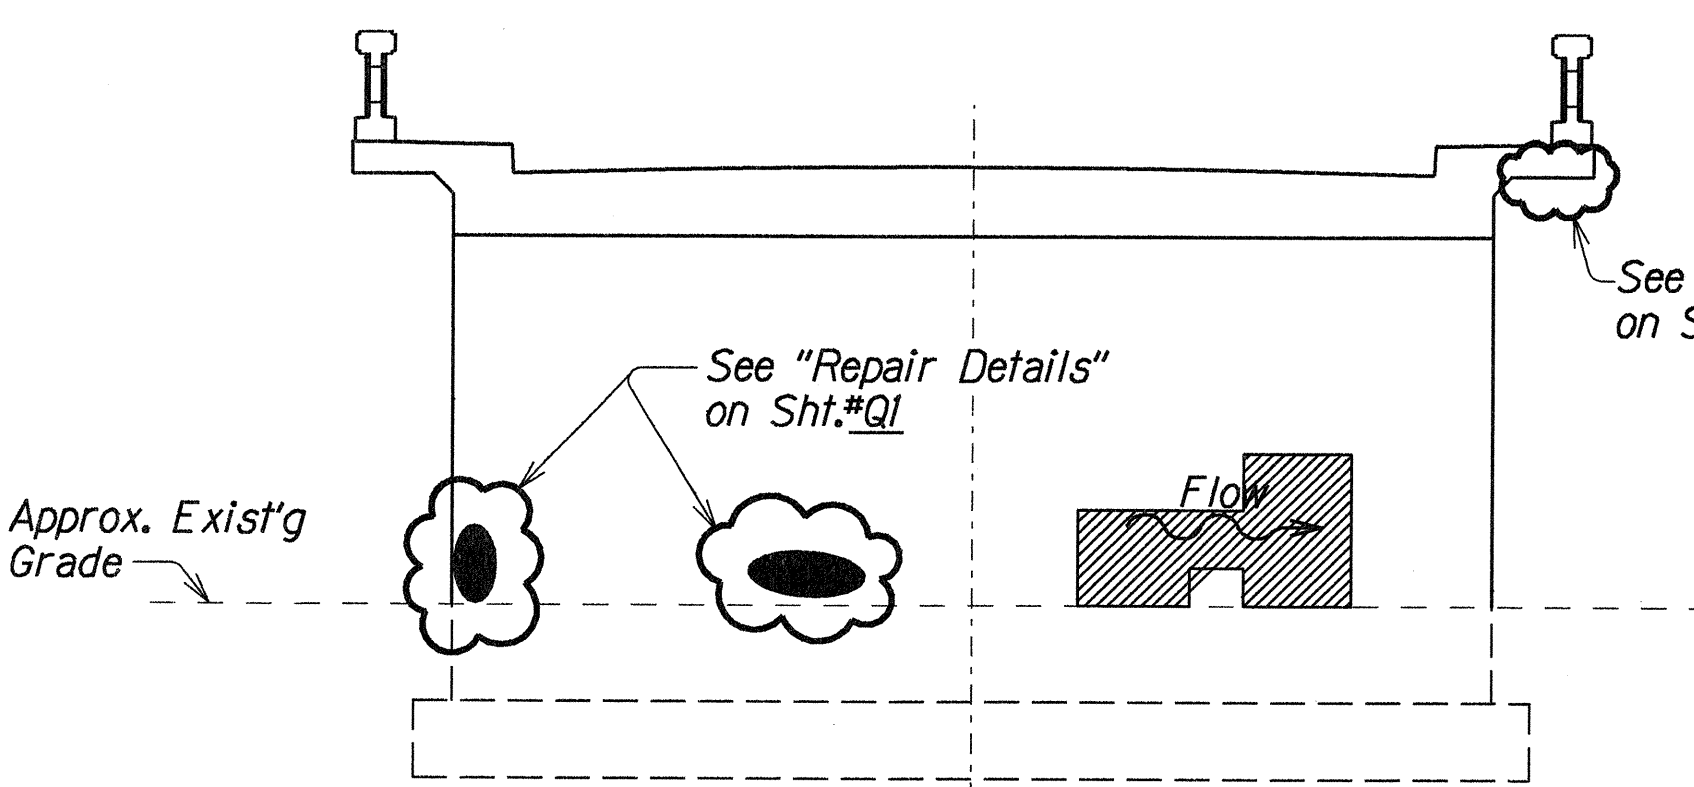

PUPUKEA SIDE PIVOT WALL ELEVATION
Scale: 1" = 5'-0"

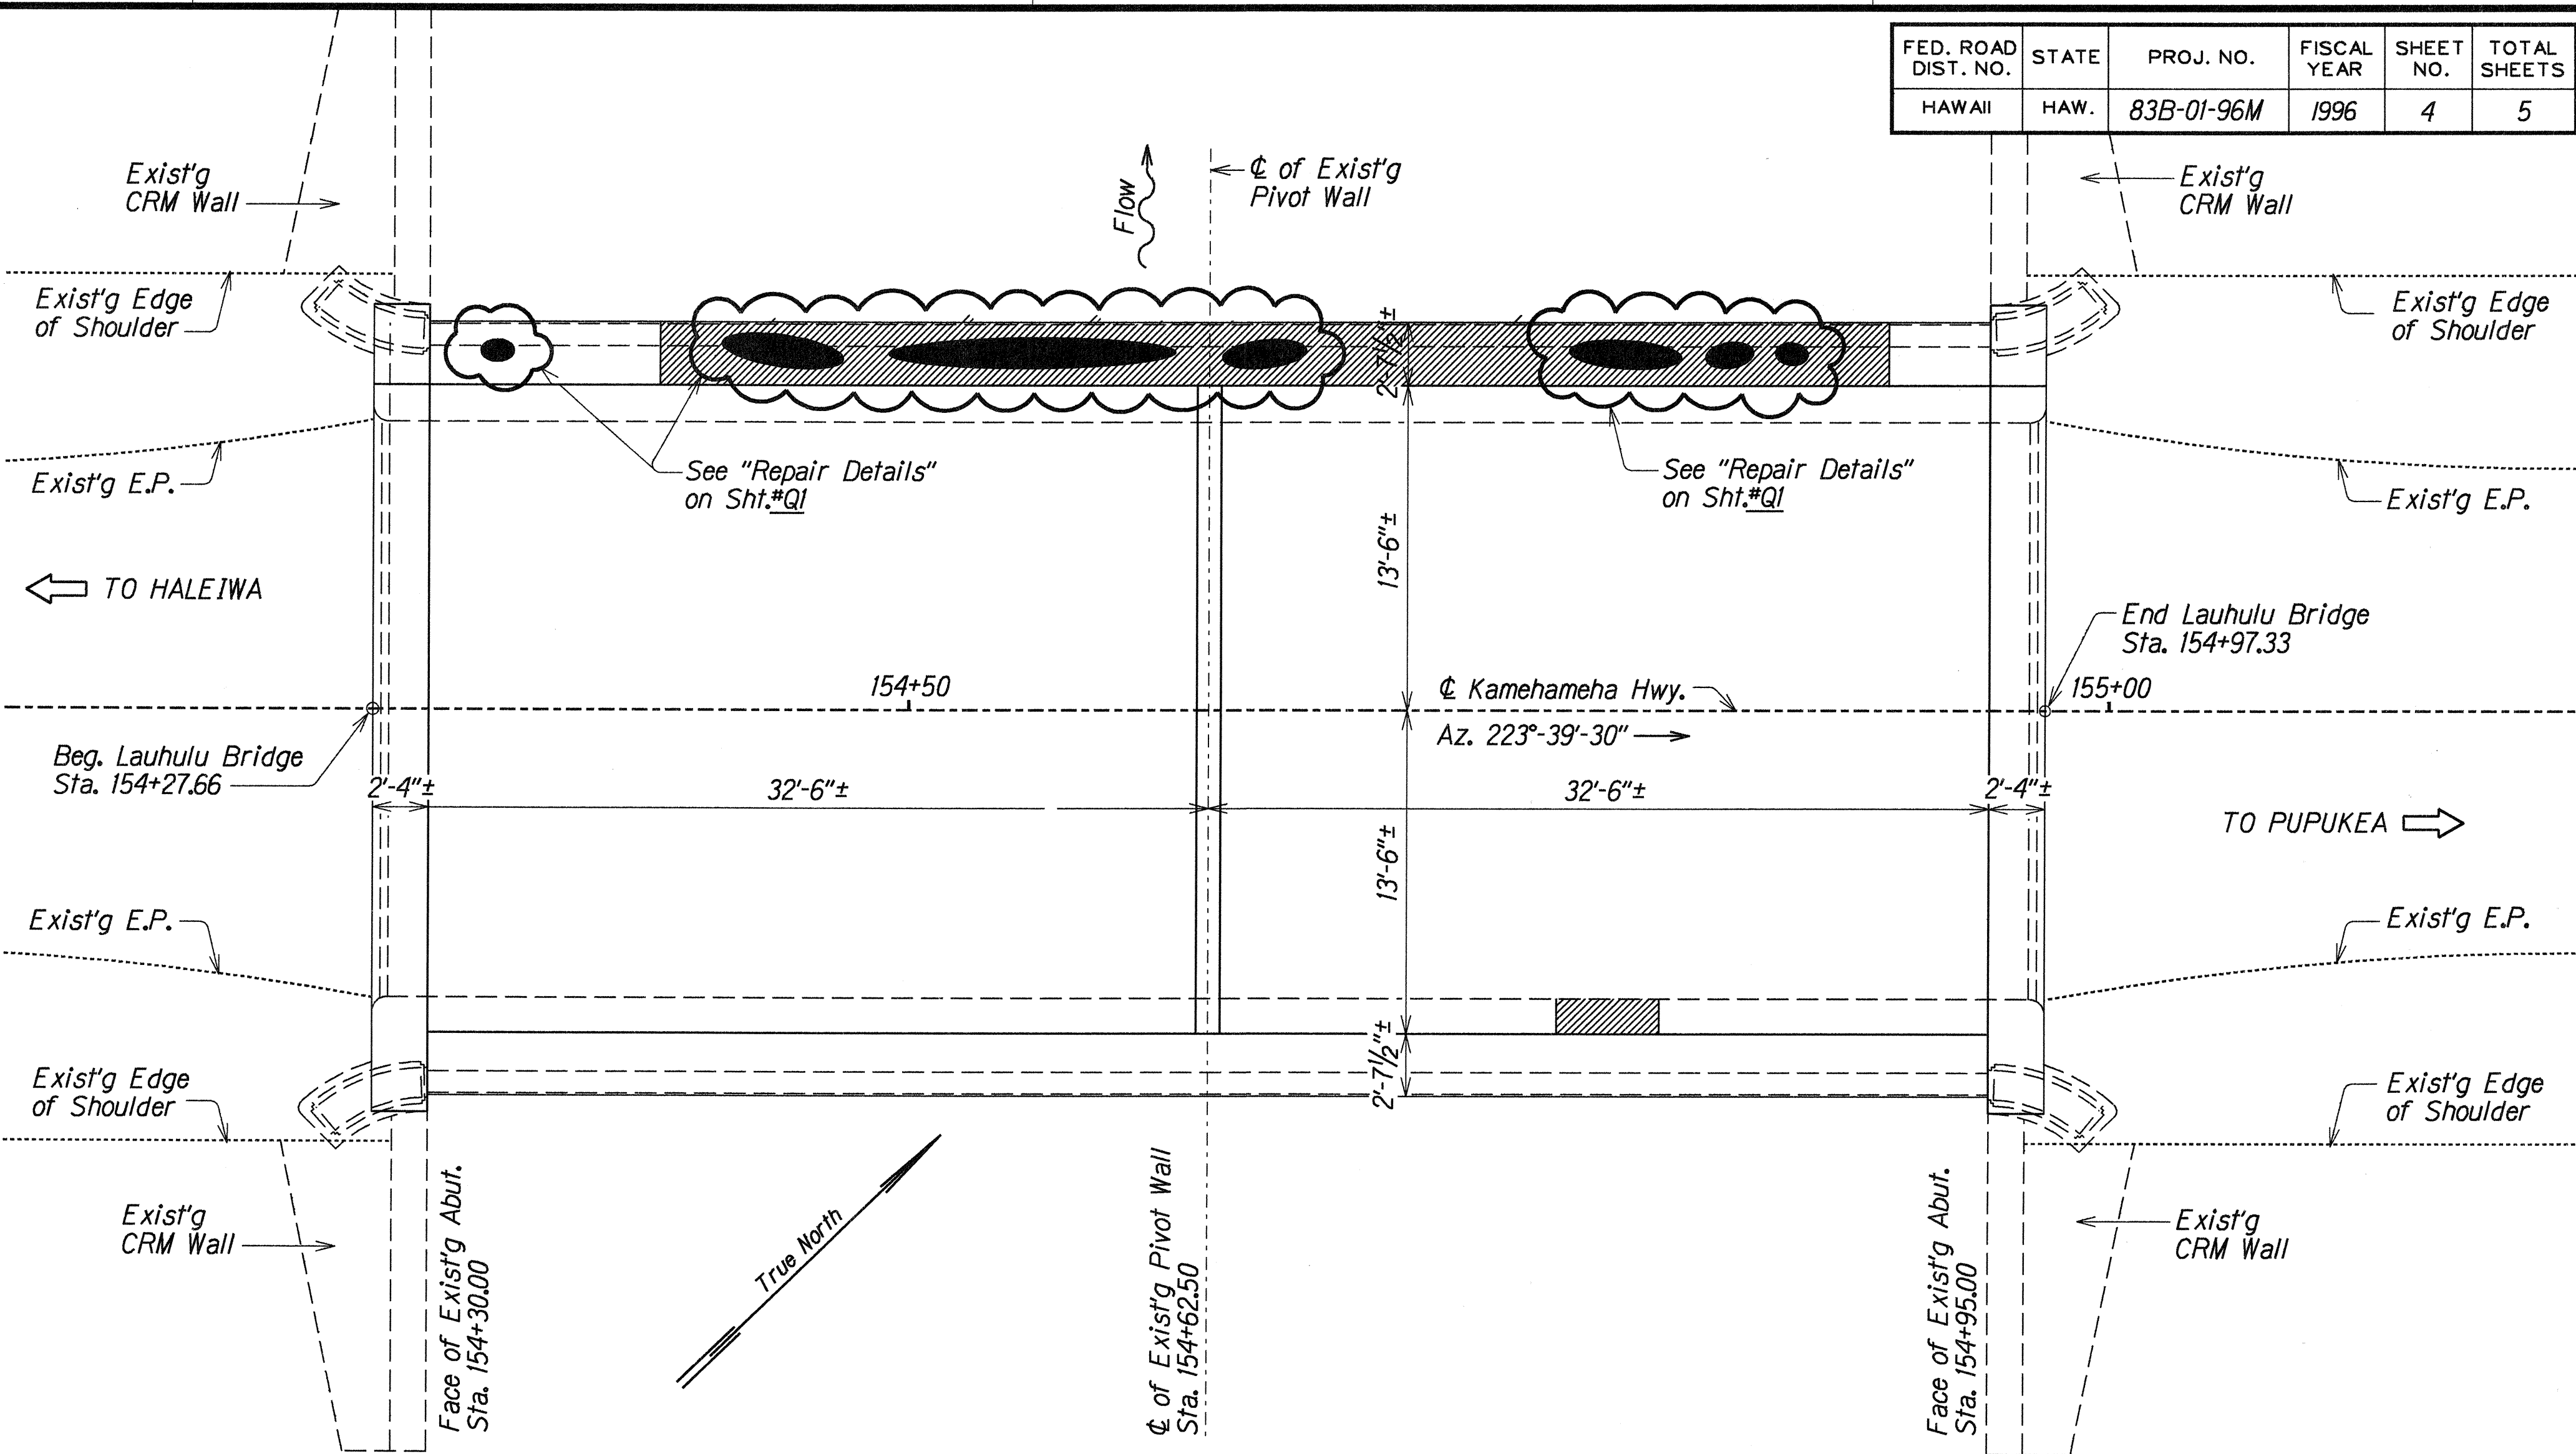

REFLECTED CEILING PLAN
Scale: 1" = 5'-0"

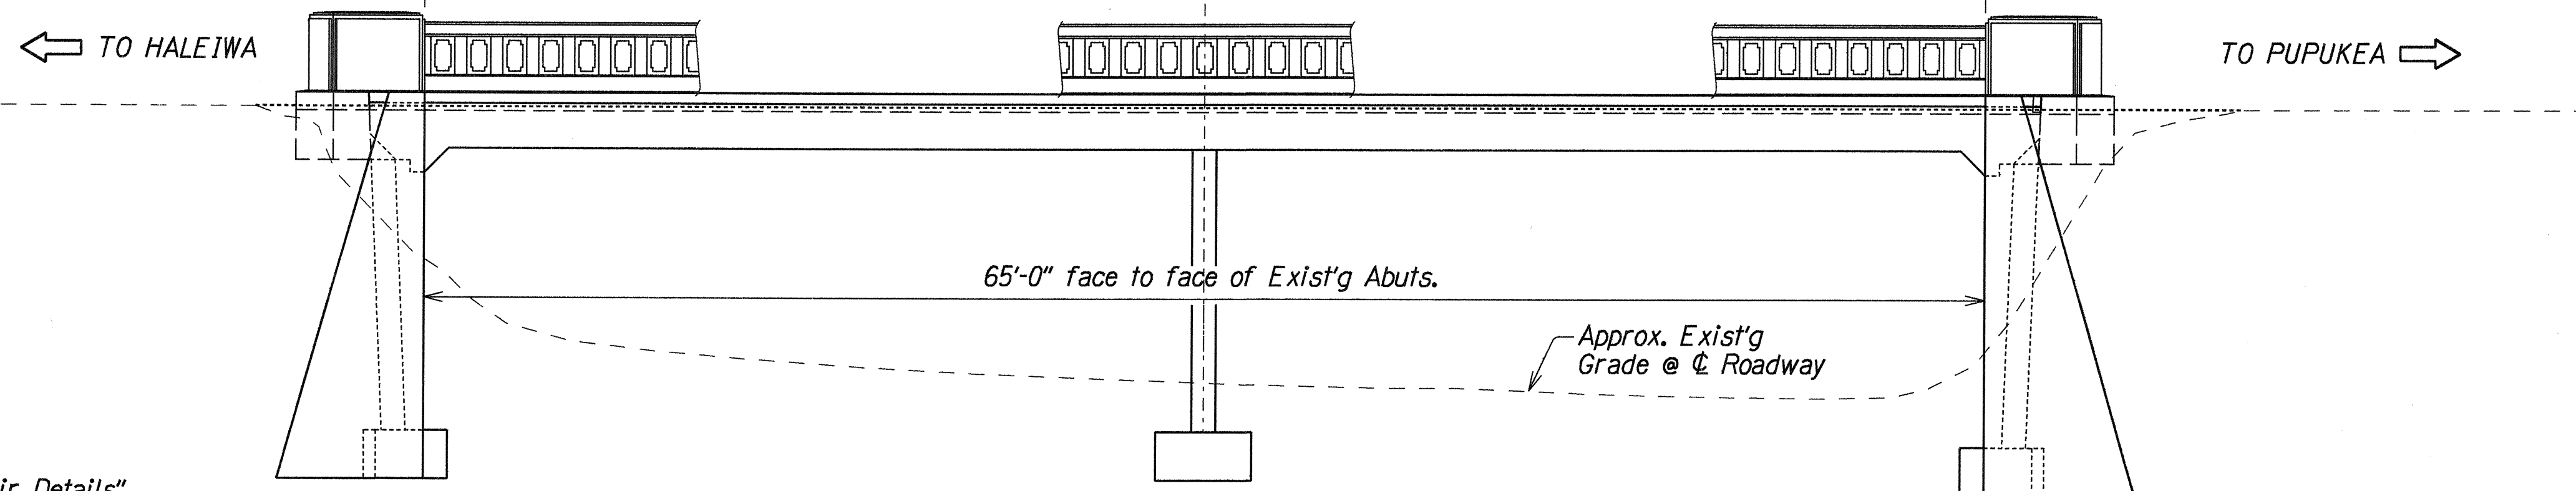

ELEVATION
Scale: 1" = 5'-0"

Notes:
Install New Construction Warning Sign CW20-1d with posts (2 each), at Sta. 149+27± Rt. and Sta. 159+97± Lt. Install New Construction Warning Sign CG20-2 with posts (2 each), at Sta. 149+27± Lt. and Sta. 159+97± Rt. These signs shall be placed in addition to the required traffic control signs called for in Section 645 - Traffic Control. The construction warning signs shall be new and become the property of the State. The Contractor shall remove, clean and deliver the signs and posts to the Oahu District Baseyard or as directed by the Engineer upon completion of the project. The Contractor shall replace all existing pavement striping and markings which were damaged during his operations.

Indicates Additional Spall Repair locations.
Indicates Approximate Spall Location
Note: Spall locations are for illustrative purposes only. Actual location to be determined by the Engineer in the field.

STATE OF HAWAII
DEPARTMENT OF TRANSPORTATION
HIGHWAYS DIVISION

REFLECTED CEILING PLAN AND
ELEVATIONS

KAMEHAMEHA HIGHWAY
LAUHULU BRIDGE

Repair Spalls at Pile Bent and Soffit
Proj. No. 83B-01-96M

Scale: As Noted Date: Feb. 1996

SHEET No. Q2 OF 3 SHEETS

SURVEY PLOTTED BY	DATE
KSG	JAN 1996
DESIGNED BY	
TRACED BY	
QUANTITIES BY	
CHECKED BY	
NOTED BY	
LAUHULU LOG	