

GENERAL NOTES


FED. ROAD DIST. NO.	STATE	FED. AID PROJ. NO.	FISCAL YEAR	SHEET NO.	TOTAL SHEETS
HAWAII	HAW.	STP-083-K(35)	1996	3	40

- The scope of work for this project consists of constructing drainage pipe culvert, concrete gutter and grated drop inlet.
- The Contractor is reminded of the requirements of Subsection 108.01 - Subletting of Contract, which requires him to perform work amounting to not less than 50 percent of the total contract cost less deductible items. Non-compliance with this Subsection may be grounds for rejection of bid.
- The Contractor's attention is directed to the following Sections of the Special Provisions : Subsection 107.13 - Public Convenience and Safety; Subsection 107.21 - Contractor's Responsibility For Utility Property And Services; and Section 645 -Traffic Control.
- At the end of each day's work, the Contractor shall remove all equipment and other obstructions to permit free and safe passage of public traffic.
- The existence and location of underground utilities, manholes, monuments and structures as shown on the plans are from the latest available data but the accuracy is not guaranteed. The encountering of other obstacles during the course of work is possible. The Contractor shall be held liable for any damages incurred to the existing facilities and/or improvements as a result of his operations.
- The Contractor shall notify in writing, the Oahu Transit Services, Inc. Roads Supervision Office, 811 Middle St., Hon., HI 96819 (ph. #848-4571) seven (7) days prior to any paving operations.
- The Contractor shall notify the Engineer in writing, two (2) weeks prior to starting paving operations.
- ~~The State's Contractor shall coordinate the signal corps cable adjustment work with Hawaiian Telephone Company (HTCO) and/or its Contractor. Excavation work done by the State's Contractor shall be considered incidental to the various contract items and no additional payment will be made.~~
- All holes, depressions and wheel ruts shall be filled and compacted with Asphalt Concrete Pavement, Mix No. V prior to paving. This work will be considered incidental to various contract items.
- Smooth riding connections shall be constructed at paving limits, including the adjacent lane as shown on the plans and/or as directed by the Engineer.
- Existing drainage system will be functional at all times during construction. The Contractor is to furnish materials, equipment, labor, tools and incidentals necessary to maintain flow. This work shall be considered incidental to various contract items.
- Earth swale shall be graded to drain. This work shall be considered incidental to the various contract items.
- The "General Plan For Utilities" plan sheet shall not be used for construction of drainage facilities.
- Contractor shall restore areas disturbed by its operations to the satisfaction of the Engineer in the field. Cost for this work will be considered incidental to the various contract items.
- Baseline azimuth and point coordinates of "Waimea" origin are for reference only.

# Station	Coordinate	
230+00	7403.1290N	3072.2126E
280+00	10871.7098N	6673.4551E
304+00	12604.1056N	8333.0942E

LEGEND

—e—	Existing Electrical Line
°pp	Existing Power Pole
—sc—	Existing Signal Corps Cable
—w-12—	Existing 12" Water Line
°wmh	Existing Water Manhole
°wv	Existing Water Valve Box
°fh	Existing Fire Hydrant
—s-12—	Existing Sewer Line
°smh	Existing Sewer Manhole
©mon	Existing Monument
---d-24---	Existing 24" Drain Line
<u>24" RCP</u>	New 24" RCP Drain Line
°dmh	Existing Storm Drain Manhole
°SDMH	Adjusted Storm Drain MH Frame/Cover
•SDMH	New Storm Drain Manhole
□gdi	Existing Grated Drop Inlet
□GDI	New Grated Drop Inlet
cb	Existing Catch Basin
CB	New Catch Basin
p	Existing Traffic Sign

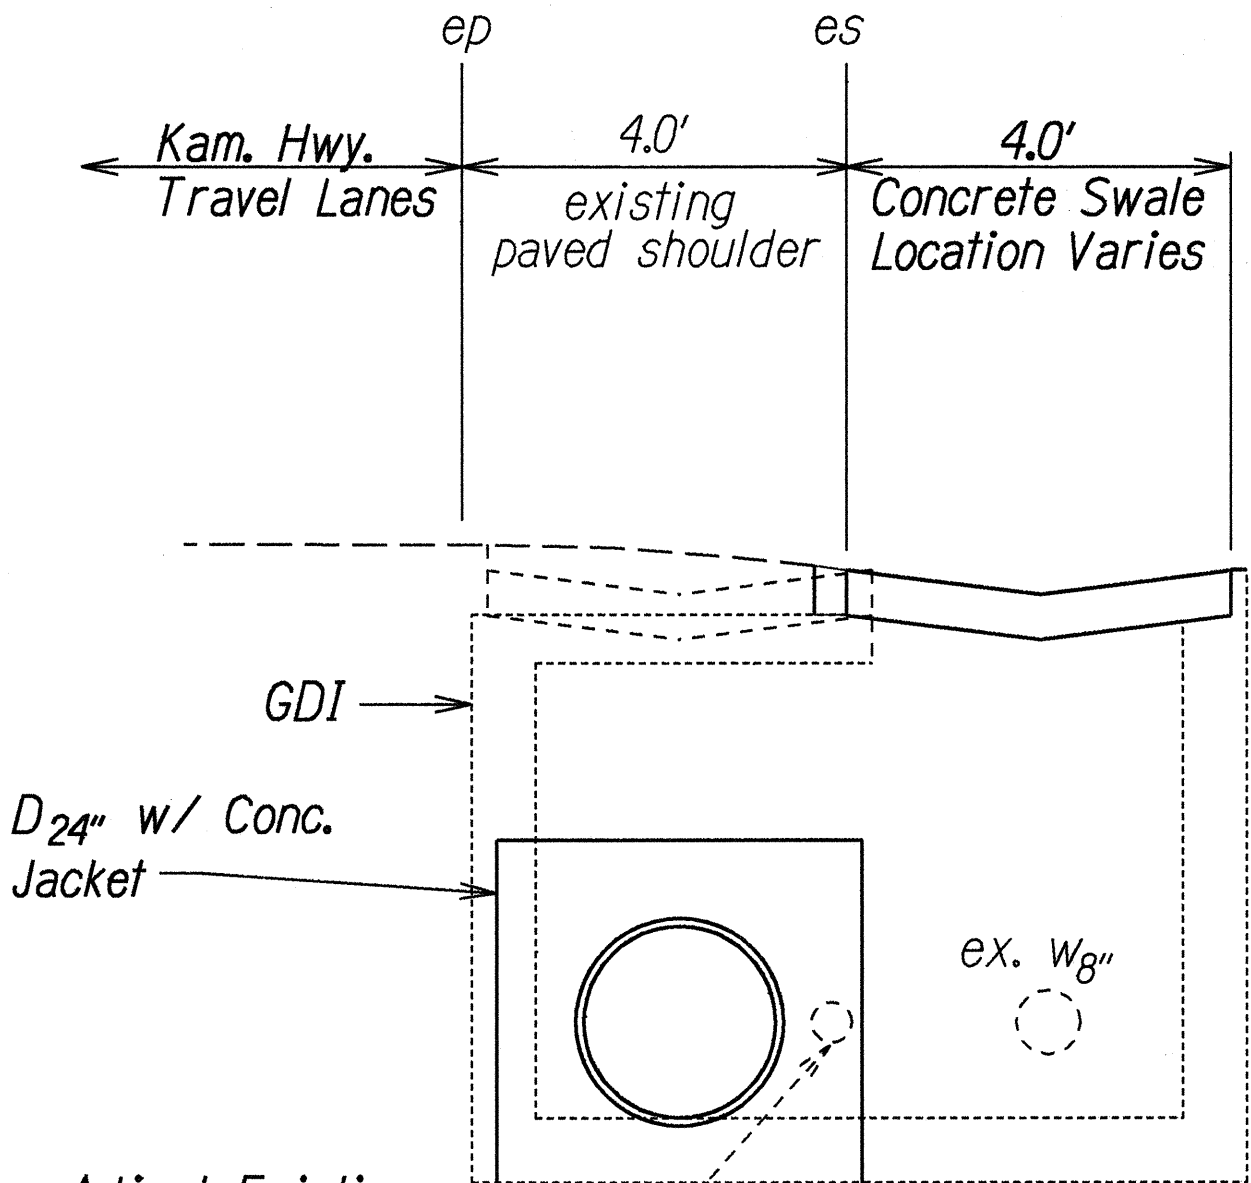

DETAIL
Not to Scale

LEGEND FOR AS-BUILT POSTINGS	
~~~~~	Squiggly line for as-built deletion
==	Double line for as-built deletion
Roadway	Text for as-built posting

STATE OF HAWAII DEPARTMENT OF TRANSPORTATION HIGHWAYS DIVISION
<b>GENERAL NOTES &amp; LEGEND</b>
KAMEHAMEHA HWY. DRAINAGE IMP. Vic. of Sunset Beach Elementary School Federal Aid Project No. STP-083-K(35)

Date: Feb., 1996

SHEET No. 1 OF 1 SHEETS

"AS-BUILT"