| | INDEX TO DRAWINGS | | | | |
|-----------|----------------------------------|--|--|--|--|
| SHEET NO. | DESCRIPTION | | | | |
| 1 | TITLE SHEET | | | | |
| 2 | STANDARD PLANS SUMMARY | | | | |
| 3 | GENERAL NOTES & LEGEND | | | | |
| 4 | NPDES NOTES | | | | |
| ① 5 – 28 | DRAINAGE PLAN & PROFILE | | | | |
| 3 - 20 | AND DETAILS | | | | |
| 29 | TRAFFIC MARKING, DETAILS & NOTES | | | | |
| 30 – 40 | WATER UTILITY ADJUSTMENT PLAN, | | | | |
| 00 40 | DETAILS & NOTES | | | | |
| | | | | | |
| | | | | | |
① Plan sheet No. 24S-I is a supplementary sheet to this project. Total Sheet Count after "AS-BUILT" posting 41 sheets.

STATE OF HAWAII

DEPARTMENT OF TRANSPORTATION

HIGHWAYS DIVISION HONOLULU, HAWAII

"AS BUILT"


PLANS FOR

KAMEHAMEHA HIGHWAY DRAINAGE IMPROVEMENTS

VICINITY OF SUNSET BEACH ELEMENTARY SCHOOL FEDERAL AID PROJECT NO. STP-083-1(35)

> DISTRICT OF KOOLAULOA ISLAND OF OAHU

> > SCALE IN THOUSAND FEET

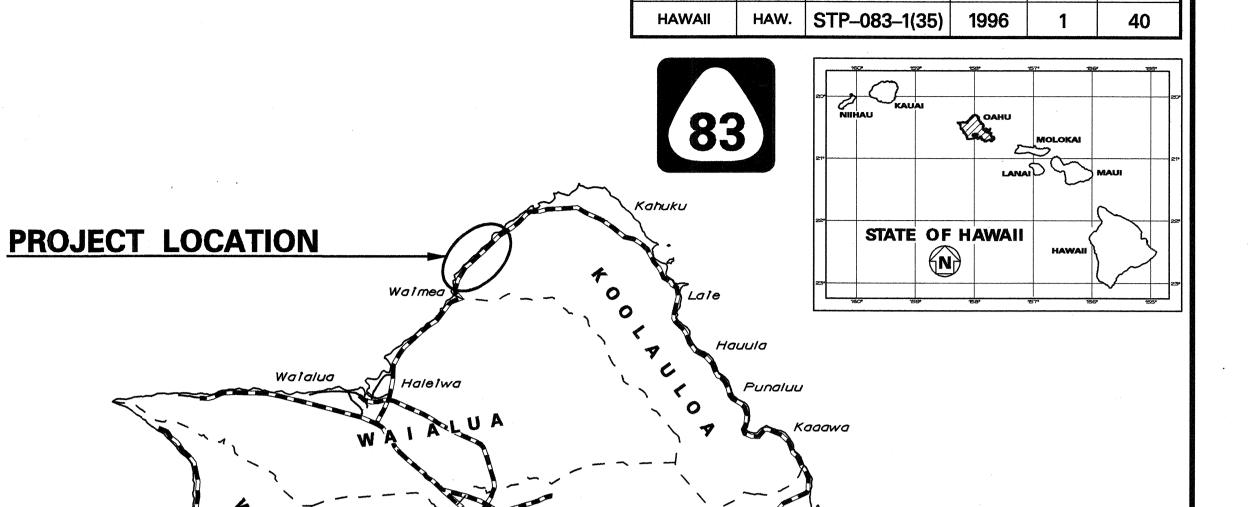

FED. ROAD DIST. NO.

FED. AID PROJ. NO.

FISCAL SHEET YEAR NO.

SCALE IN MILES FEDERAL AID PROJECTS PREVIOUSLY CONSTRUCTED OR UNDER CONSTRUCTION

MILE POST __7.52 TO MILE POST __9.18

DESIGN DESIGNATION

| ADT | (1995) | | 10,0 | 040 |
|-----------------|--------|------|------|-------|
| ADT | (2015) | | 10,8 | 350 |
| DHV | | | | 955 |
| D | | | 55 | /45 |
| T ₂₄ | | | 4.0 | % |
| ٧ | | | 45 | M.P.H |
| | | | | |

CHANGES MADE DURING CONSTRUCTION HAVE BEEN AND/OR COMPUTATION BOOK.

DEPARTMENT OF TRANSPORTATION STATE OF HAWAII

APPROVED:

DIR. OF TRANSPORTATION

Pacific PROJECT LOCATION O_{cean} KE WAENA ROAD PAUMALU BRIDGE SUNSET Waimea BEACH **ELEMENTARY** SCHOOL COMSAT WAIMEA BRIDGE — LOCATION PLAN GROSS LENGTH OF PROJECT.....1.66 MILES NET LENGTH OF PROJECT.....0.72 MILES

DATE