
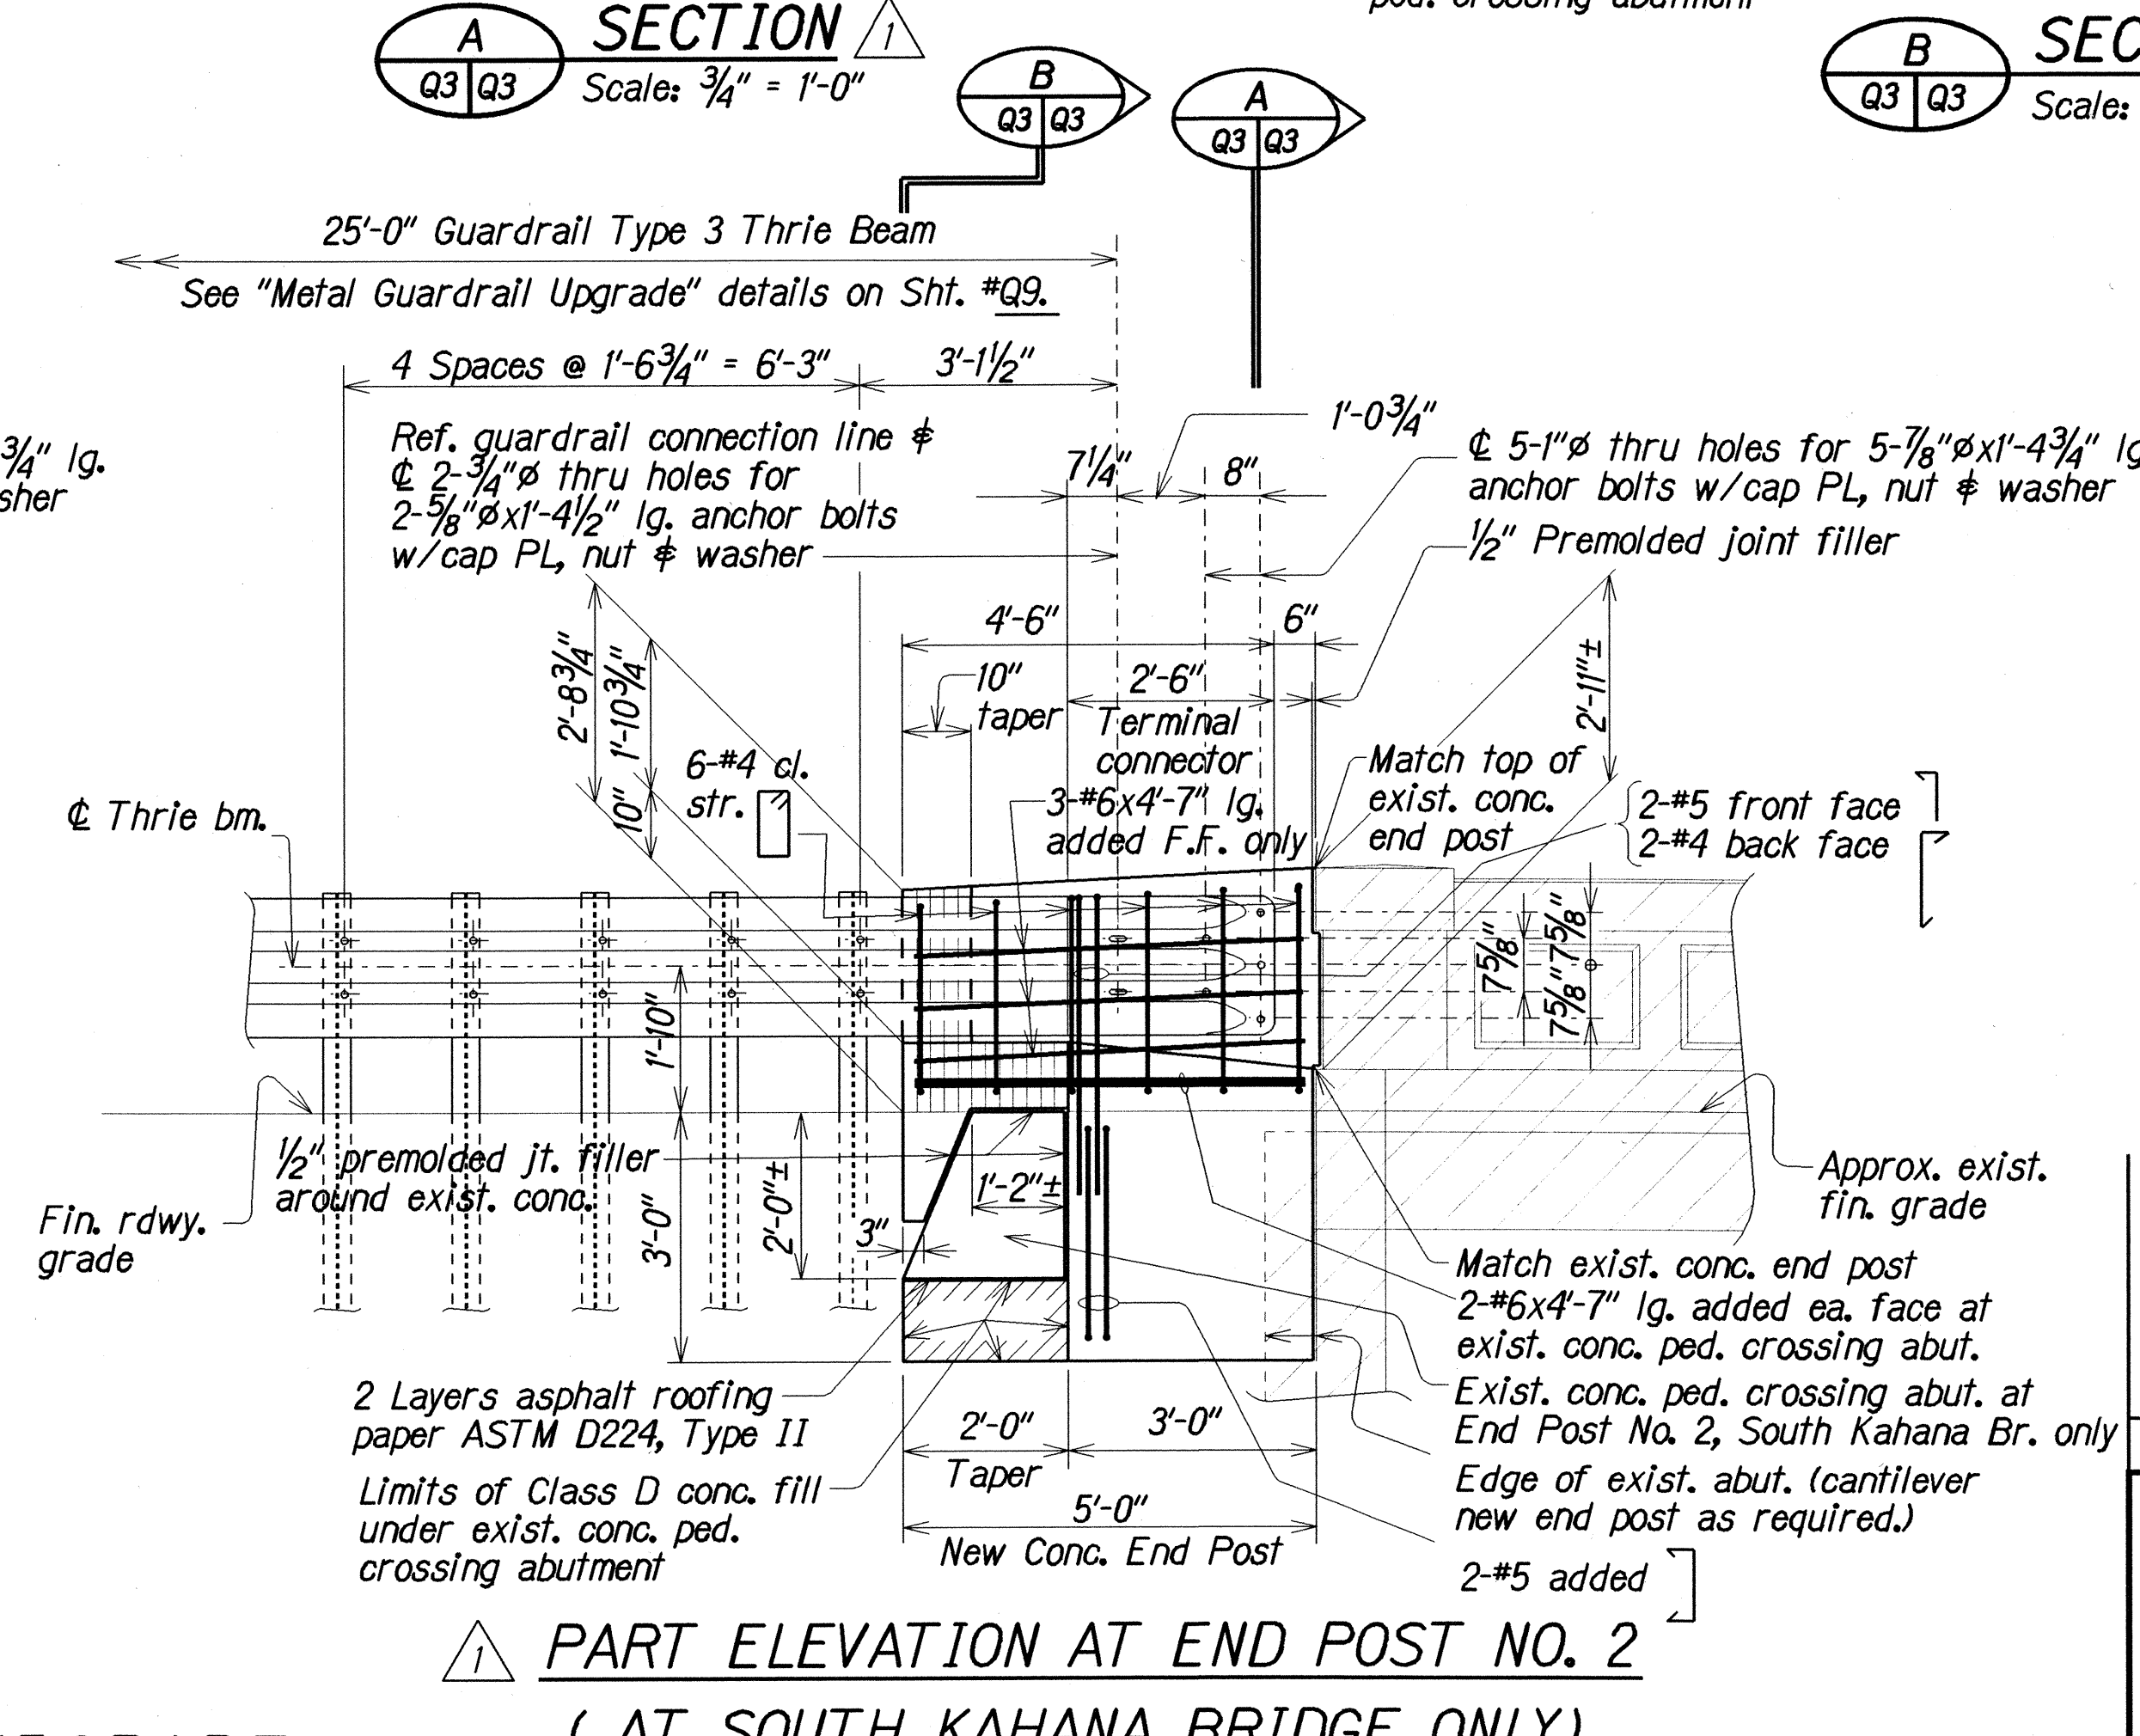
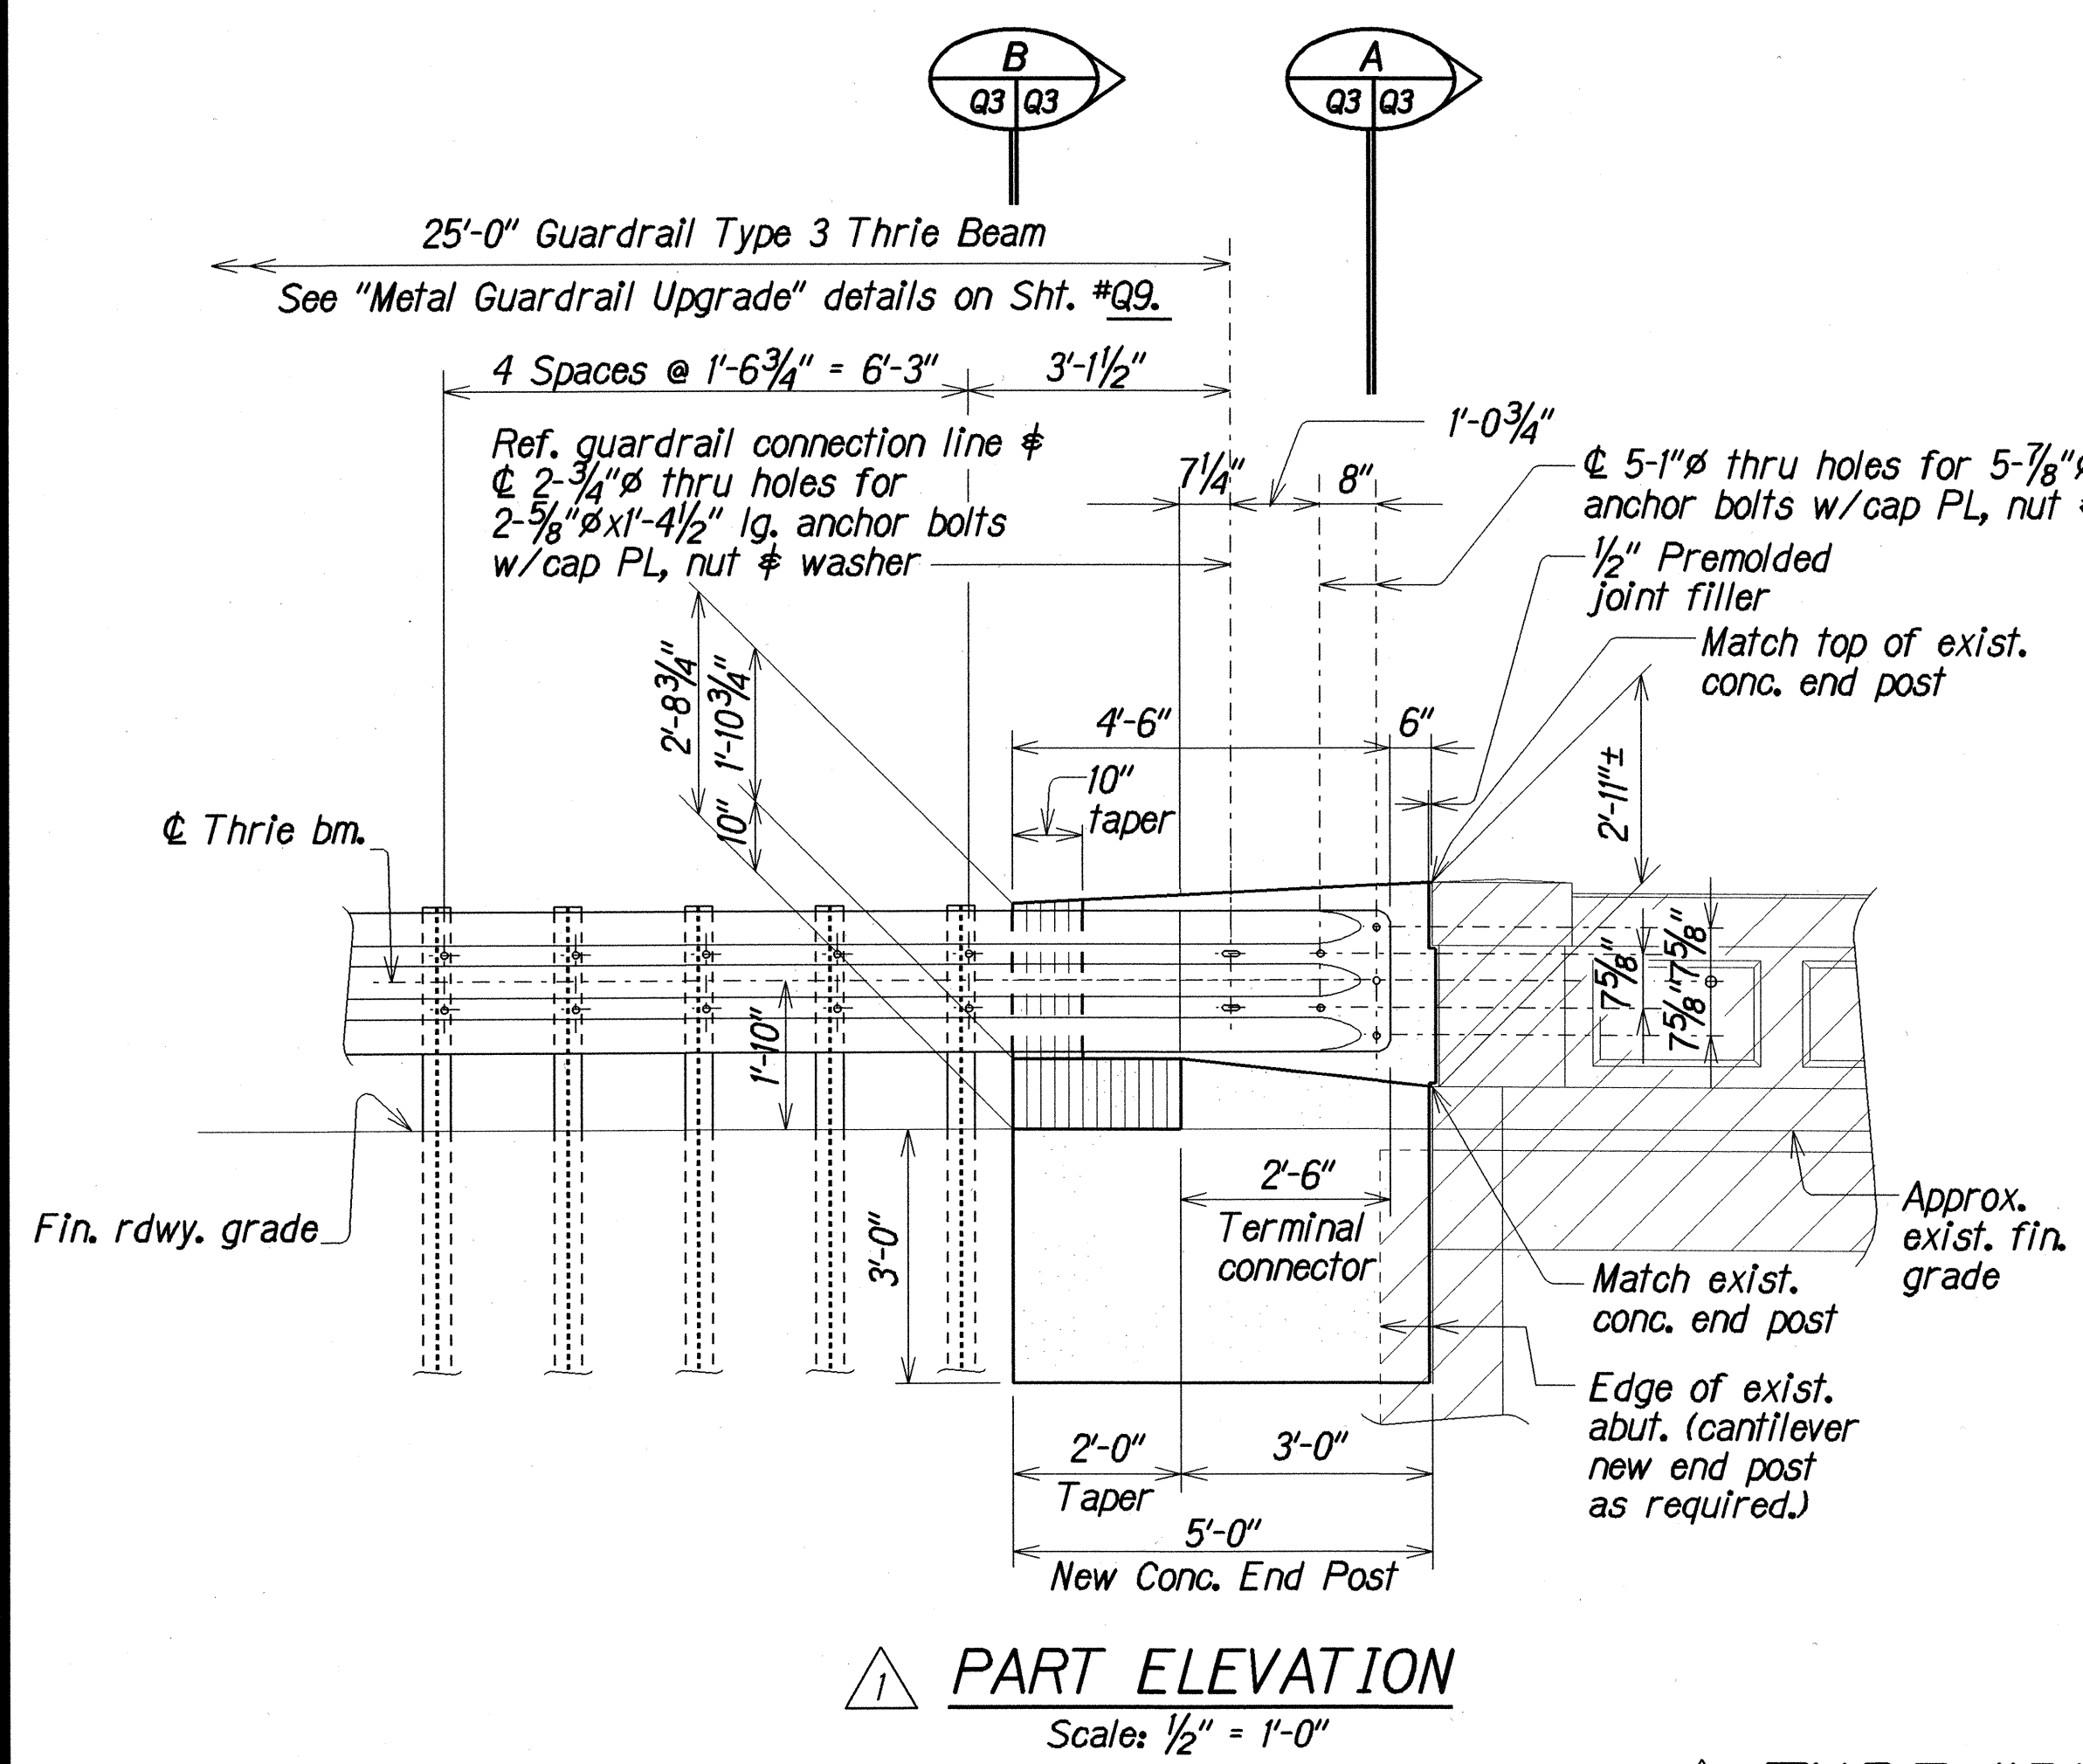
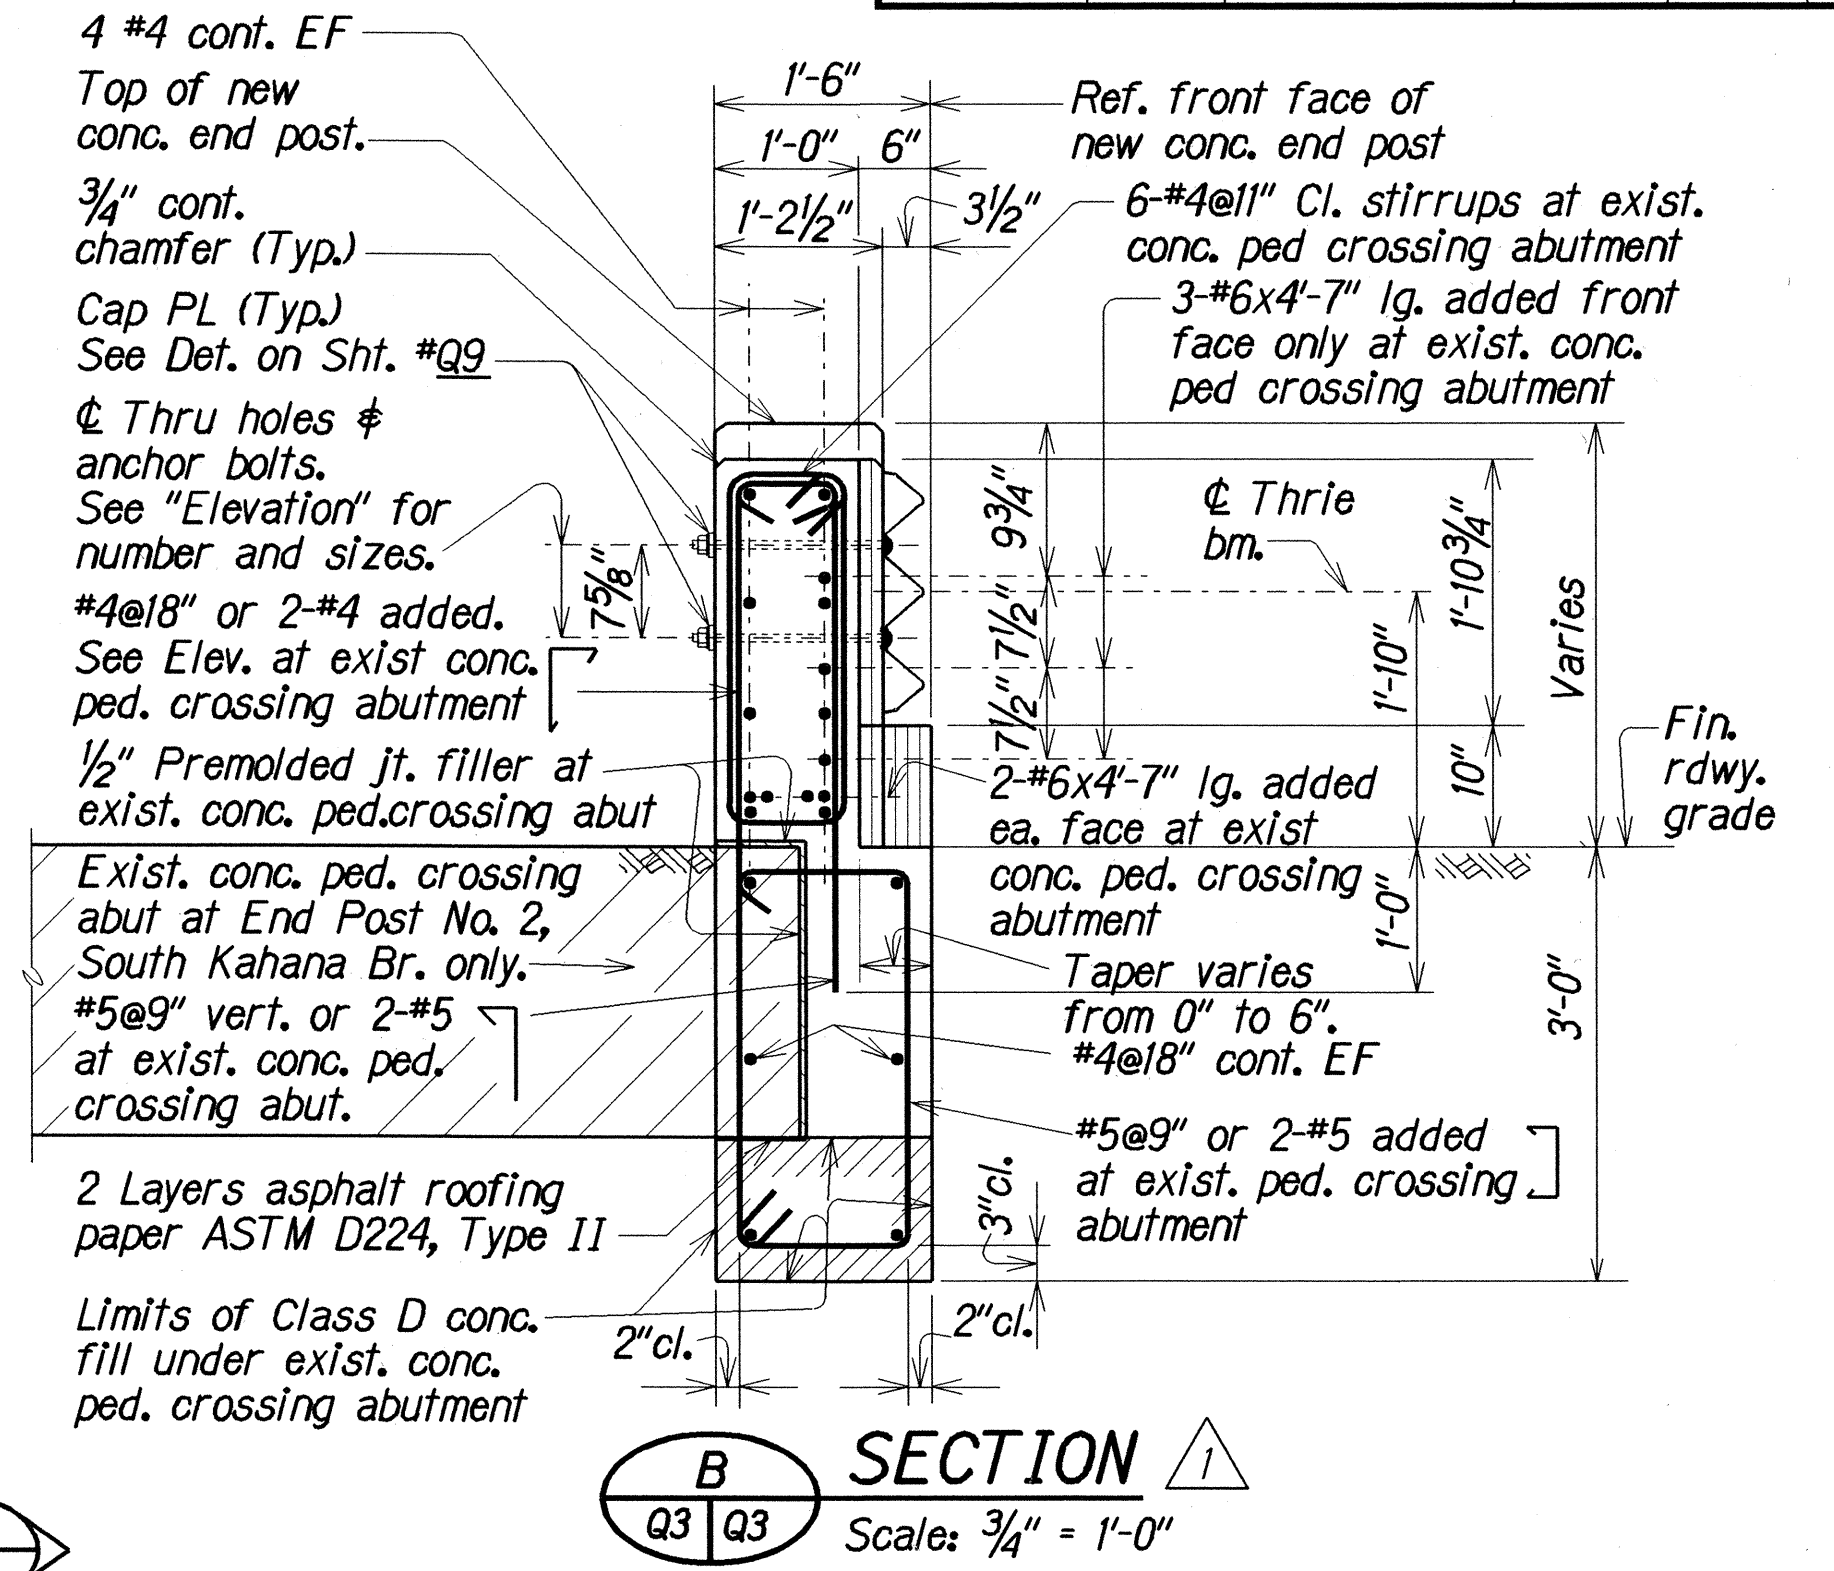
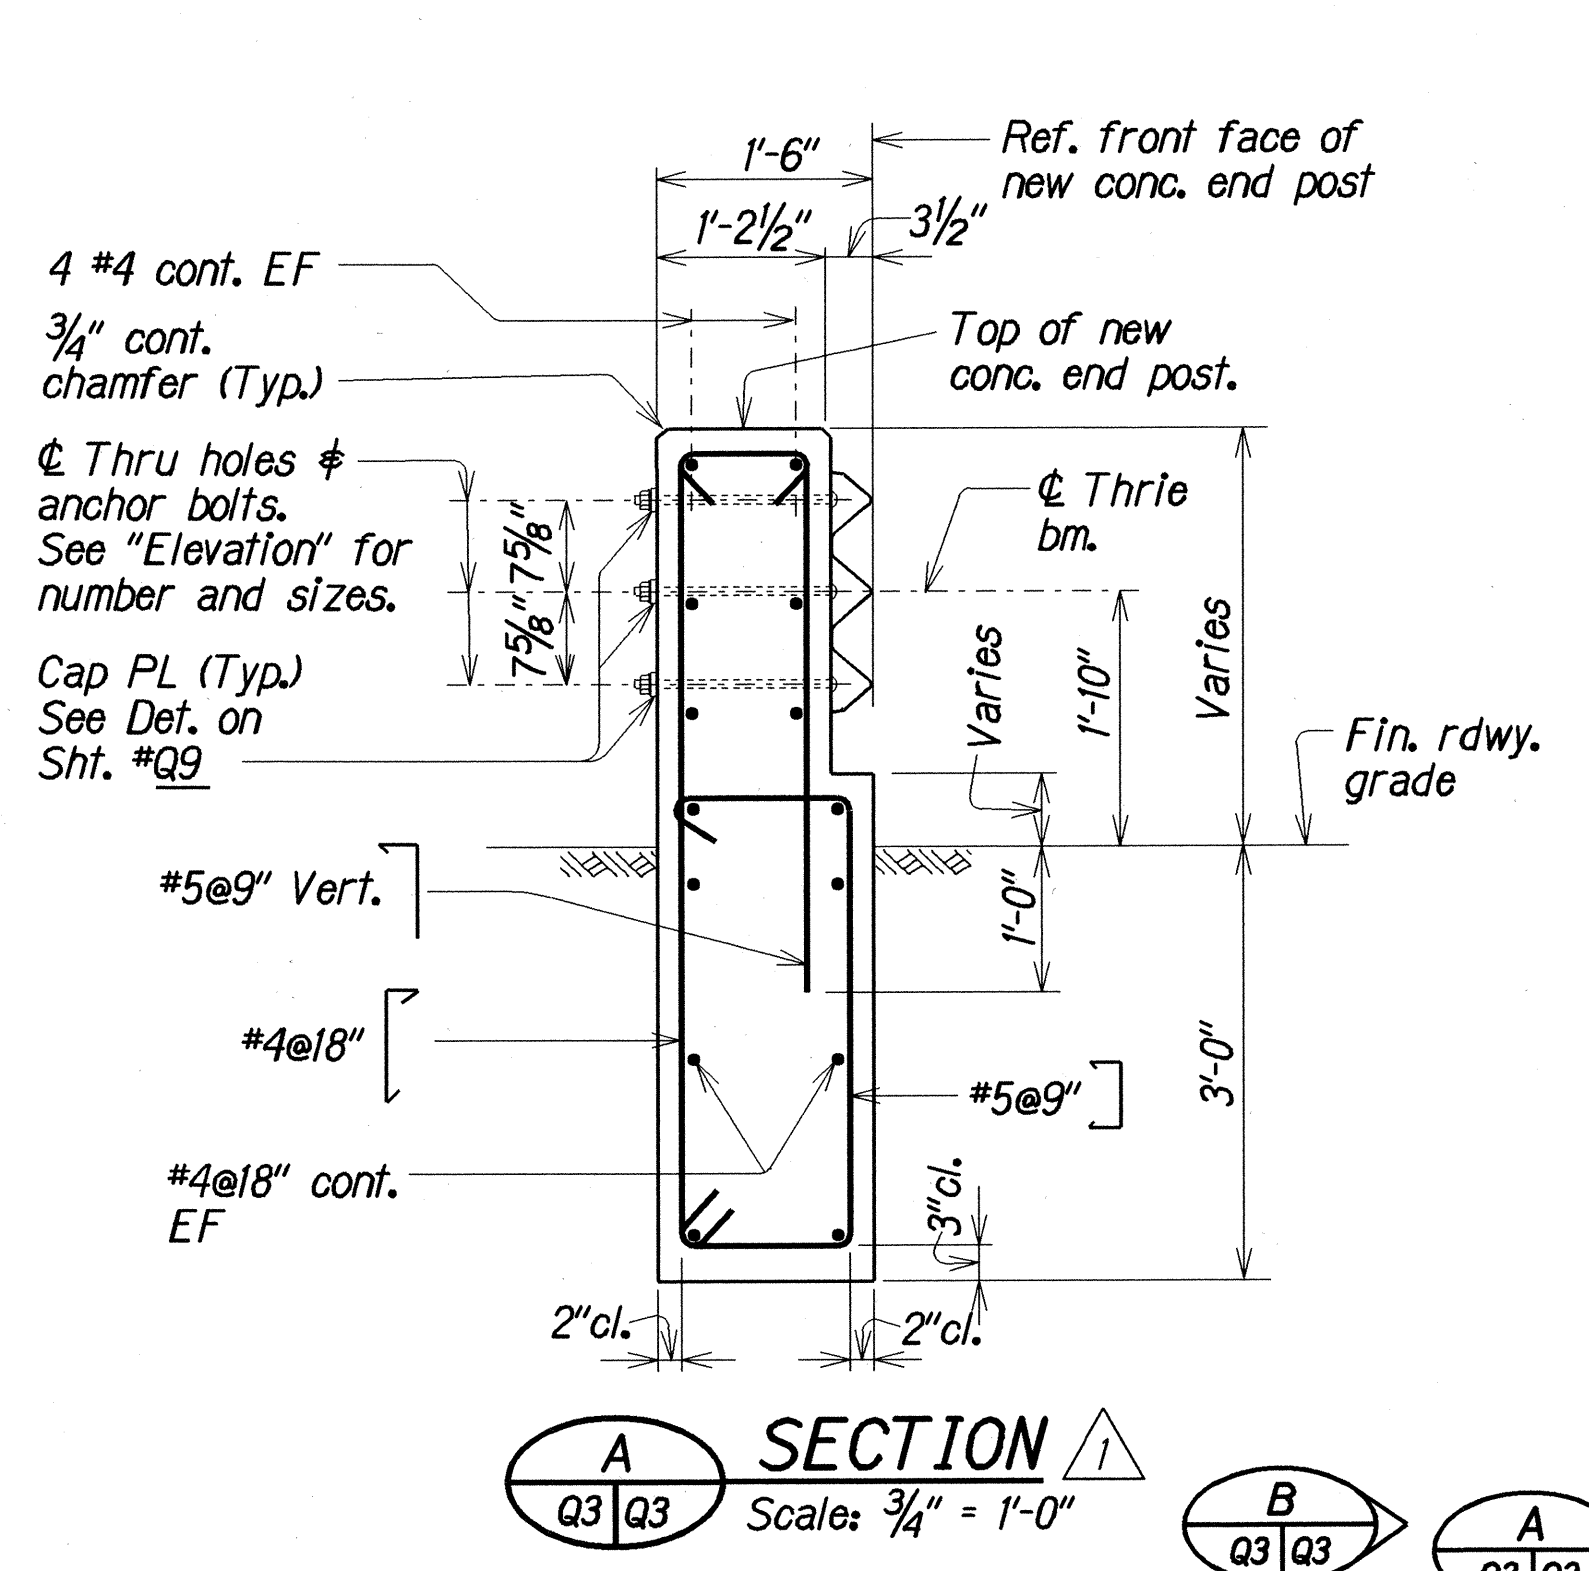


FED. ROAD DIST. NO.	STATE	PROJ. NO.	FISCAL YEAR	SHEET NO.	TOTAL SHEETS
HAWAII	HAW.	83D-01-96M	1996	C.O.29	50

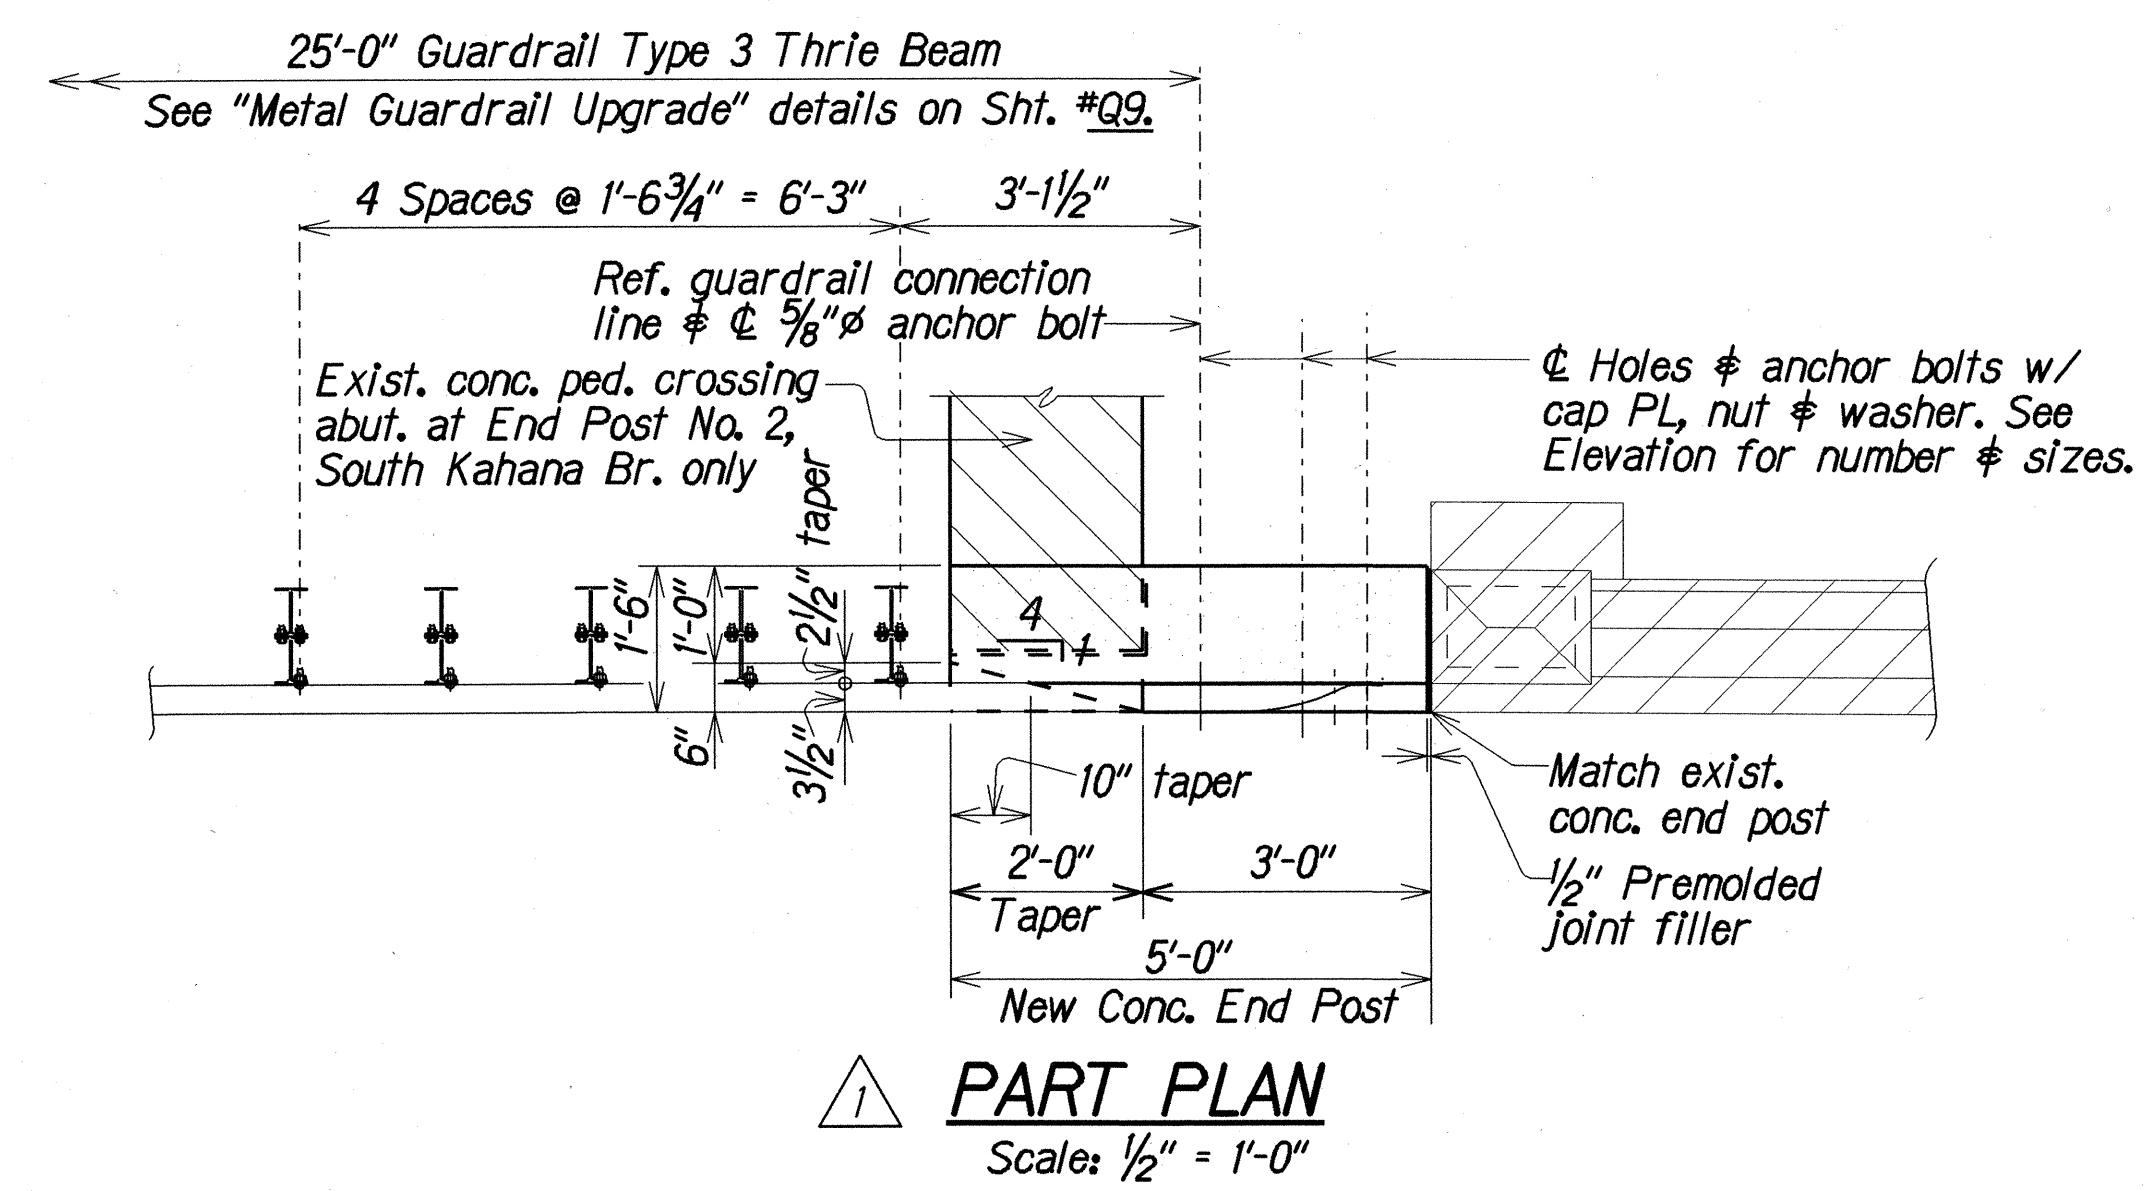

△ TYPE "B" UPGRADE

(AT SOUTH KAHANA, NORTH KAHANA, AND SOUTH PUNALUU BRIDGES)

Added detail and information to accommodate exist. conc. ped. crossing abut. at End Post No. 2, South Kahana Bridge. Dimensions, labels and details were moved to make space for additions.	2/11/97
DATE	REVISIONS
STATE OF HAWAII DEPARTMENT OF TRANSPORTATION HIGHWAYS DIVISION SOUTH KAHANA, NORTH KAHANA, AND SOUTH PUNALUU BRIDGES TYPE "B" UPGRADE - END POST CONNECTION KAMEHAMEHA HIGHWAY RESURFACING Crouching Lion to Puhuli Street Project No. 83D-01-96M Scale: As Noted Date: May 1996	

db3/usr2/lhm/nkam/bc3co29.dgn

DATE: May 1996
 DESIGNED BY: JFU
 CHECKED BY: JFU
 QUANTITIES BY: JFU
 DATE: May 1996