	INDEX TO DRAWINGS
SHEET NO.	DESCRIPTION
1	TITLE SHEET
2	STANDARD PLANS SUMMARY
3	TRAFFIC NOTES
4	TRAFFIC NOTES & PAVT. MARKING DETAILS
5	PAVEMENT MARKING & SIGNING PLAN
6	ELECTRICAL SYMBOLS, TYPICAL TRENCH SECTION, DEMOLITION NOTES
7	CONSTRUCTION NOTES
8	TRAFFIC SIGNAL PLAN
9	ONE-LINE DIAGRAMS, MISC. DETAILS
10- 14	TRAFFIC SIGNAL DETAILS
15	SIGN MOUNTING DETAIL

STATE OF HAWAII

DEPARTMENT OF TRANSPORTATION

HIGHWAYS DIVISION HONOLULU, HAWAII


"AS-BUILT"


PLANS FOR

KAMEHAMEHA HIGHWAY

INTERSECTION IMPROVEMENTS
AT KAHUKU HIGH SCHOOL
FEDERAL AID PROJECT NO. STP-083-1(36)

DISTRICT OF KOOLAULOA ISLAND OF OAHU

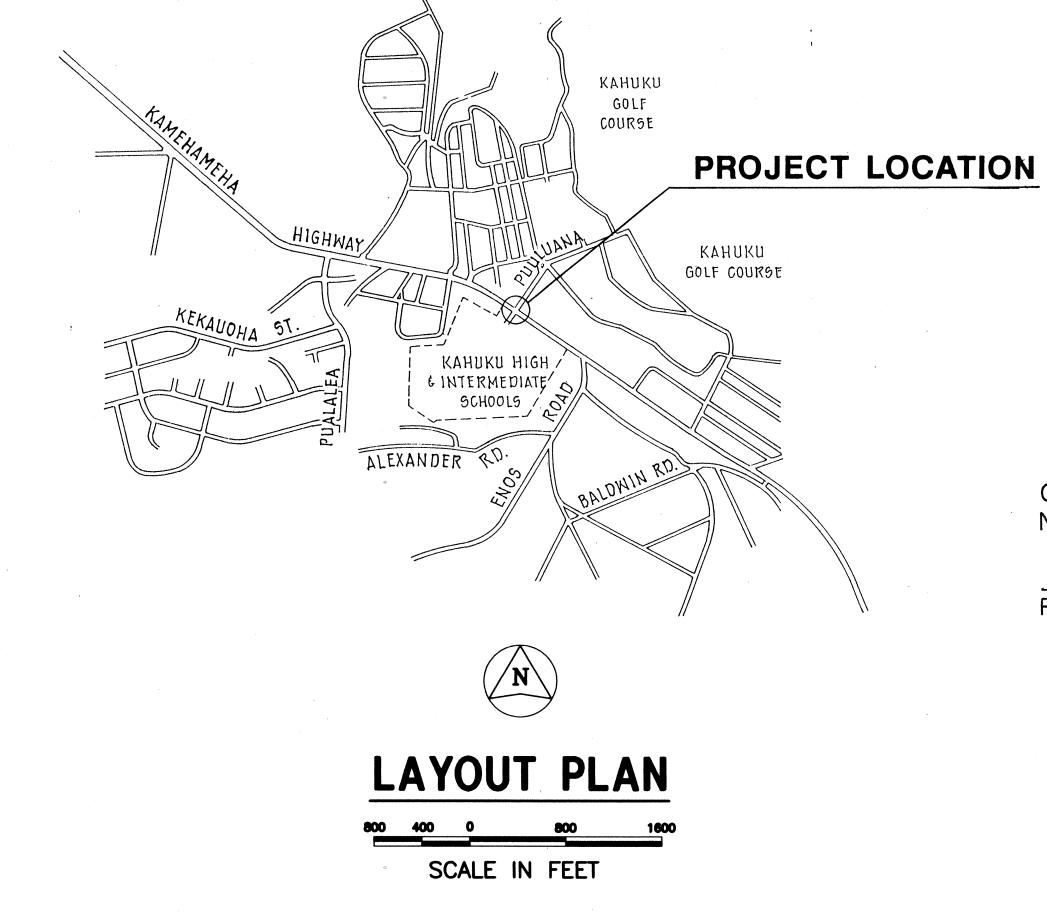

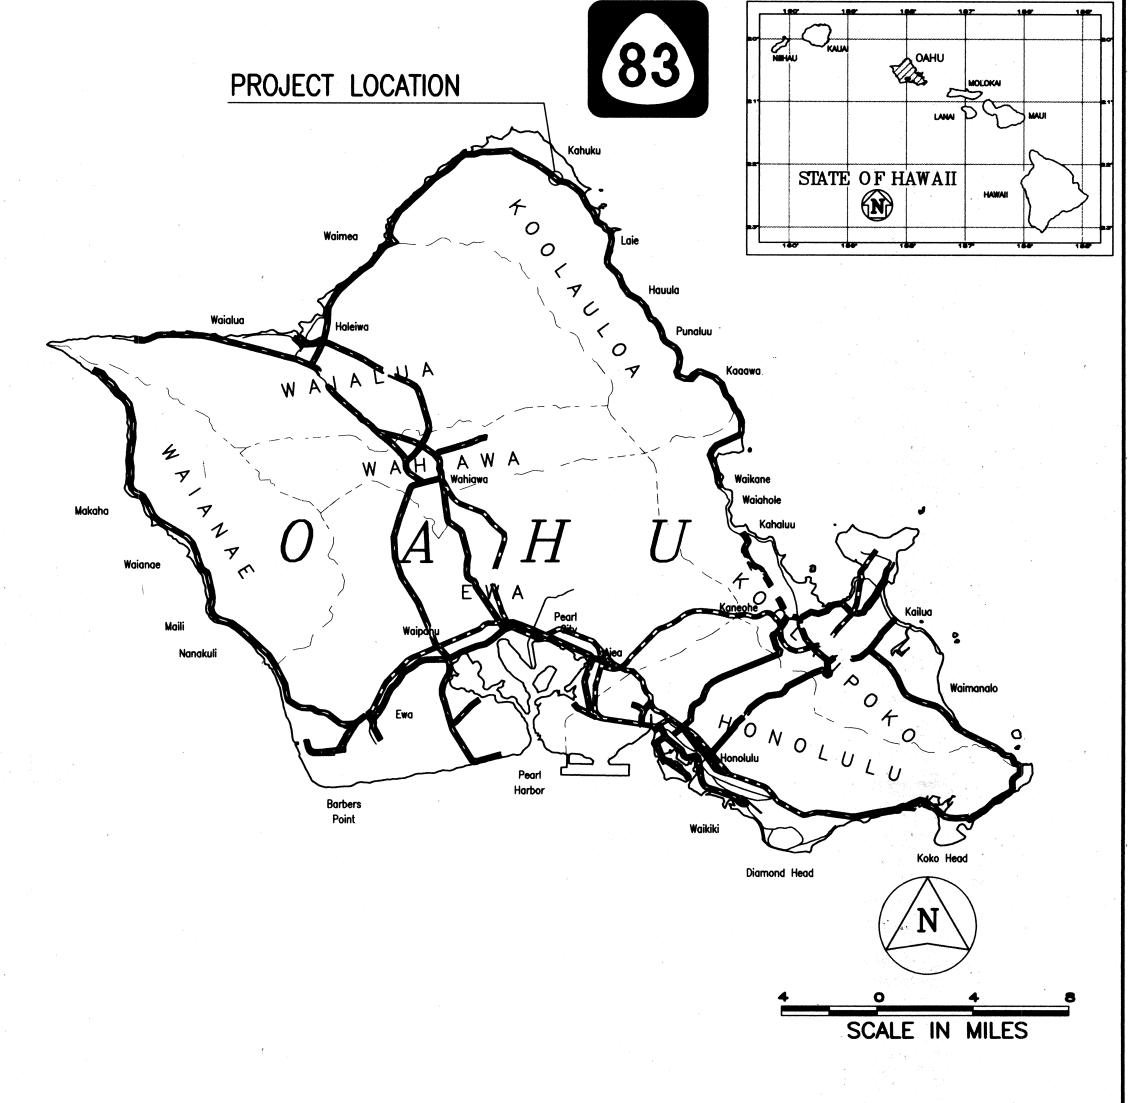

FEDERAL AID PROJECTS PREVIOUSLY CONSTRUCTED OR UNDER CONSTRUCTION

FED. AID PROJ. NO.

MILE POST <u>15.83</u> TO MILE POST <u>15.93</u>

CHANGES MADE DURING CONSTRUCTION HAVE BEEN NOTED IN RED ON THESE TRACINGS AND CHECKED BY

RESIDENT ENGINEER DATE

DEPARTMENT OF TRANSPORTATION STATE OF HAWAII

DIR. OF TRANSPORTATION

APPROVED:

1

KARL KUNISHIGE 587–2174 MAY 19 S. S. & E. BY PHONE DAT

ESIGNED BY P. 9