

STATE OF HAWAII

DEPARTMENT OF TRANSPORTATION

HIGHWAYS DIVISION

HONOLULU, HAWAII

"AS-BUILT"

PLANS FOR

KAMEHAMEHA HIGHWAY



REPAIR SPALLS AT SOFFIT, PILES AND PIER CAPS

ON KAAWA STREAM BRIDGE

PROJECT NO. 83D-01-97M

DISTRICT OF KOOLAULOA

ISLAND OF OAHU

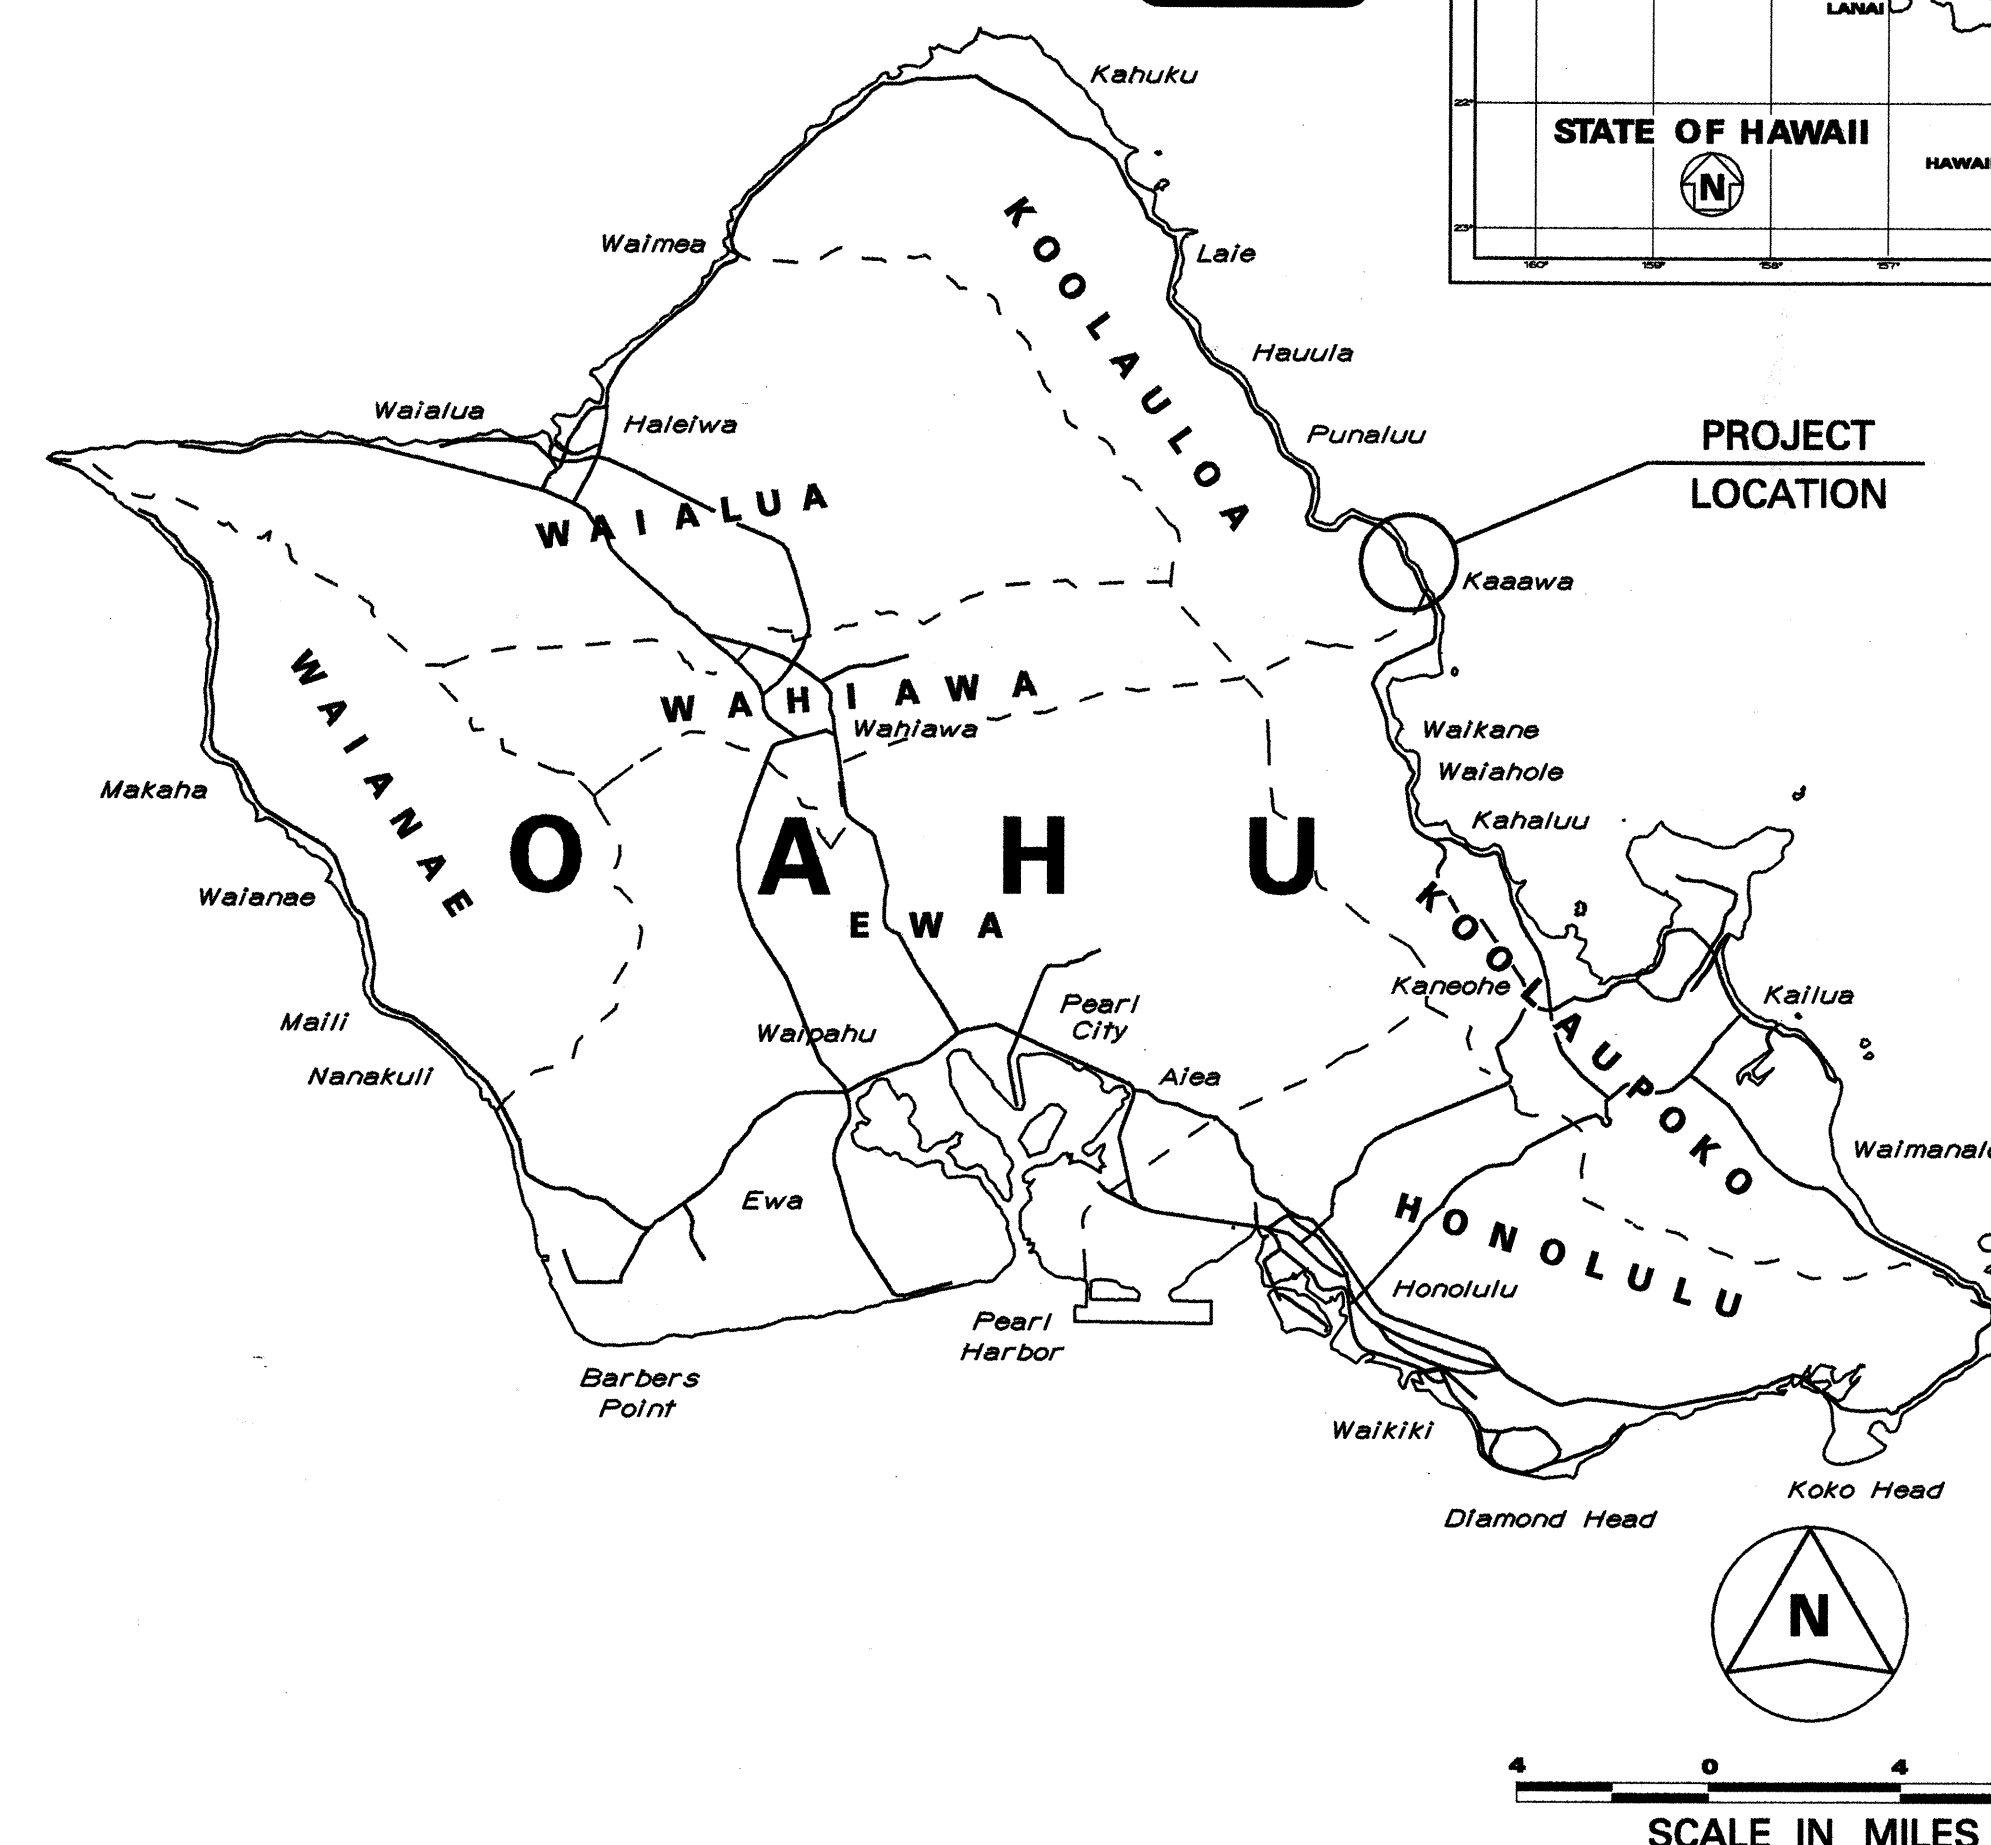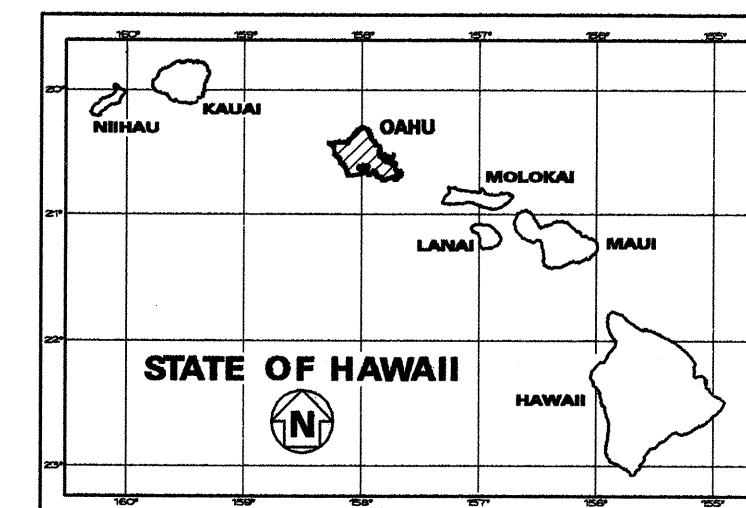


MILE POST 28.98 TO MILE POST 29.00

NO SIGNIFICANT CHANGES WERE MADE ON THESE PLANS
DURING CONSTRUCTION.

Gerald Parn
RESIDENT ENGINEER

11/10/98
DATE

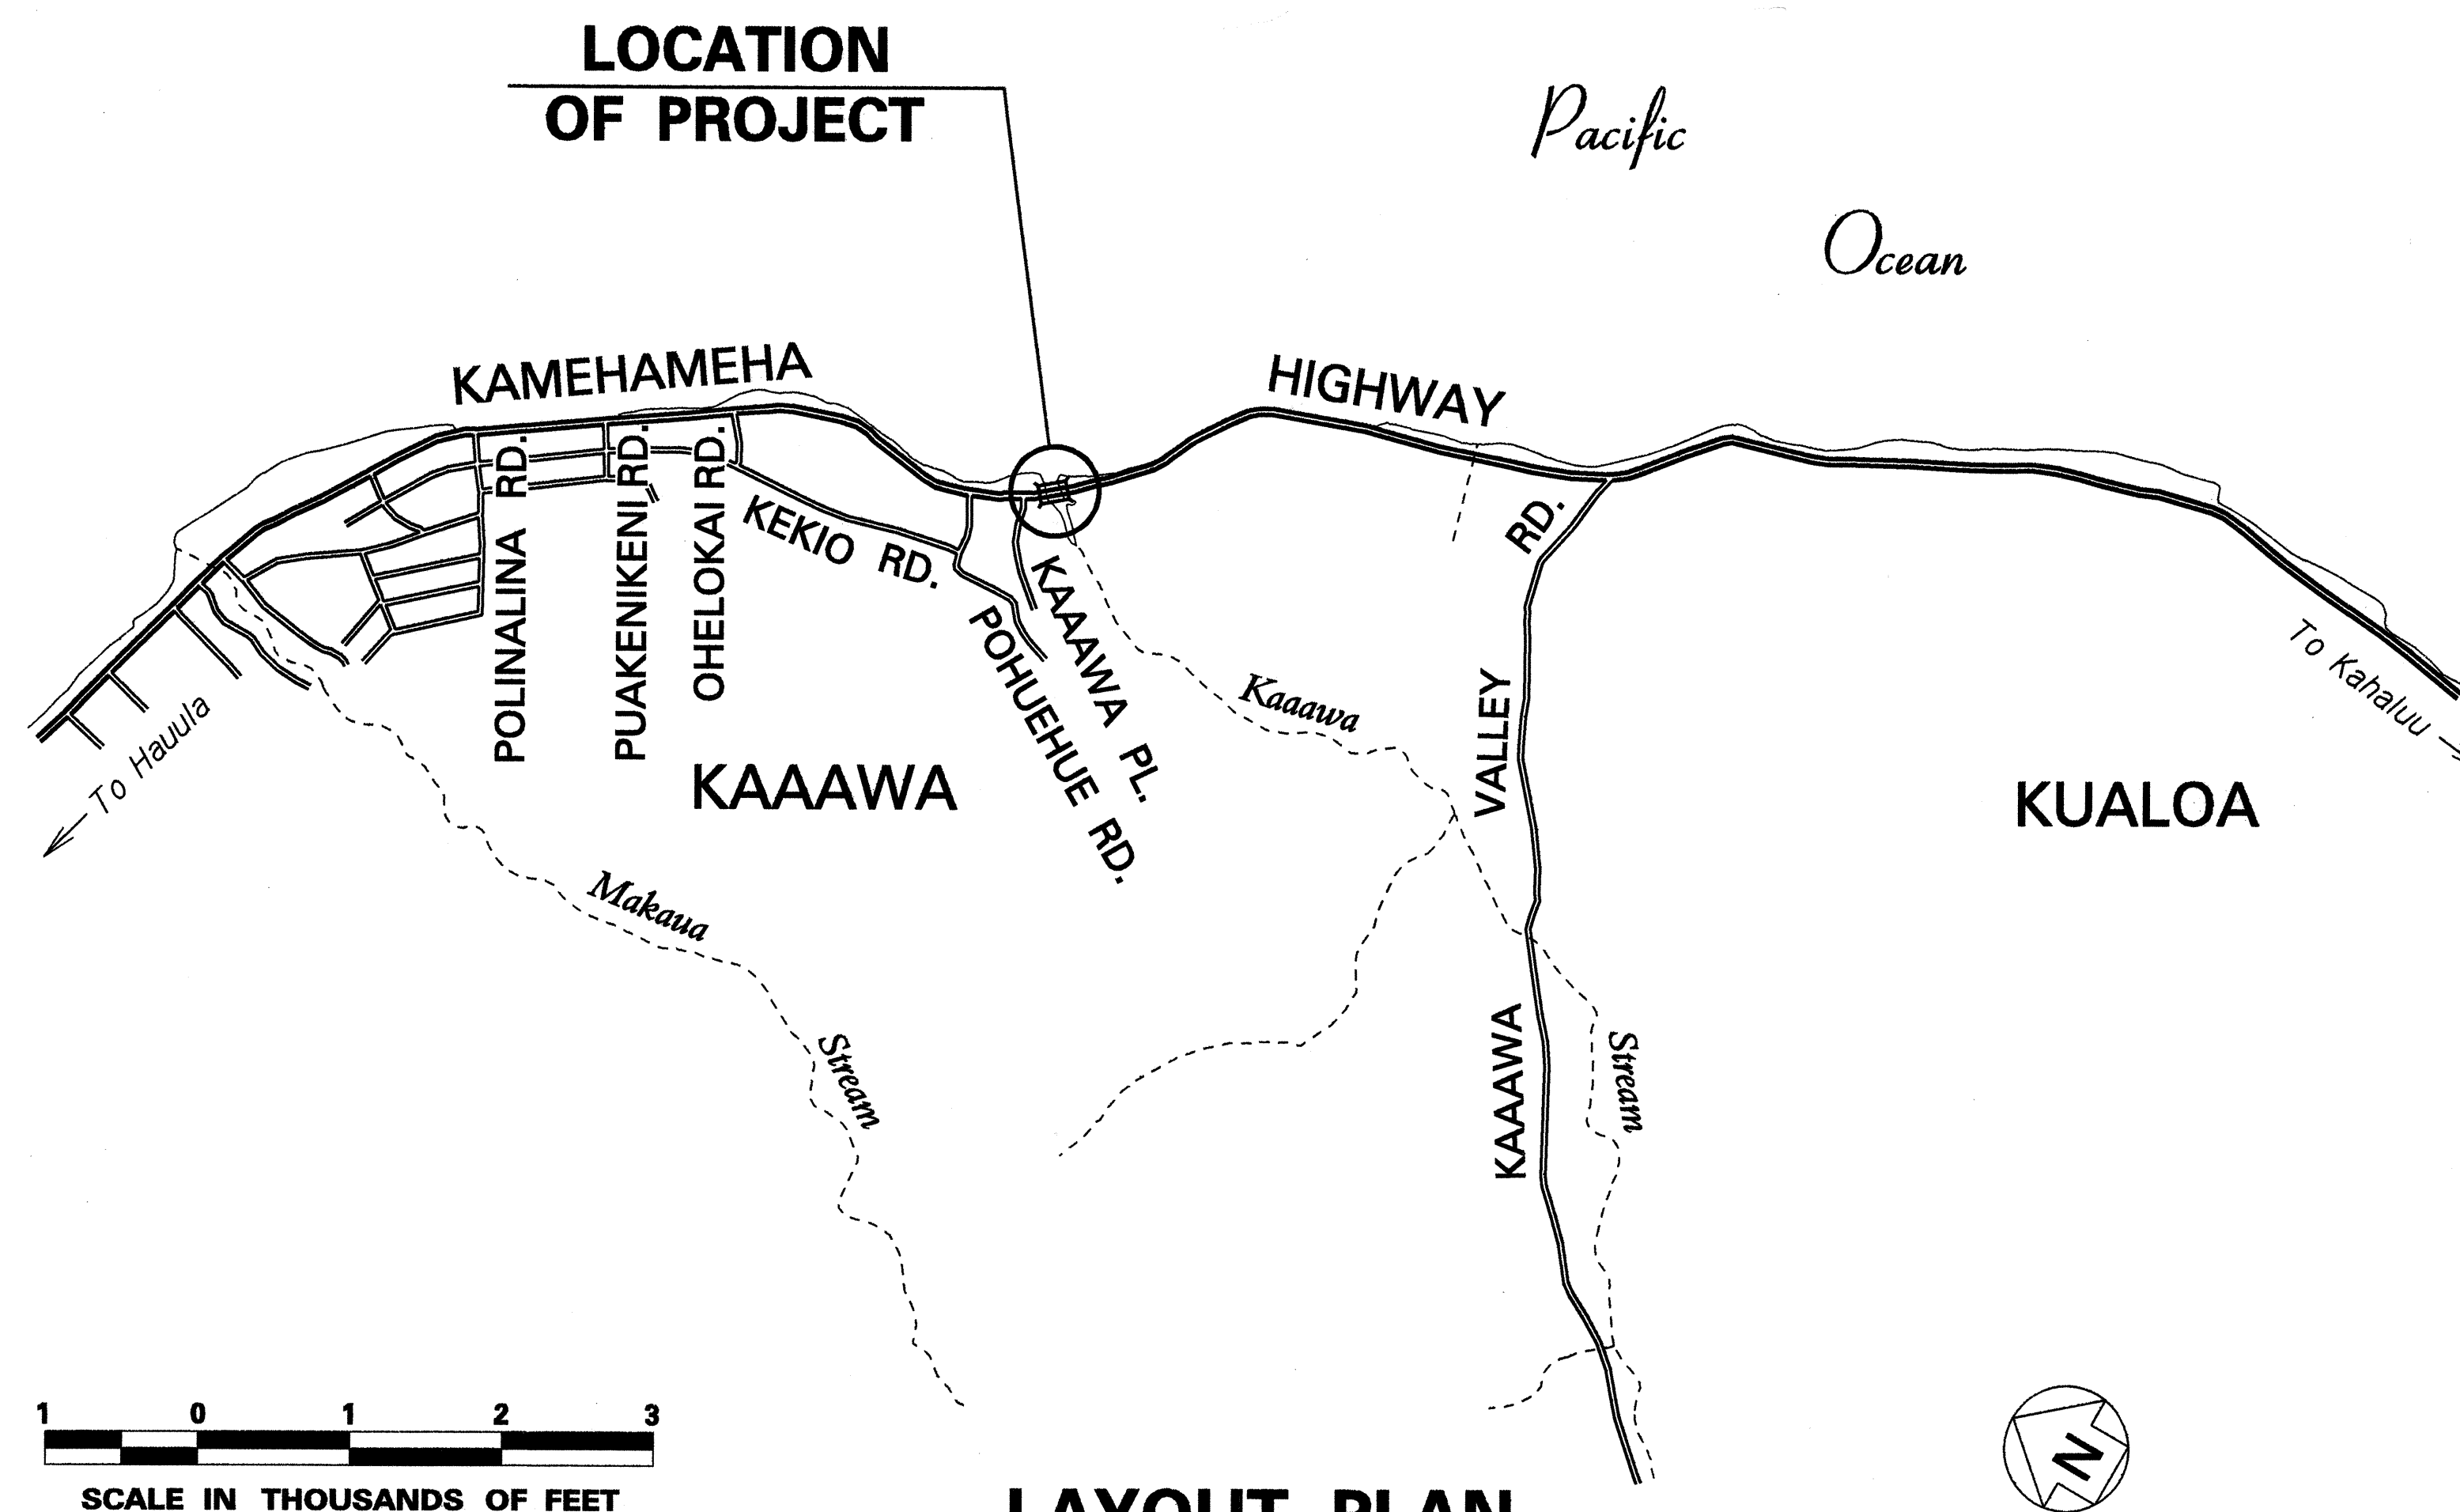

1 0 1 2

SCALE IN THOUSANDS OF FEET

LAYOUT PLAN

GROSS LENGTH OF PROJECT..... 0.02 MILES

UNIT "D" DESIGNED BY K. ITO 587-2238 PHONE DEC., 1996 DATE

DEPARTMENT OF TRANSPORTATION
STATE OF HAWAII

APPROVED: *Rayn Shyashiki* 12/31/96

DIR. OF TRANSPORTATION DATE