


FED. ROAD DIST. NO.	STATE	PROJ. NO.	FISCAL YEAR	SHEET NO.	TOTAL SHEETS
HAWAII	HAW.	NH-083-1(41)	2000	88	90

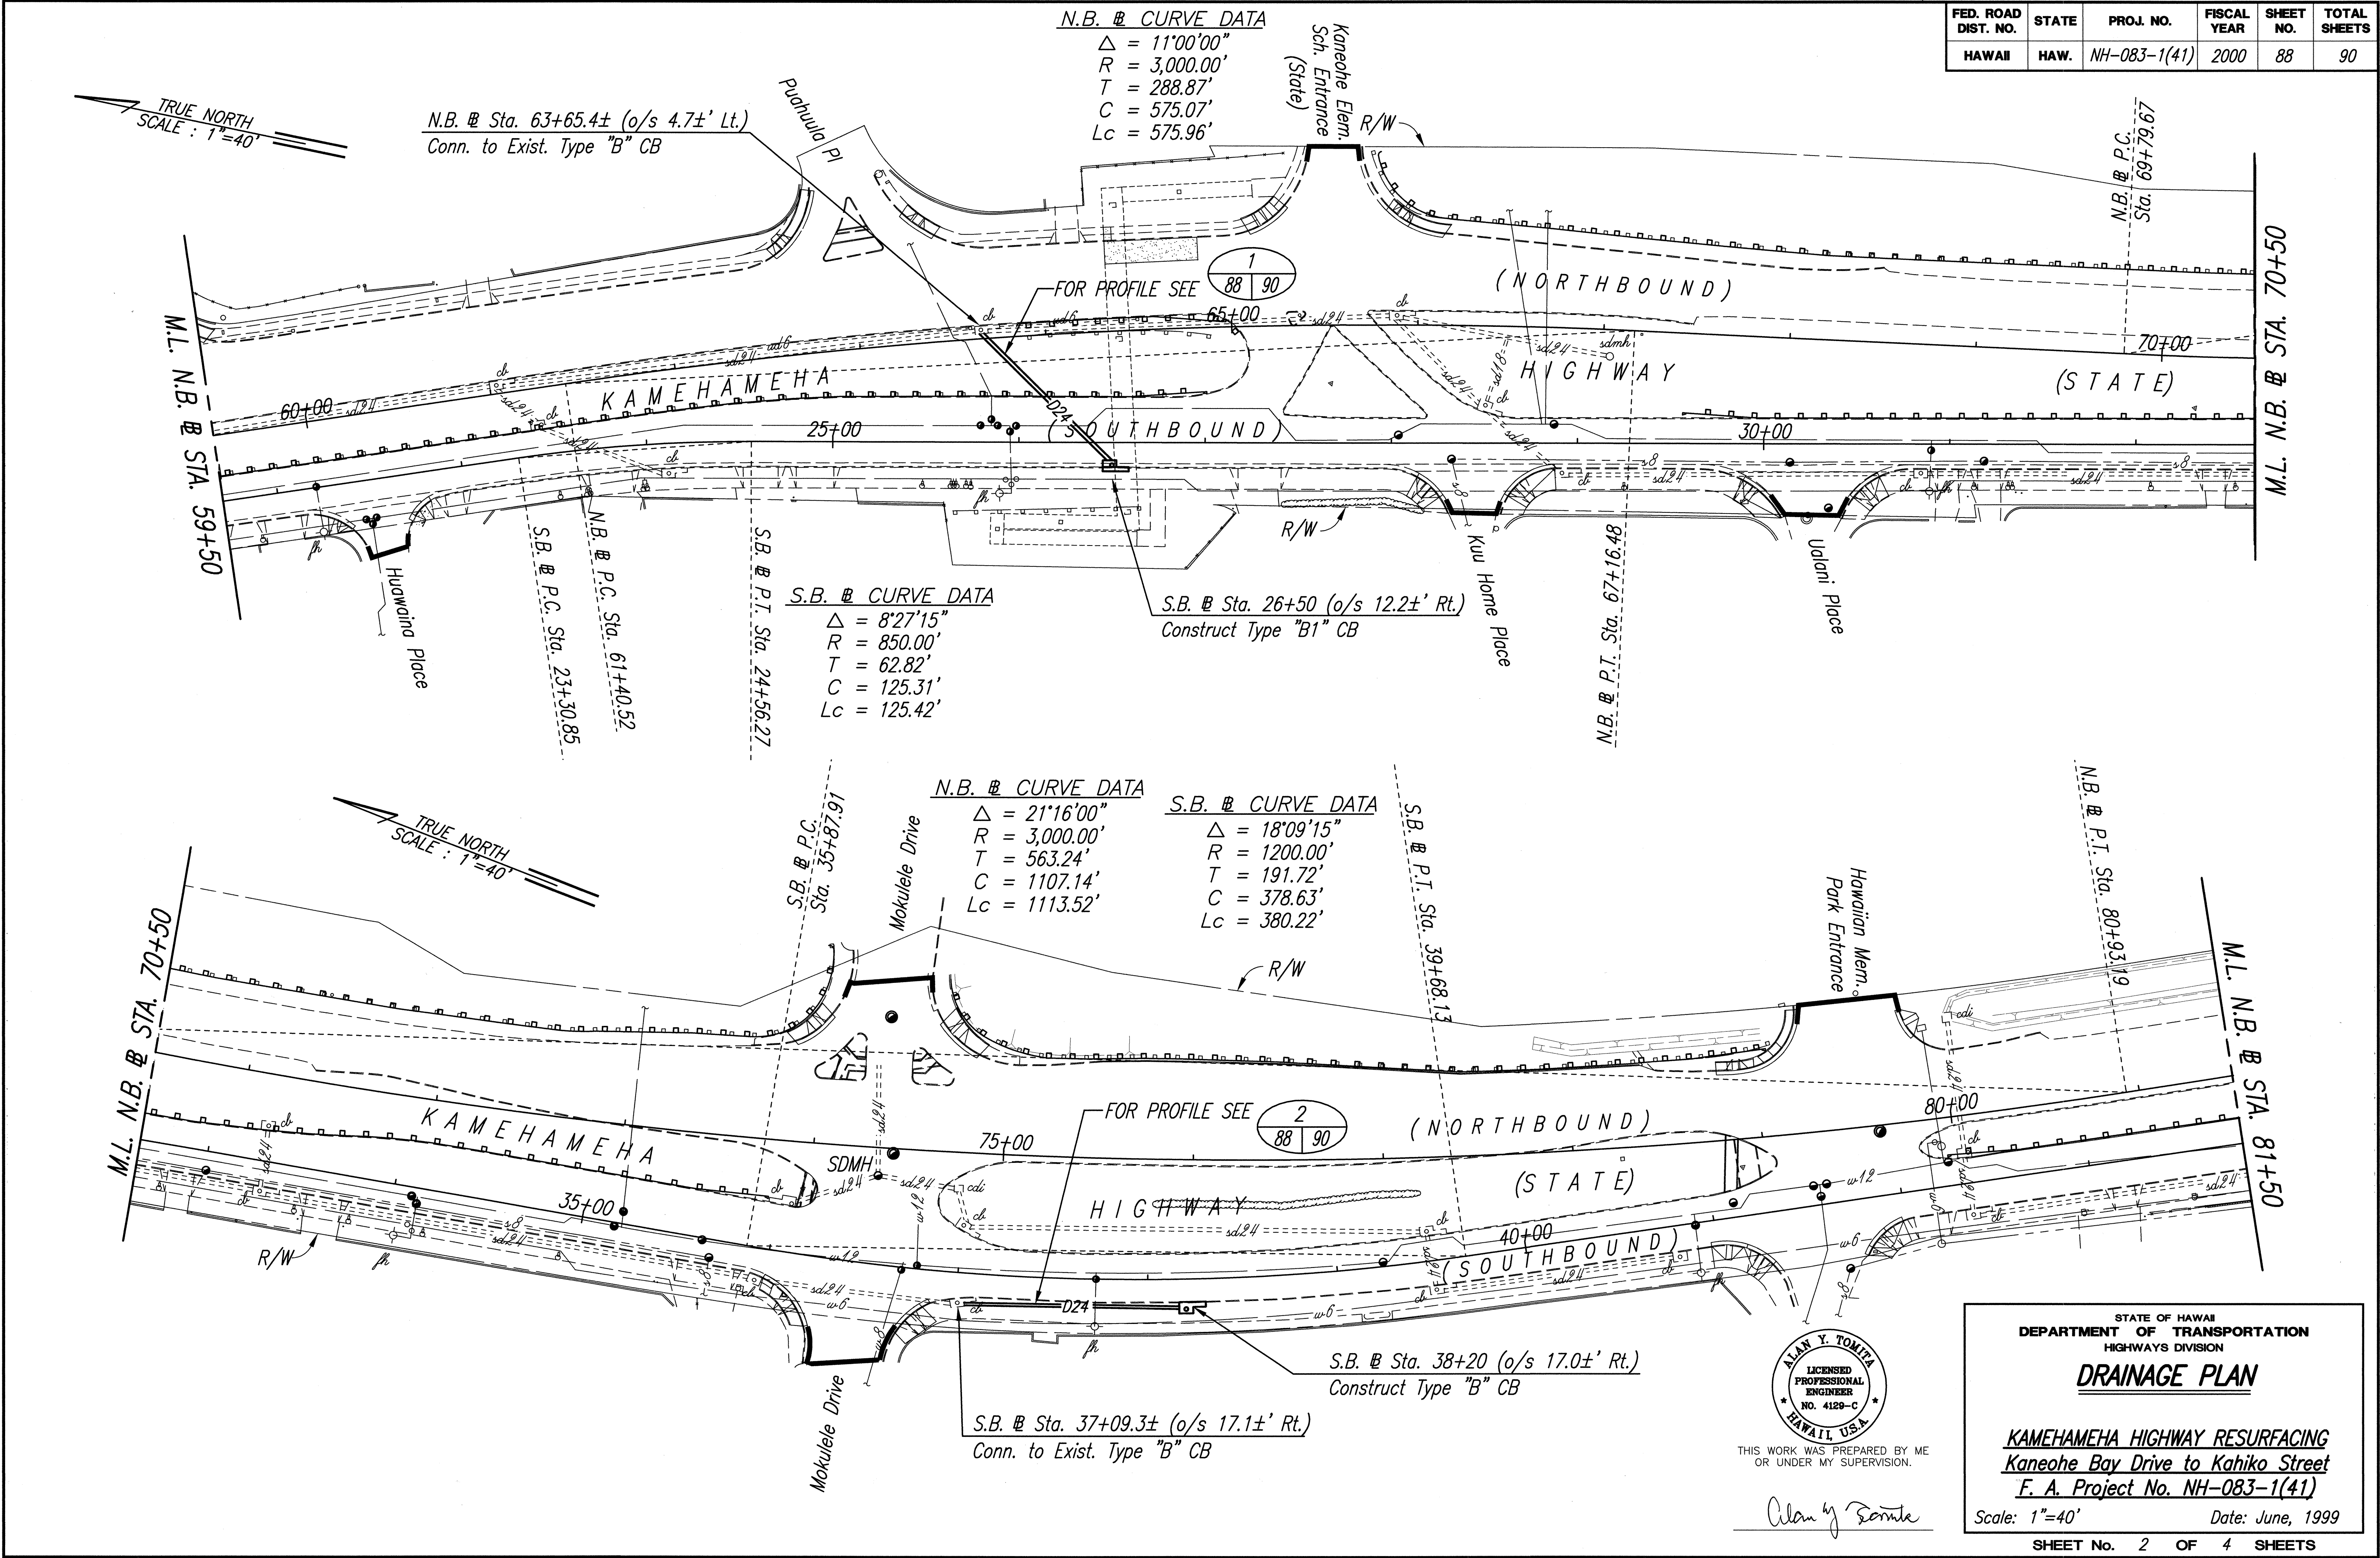

SURVEY PLOTTED BY	DATE
DRAWN BY	
TRACED BY	
DESIGNED BY	
QUANTITIES BY	
CHECKED BY	
ORIGINAL PLAN	
NOTE BOOK	
No.	


ALAN Y. TOMITA
 LICENSED PROFESSIONAL ENGINEER
 NO. 4120-C
 HAWAII, U.S.A.

THIS WORK WAS PREPARED BY ME
 OR UNDER MY SUPERVISION.


Alan Y. Tomita

STATE OF HAWAII
 DEPARTMENT OF TRANSPORTATION
 HIGHWAYS DIVISION
DRAINAGE PLAN
 KAMEHAMEHA HIGHWAY RESURFACING
 Kaneohe Bay Drive to Kahiko Street
 F. A. Project No. NH-083-1(41)
 Scale: 1"=40' Date: June, 1999
 SHEET No. 2 OF 4 SHEETS


FED. ROAD DIST. NO.	STATE	PROJ. NO.	FISCAL YEAR	SHEET NO.	TOTAL SHEETS
HAWAII	HAW.	NH-083-1(41)	2000	90	90

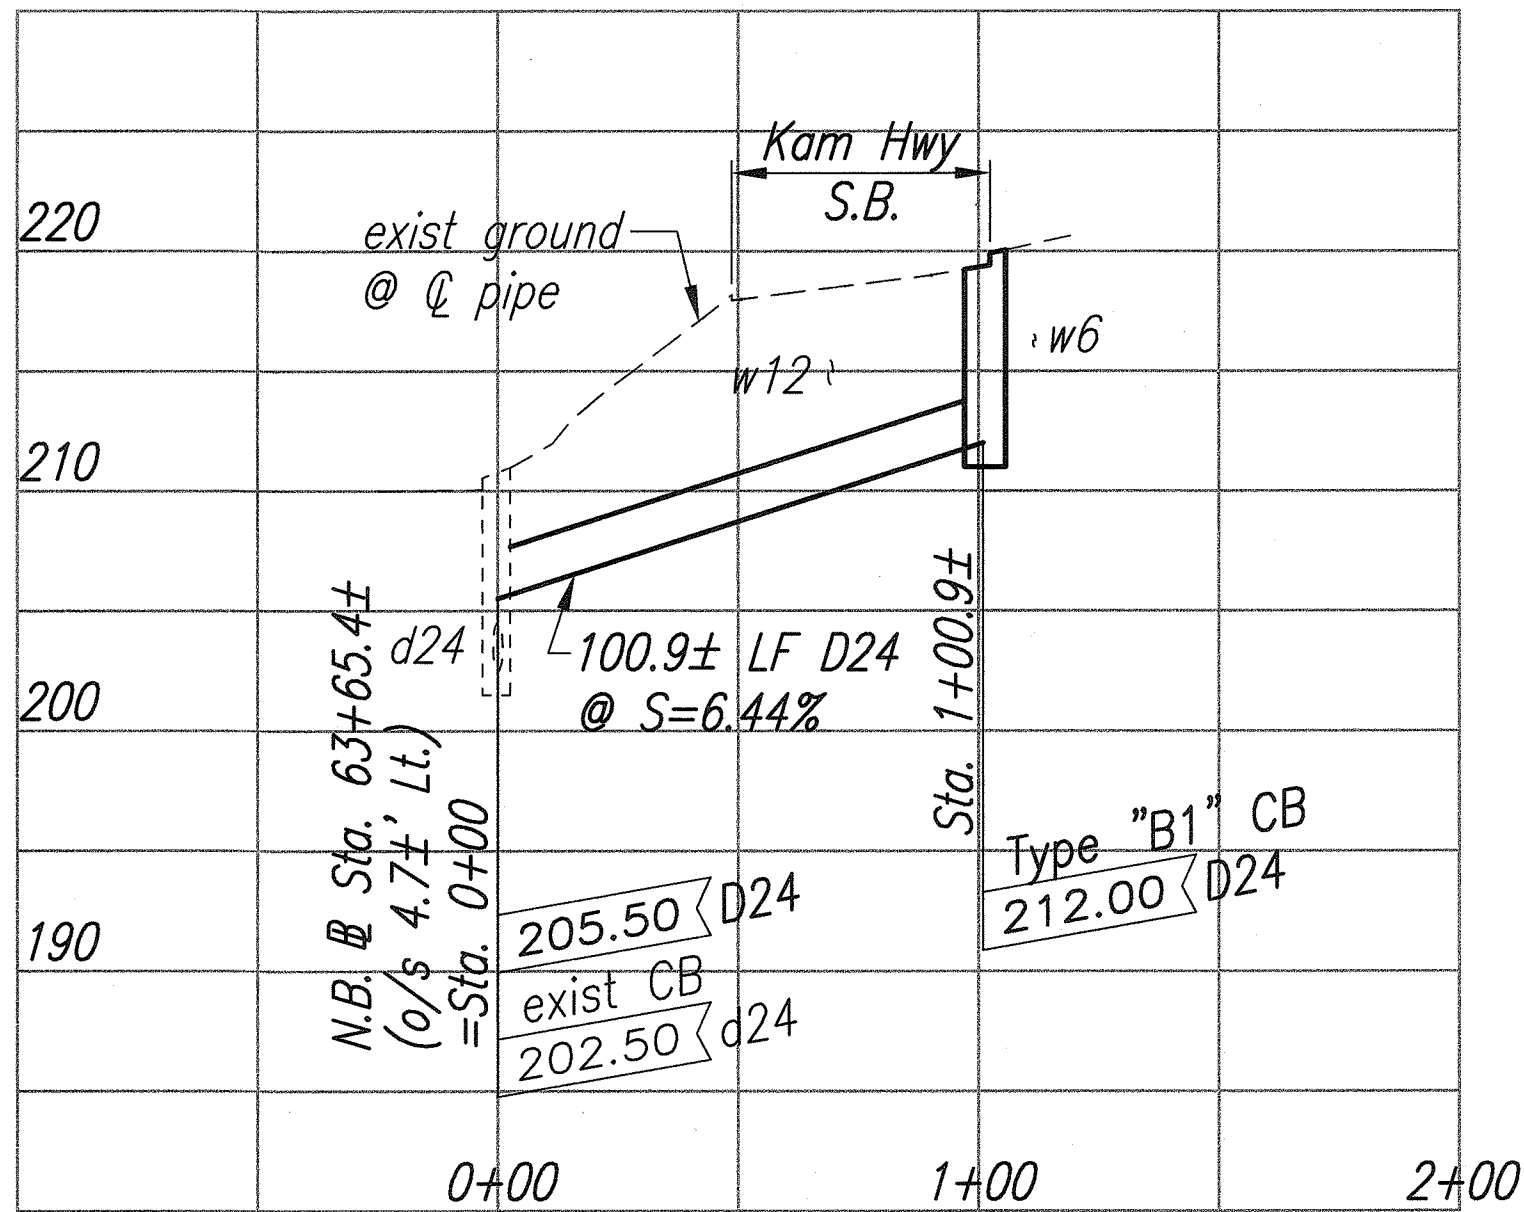

1 D24 @ N.B. @ Sta. 63+65.4± (o/s 4.7±' Lt.)
88 90 Scales: HORIZ 1"=40'
VERT 1"=8'

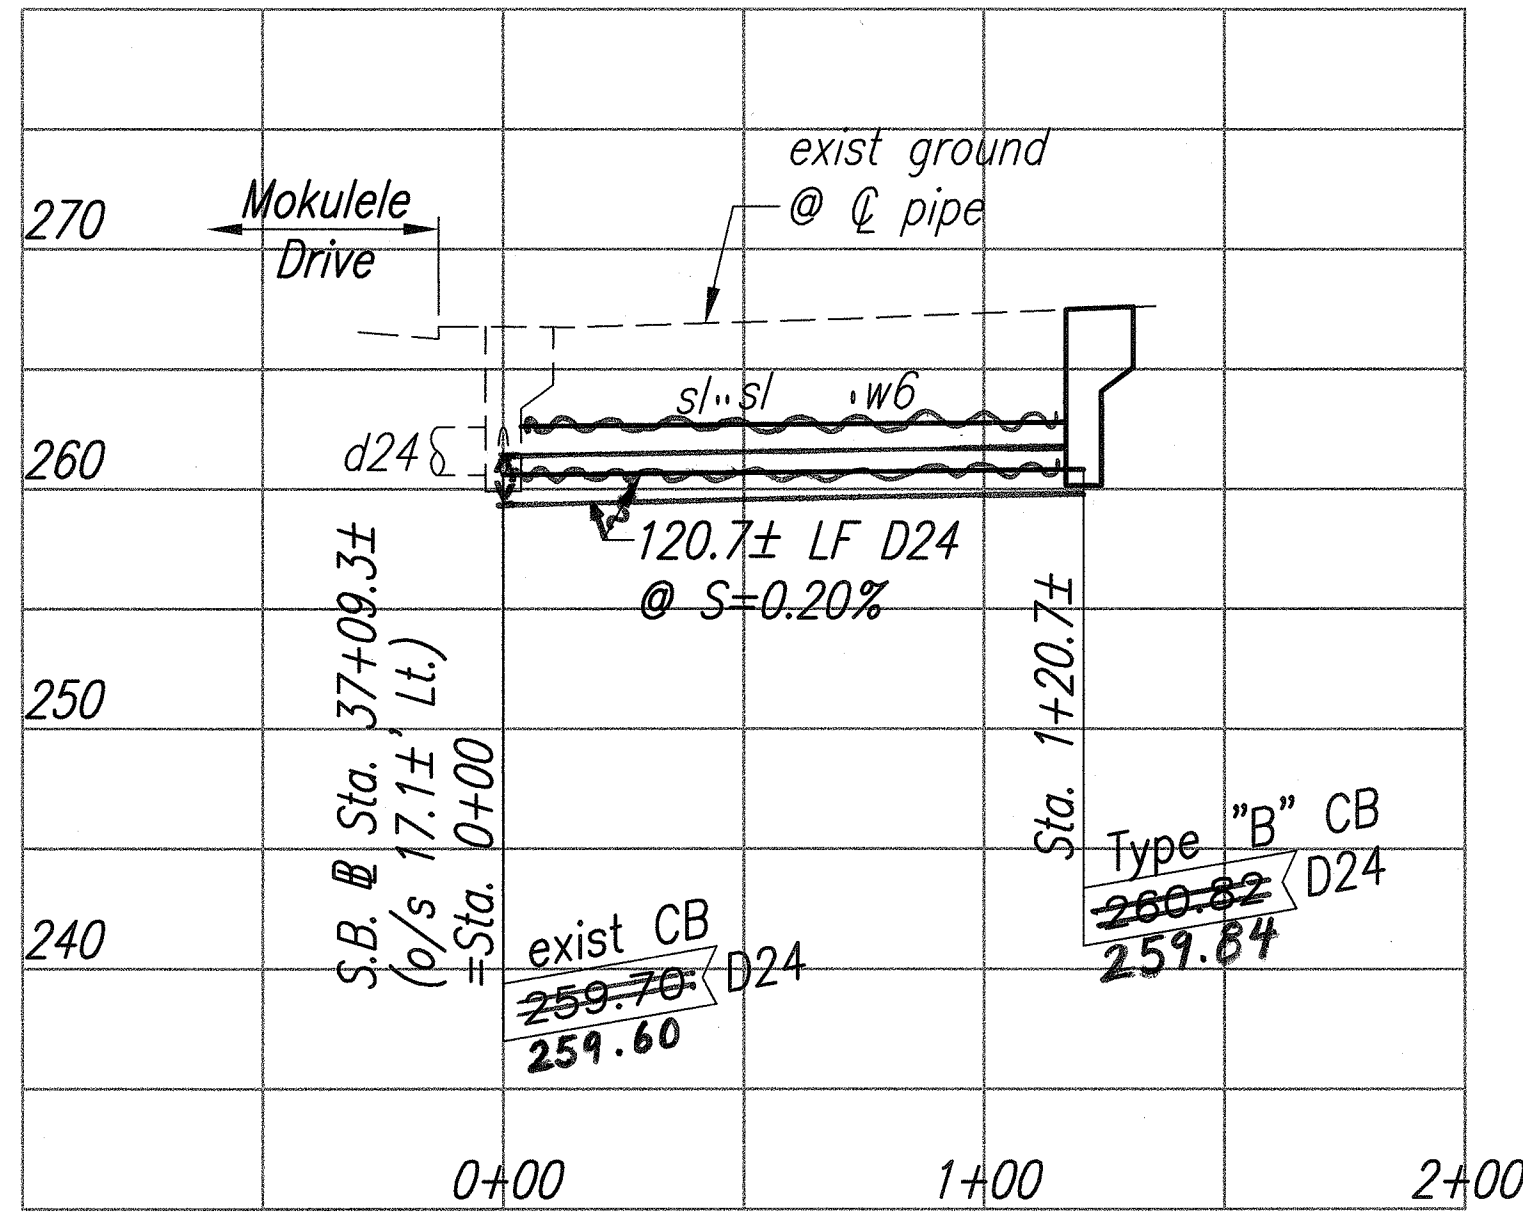


2 D24 @ S.B. @ Sta. 37+09.3± (o/s 17.1±' Rt.)
88 90 Scales: HORIZ 1"=40'
VERT 1"=8'

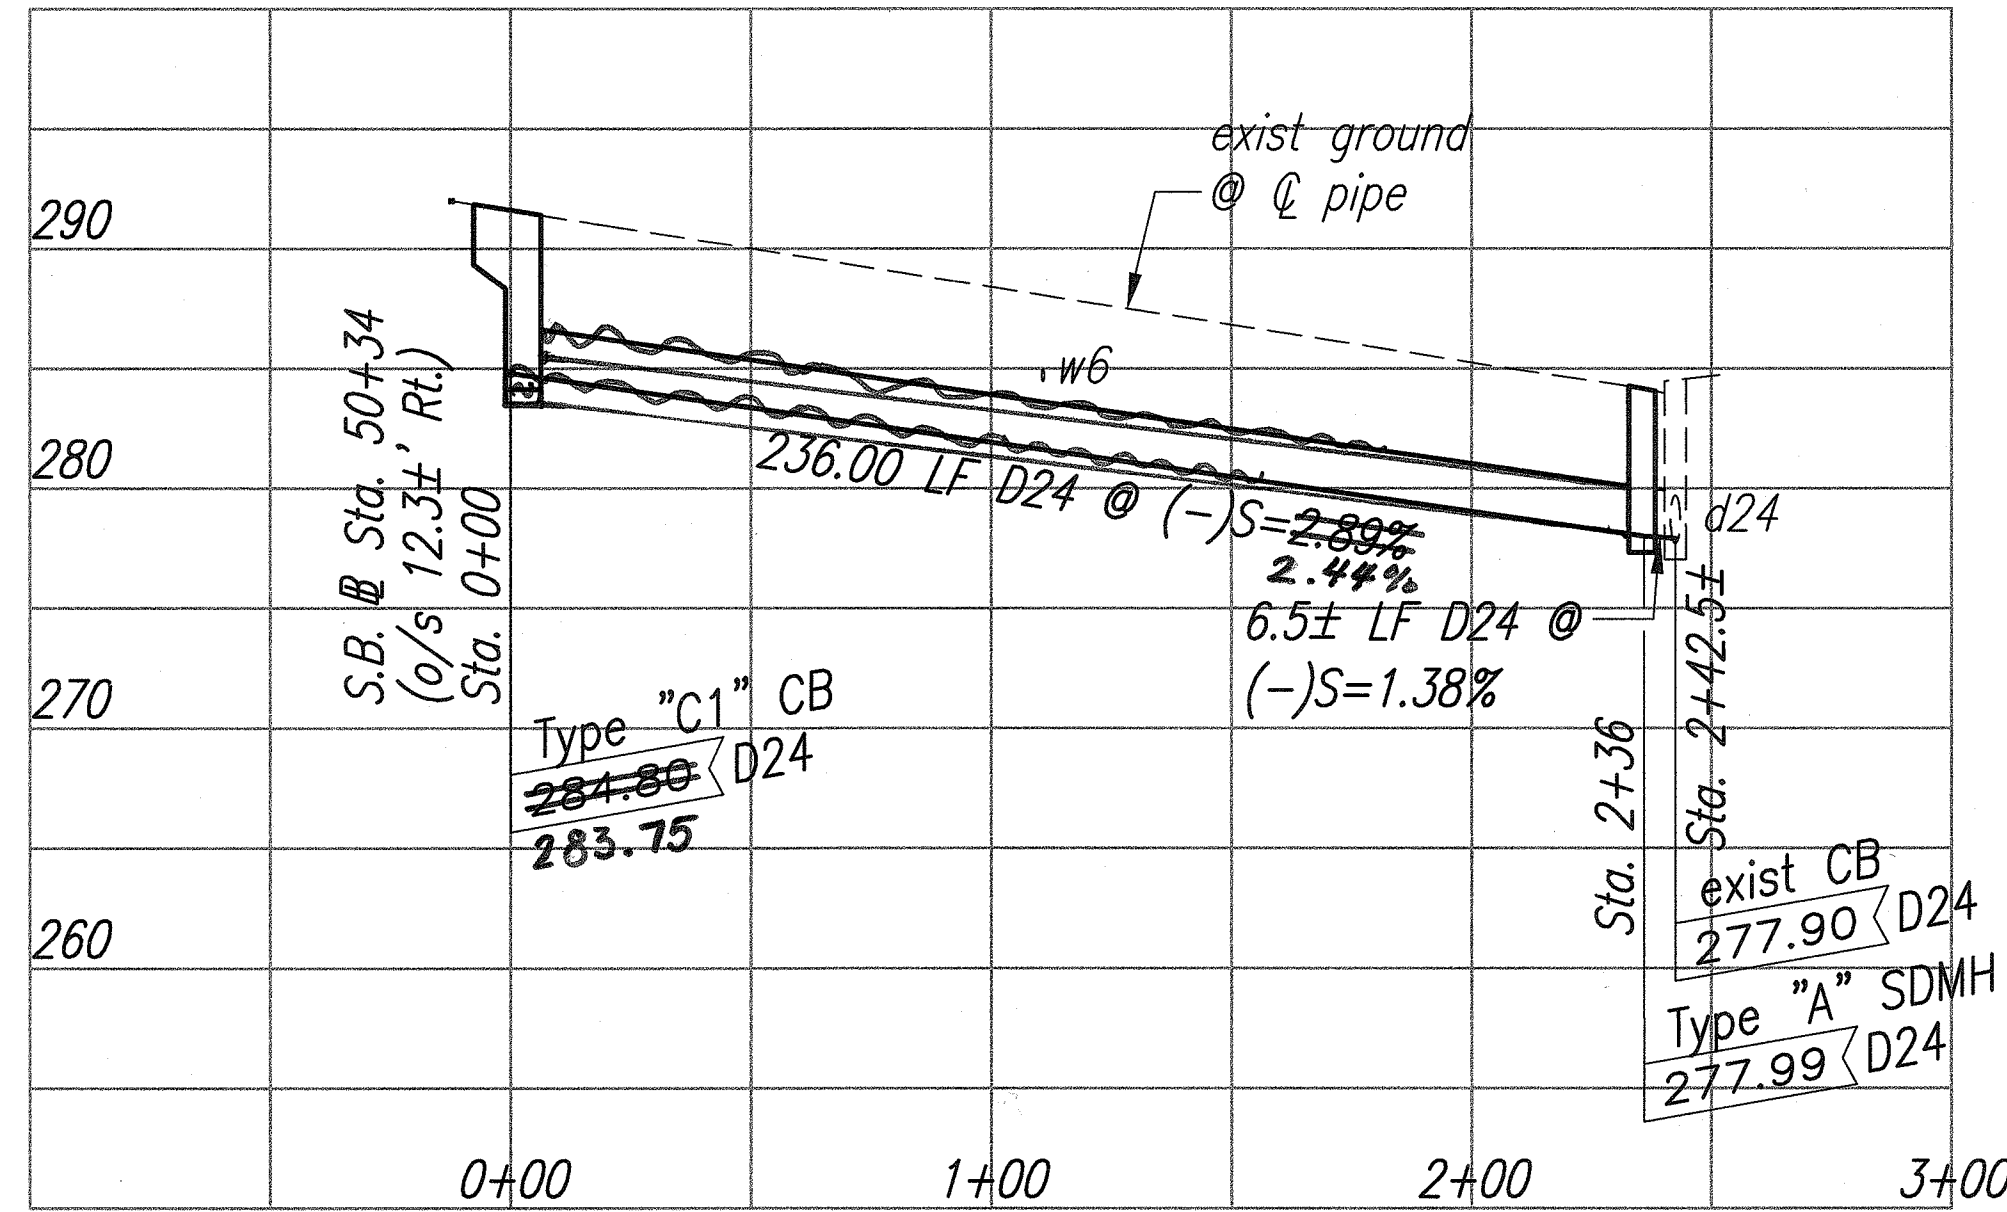

3 D24 @ S.B. @ Sta. 50+34 (o/s 12.3±' Rt.)
89 90 Scales: HORIZ 1"=40'
VERT 1"=8'

ORIGINAL PLAN	SURVEY PLOTTED BY	DATE
NOTE BOOK	DRAWN BY	
No.	CHECKED BY	

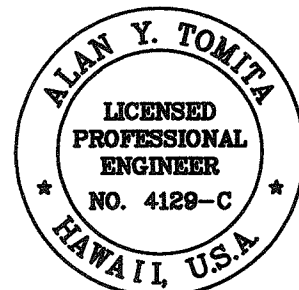

THIS WORK WAS PREPARED BY ME
OR UNDER MY SUPERVISION.

Alan Y. Tomita

STATE OF HAWAII
DEPARTMENT OF TRANSPORTATION
HIGHWAYS DIVISION
DRAINAGE PROFILES

KAMEHAMEHA HIGHWAY RESURFACING
Kaneohe Bay Drive to Kahiko Street
F. A. Project No. NH-083-1(41)

Scale: 1"=40' Date: June, 1999

SHEET No. 4 OF 4 SHEETS

"AS-BUILT"