

INDEX TO DRAWINGS	
SHEET NO.	DESCRIPTION
1	TITLE SHEET
2	STANDARD PLANS SUMMARY
3	GENERAL NOTES
4	DRAINAGE PLAN AND NOTES
5	DRAINAGE PROFILE
6-17	DRAINAGE DETAILS
18-19	WATERLINE RELOCATION DETAILS

STATE OF HAWAII

DEPARTMENT OF TRANSPORTATION

HIGHWAYS DIVISION

HONOLULU, HAWAII

"AS-BUILT"

PLANS FOR

KAMEHAMEHA HIGHWAY

DRAINAGE IMPROVEMENTS



IN THE VICINITY OF POLINALINA ROAD

PROJECT NO. 83D-01-98


DISTRICT OF KOOLAULOA

ISLAND OF OAHU

FED. ROAD DIST. NO.	STATE	PROJ. NO.	FISCAL YEAR	SHEET NO.	TOTAL SHEETS
HAWAII	HAW.	83D-01-98	2000	1	19

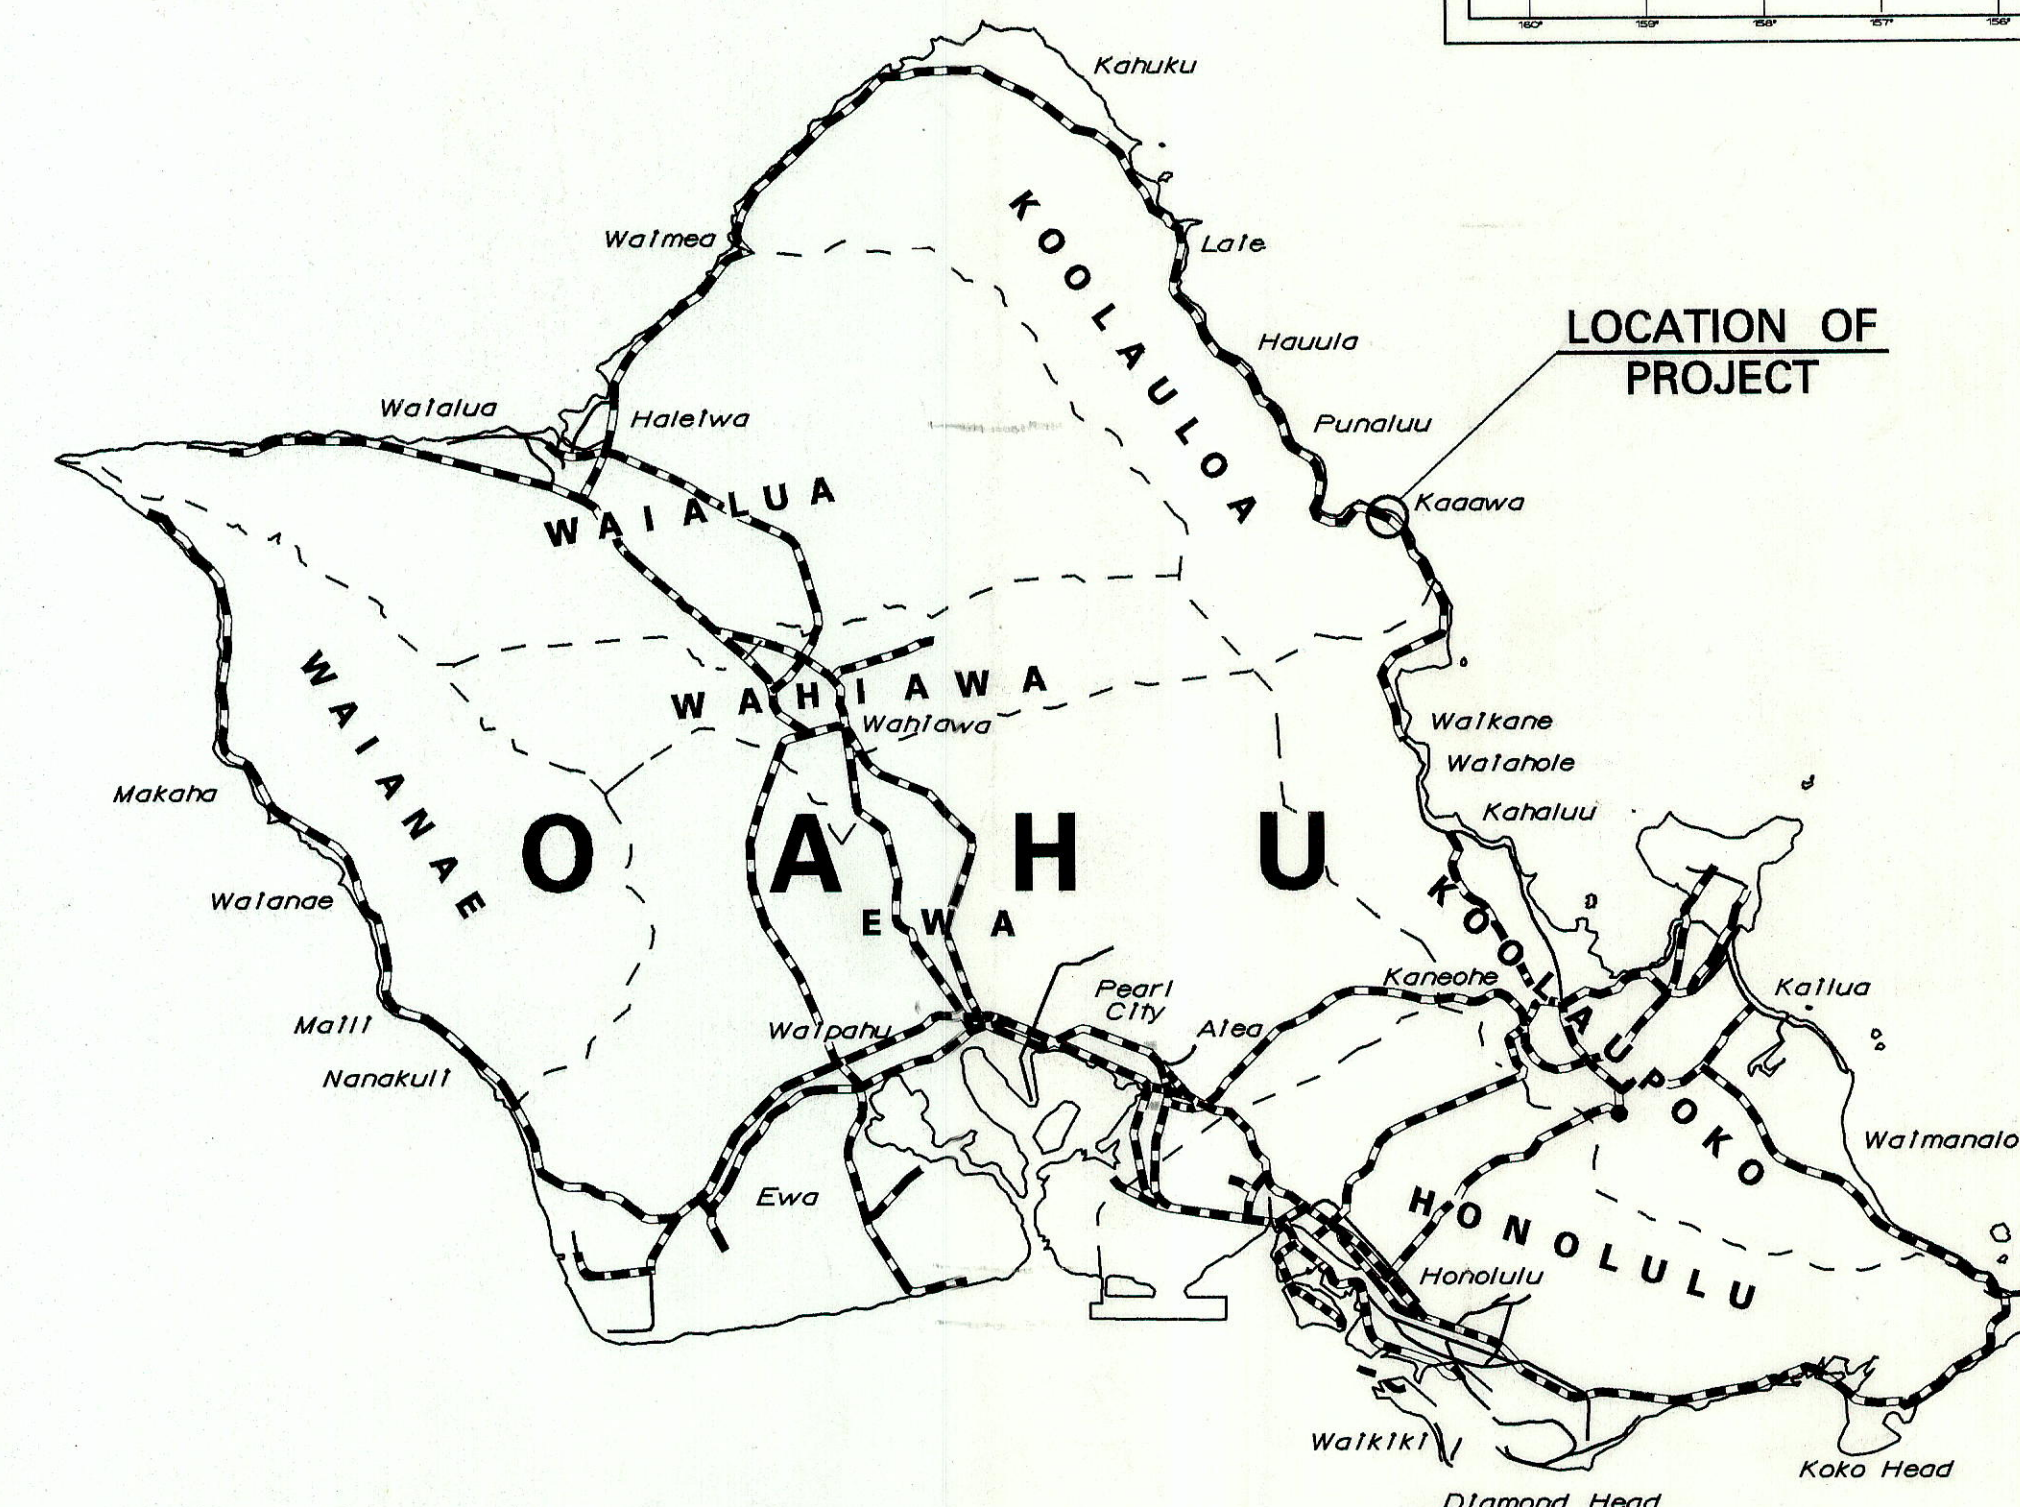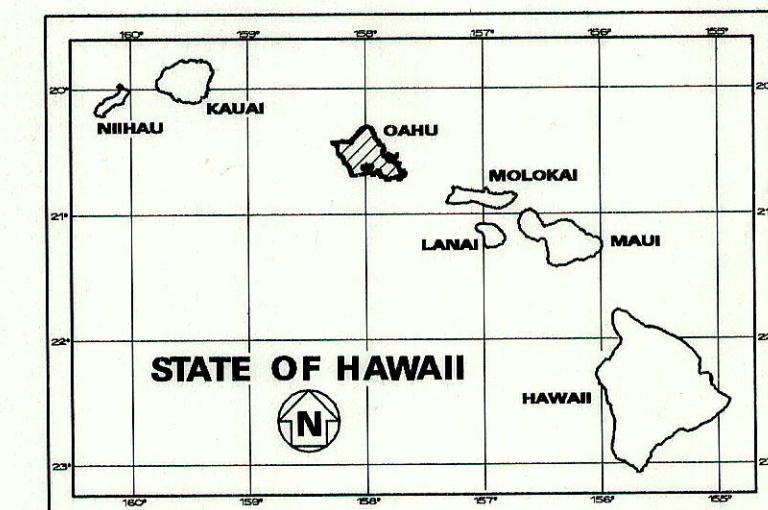

4 0 4 8
SCALE IN MILES

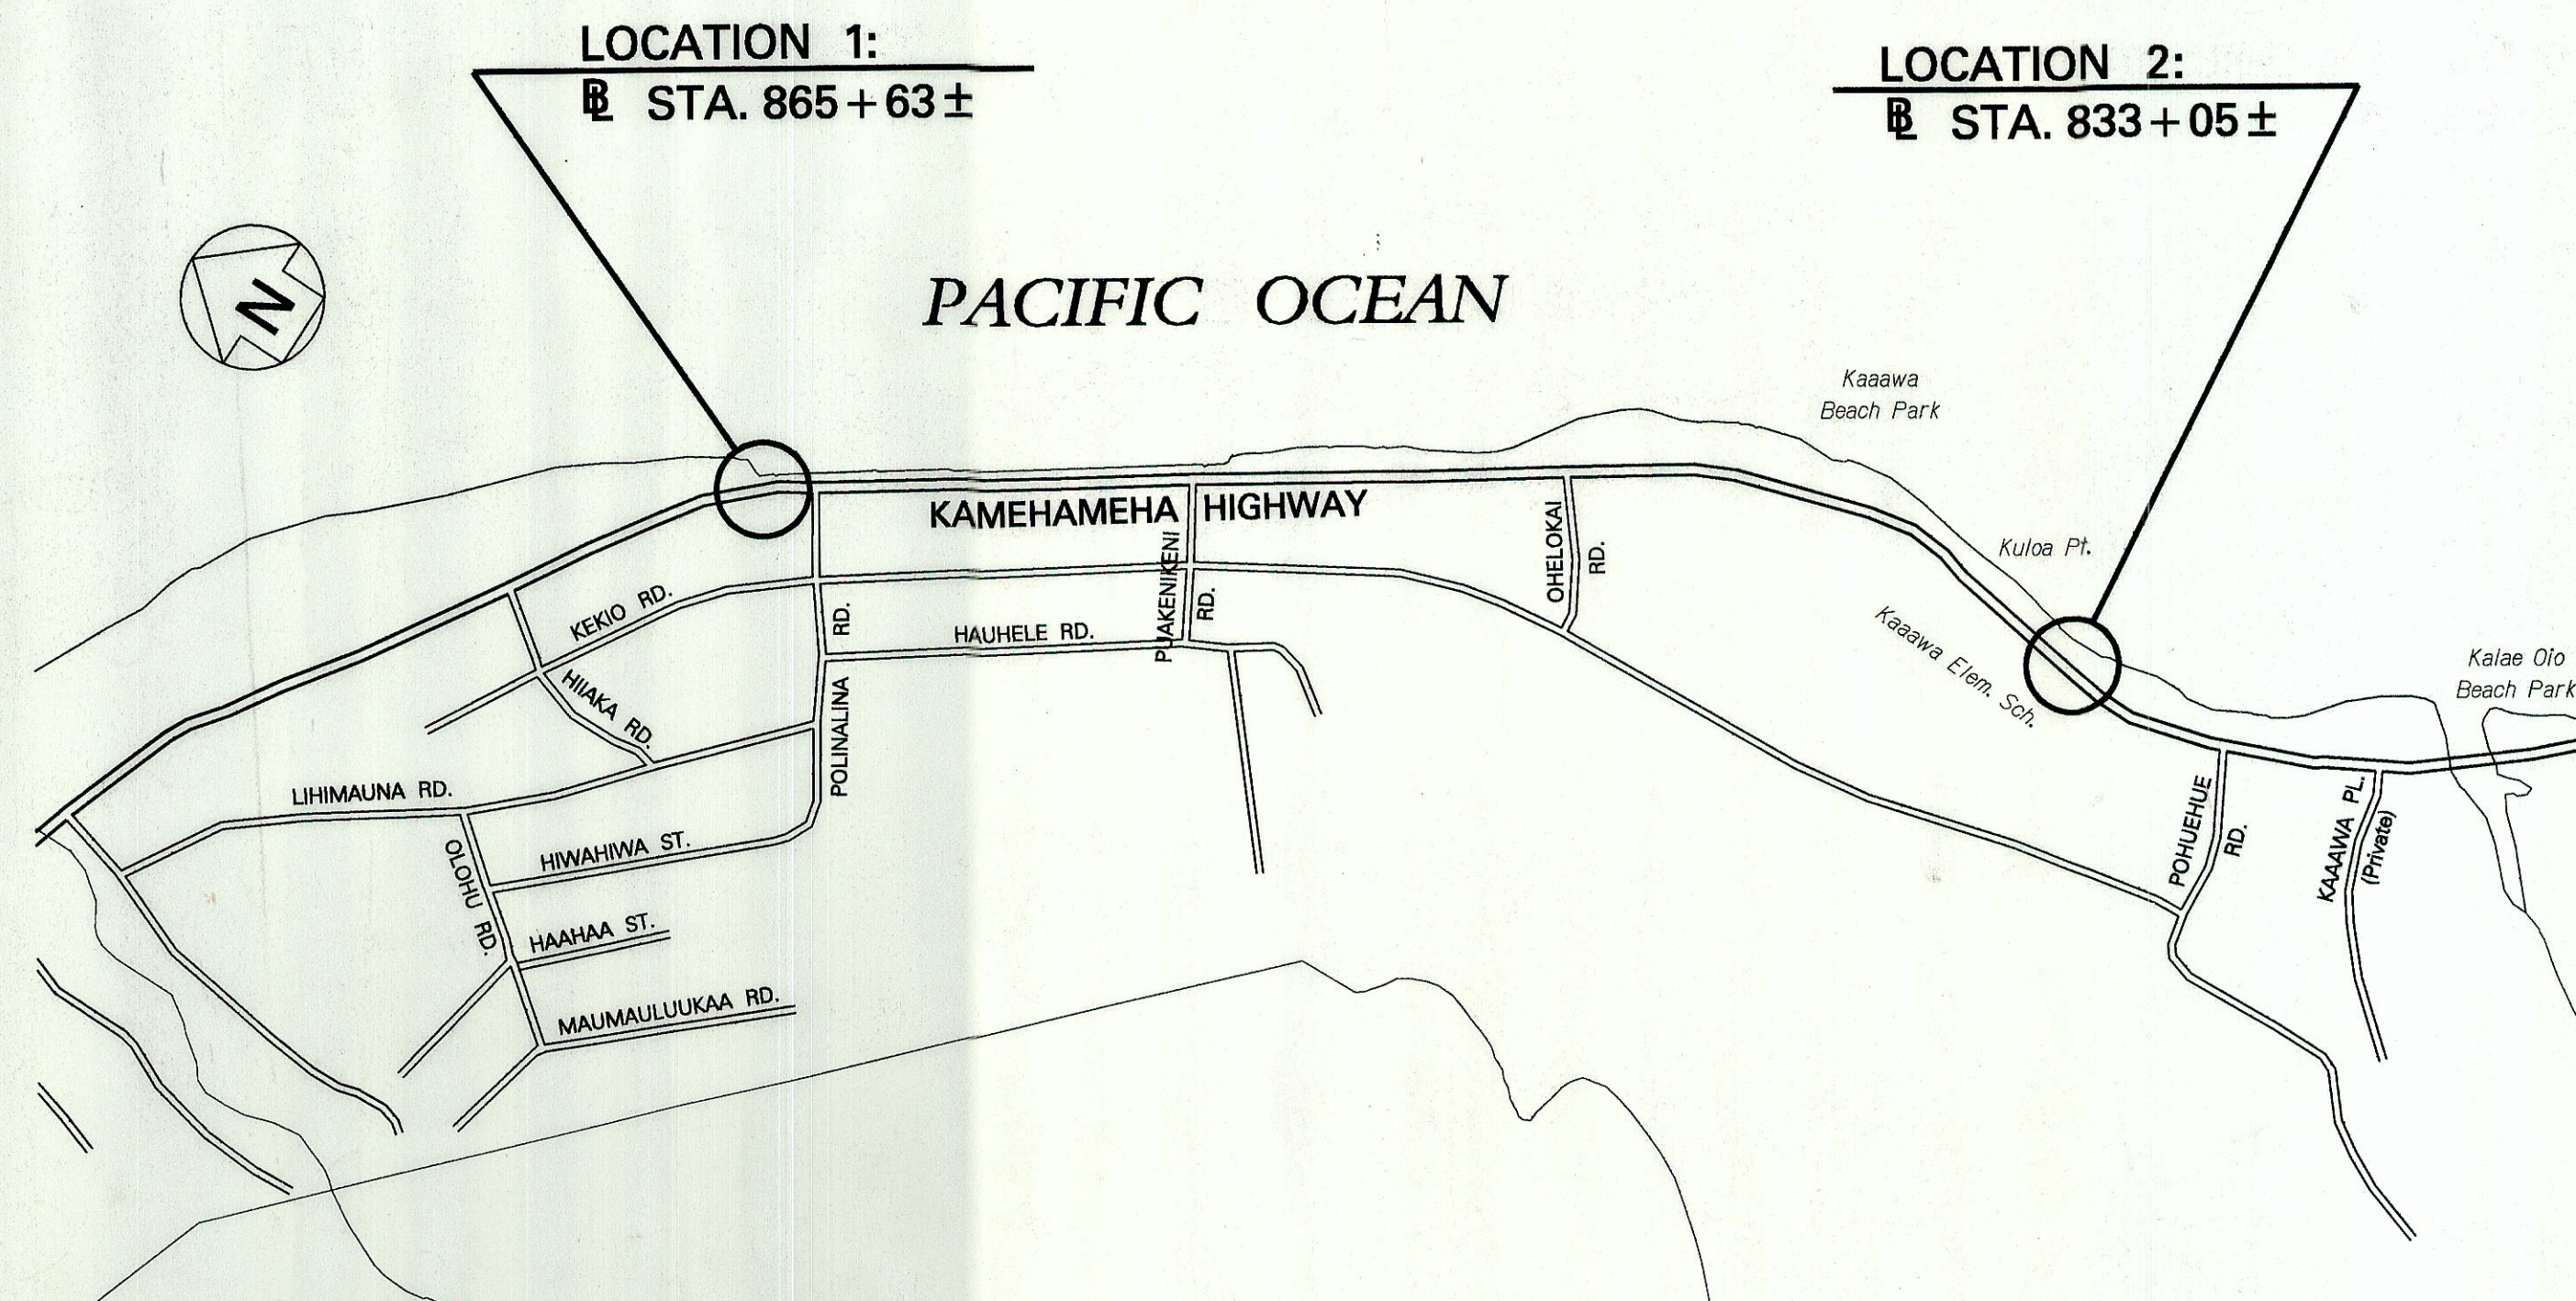

LAYOUT PLAN

4 0 4 8 12
SCALE IN HUNDRED FEET

--- FEDERAL AID PROJECTS PREVIOUSLY CONSTRUCTED OR UNDER CONSTRUCTION

LOCATION 1:
MILE POST 27.95 TO MILE POST 28.05
AND

LOCATION 2:
MILE POST 28.58 TO MILE POST 28.68

CHANGES MADE DURING CONSTRUCTION HAVE BEEN INCORPORATED ON THESE PLANS EXCEPT CHANGES IN THE ORIGINAL THEORETICAL QUANTITIES. FOR ACTUAL QUANTITIES, REFER TO PROJECT LEDGER AND/OR COMPUTATION BOOK.

[Signature] 1/25/15
RESIDENT ENGINEER DATE

DEPARTMENT OF TRANSPORTATION STATE OF HAWAII	
APPROVED:	
<i>[Signature]</i>	1/25/15
DIR. OF TRANSPORTATION	DATE

Hwy-DH
DESIGNED BY
R. HIRONAKA
P. S. & E. BY
692-7575
PHONE
NOV. 1999
DATE