
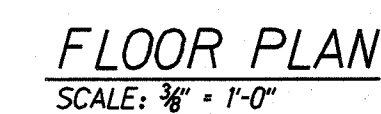
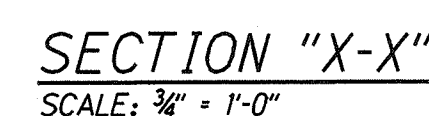
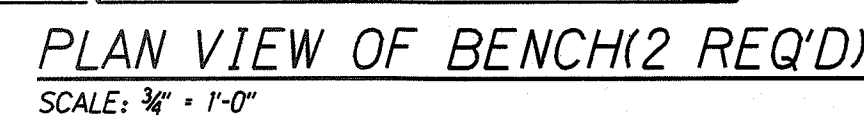
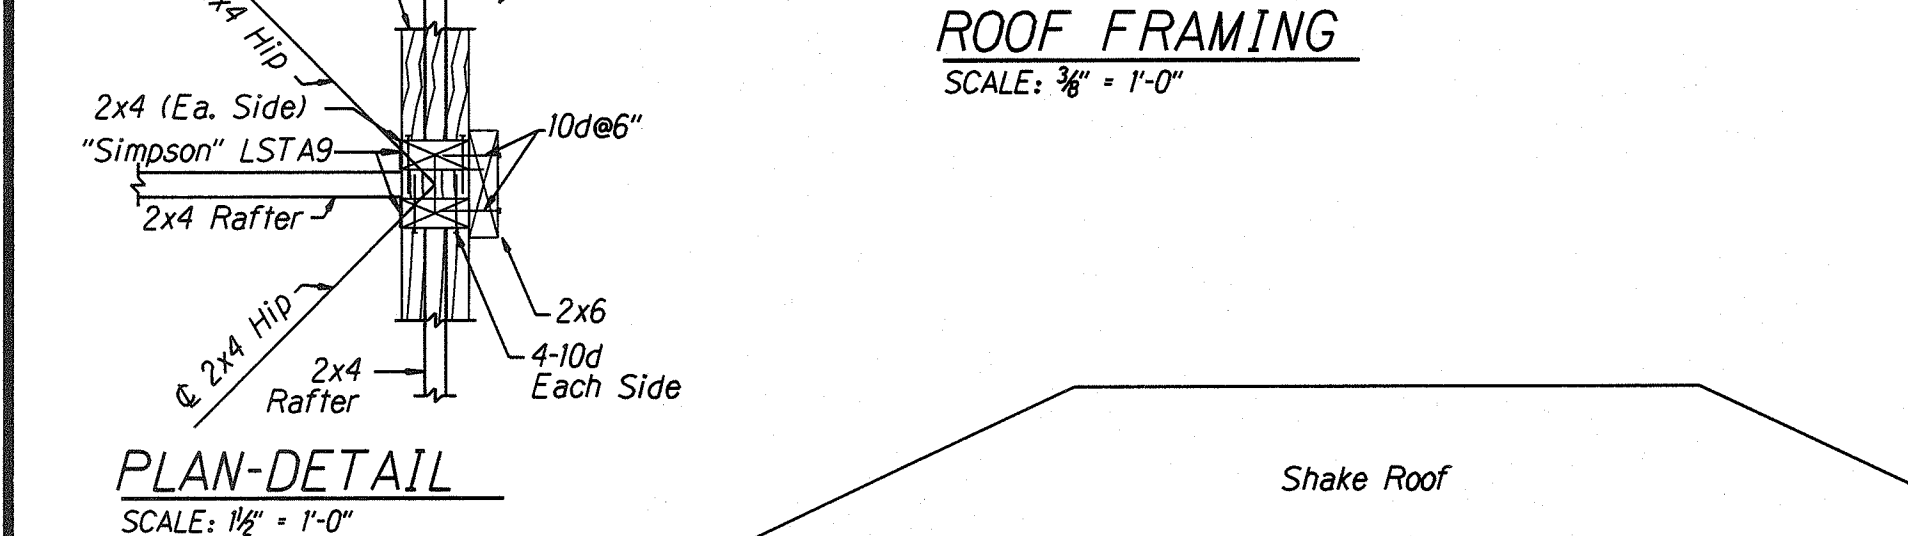


2-10d F.S. 30"x48" Clr. Floor

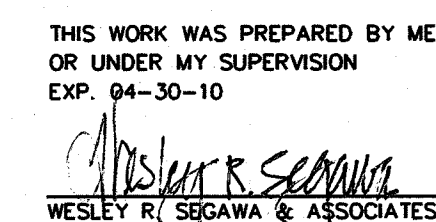

- Chief Engineer, Department of Transportation Services
- Date

Chief Engineer, Department of Transportation Services Date

KAMEHAMEHA HIGHWAY DRAINAGE IMPROVEMENTS
Vicinity of Kahuku Hospital and Replacement of Kii Bridge
Federal Aid Project No. NH-083-1(46)
 Scale: As Noted Date: April 2004