


FED. ROAD DIST. NO.	STATE	FED. AID PROJ. NO.	FISCAL YEAR	SHEET NO.	TOTAL SHEETS
HAWAII	HAW.	NH-083-1(46)	2002	20	89

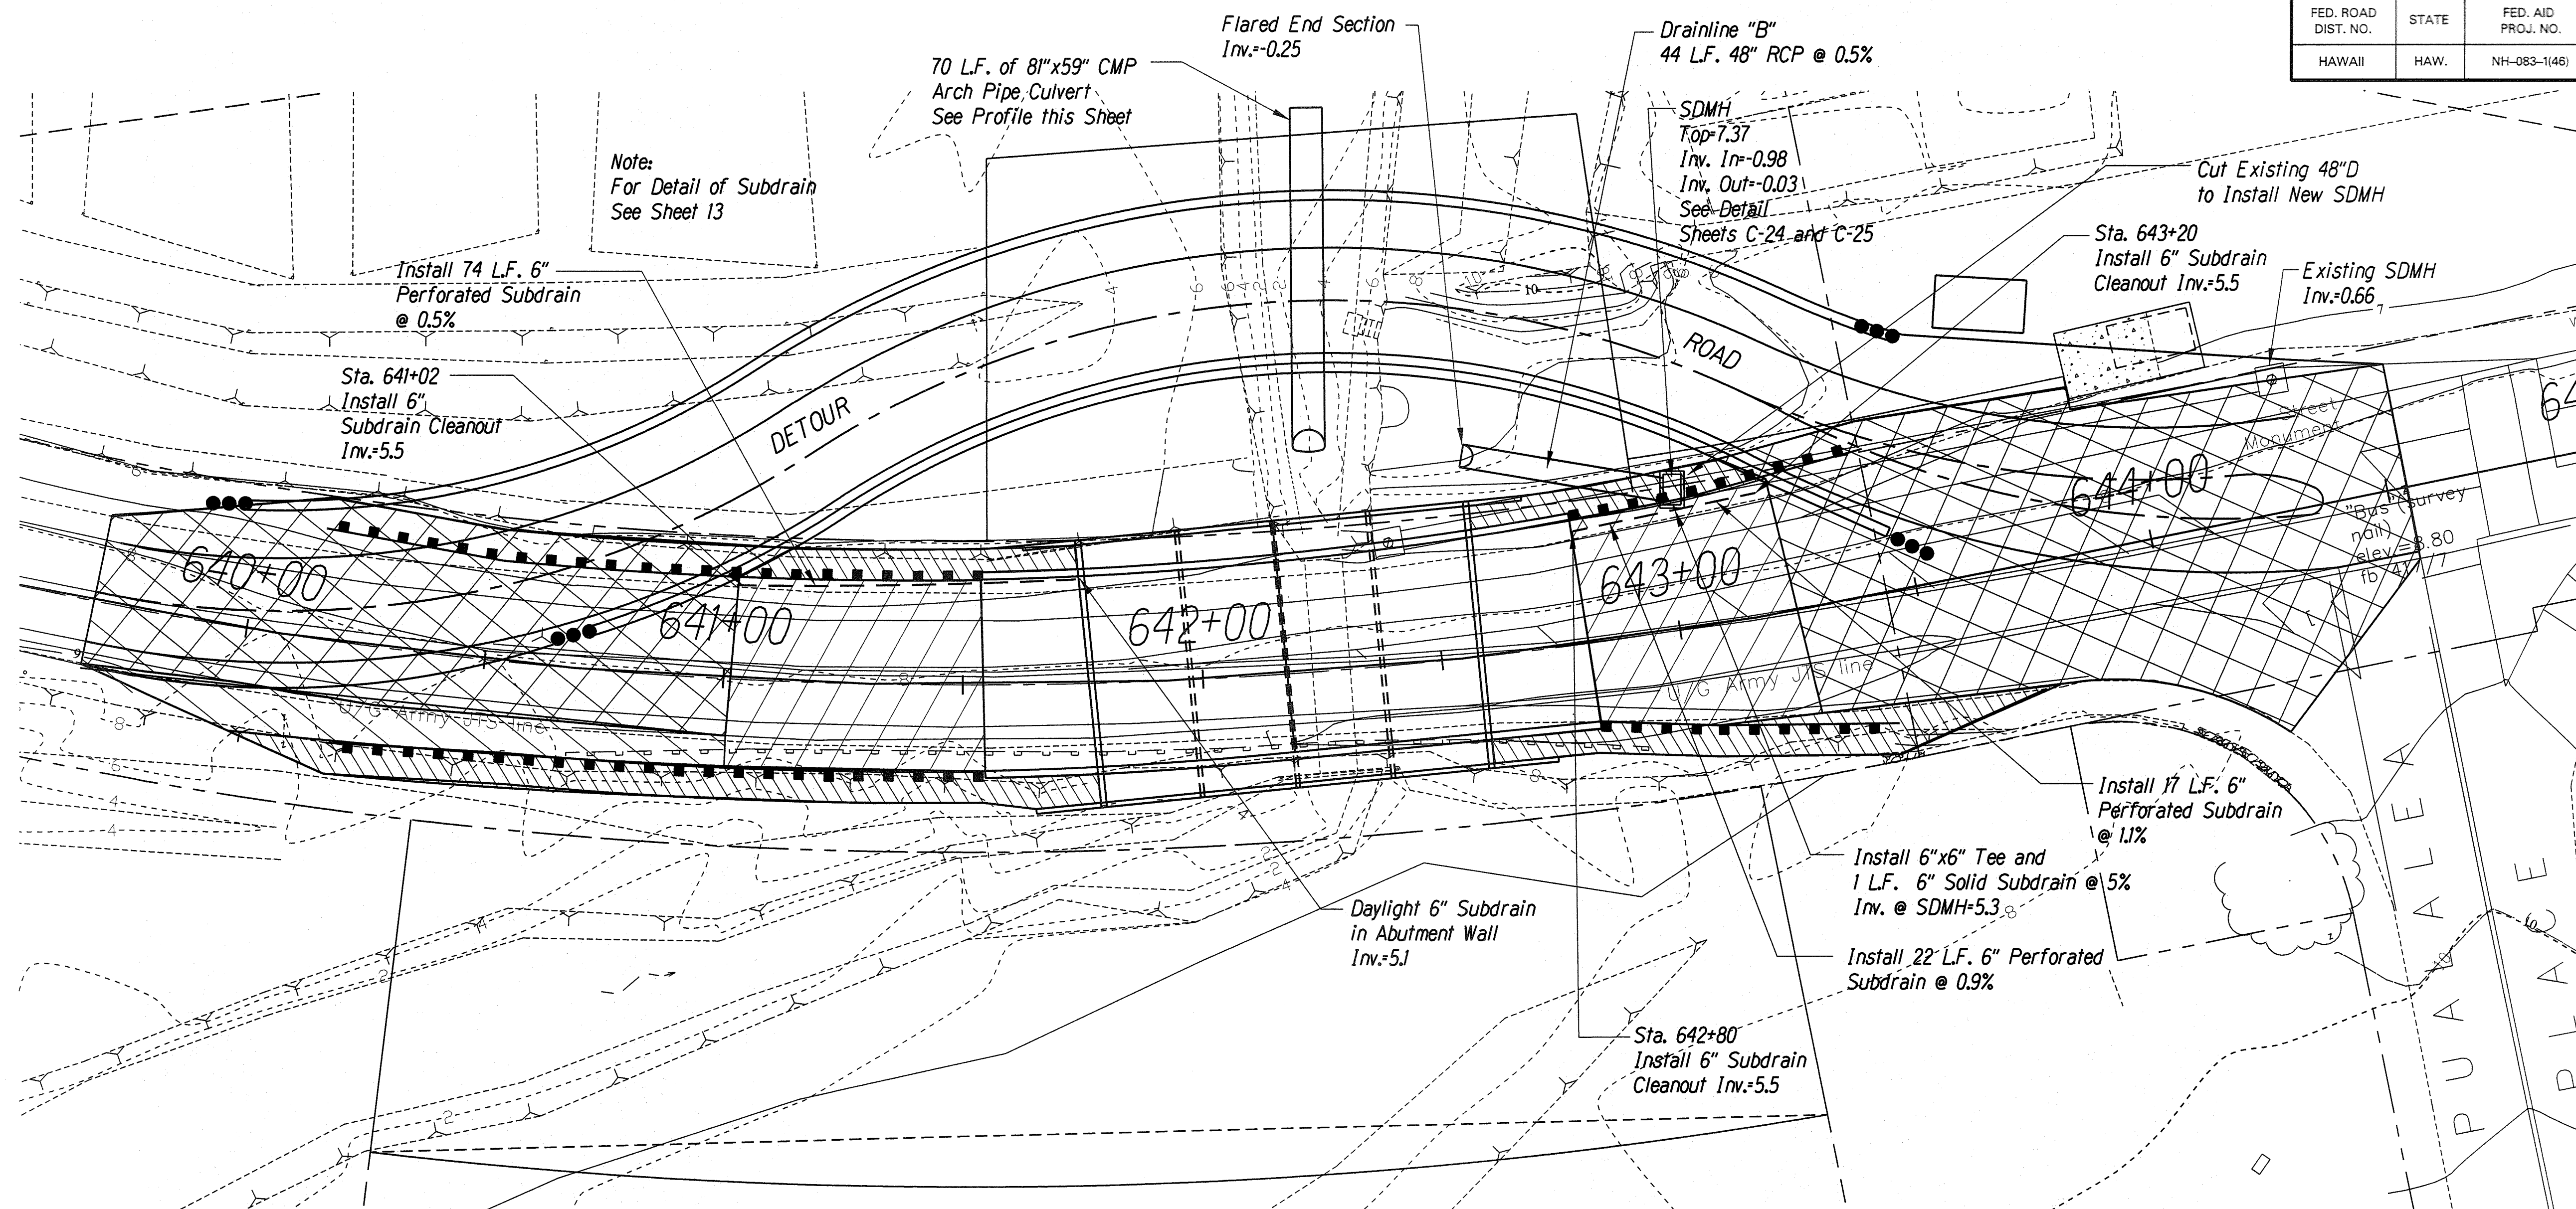


NOTE

All Kamehameha Highway Stationing Shown on this Sheet is Off by 3.23'. To Obtain Current D.O.T. Highways Stationing, Subtract 3.23' from any Station Shown.


PROFILE-DRAINLINE "B"

Scale: 1"=20'

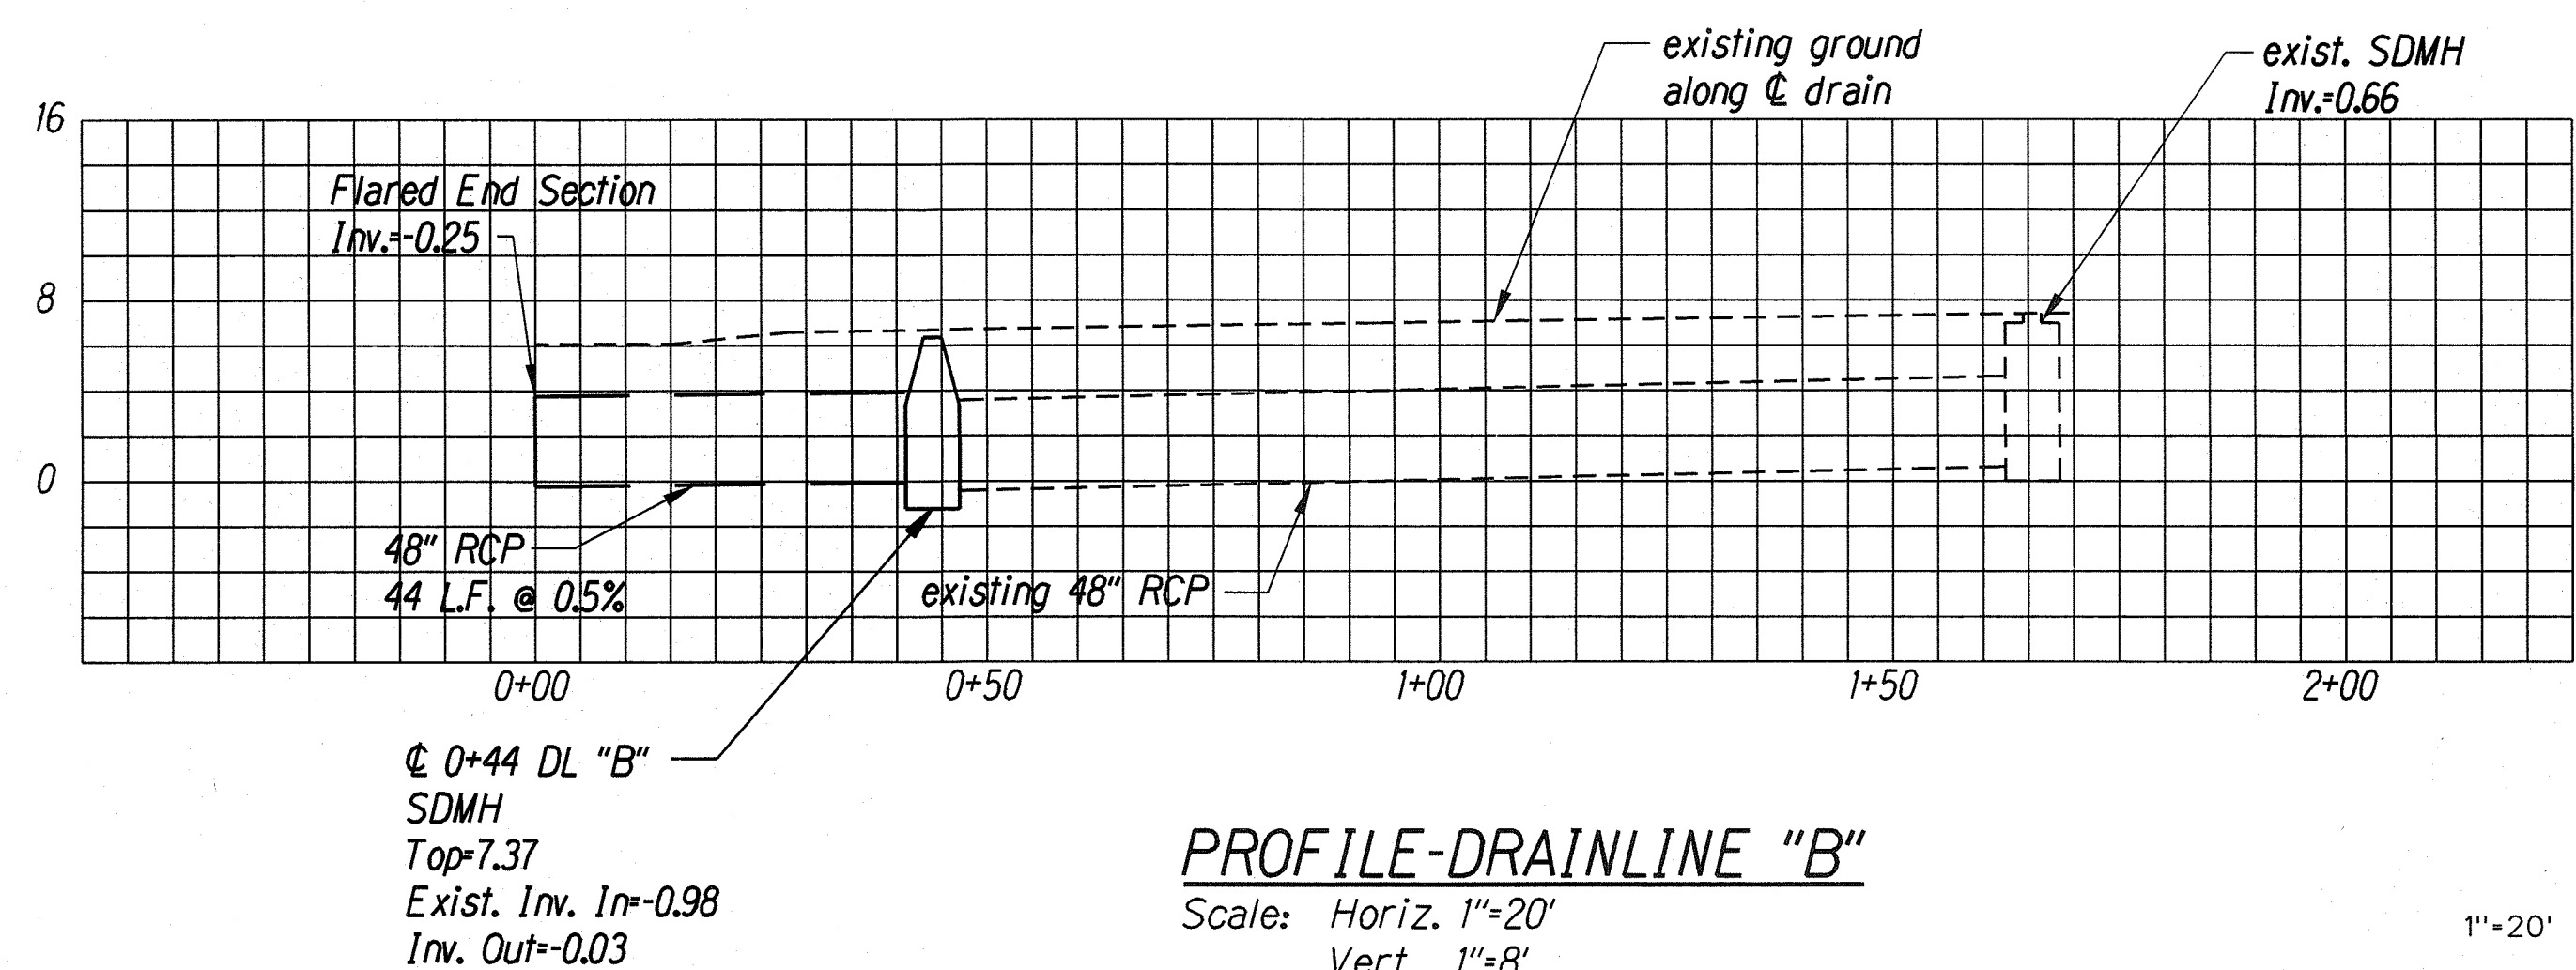

PROFILE-DRAINLINE "B"

Scale: Horiz. 1"=20'
Vert. 1"=8'

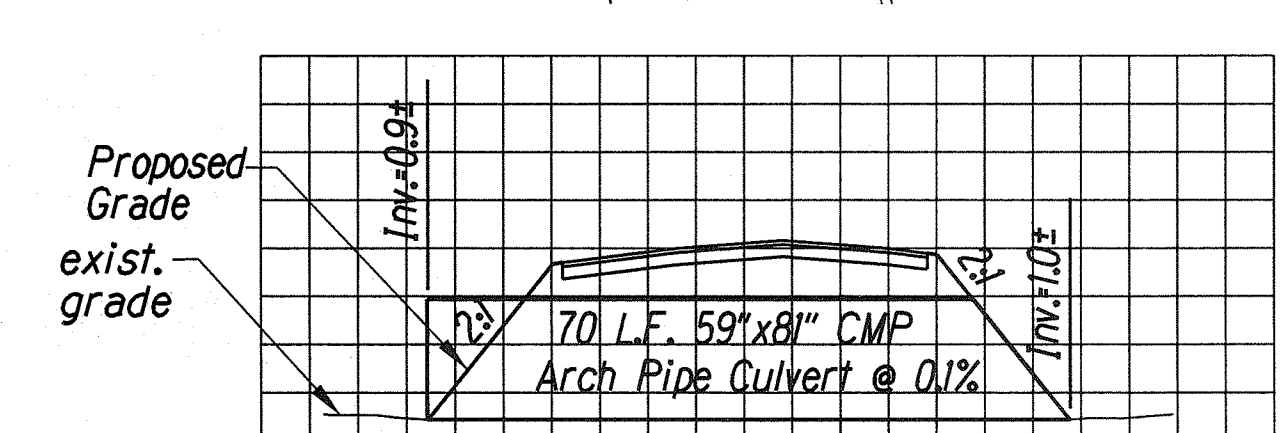


Notes:

- Inverts may vary depending on existing grades. Slope shown to remain.
- Follow recommendations in Geotechnical Report.
- Minimum cover specified by manufacturer must be maintained.

DETOUR ROAD CULVERT PROFILE

SCALE: HORIZ 1"=20'
VERT. 1"=8'

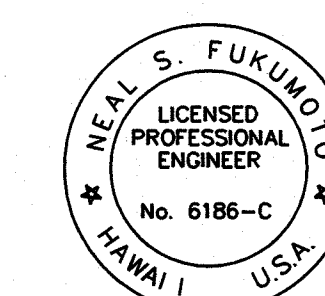

This work was prepared by me or under my supervision.
Exp. 04-30-10
Wesley R. Segawa & Associates, Inc.

STATE OF HAWAII
DEPARTMENT OF TRANSPORTATION
HIGHWAYS DIVISION

**HOSPITAL CULVERT
DRAINAGE & SUBDRAIN PLAN**

KAMEHAMEHA HIGHWAY DRAINAGE IMPROVEMENTS
Vicinity of Kahuku Hospital and Replacement of Kii Bridge
Federal Aid Project No. NH-083-1(46)
Scale: As Noted Date: April 2004

SHEET No. 1 OF 1 SHEETS

AS-BUILT

20

SURVEY PLOTTED BY	DATE
DRAWN BY	
TRACED BY	
DESIGNED BY	
CHECKED BY	
ORIGINAL PLAN	
NOTE BOOK	
FILE	