



FED. ROAD DIST. NO.	STATE	FED. AID PROJ. NO.	FISCAL YEAR	SHEET NO.	TOTAL SHEETS
HAWAII	HAW.	NH-083-1(46)	2002	15	89

Note:
After Completion of New Bus Shelter, Contractor to Transport Existing Bus Shelter to a New Site Within a 10 Mile Radius from Kahuku as Directed by the City and County.

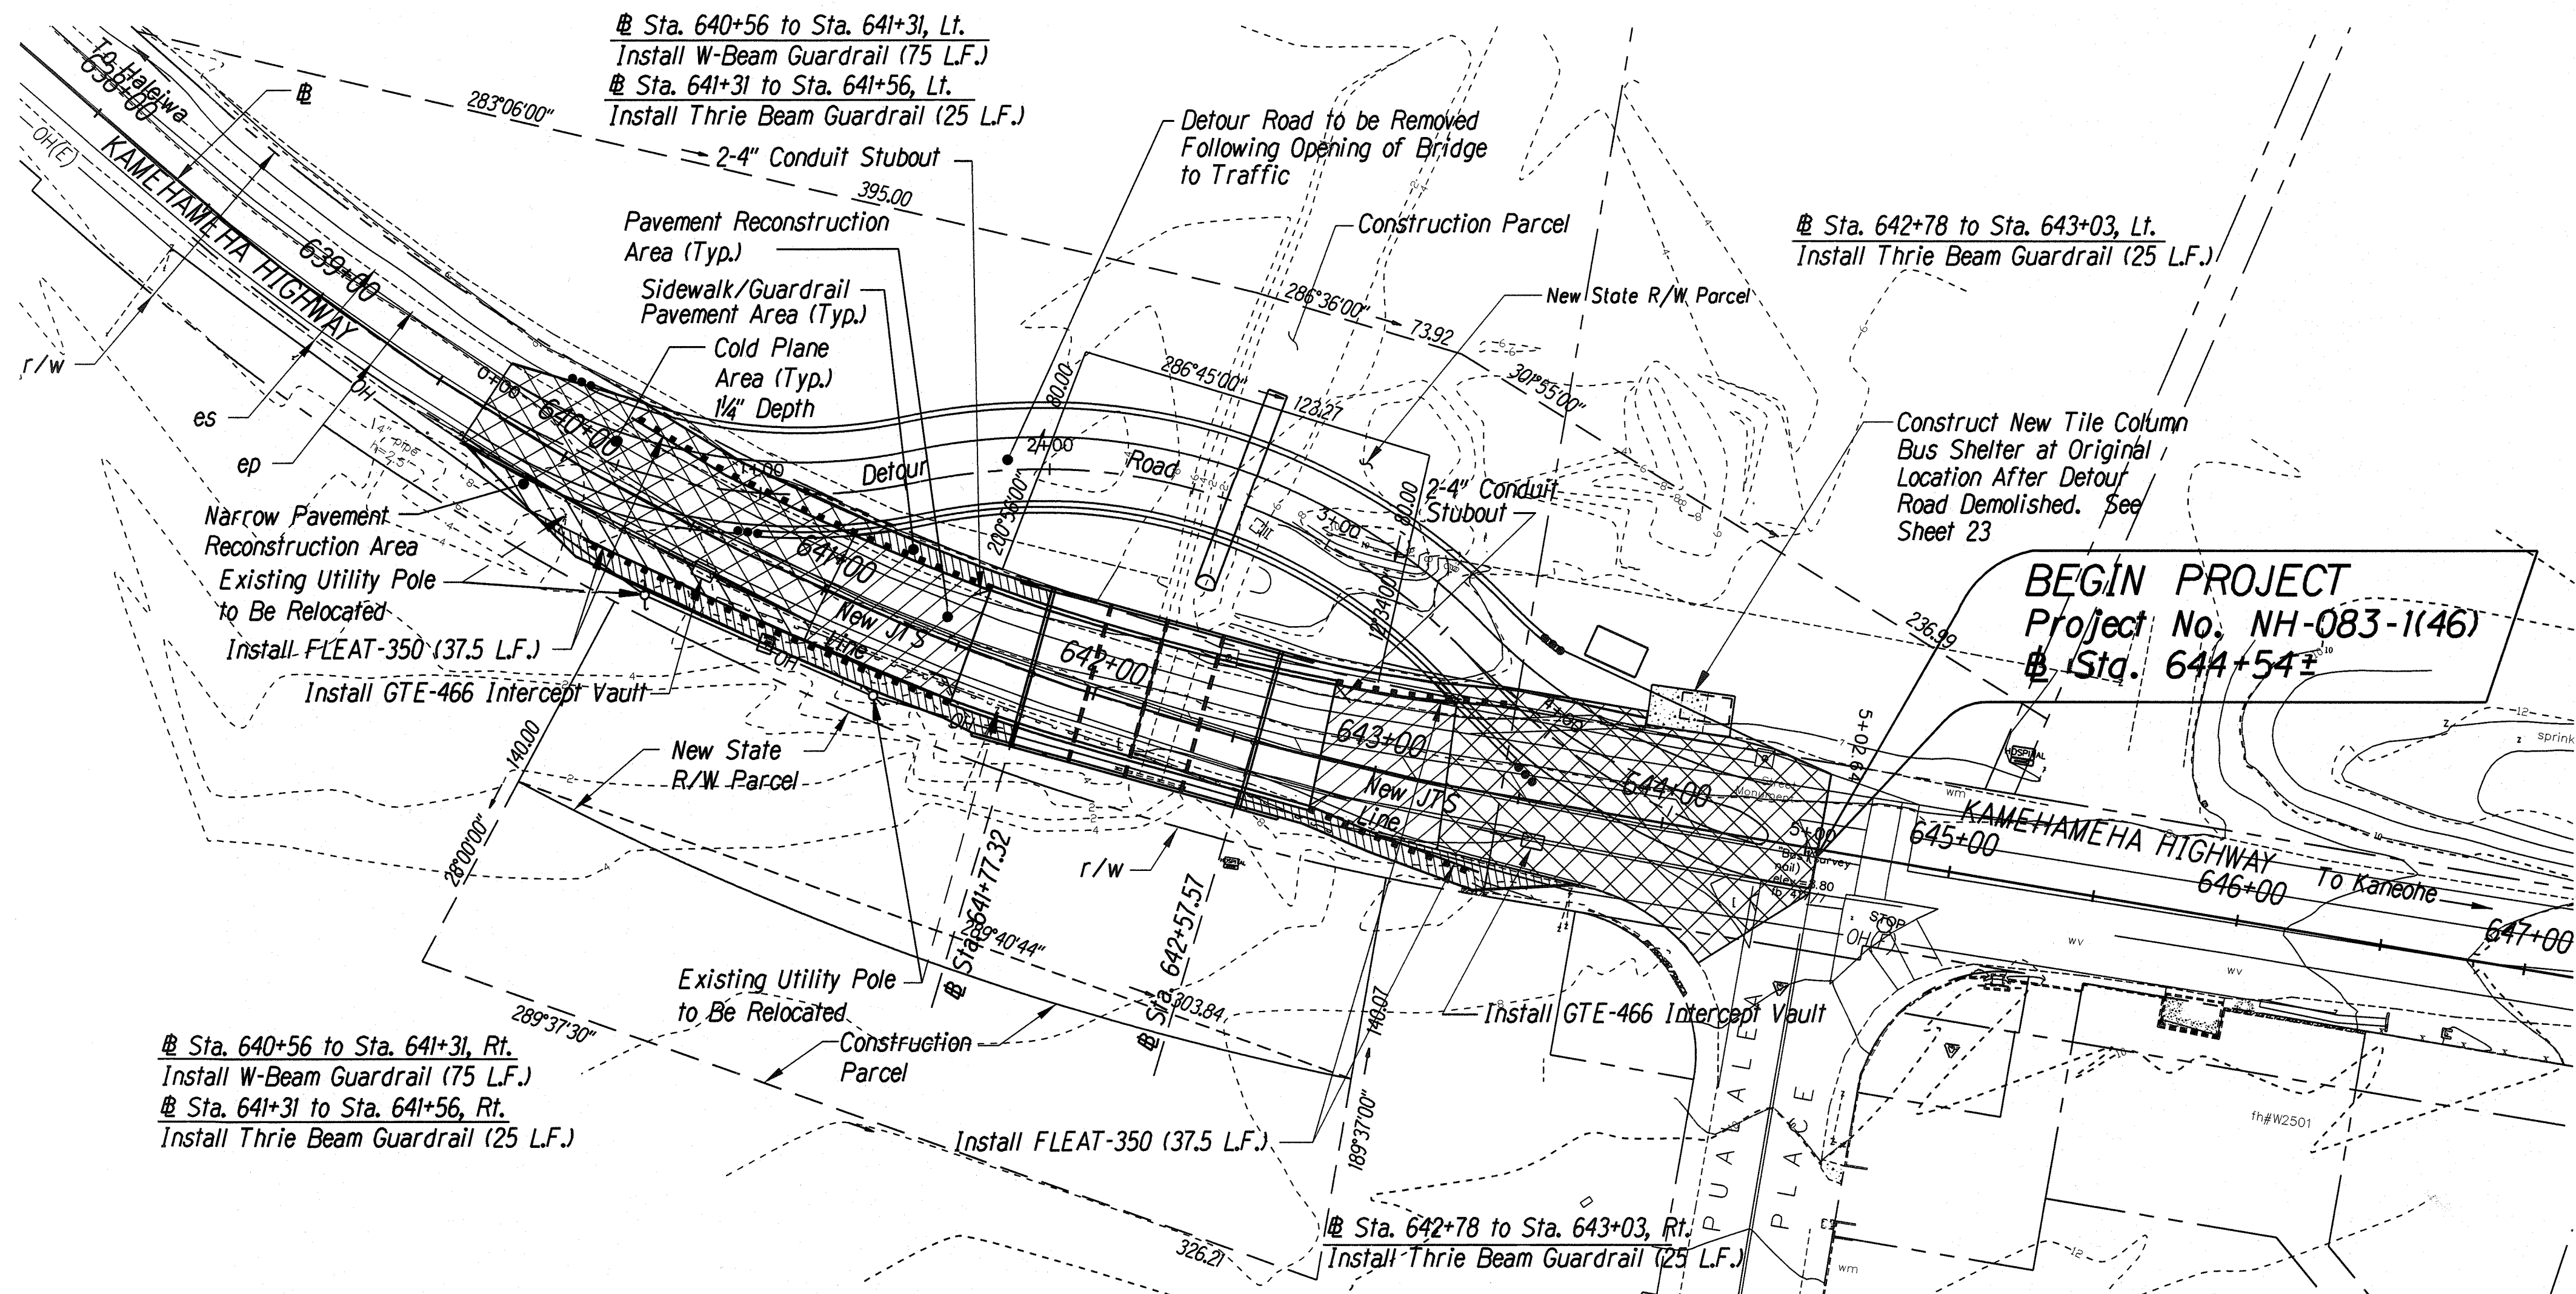


PLAN
Scale: 1"=40'


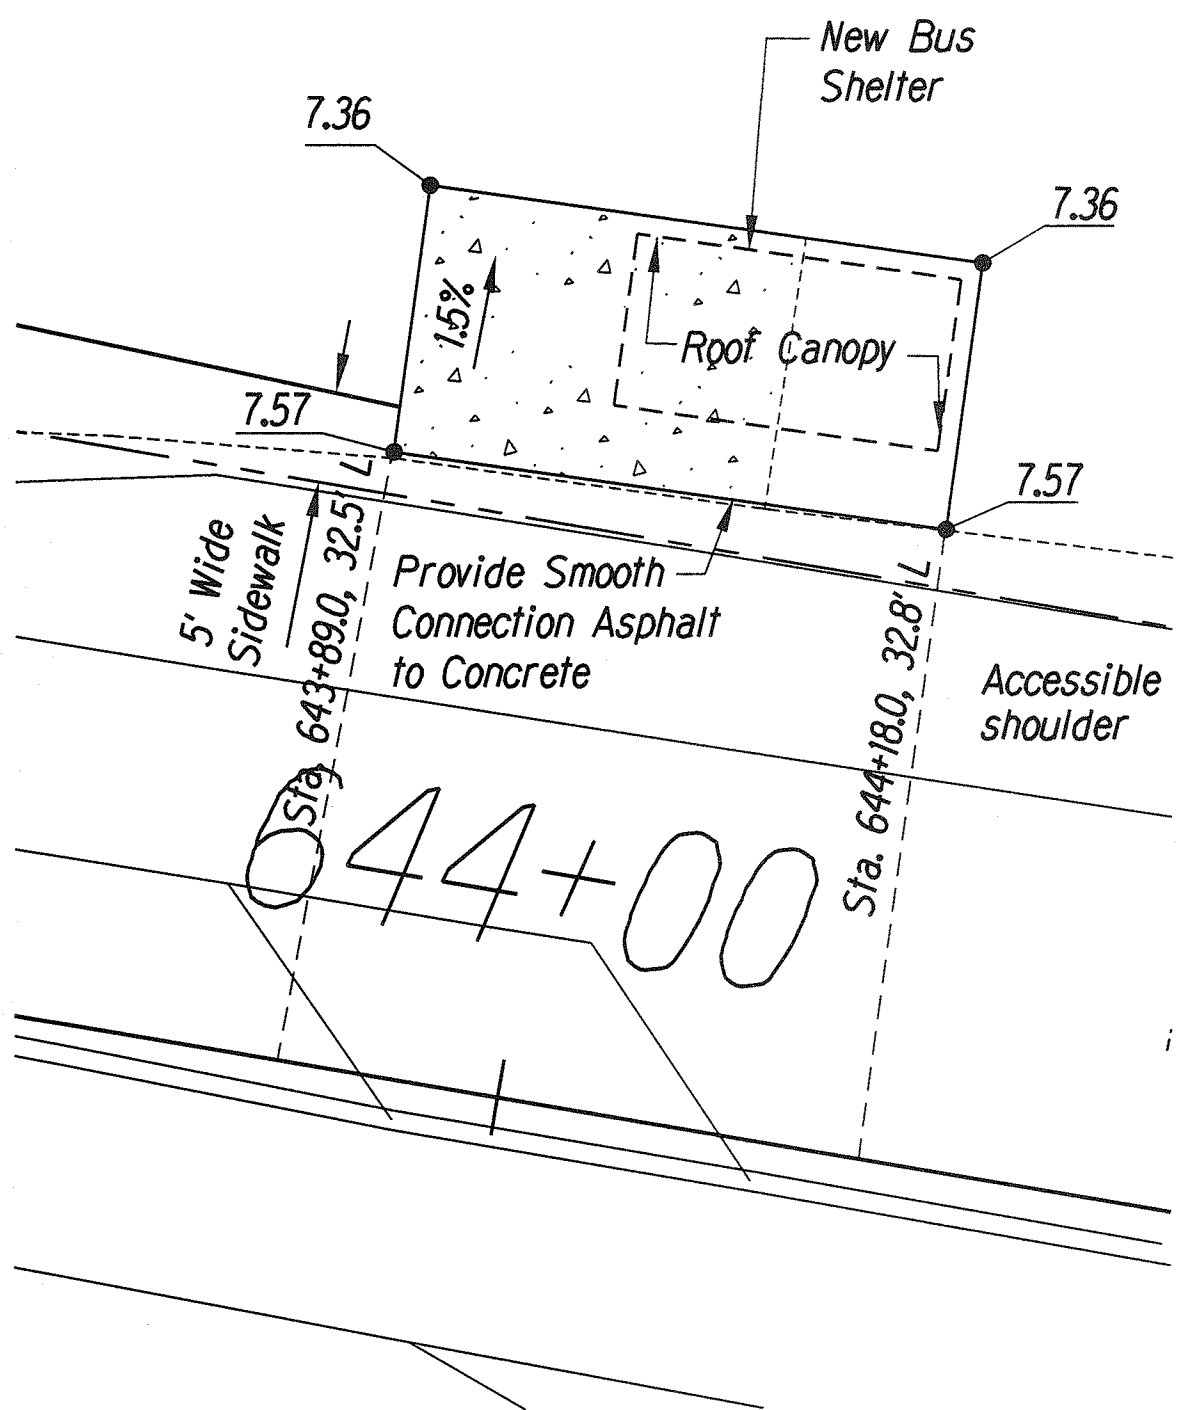


BUS SHELTER PLAN
Scale: 1"=10'

NOTE
All Kamehameha Highway Stationing Shown on this Sheet is Off by 3.23'. To Obtain Current D.O.T. Highways Stationing, Subtract 3.23' from any Station Shown.

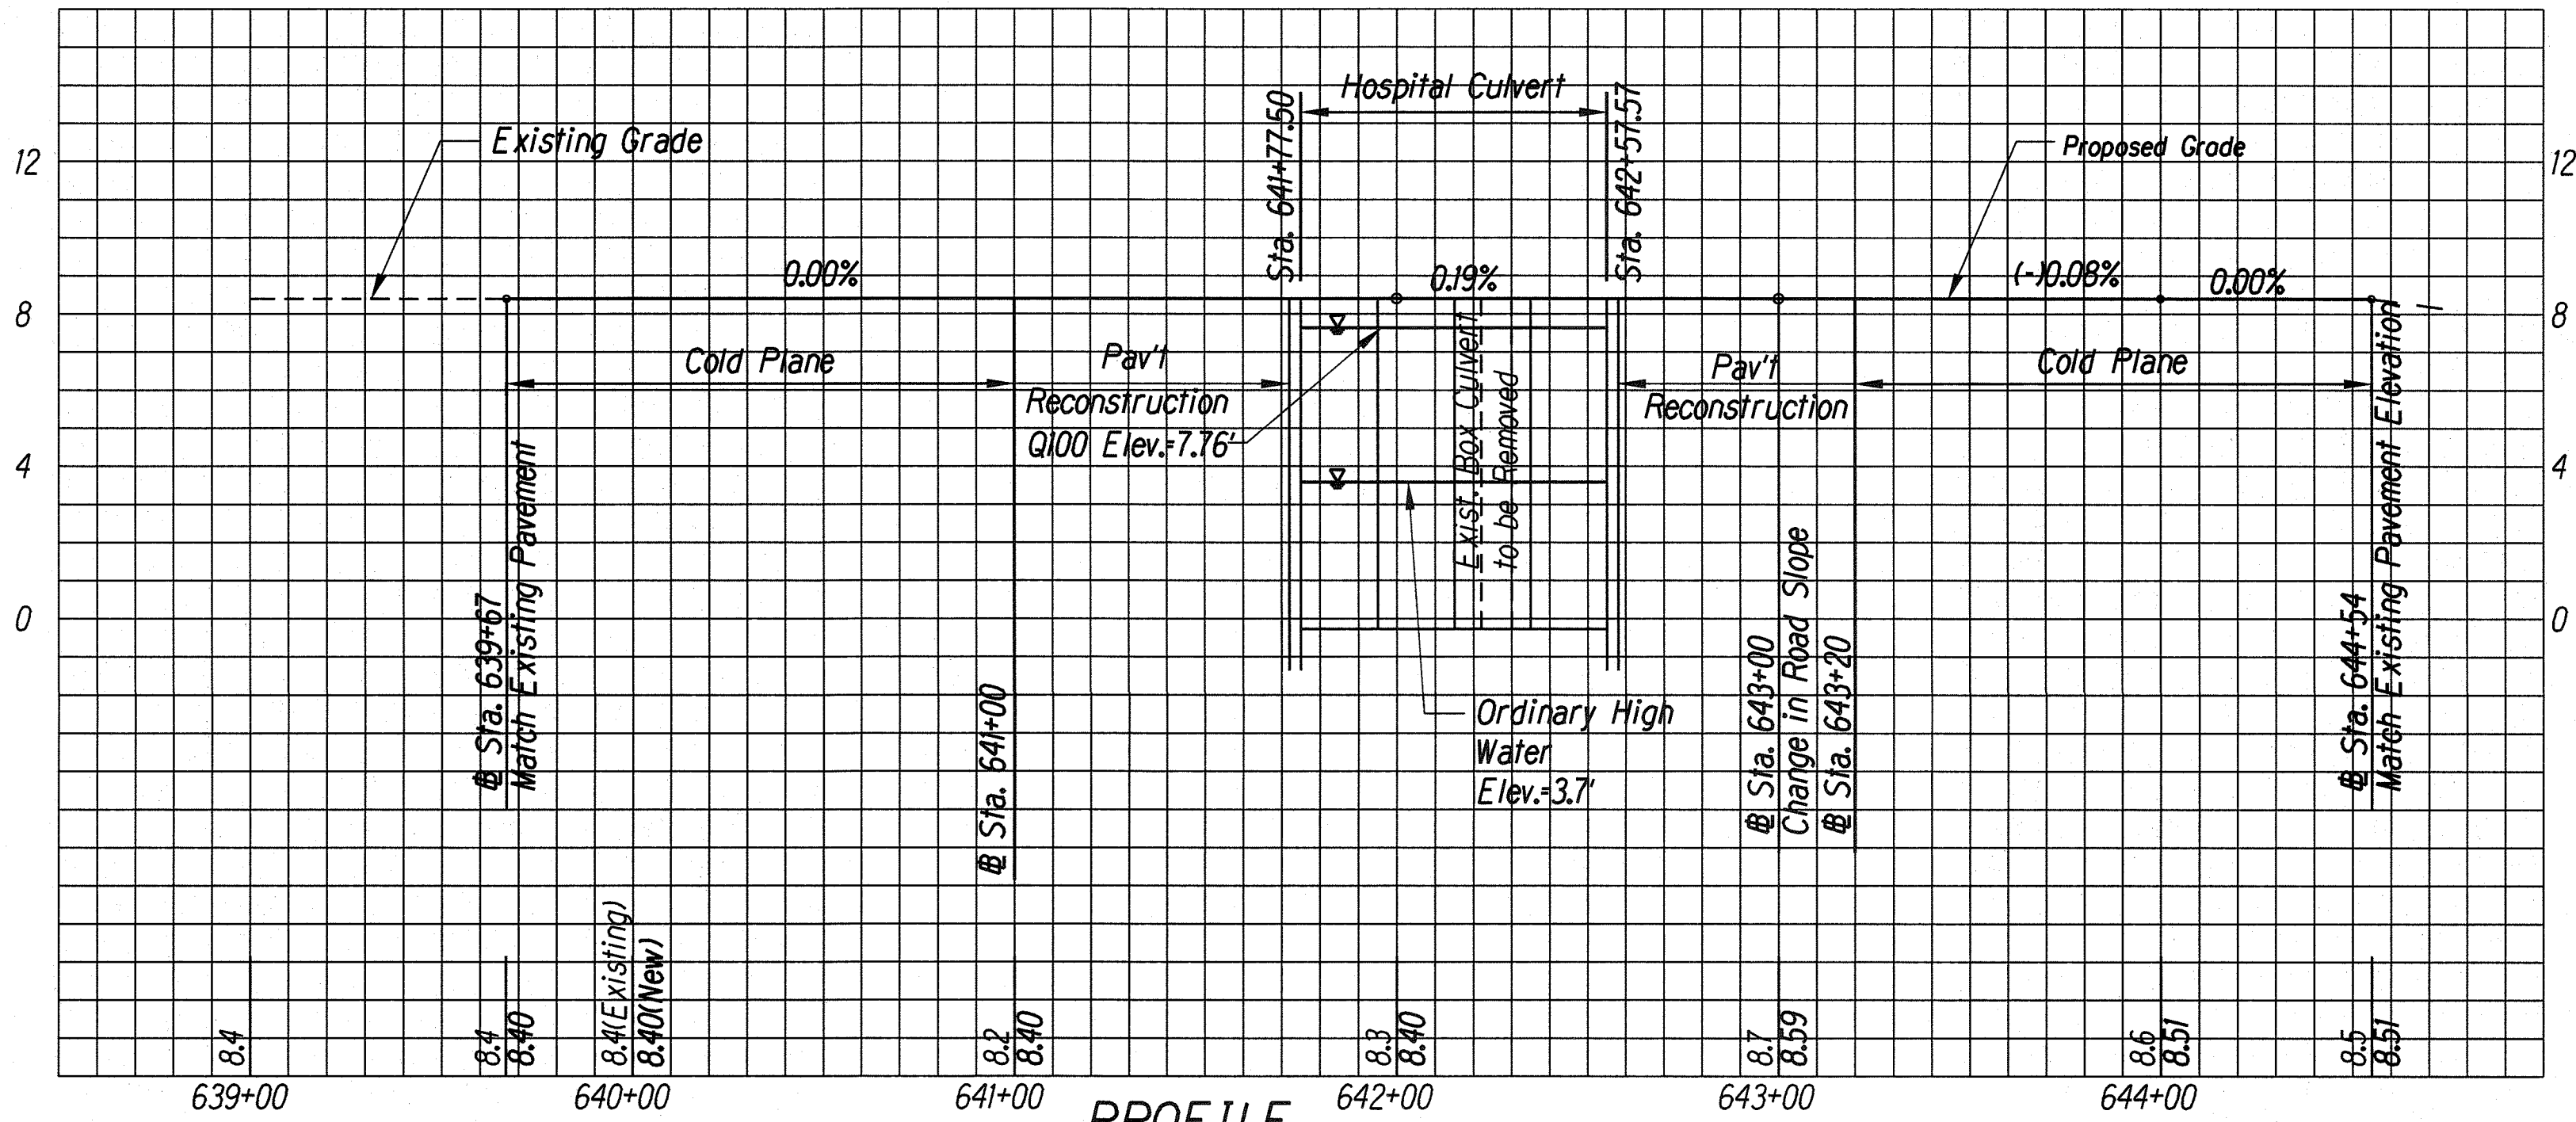

PROFILE
Scale: Horiz 1"=40'
Vert. 1"=4'

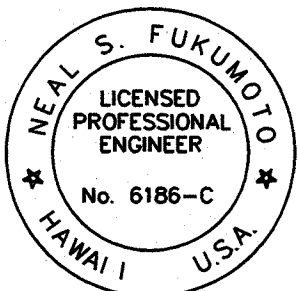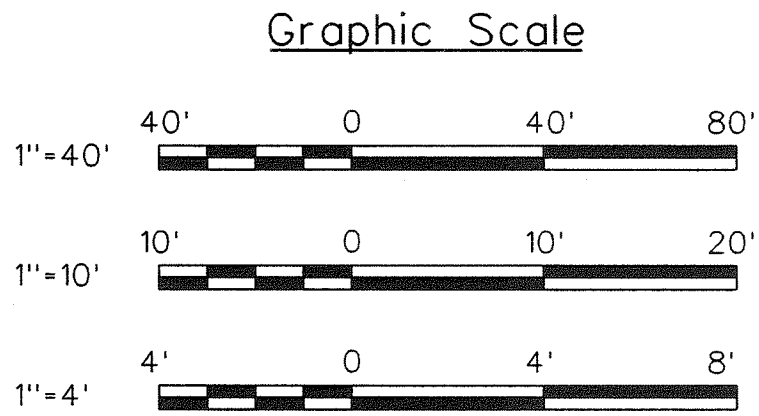

This work was prepared by me or under my supervision.
Exp. 04-30-10
Neal S. Fukunoto
Wesley R. Segawa & Associates, Inc.

STATE OF HAWAII
DEPARTMENT OF TRANSPORTATION
HIGHWAYS DIVISION

HOSPITAL CULVERT
PLAN & PROFILE

KAMEHAMEHA HIGHWAY DRAINAGE IMPROVEMENTS
Vicinity of Kahuku Hospital and Replacement of Kii Bridge
Federal Aid Project No. NH-083-1(46)

Scale: As Noted Date: April 2004

SHEET No. 1 OF 1 SHEETS

AS-BUILT