




FED. ROAD DIST. NO.	STATE	FED. AID PROJ. NO.	FISCAL YEAR	SHEET NO.	TOTAL SHEETS
HAWAII	HAW.	NH-083-1(46)	2002	19	89

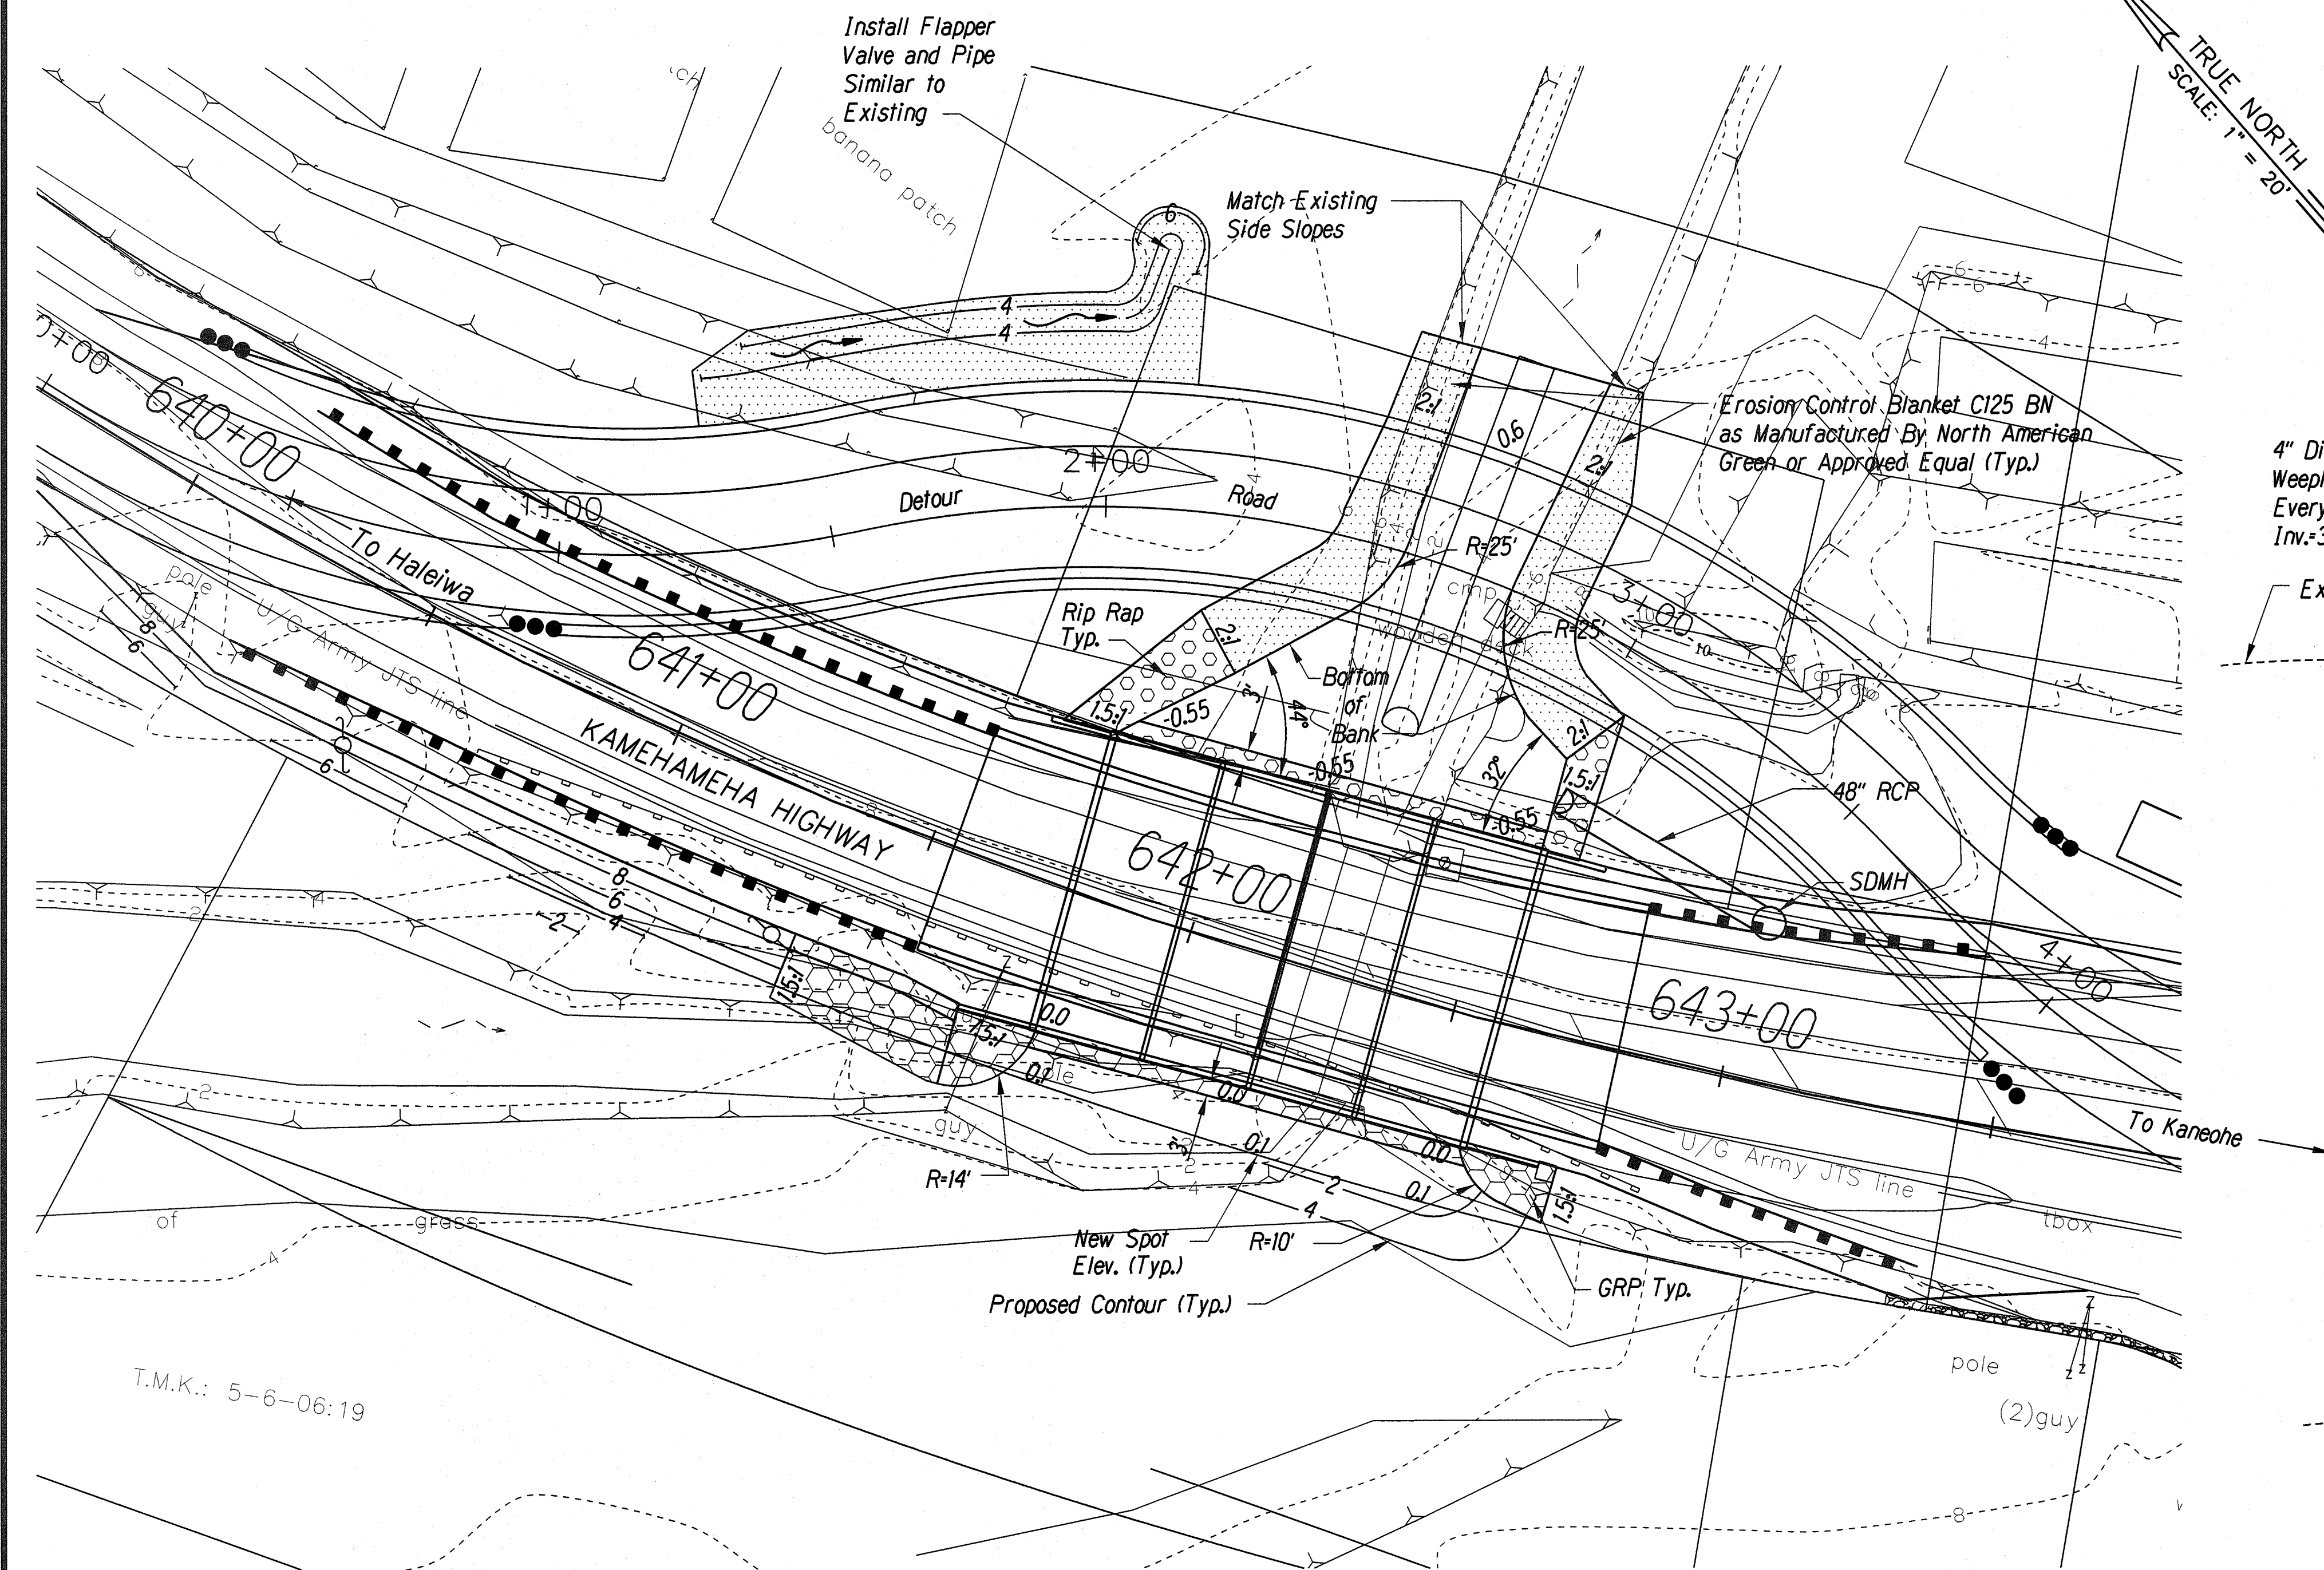


HOSPITAL CULVERT STREAM IMPROVEMENTS PLAN
Scale: 1"=20'

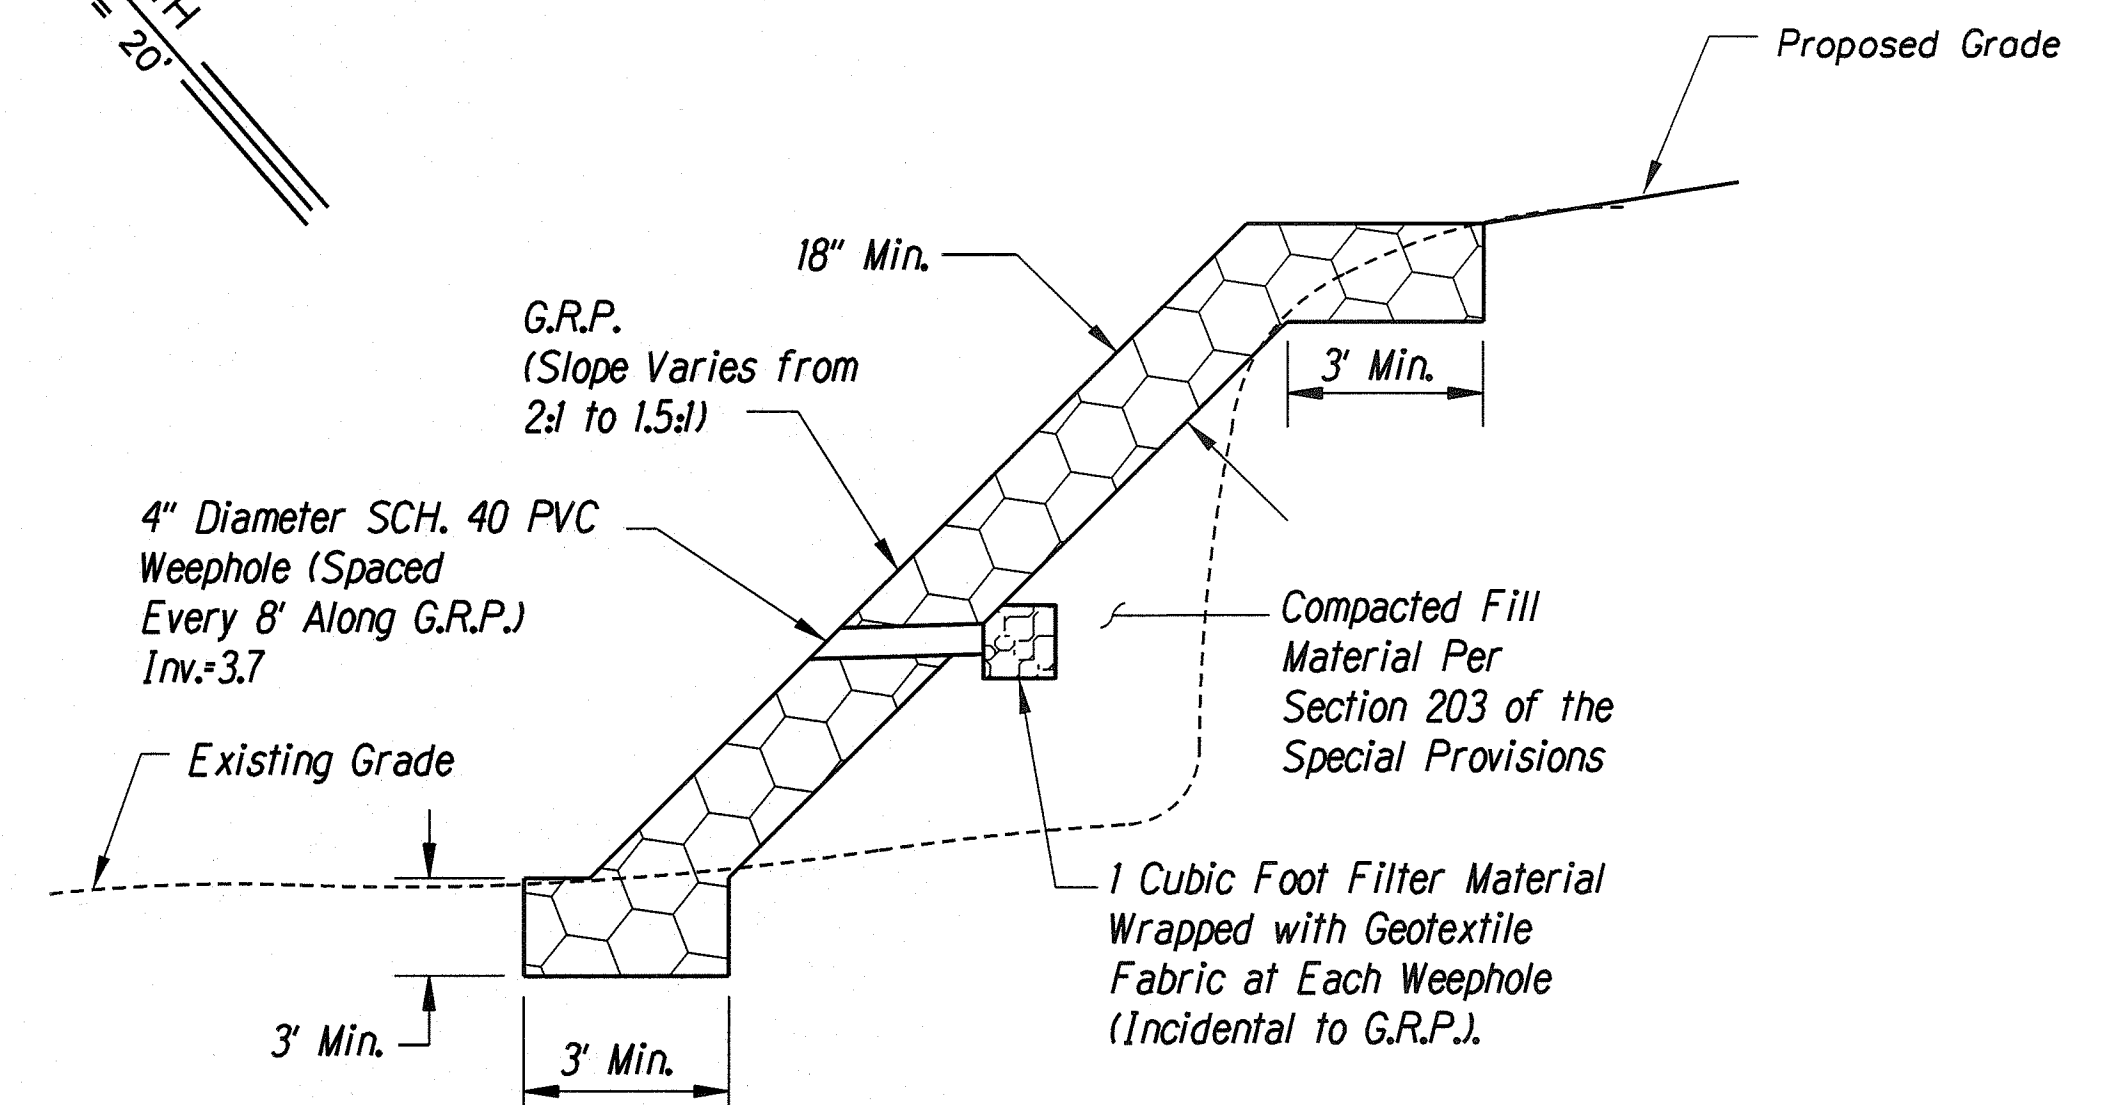


G.R.P. DETAIL
Not to Scale

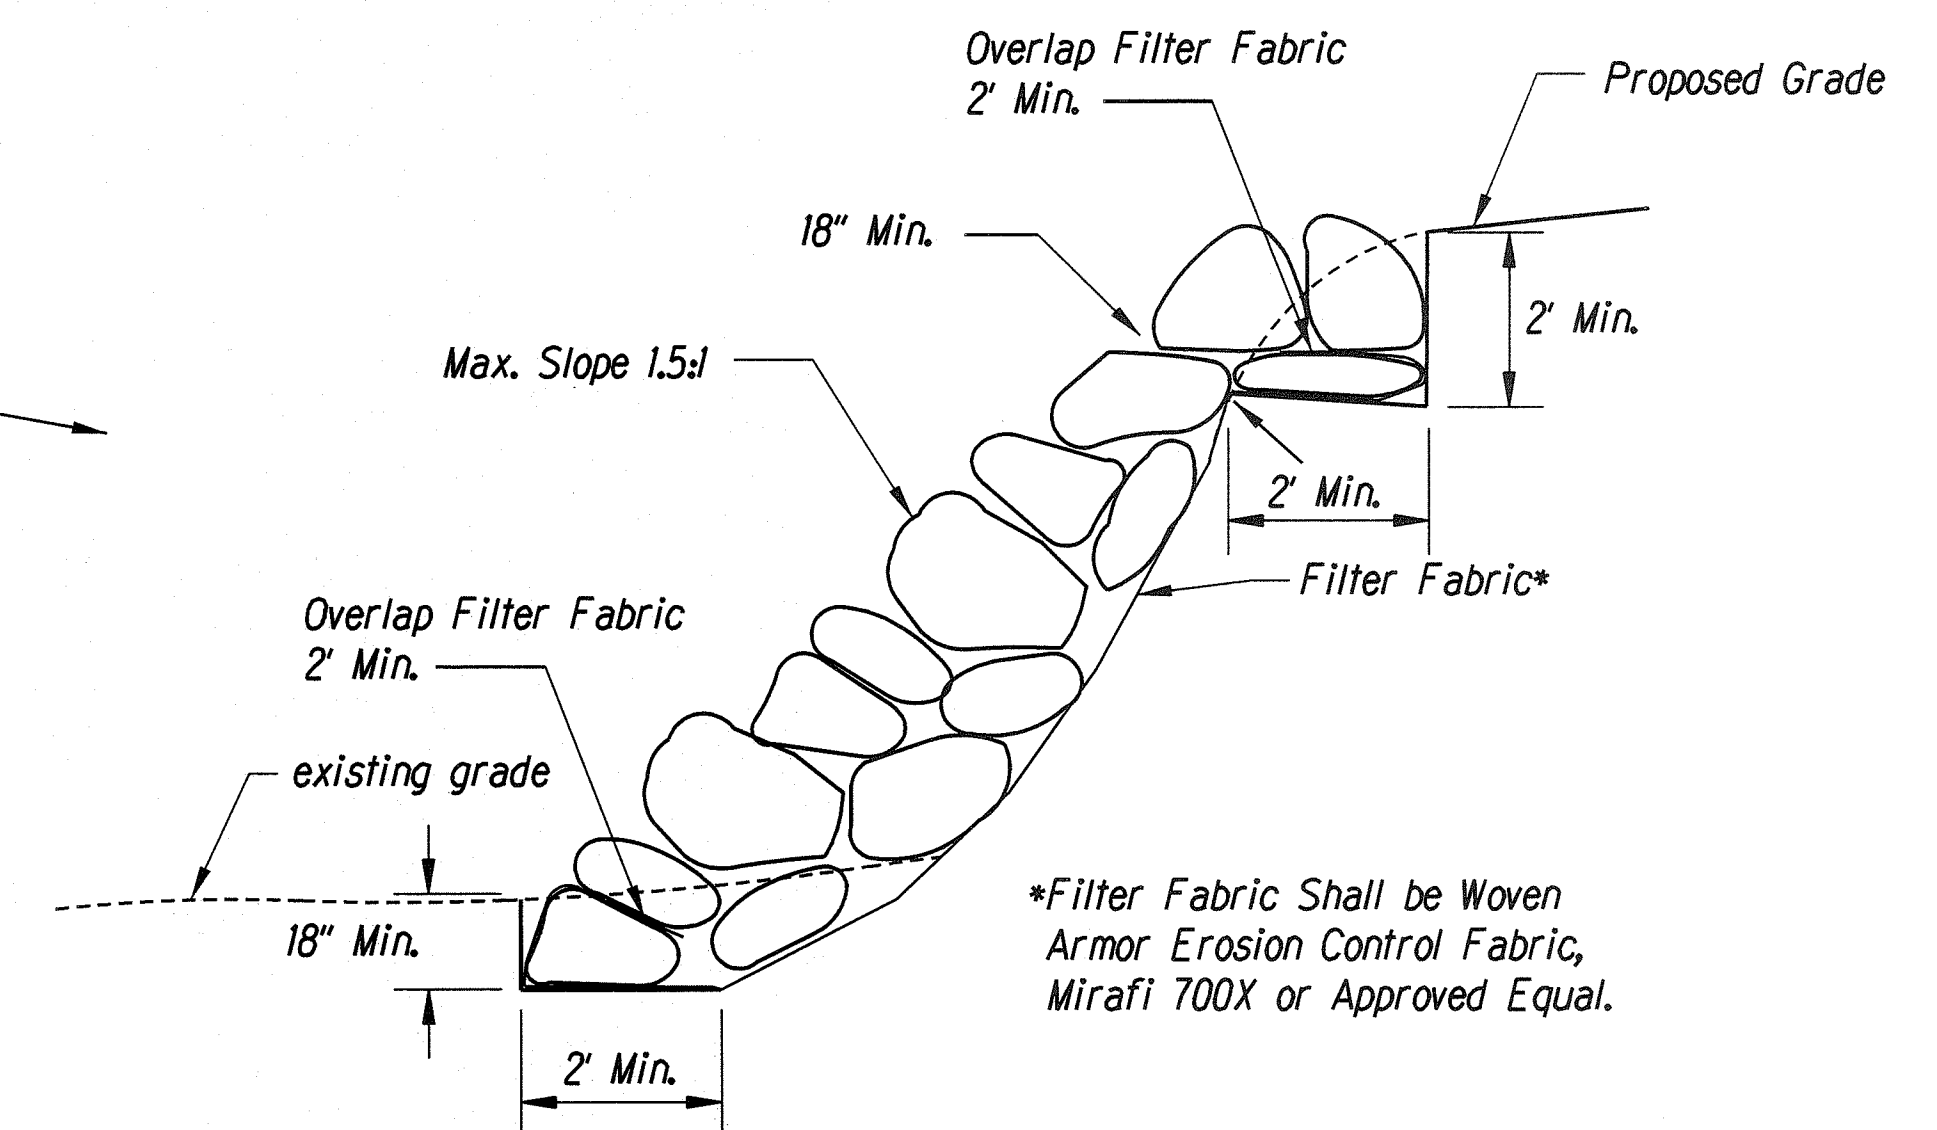

RIPRAP DETAIL
Not to Scale

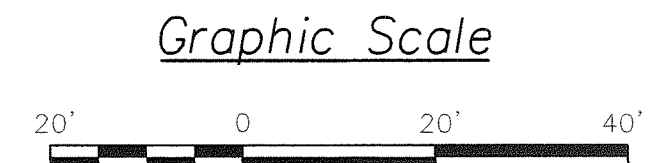

SURVEY PLOTTED BY	DATE
DRAWN BY	
DESIGNED BY	
CHECKED BY	
ORIGINAL PLAN	
NOTE BOOK	
N.	

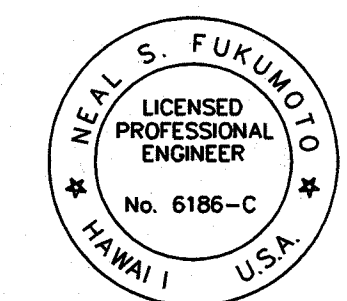

This work was prepared by me or under my supervision.
Exp. 04-30-10
Neal S. Fukumoto
Wesley R. Segawa & Associates, Inc.

STATE OF HAWAII
DEPARTMENT OF TRANSPORTATION
HIGHWAYS DIVISION
HOSPITAL CULVERT STREAM IMPROVEMENTS PLAN
KAMEHAMEHA HIGHWAY DRAINAGE IMPROVEMENTS
Vicinity of Kahuku Hospital and Replacement of Kii Bridge
Federal Aid Project No. NH-083-1(46)
Scale: 1" = 20' Date: April 2004
SHEET No. 1 OF 1 SHEETS

AS-BUILT