


FED. ROAD DIST. NO.	STATE	FED. AID PROJ. NO.	FISCAL YEAR	SHEET NO.	TOTAL SHEETS
HAWAII	HAW.	NH-083-1(46)	2002	11	89

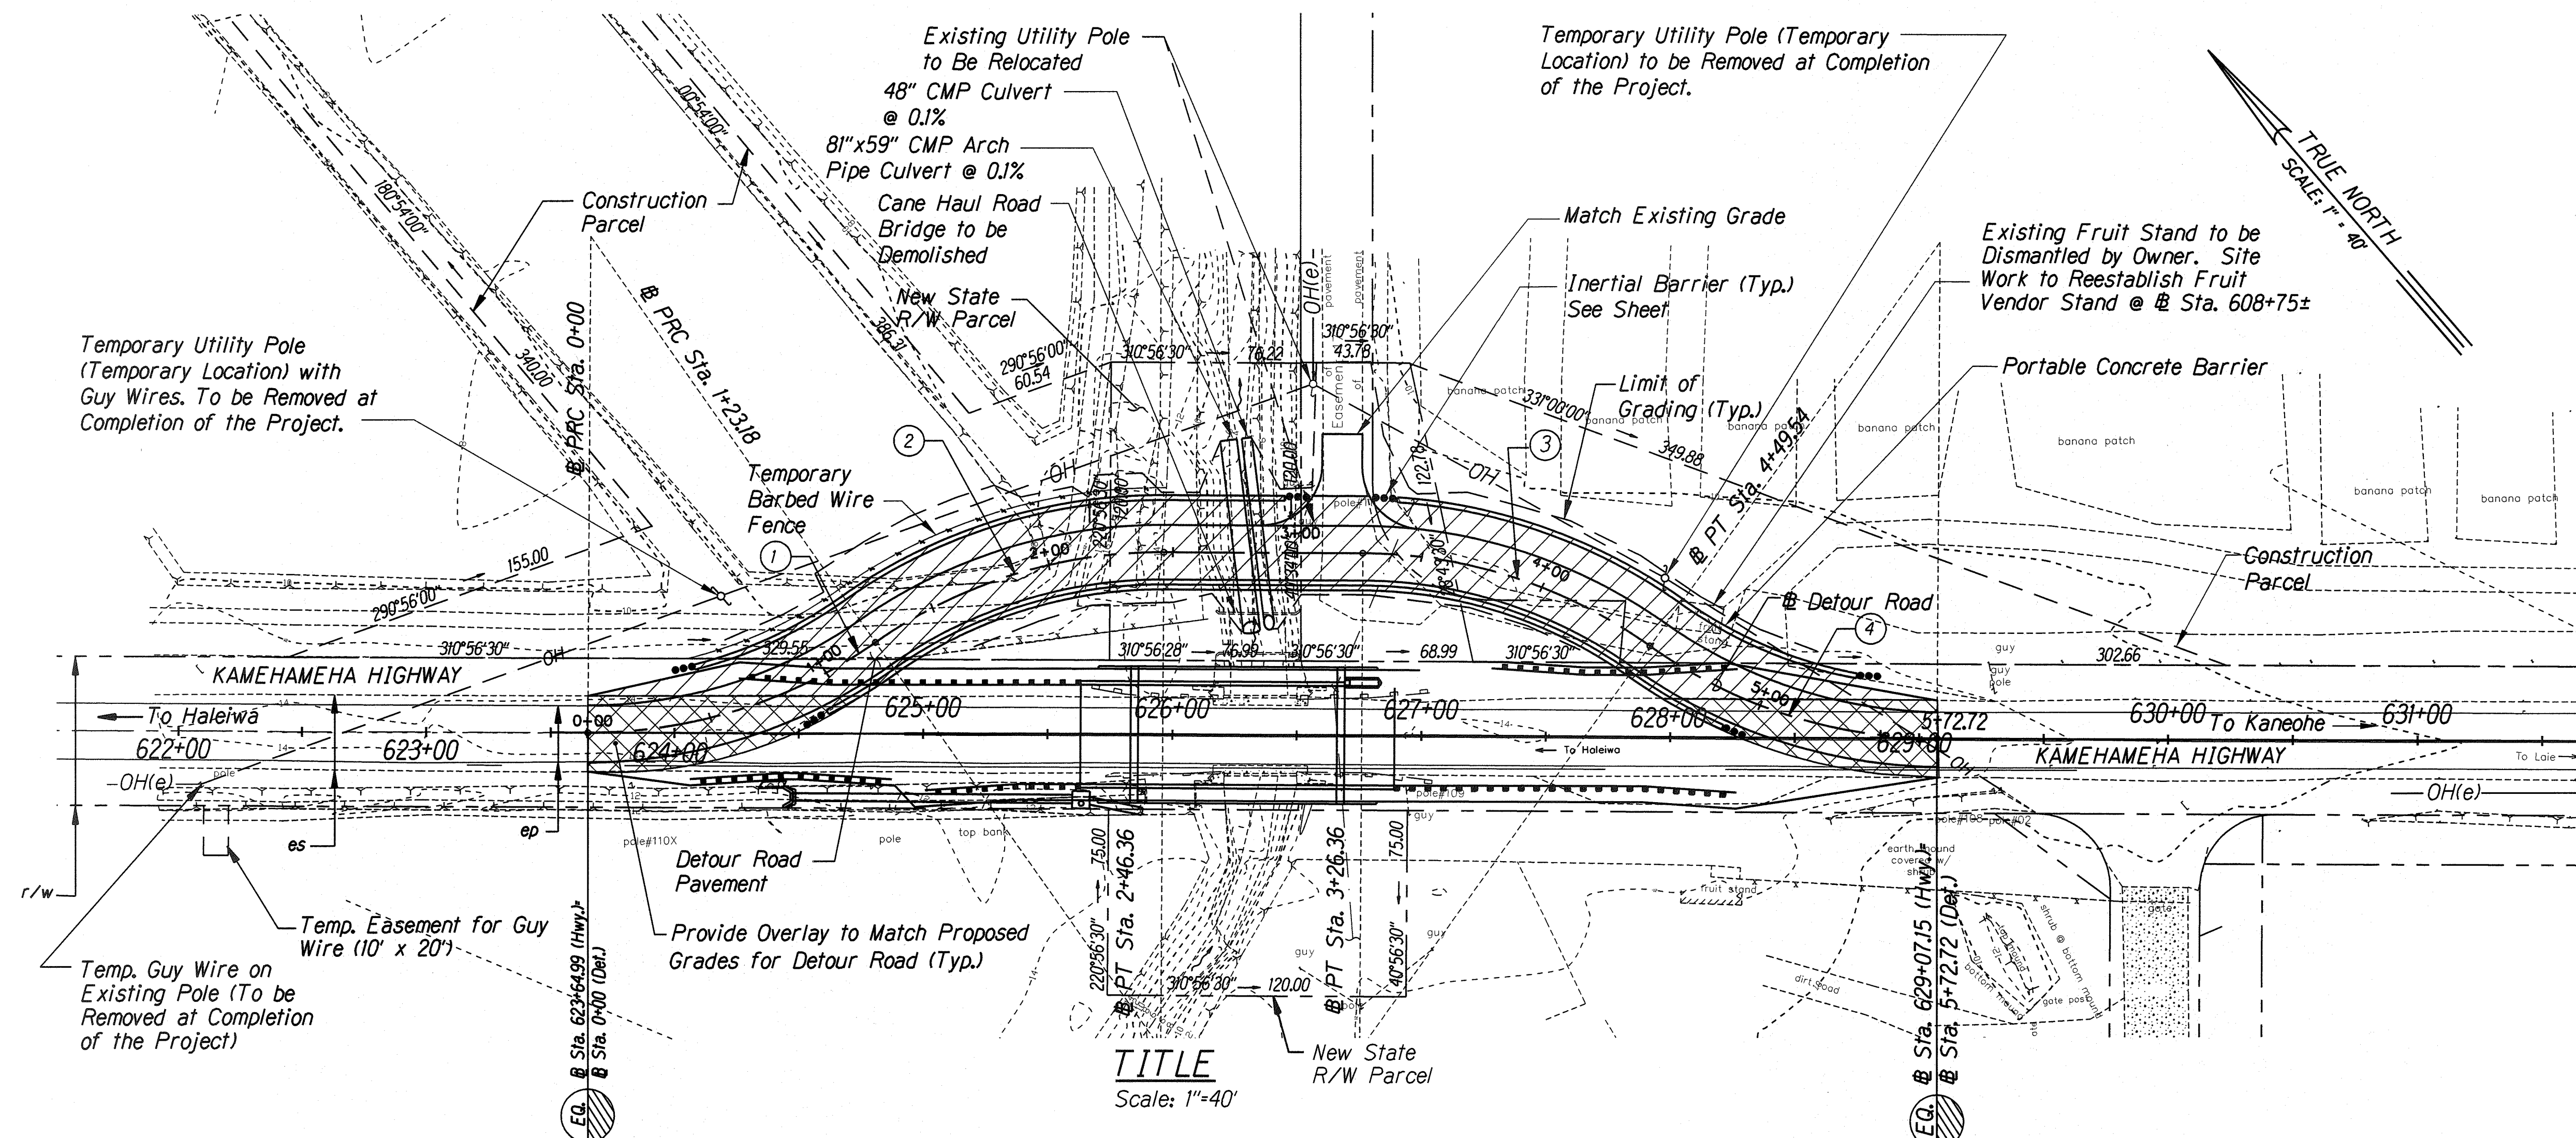

① CURVE DATA

$\Delta = 35^\circ 17' 18''$
 $\Delta/2 = 17^\circ 38' 39''$
 $R = 200.00$
 $T = 63.61$
 $Ch = 121.24$
 $Lc = 123.18$

② CURVE DATA


$\Delta = 35^\circ 17' 18''$
 $\Delta/2 = 17^\circ 38' 39''$
 $R = 200.00$
 $T = 63.61$
 $Ch = 121.24$
 $Lc = 123.18$

③ CURVE DATA

$\Delta = 35^\circ 17' 18''$
 $\Delta/2 = 17^\circ 38' 39''$
 $R = 200.00$
 $T = 63.61$
 $Ch = 121.24$
 $Lc = 123.18$

④ CURVE DATA


$\Delta = 35^\circ 17' 18''$
 $\Delta/2 = 17^\circ 38' 39''$
 $R = 200.00$
 $T = 63.61$
 $Ch = 121.24$
 $Lc = 123.18$

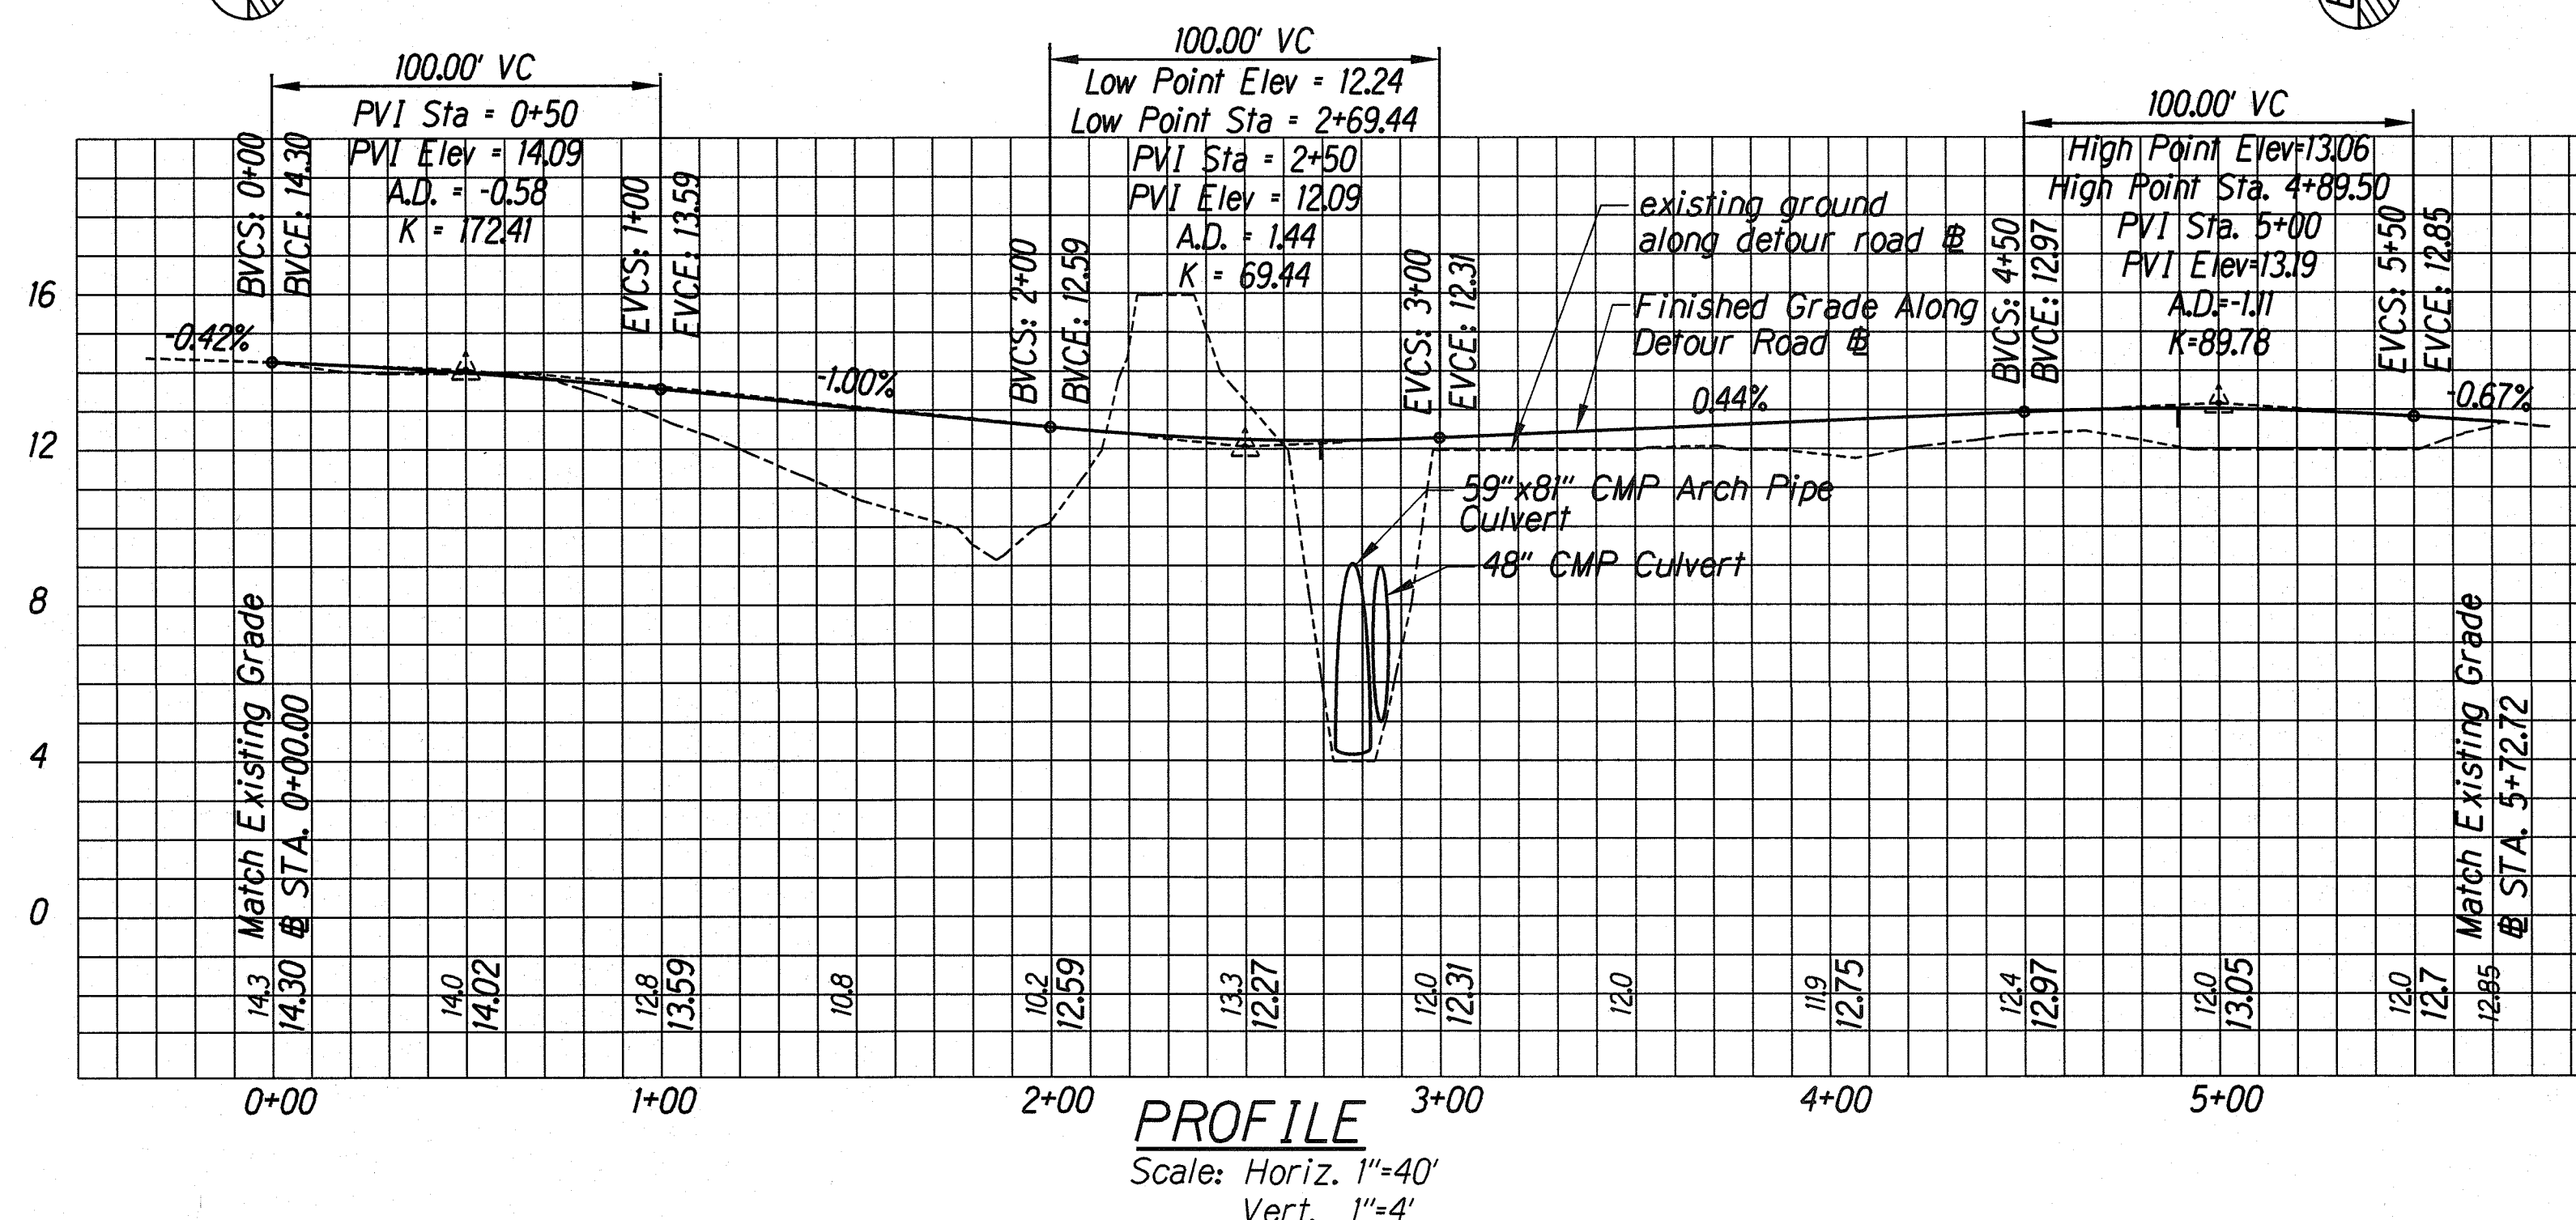


NOTE

All Kamehameha Highway Stationing Shown on this Sheet is Off By 3.23'. To Obtain Current D.O.T. Highways Stationing, Subtract 3.23' From Any Station Shown.

Graphic Scale

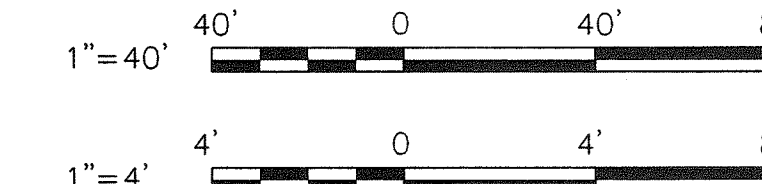

Director, Dept. of Environmental Services Date

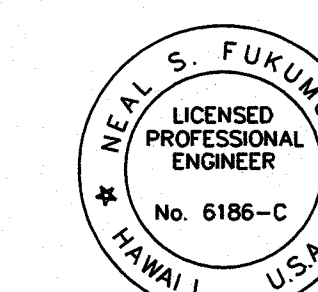

This work was prepared by me or under my supervision. Exp. 04-30-10

Wesley R. Segawa & Associates, Inc.

STATE OF HAWAII
 DEPARTMENT OF TRANSPORTATION
 HIGHWAYS DIVISION
KII BRIDGE DETOUR ROAD
PLAN & PROFILE
 KAMEHAMEHA HIGHWAY DRAINAGE IMPROVEMENTS
 Vicinity of Kahuku Hospital and Replacement of Kii Bridge
 Federal Aid Project No. NH-083-1(46)
 Scale: As Shown Date: April 2004
 SHEET No. 2 OF 2 SHEETS

AS-BUILT

11