

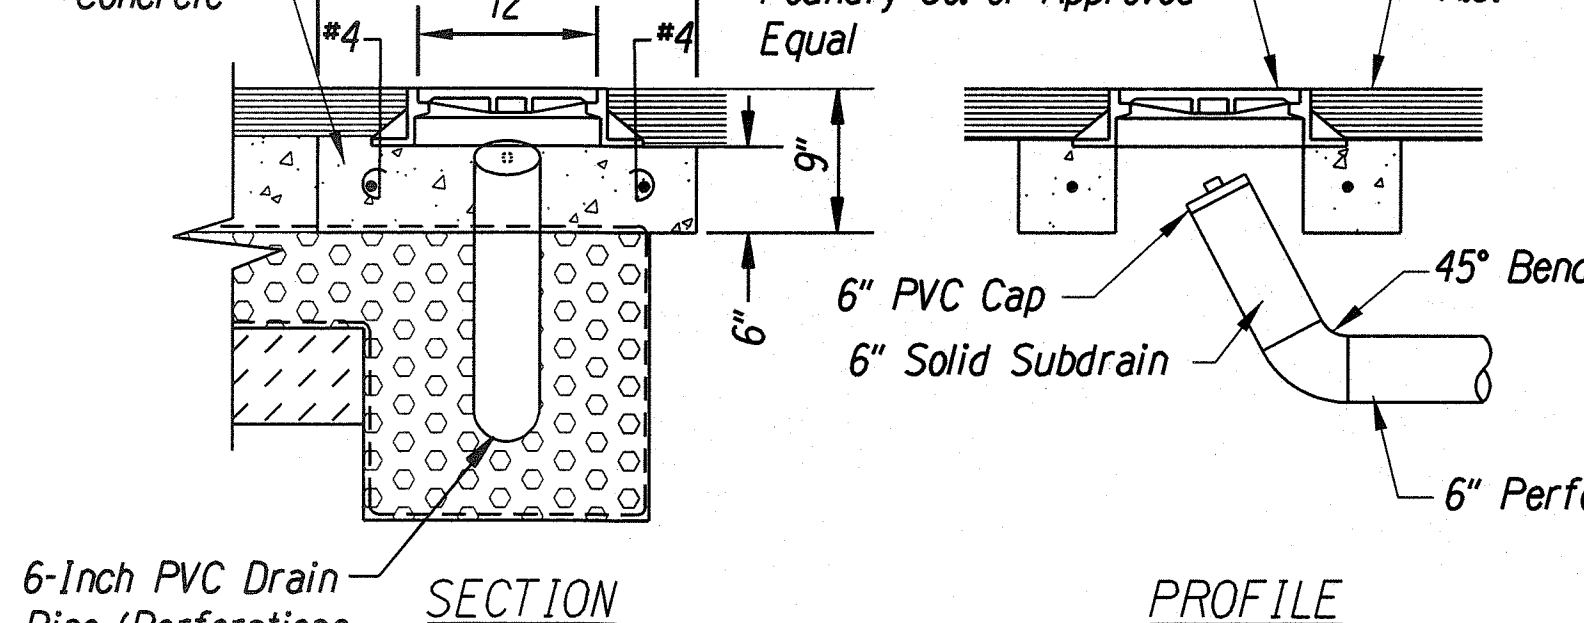



FED. ROAD DIST. NO.	STATE	FED. AID PROJ. NO.	FISCAL YEAR	SHEET NO.	TOTAL SHEETS
HAWAII	HAW.	NH-083-1(46)	2002	13	89

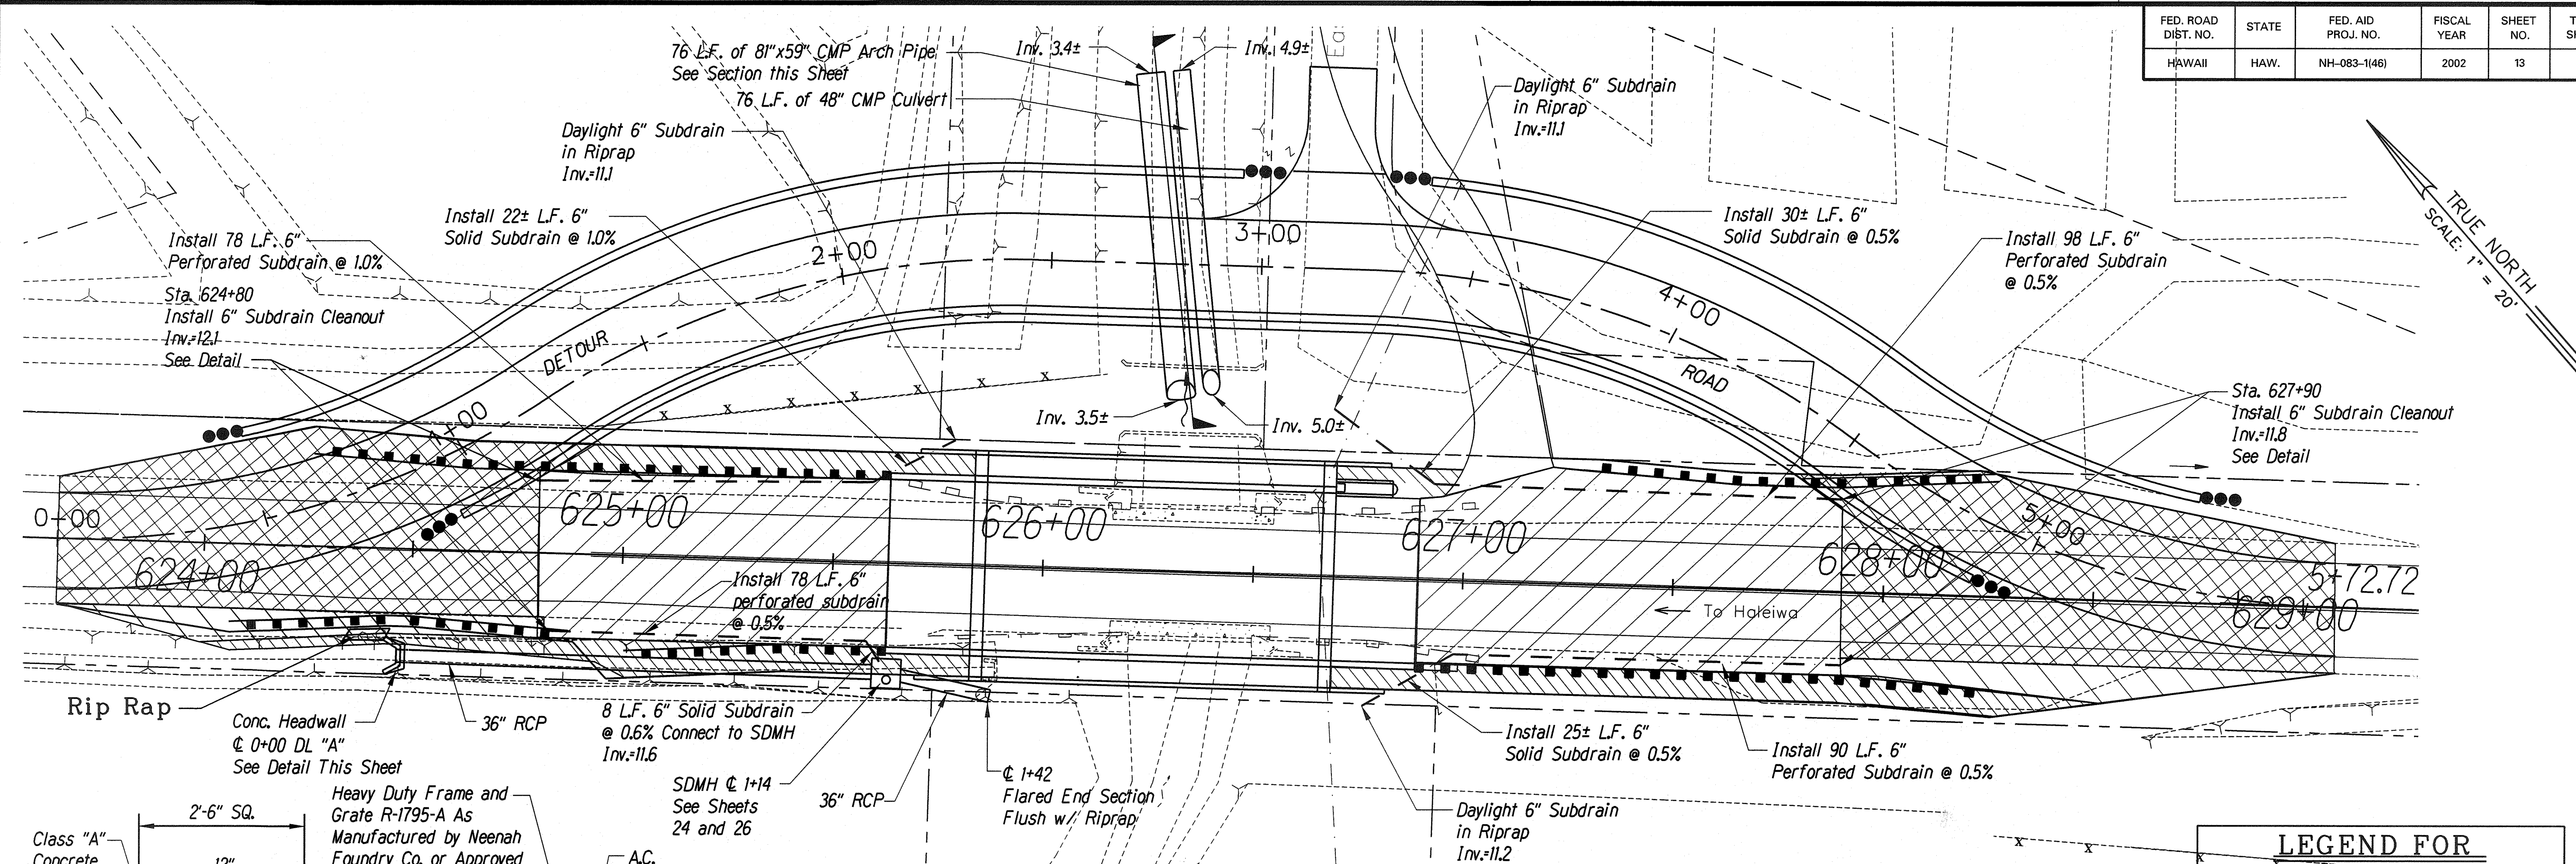


SUBDRAIN CLEANOUT DETAIL
Not to Scale

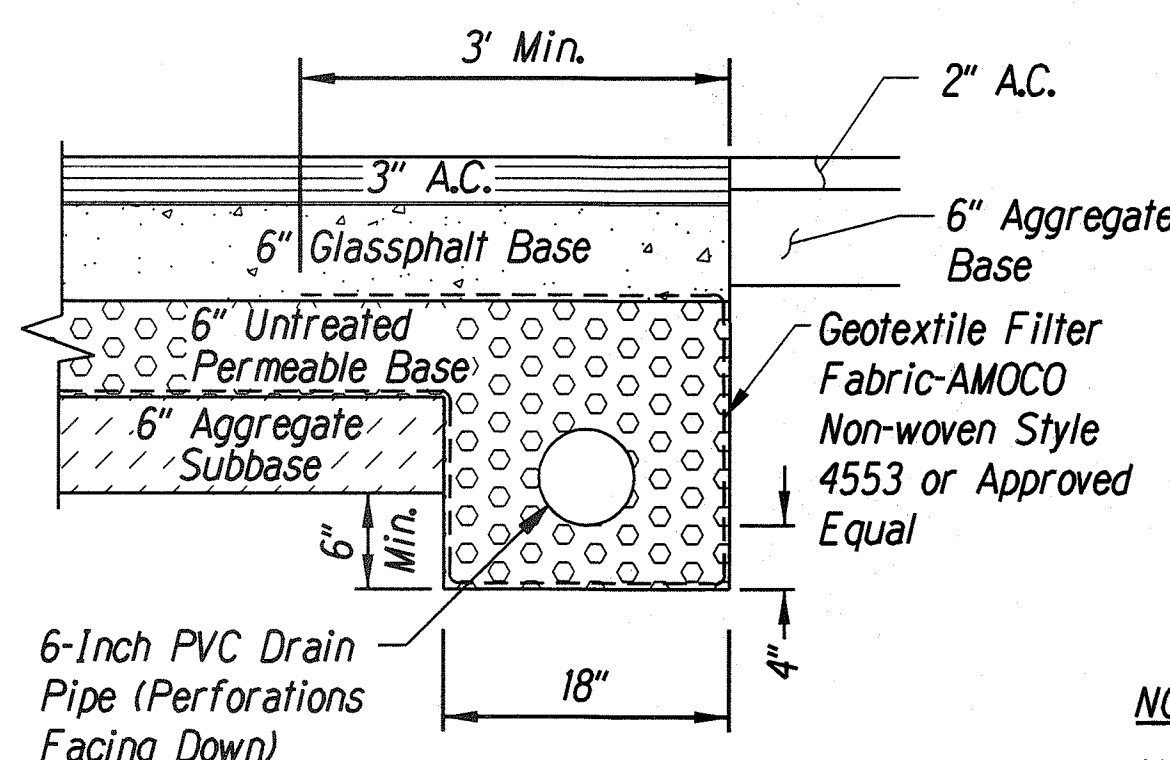

SUBDRAIN DETAIL
Not to Scale

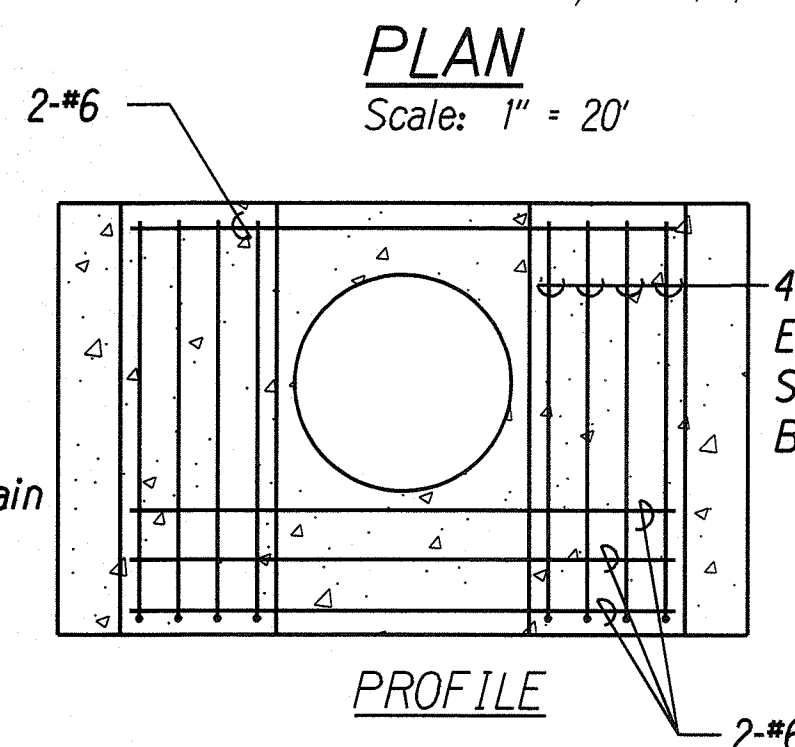


HEADWALL DETAIL
Not to Scale

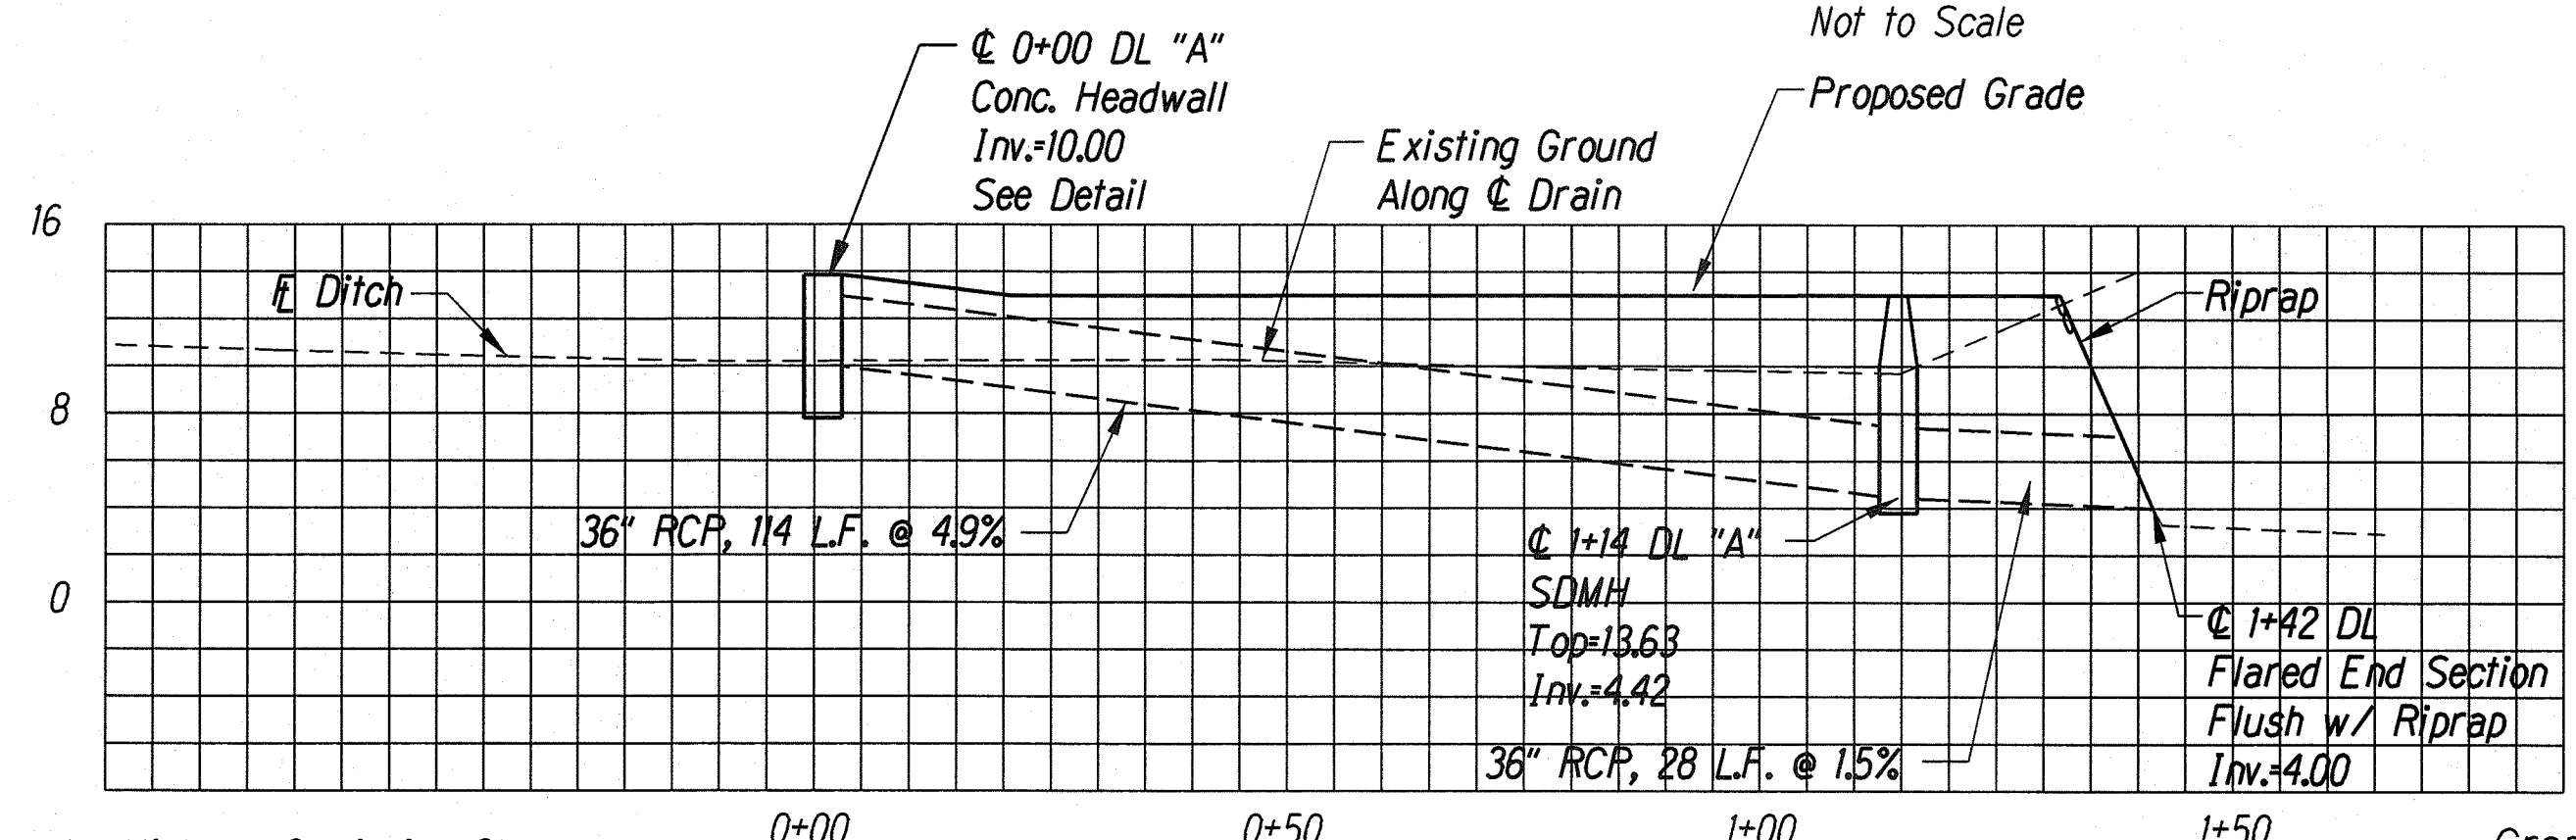


PROFILE-DRAINLINE "A"
Scale: Horiz. 1\"/>

LEGEND FOR AS-BUILT POSTINGS	
	Squiggly line for as-built deletion
	Double line for as-built deletion
	Text for as-built posting

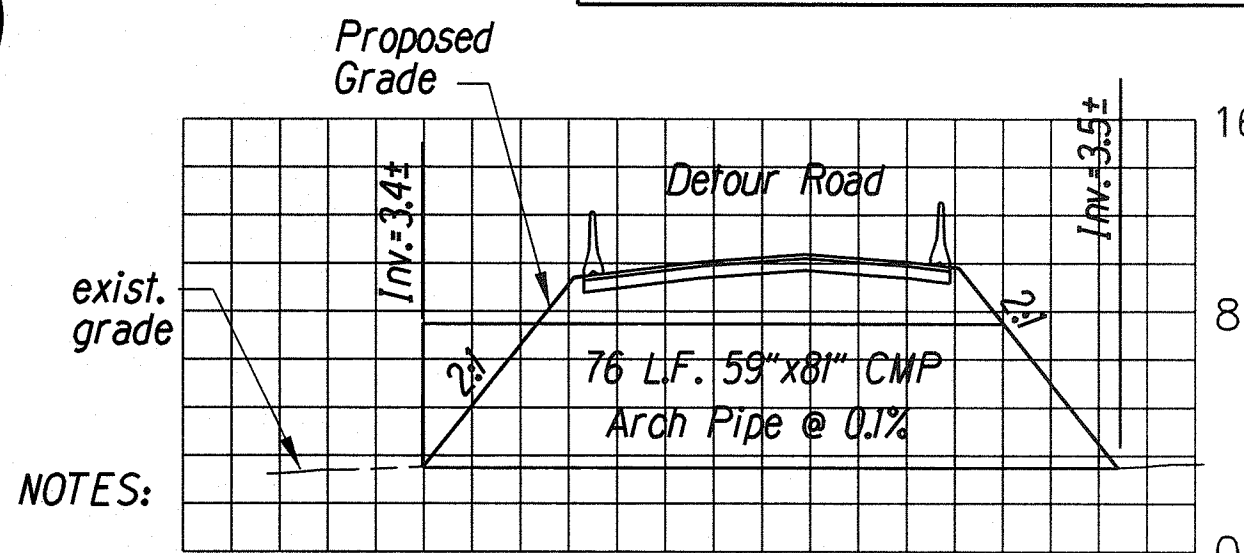

DETOUR ROAD CULVERT SECTION
Scale: Horiz. 1\"/>

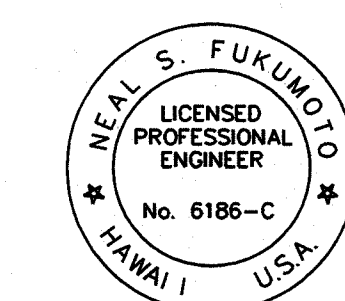

This work was prepared by me or under my supervision.
Exp. 04-30-10
Wesley R. Segawa & Associates, Inc.

9/26/06	As Built - Added Rip Rap
DATE	REVISION
STATE OF HAWAII DEPARTMENT OF TRANSPORTATION HIGHWAYS DIVISION	
KII BRIDGE	
DRAINAGE & SUBDRAIN PLAN	
KAMEHAMEHA HIGHWAY DRAINAGE IMPROVEMENTS Vicinity of Kahuku Hospital and Replacement of Kii Bridge Federal Aid Project No. NH-083-1(46)	
Scale: As Noted	Date: April 2004
SHEET No. 1 OF 1 SHEETS	

AS-BUILT