
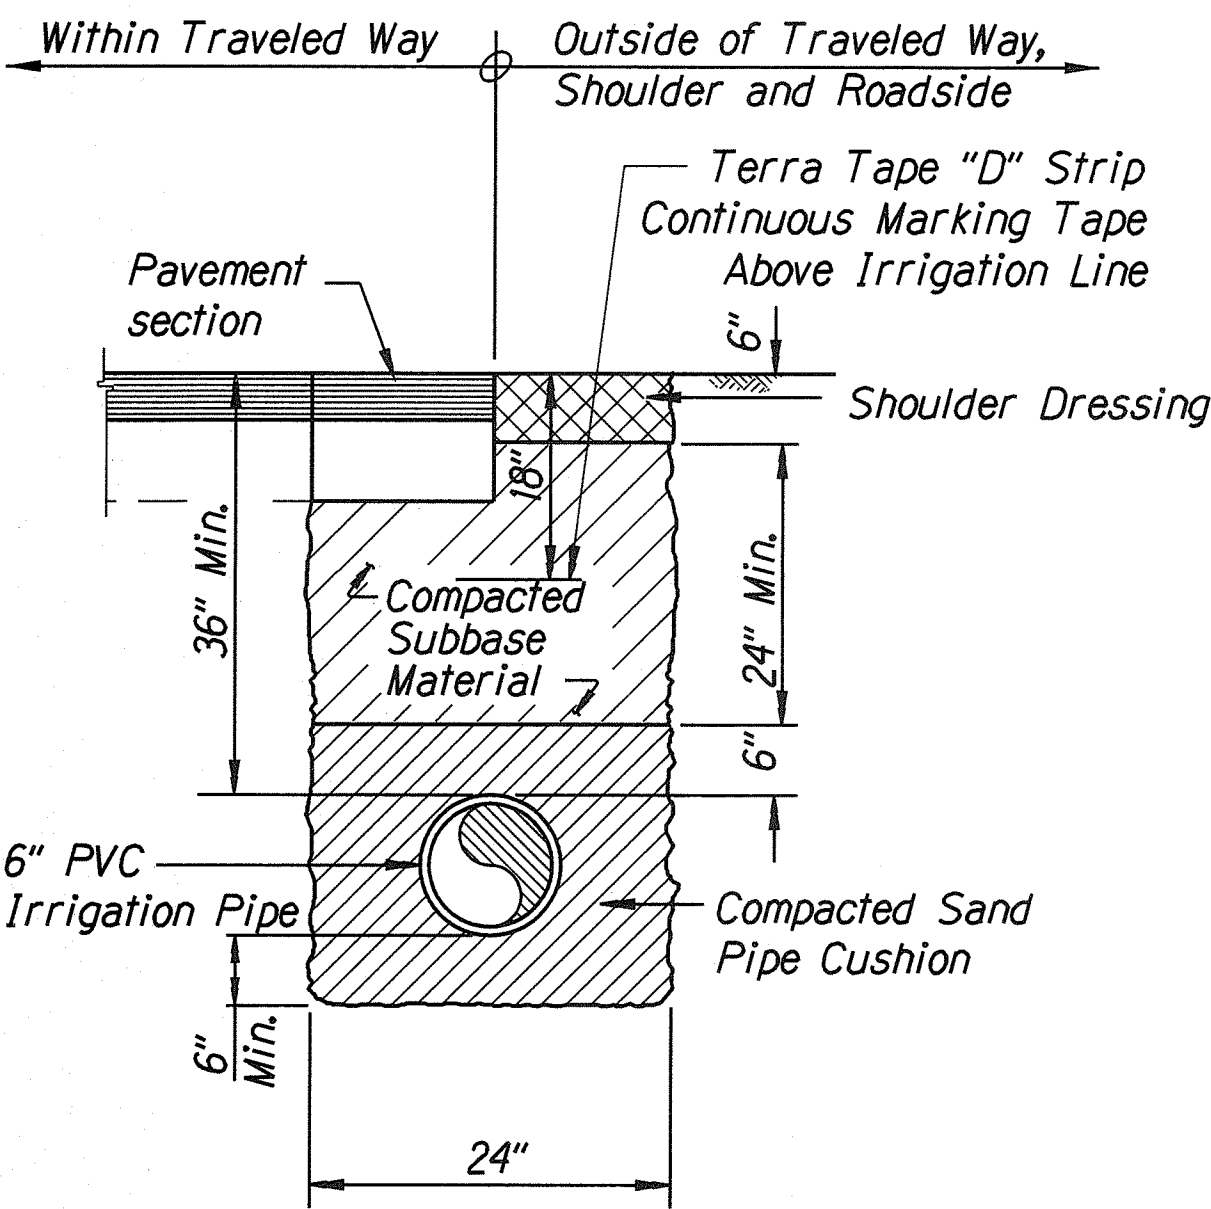



FED. ROAD DIST. NO.	STATE	FED. AID PROJ. NO.	FISCAL YEAR	SHEET NO.	TOTAL SHEETS
HAWAII	HAW.	NH-083-1(46)	2002	10	89

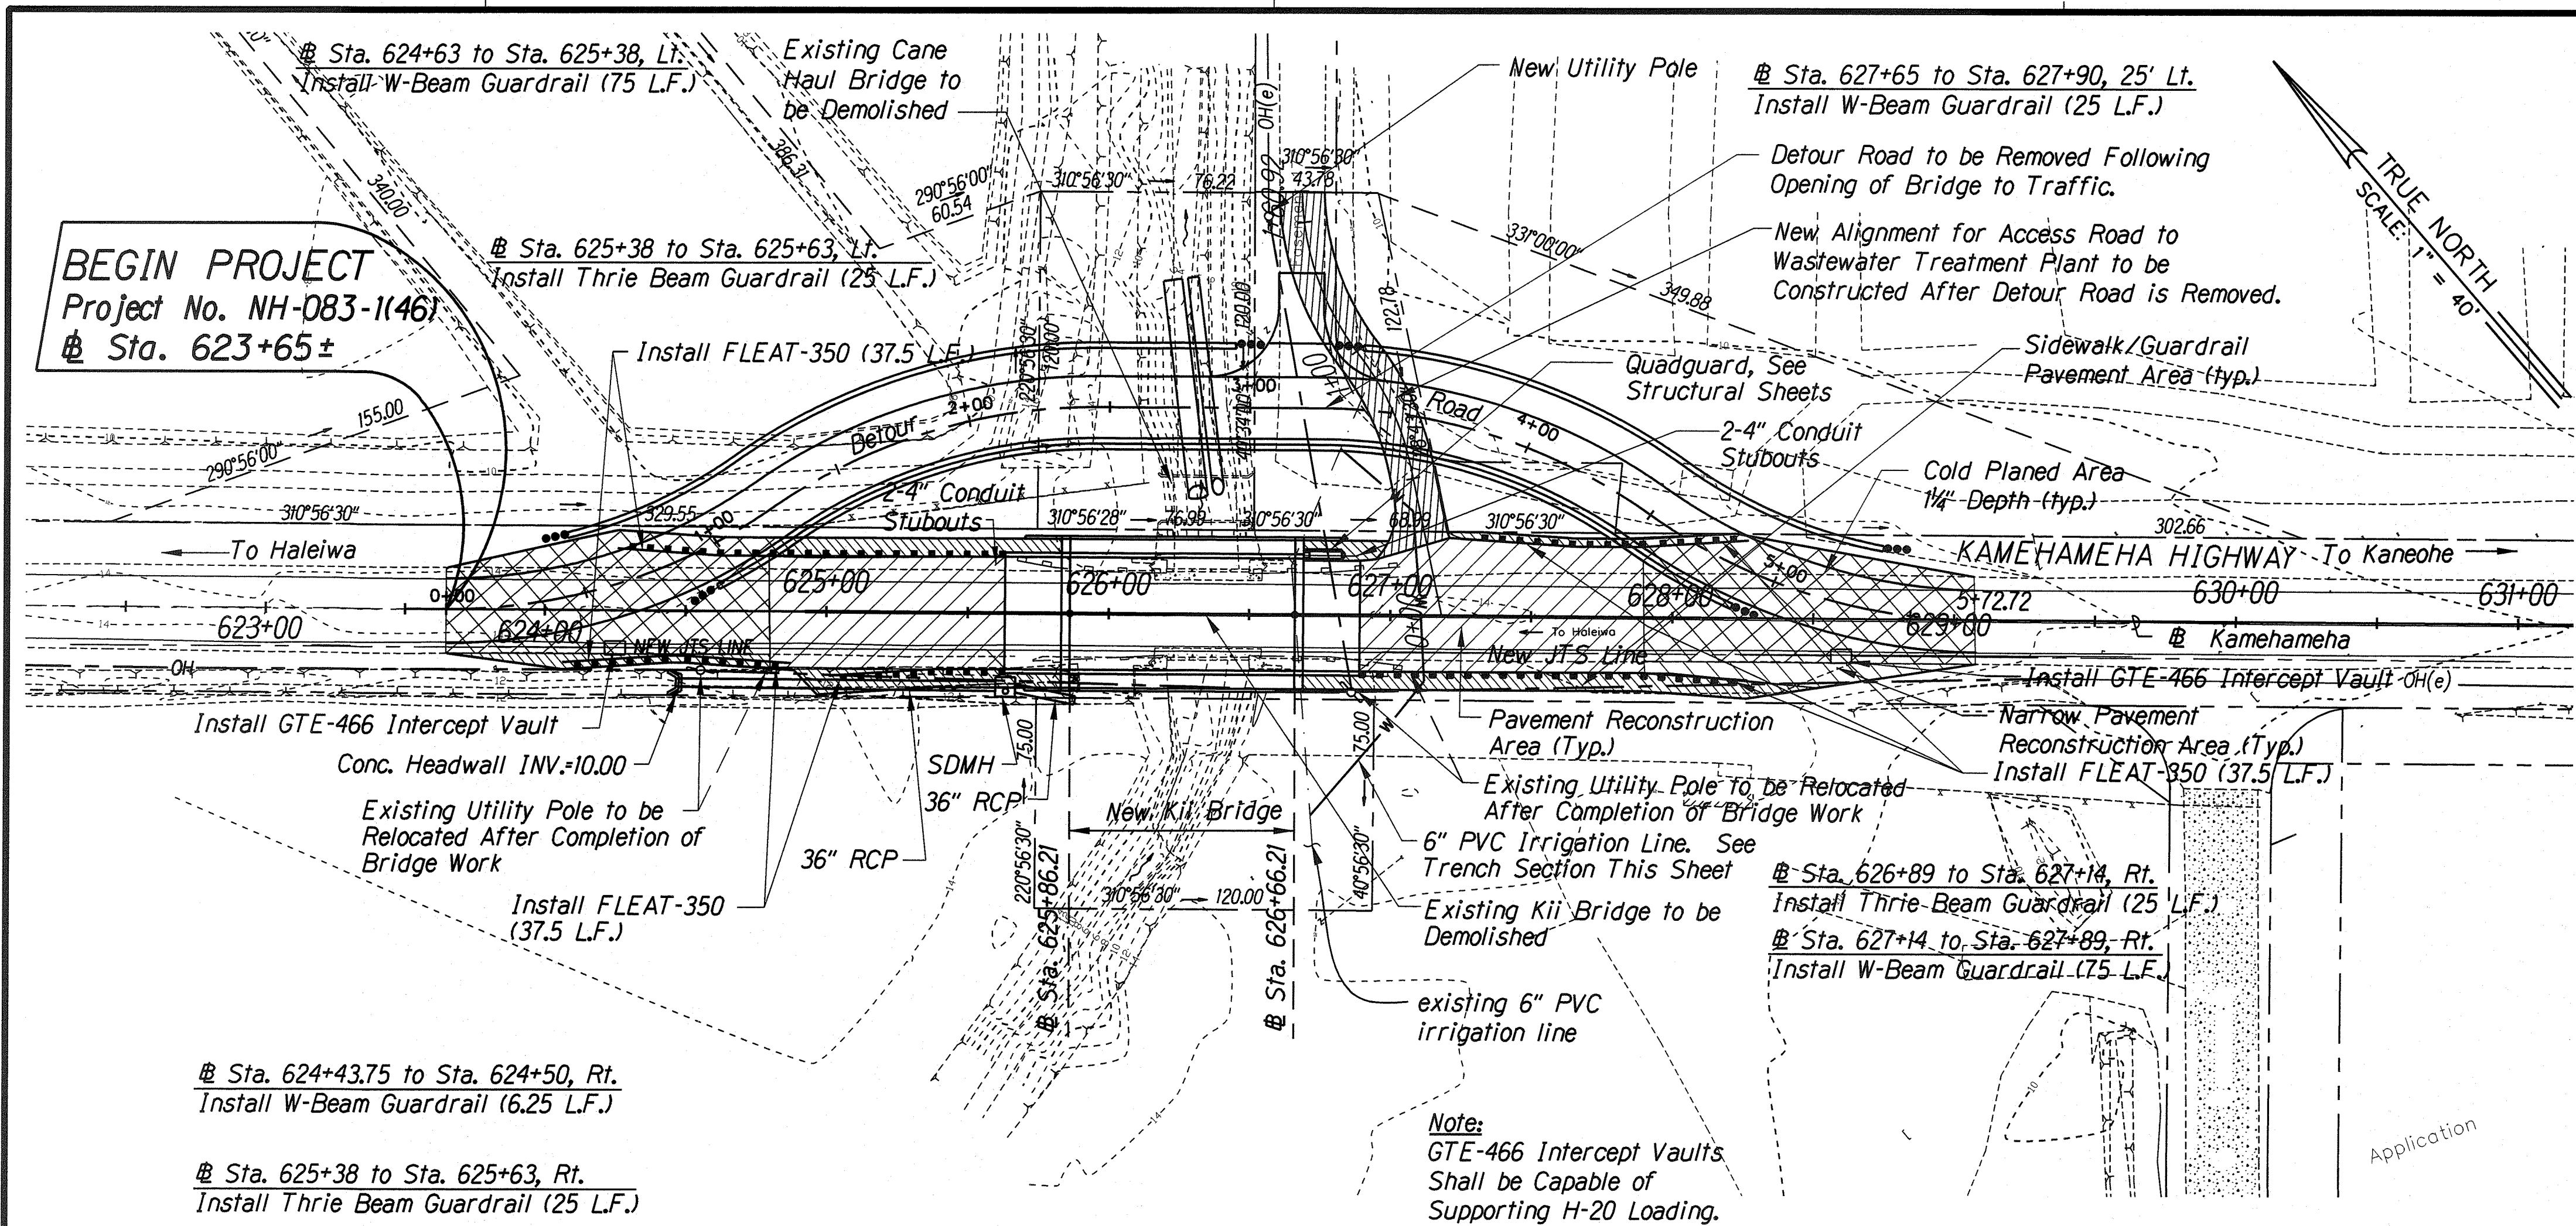


- NOTES:
1. PVC pipe shall be AWWA C905, CLASS 150 (DR18).
 2. All fittings shall be cast iron and double wrapped with polyethylene.
 3. No Bending of PVC pipes shall be permitted.
 4. Maintain min. 12" vertical clearance between subdrains, JTS line, etc.
 5. Thrust blocks shall be installed at all bends. Thrust blocks shall have a minimum of 1 square foot of bearing area against undisturbed soil.

TYP. IRRIGATION TRENCH SECTION
 Scale: Not to Scale


PLAN
 Scale: 1"=40'

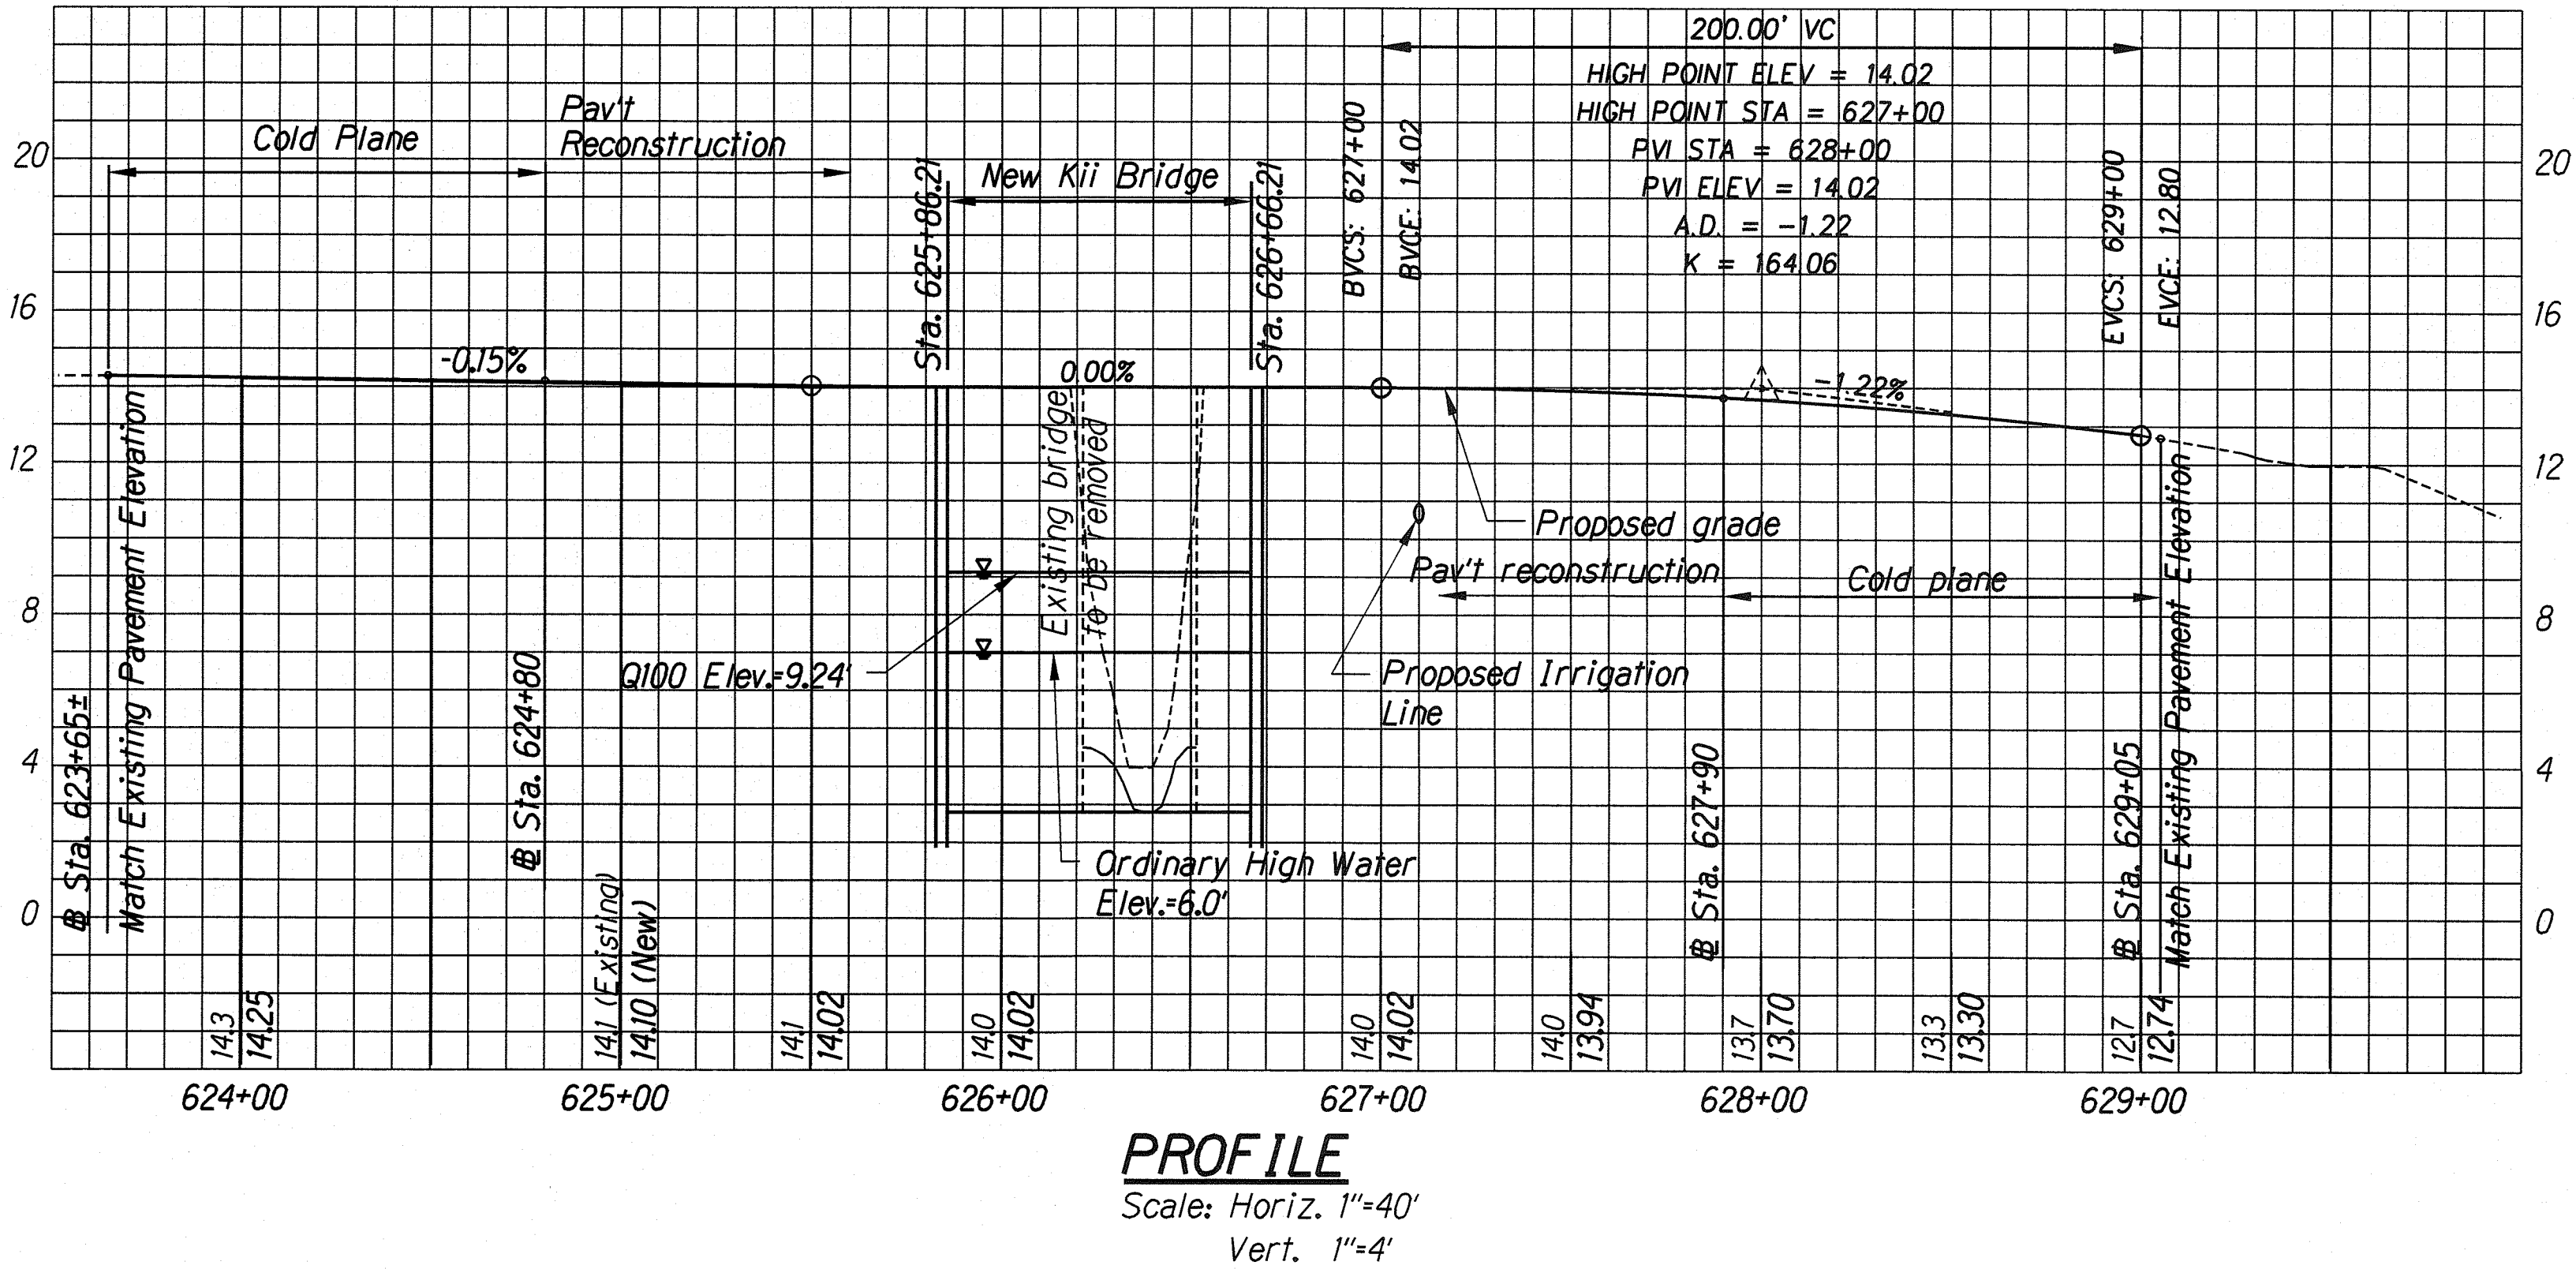

NOTE
 All Kamehameha Highway Stationing Shown on This Sheet is Off by 3.23'. To Obtain Current D.O.T. Highways Stationing, Subtract 3.23' from any Station Shown.

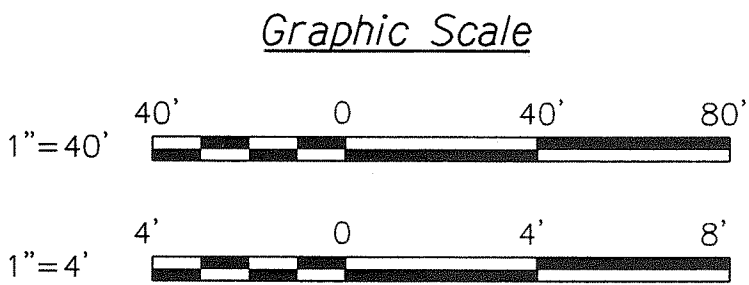

Director, Dept. of Environmental Services Date

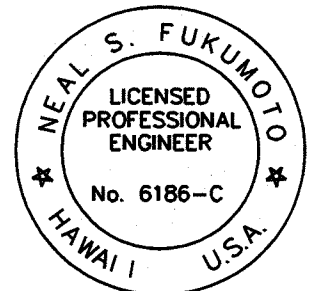

This work was prepared by me or under my supervision.
 Exp. 04-30-10
 Wesley R. Segawa & Associates, Inc.

STATE OF HAWAII
 DEPARTMENT OF TRANSPORTATION
 HIGHWAYS DIVISION

KII BRIDGE PLAN & PROFILE

KAMEHAMEHA HIGHWAY DRAINAGE IMPROVEMENTS
 Vicinity of Kahuku Hospital and Replacement of Kii Bridge
 Federal Aid Project No. NH-083-1(46)

Scale: As Noted Date: April 2004

SHEET No. 1 OF 2 SHEETS

ORIGINAL PLAN	SURVEY PLOTTED BY	DATE
NOTE BOOK	DRAWN BY	
	CHECKED BY	