

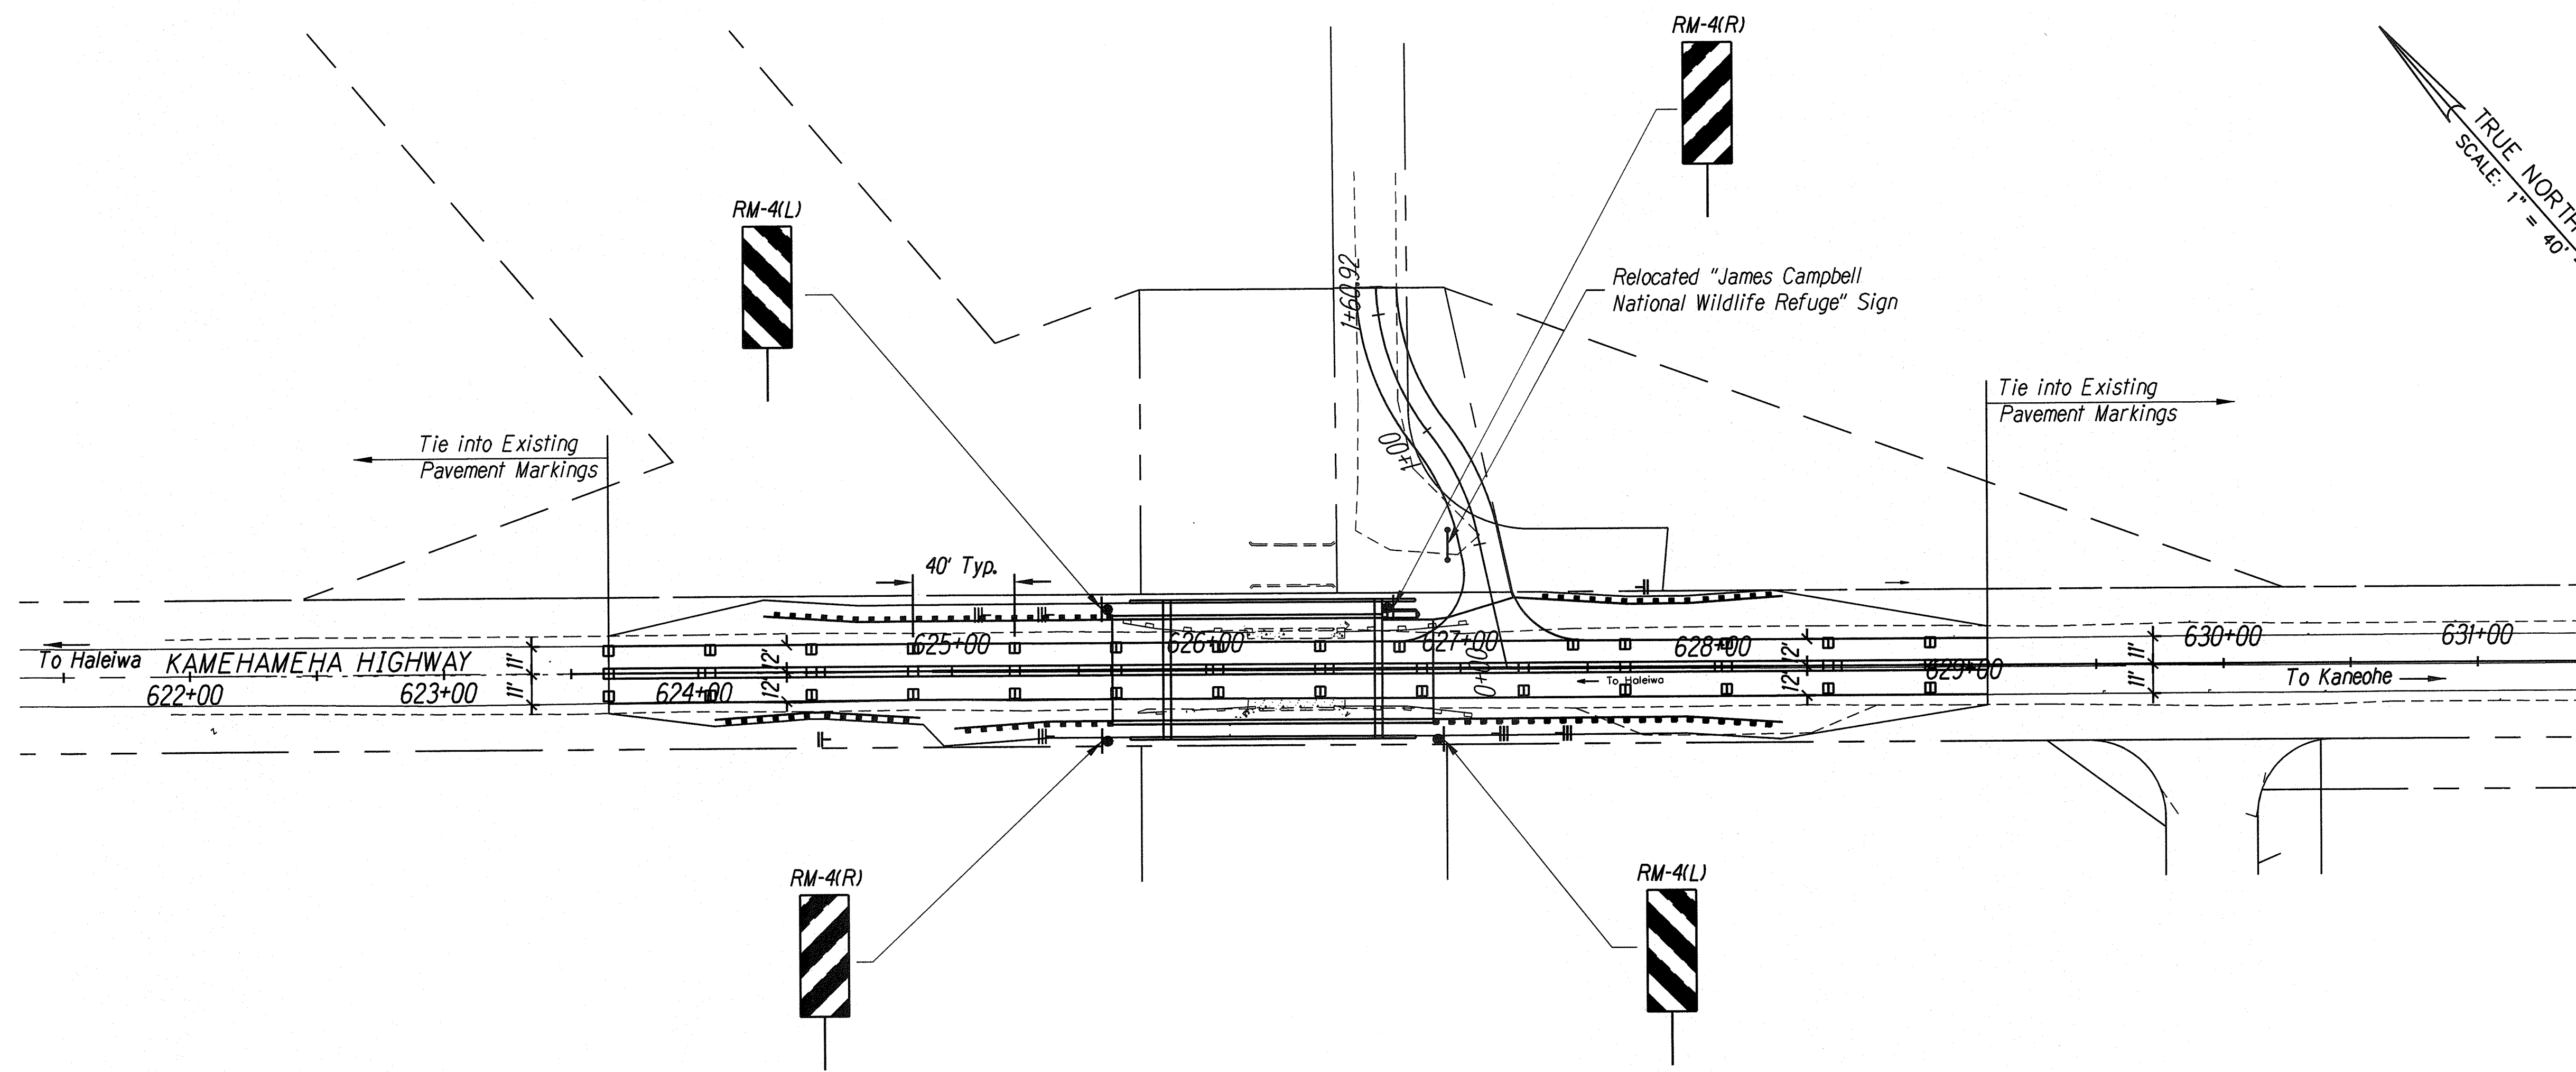


FED. ROAD DIST. NO.	STATE	FED. AID PROJ. NO.	FISCAL YEAR	SHEET NO.	TOTAL SHEETS
HAWAII	HAW.	NH-083-1(46)	2002	81	89

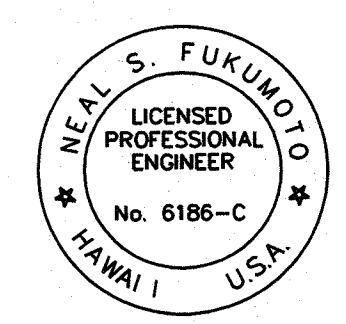

KII BRIDGE SIGNING AND STRIPING PLAN
Scale: 1"=40'

SURVEY PLOTTED BY	DATE
DRAWN BY	
NOTED BY	
CHECKED BY	
DATE	

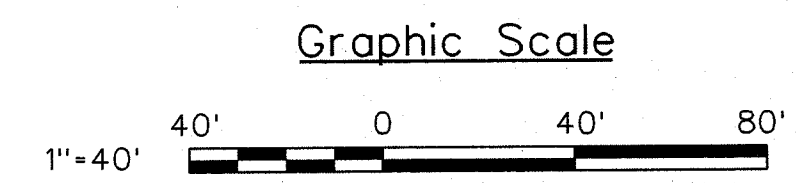

This work was prepared by me or under my supervision.
Exp. 04-30-10
Neal S. Fukunaga
Wesley R. Segawa & Associates, Inc.

STATE OF HAWAII
DEPARTMENT OF TRANSPORTATION
HIGHWAYS DIVISION

KII BRIDGE
SIGNING & STRIPING PLAN

KAMEHAMEHA HIGHWAY DRAINAGE IMPROVEMENTS
Vicinity of Kahuku Hospital and Replacement of Kii Bridge
Federal Aid Project No. NH-083-1(46)
Scale: 1" = 40' Date: April 2004

SHEET No. 1 OF 2 SHEETS

May 11, 1999 7:12:30 a.m.
Drawing: BORDER.DWG(L.P.C.)

AS-BUILT