

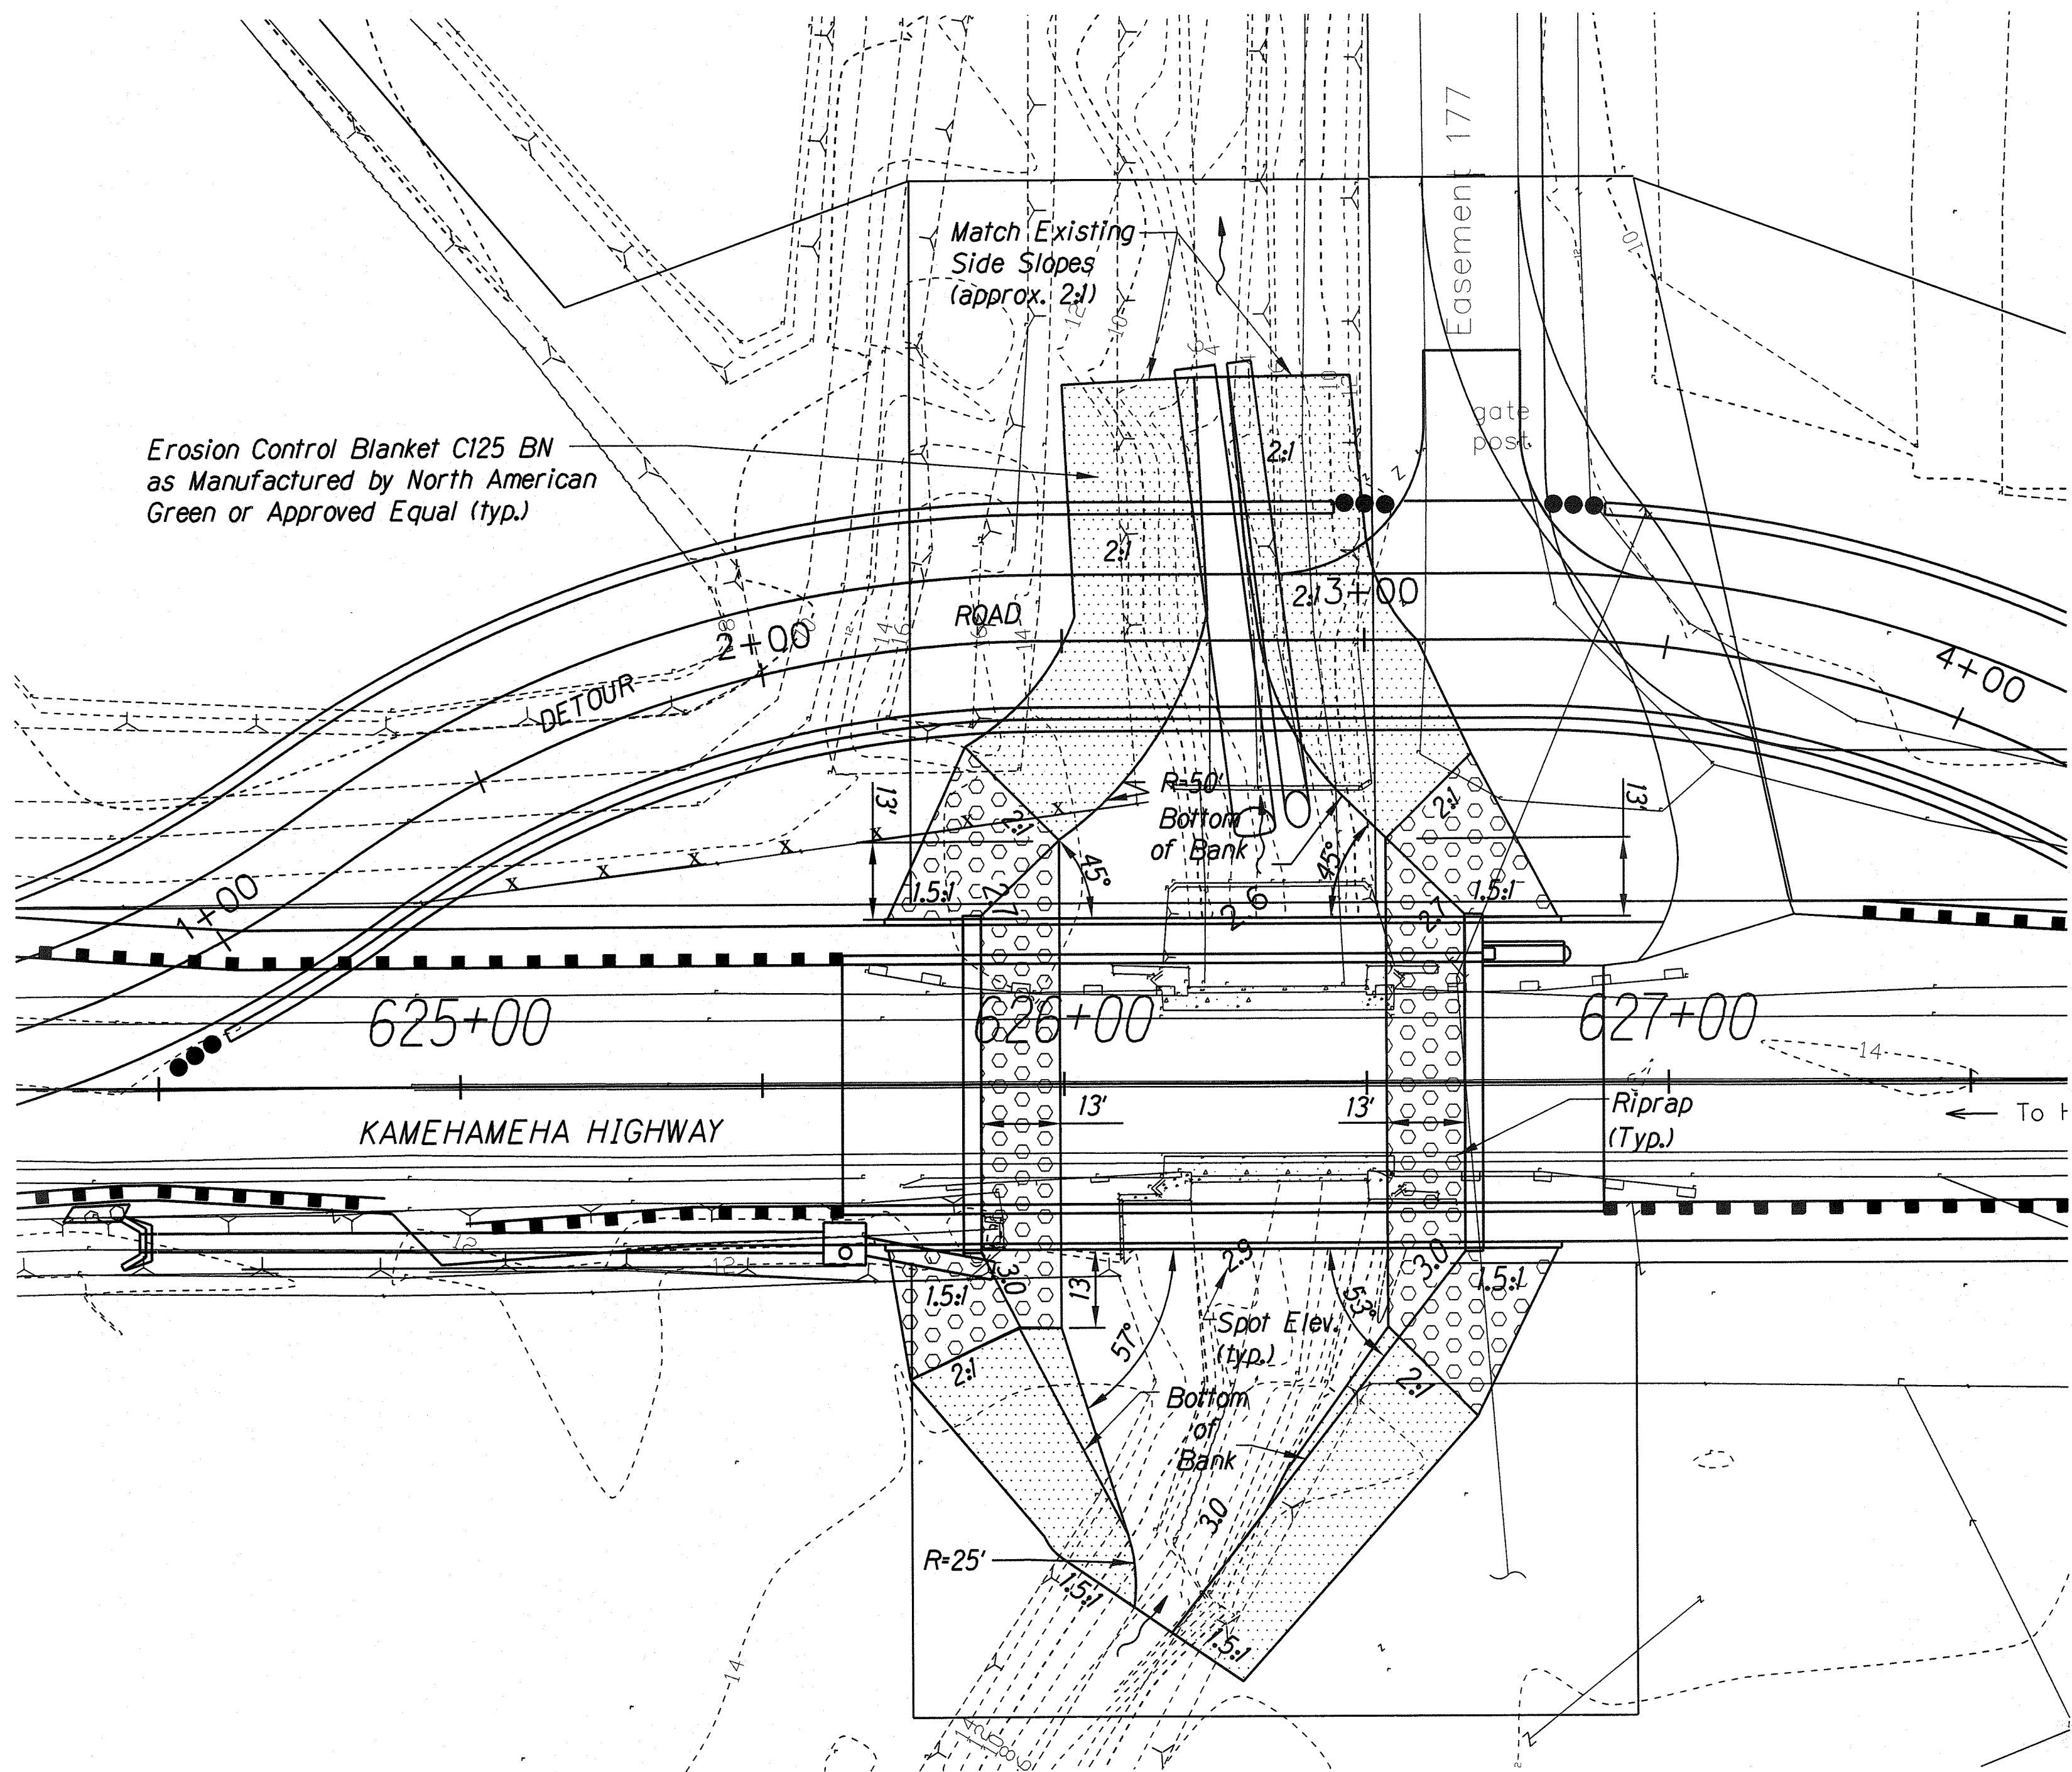


FED. ROAD DIST. NO.	STATE	FED. AID PROJ. NO.	FISCAL YEAR	SHEET NO.	TOTAL SHEETS
HAWAII	HAW.	NH-083-1(46)	2002	12	89

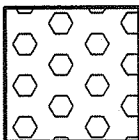


STREAM IMPROVEMENTS PLAN
 Scale: 1"=20'

-  Riprap
-  Erosion Control Blanket

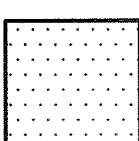

ORIGINAL PLAN	SURVEY PLOTTED BY	DATE
TRACED BY	DRAWN BY	
NOTE BOOK	CHECKED BY	
QUANTITIES BY		
CHECKED BY		

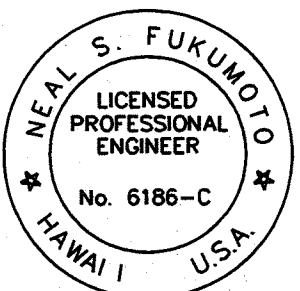

This work was prepared by me or under my supervision.
 Exp. 04-30-10
Neal S. Fukumoto
 Wesley R. Segawa & Associates, Inc.

STATE OF HAWAII
 DEPARTMENT OF TRANSPORTATION
 HIGHWAYS DIVISION

KII STREAM IMPROVEMENTS PLAN

 KAMEHAMEHA HIGHWAY DRAINAGE IMPROVEMENTS
 Vicinity of Kahuku Hospital and Replacement of Kii Bridge
 Federal Aid Project No. NH-083-1(46)
 Scale: 1" = 20' Date: April 2004

SHEET NO. 1 OF 1 SHEETS

AS-BUILT