




TRAFFIC SIGN SUMMARY					
SIGN NO.	MESSAGE	QUANTITY			
		10 SQ. FT. OR LESS		GREATER THAN 10 SQ. FT.	
		W/POST	W/O POST	W/POSTS	W/O POST
	TOTAL				

CONSTRUCTION SIGN SUMMARY			
SIGN NO.	MESSAGE	W/POSTS	W/O POST
G20-2A	END ROAD WORK	2	
R2-1	SPEED LIMIT 35	4	
R2-5b	REDUCED SPEED 20	4	
R11-2	ROAD CLOSED		4
W1-4L		2	
W1-4R		6	
W1-6			4
W20-1	ROAD WORK XXXX FT.	4	
	\$250 FINE HRS 291C-104	4	
	BEGIN	4	
	CONSTRUCTION AREA	8	
	END	4	
	TOTAL	42	8

PAVEMENT MARKING SUMMARY		
DESCRIPTION		QUANTITY
PAVEMENT MARKERS		
TYPE A		EA.
TYPE C	103	EA.
TYPE D	100	EA.
TYPE H	30	EA.
TYPE J	32	EA.
* TAPE - TYPE I OR THERMOPLASTIC EXTRUSION		
4-INCH PAVEMENT STRIPE (WHITE)		L.F.
4-INCH PAVEMENT STRIPE (YELLOW)		L.F.
8-INCH PAVEMENT STRIPE (WHITE)		L.F.
12-INCH PAVEMENT STRIPE (WHITE)		L.F.
12-INCH PAVEMENT STRIPE (YELLOW)		L.F.
DOUBLE 4-INCH PAVEMENT STRIPE (YELLOW)		L.F.
PARKING STALLS		L.F.
** TAPE - TYPE II OR THERMOPLASTIC EXTRUSION		
4-INCH PAVEMENT STRIPE (WHITE)	4,482	L.F.
4-INCH PAVEMENT STRIPE (YELLOW)		L.F.
8-INCH PAVEMENT STRIPE (WHITE)	126	L.F.
12-INCH PAVEMENT STRIPE (WHITE)	30	L.F.
12-INCH PAVEMENT STRIPE (YELLOW)	50	L.F.
DOUBLE 4-INCH PAVEMENT STRIPE (YELLOW)	2,328	L.F.
*** TAPE - TYPE III OR THERMOPLASTIC EXTRUSION		
4-INCH PAVEMENT STRIPE (WHITE)		L.F.
4-INCH PAVEMENT STRIPE (YELLOW)		L.F.
8-INCH PAVEMENT STRIPE (WHITE)		L.F.
12-INCH PAVEMENT STRIPE (WHITE)		L.F.
CROSSWALK MARKINGS		LANE
PAVEMENT ARROW		EA.
PAVEMENT WORD		EA.


SURVEY PLOTTED BY	DATE
DRAWN BY	
DESIGNED BY	
QUANTITIES BY	
CHECKED BY	
ORIGINAL PLAN	
NOTE BOOK	
N.	

REFLECTOR MARKER SUMMARY								
TYPE	QUANTITY							
	W/O POST		W/ STEEL POST		W/ FLEXIBLE POST		MOUNTED ON GUARDRAIL	
	YELLOW	WHITE	YELLOW	WHITE	YELLOW	WHITE	YELLOW	WHITE
RM-2						2		
RM-3					15			
RM-4			8					
RM-5								14
TYPE II Object Marker								

* All Objects (Utility Poles or Trees) That Are Within the State Highway Right of Way and Within 30 Feet of the Roadway Edge of Pavement Shall Be Marked As Directed by the Engineer.

NOTES:

- * Tape, Type I or Thermoplastic Extrusion (No Passing Zones, Channelizing Lines, Solid Lines or Pavement Arrows)
- ** Tape, Type II or Thermoplastic Extrusion (Transverse Median Markings, Transverse Shoulder Markings, Channelizing Islands, or Edge Striping)
- *** Tape, Type III, or Thermoplastic Extrusion (Guide Lines, Stop Lines, Extension of Edge Lines, or Crosswalk Markings)

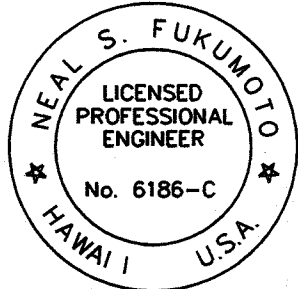

This work was prepared by me or under my supervision. Exp. 04-30-10

Neal S. Fukunaga
Wesley R. Segawa & Associates, Inc.

STATE OF HAWAII
DEPARTMENT OF TRANSPORTATION
HIGHWAYS DIVISION

TRAFFIC AND PAVEMENT
MARKING SUMMARIES

KAMEHAMEHA HIGHWAY DRAINAGE IMPROVEMENTS
Vicinity of Kahuku Hospital and Replacement of Kii Bridge
Federal Aid Project No. NH-083-1(46)

Date: April 2004