




FED. ROAD DIST. NO.	STATE	FED. AID PROJ. NO.	FISCAL YEAR	SHEET NO.	TOTAL SHEETS
HAWAII	HAW.	NH-083-1(46)	2002	9	89

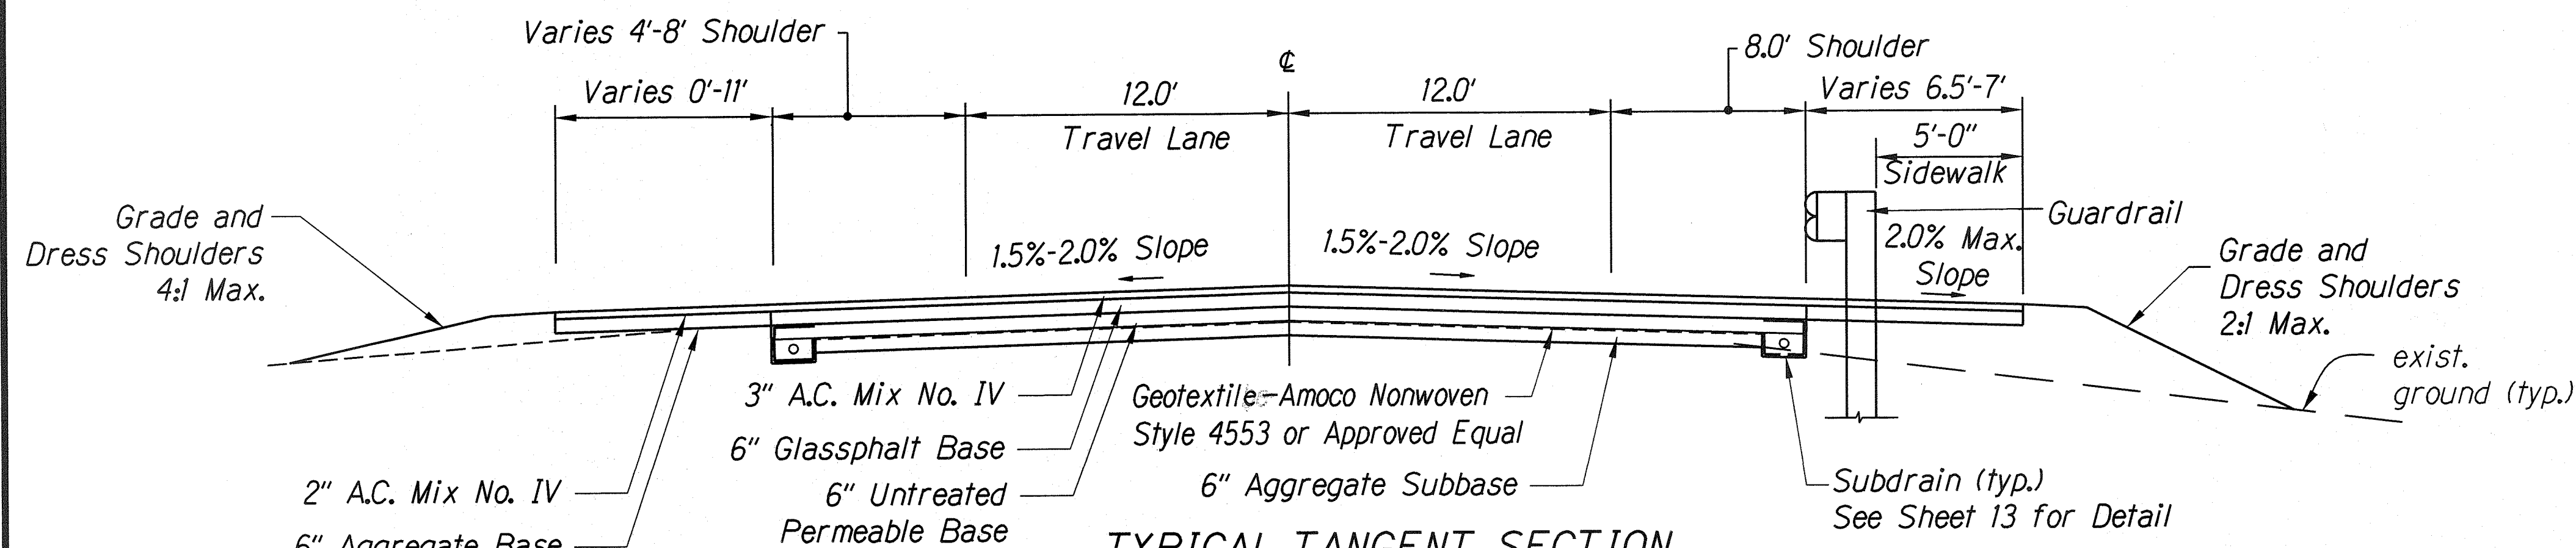


TYPICAL TANGENT SECTION
KAMEHAMEHA HIGHWAY
Not to Scale

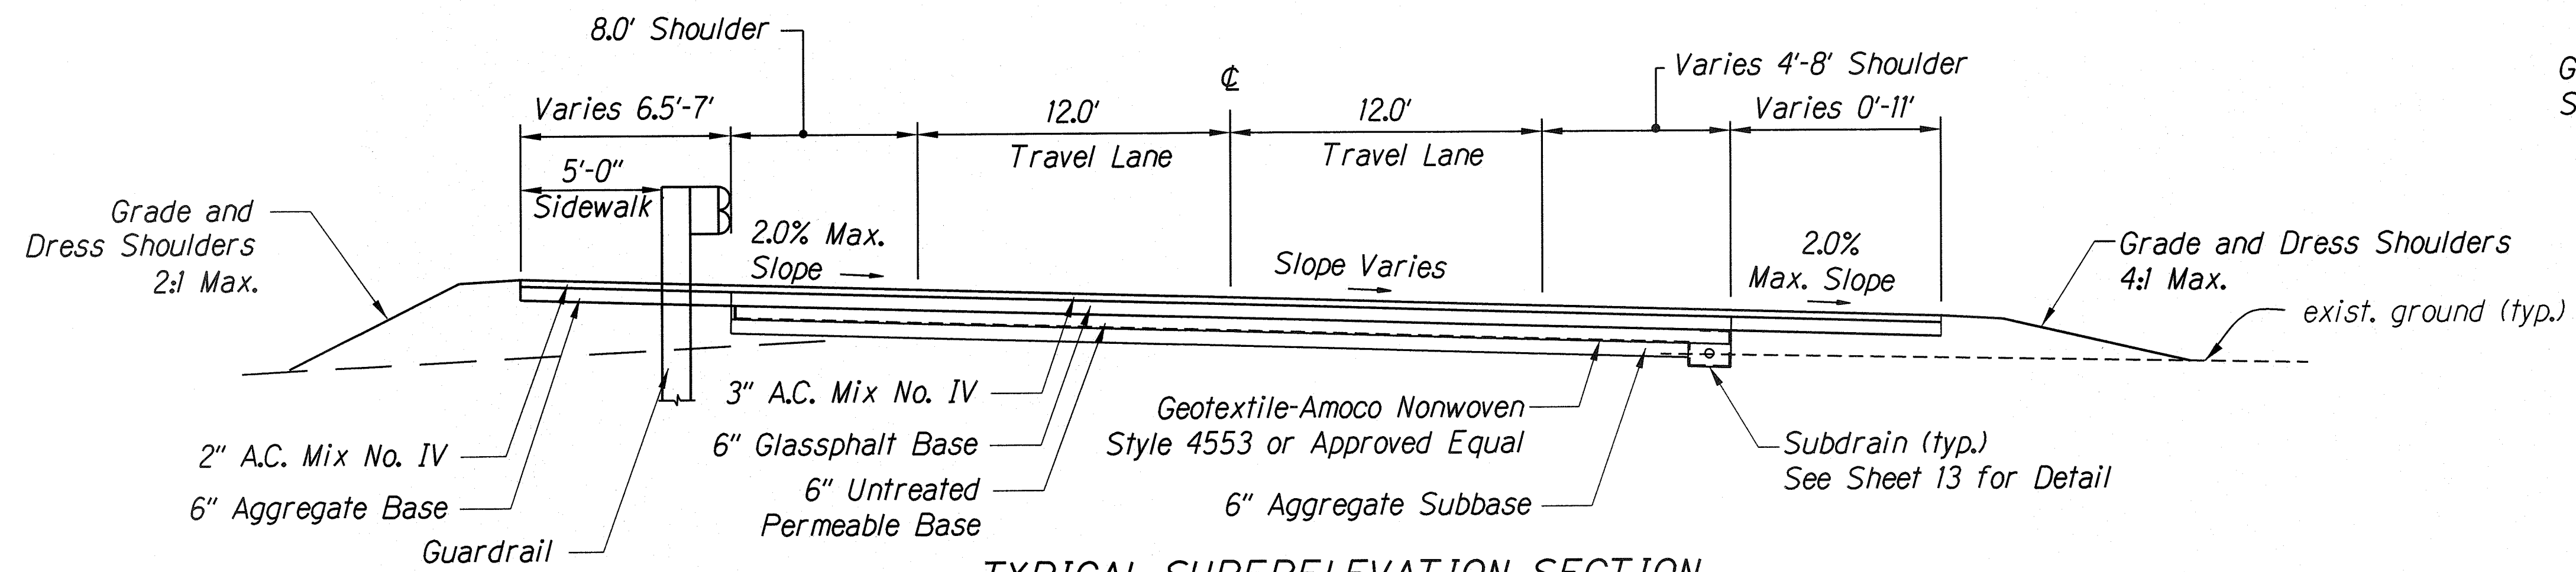

TYPICAL SUPERELEVATION SECTION
KAMEHAMEHA HIGHWAY
Not to Scale

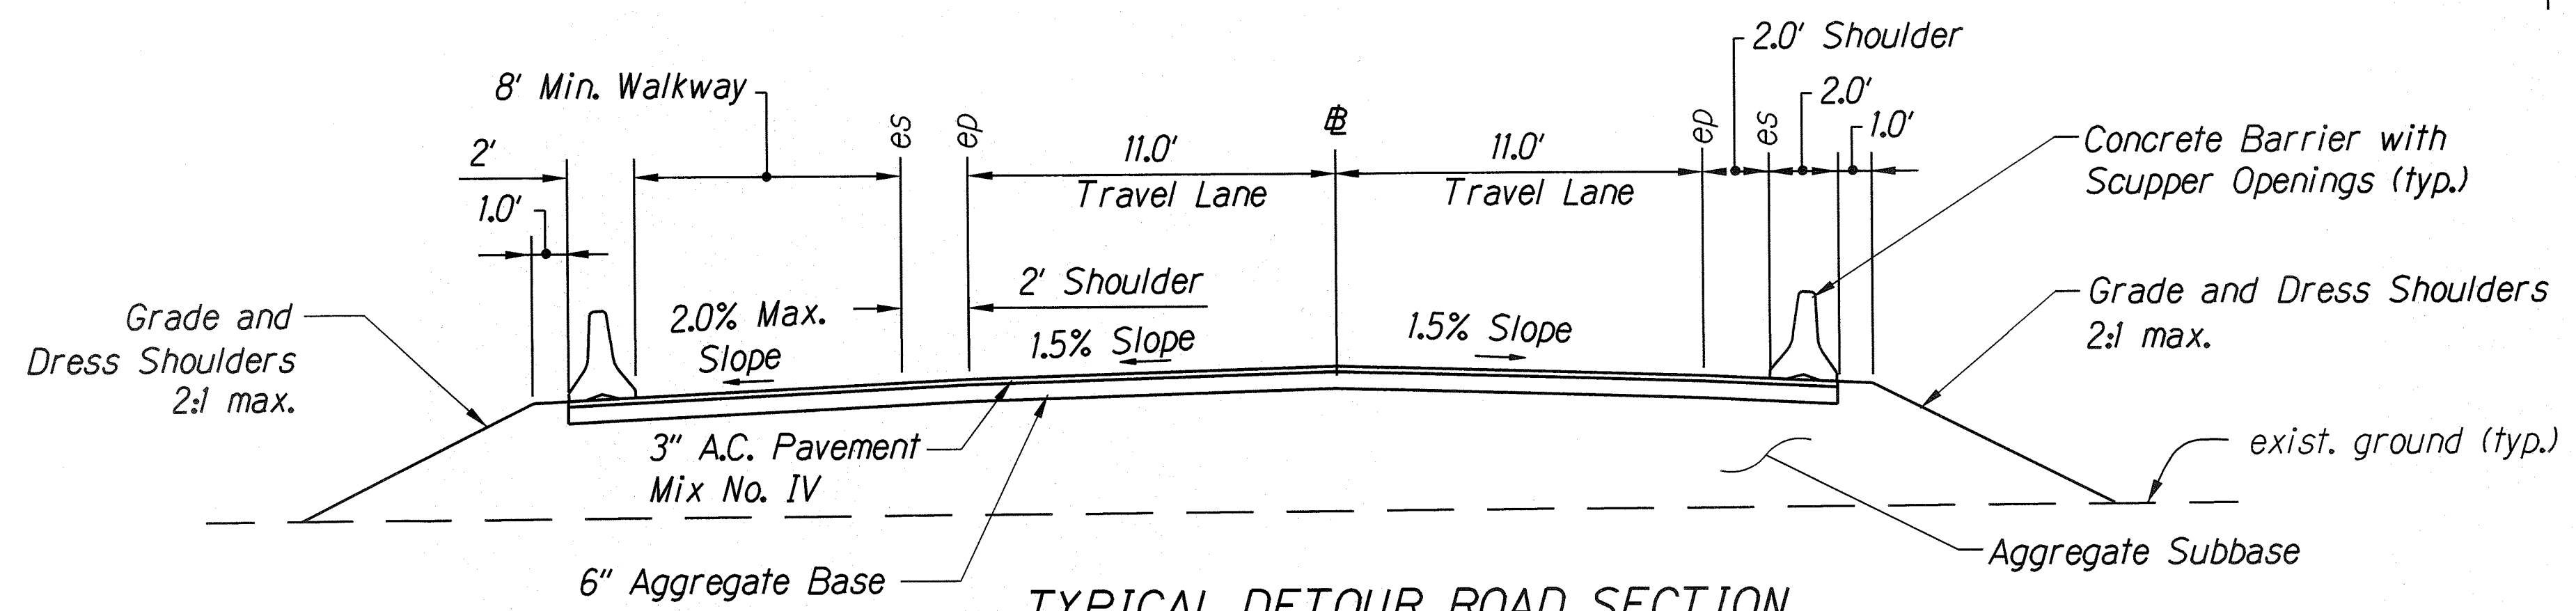


TYPICAL DETOUR ROAD SECTION
Not to Scale

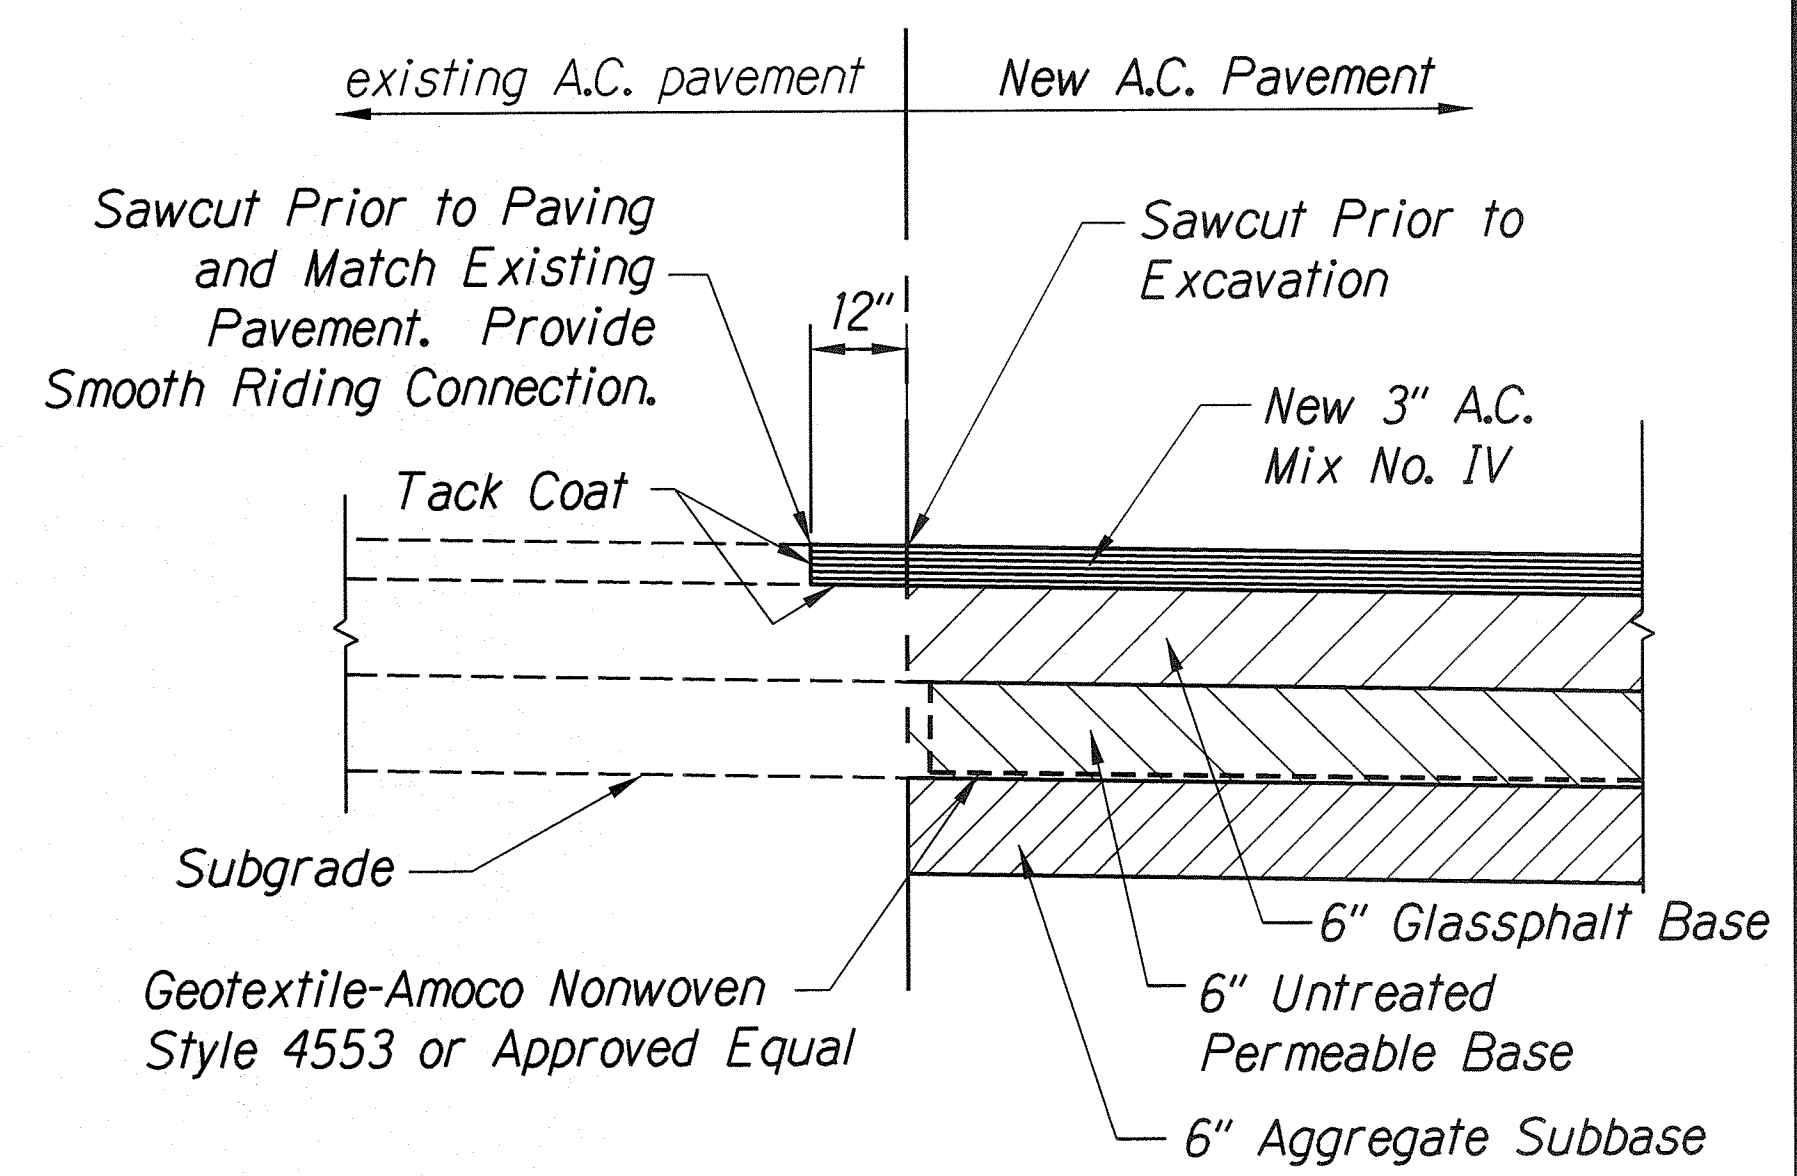


PAVEMENT CONNECTION DETAIL
Not to Scale

- LEGEND**
- A.C. Pavement Reconstruction Area
 - Narrow A.C. Pavement Reconstruction Area
 - Sidewalk/Guardrail Pavement Area
 - Cold Planed Area
 - Existing Power Pole
 - New Power Pole
 - Existing Culvert
 - New Metal Guardrail
 - New Riprap
 - New G.R.P.
 - New Overhead Wires
 - Existing Overhead Wires

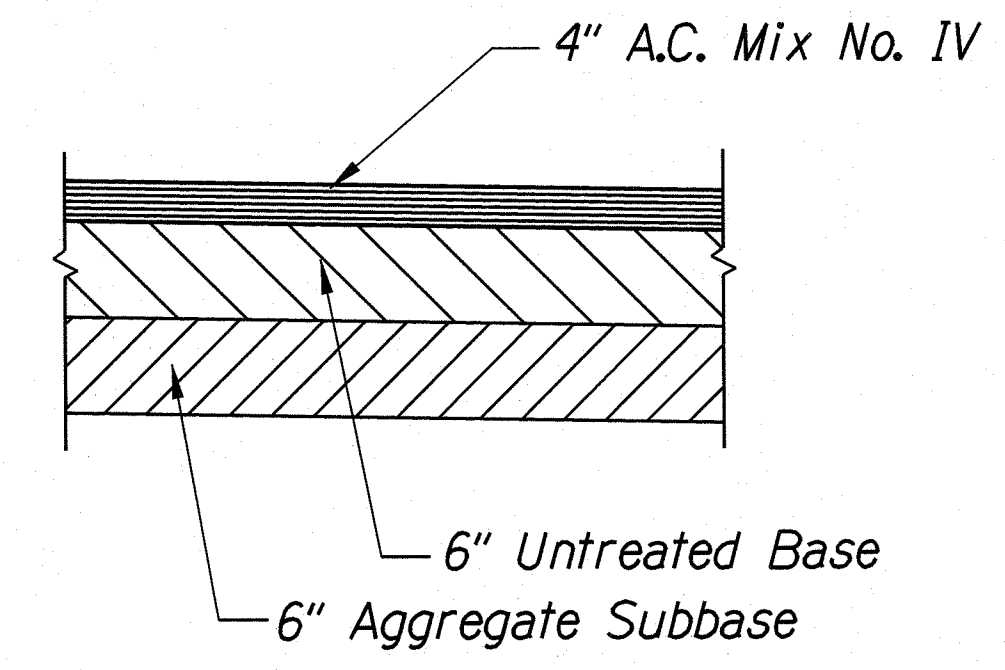

NARROW PAVEMENT RECONSTRUCTION AREA DETAIL
Not to Scale

SURVEY PLOTTED BY	DATE
DRAWN BY	
DESIGNED BY	
QUANTITIES BY	
CHECKED BY	
ORIGINAL PLAN	
NOTE BOOK	

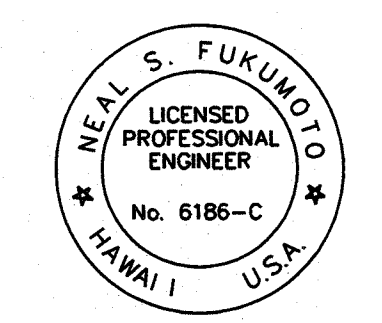

This work was prepared by me or under my supervision.
Exp. 04-30-10
Neal S. Fukunaga
Wesley R. Segawa & Associates, Inc.

STATE OF HAWAII
DEPARTMENT OF TRANSPORTATION
HIGHWAYS DIVISION

TYPICAL SECTIONS AND LEGEND

KAMEHAMEHA HIGHWAY DRAINAGE IMPROVEMENTS
Vicinity of Kahuku Hospital and Replacement of Kii Bridge
Federal Aid Project No. NH-083-1(46)
Scale: Not to Scale Date: April 2004
SHEET No. 1 OF 1 SHEETS