
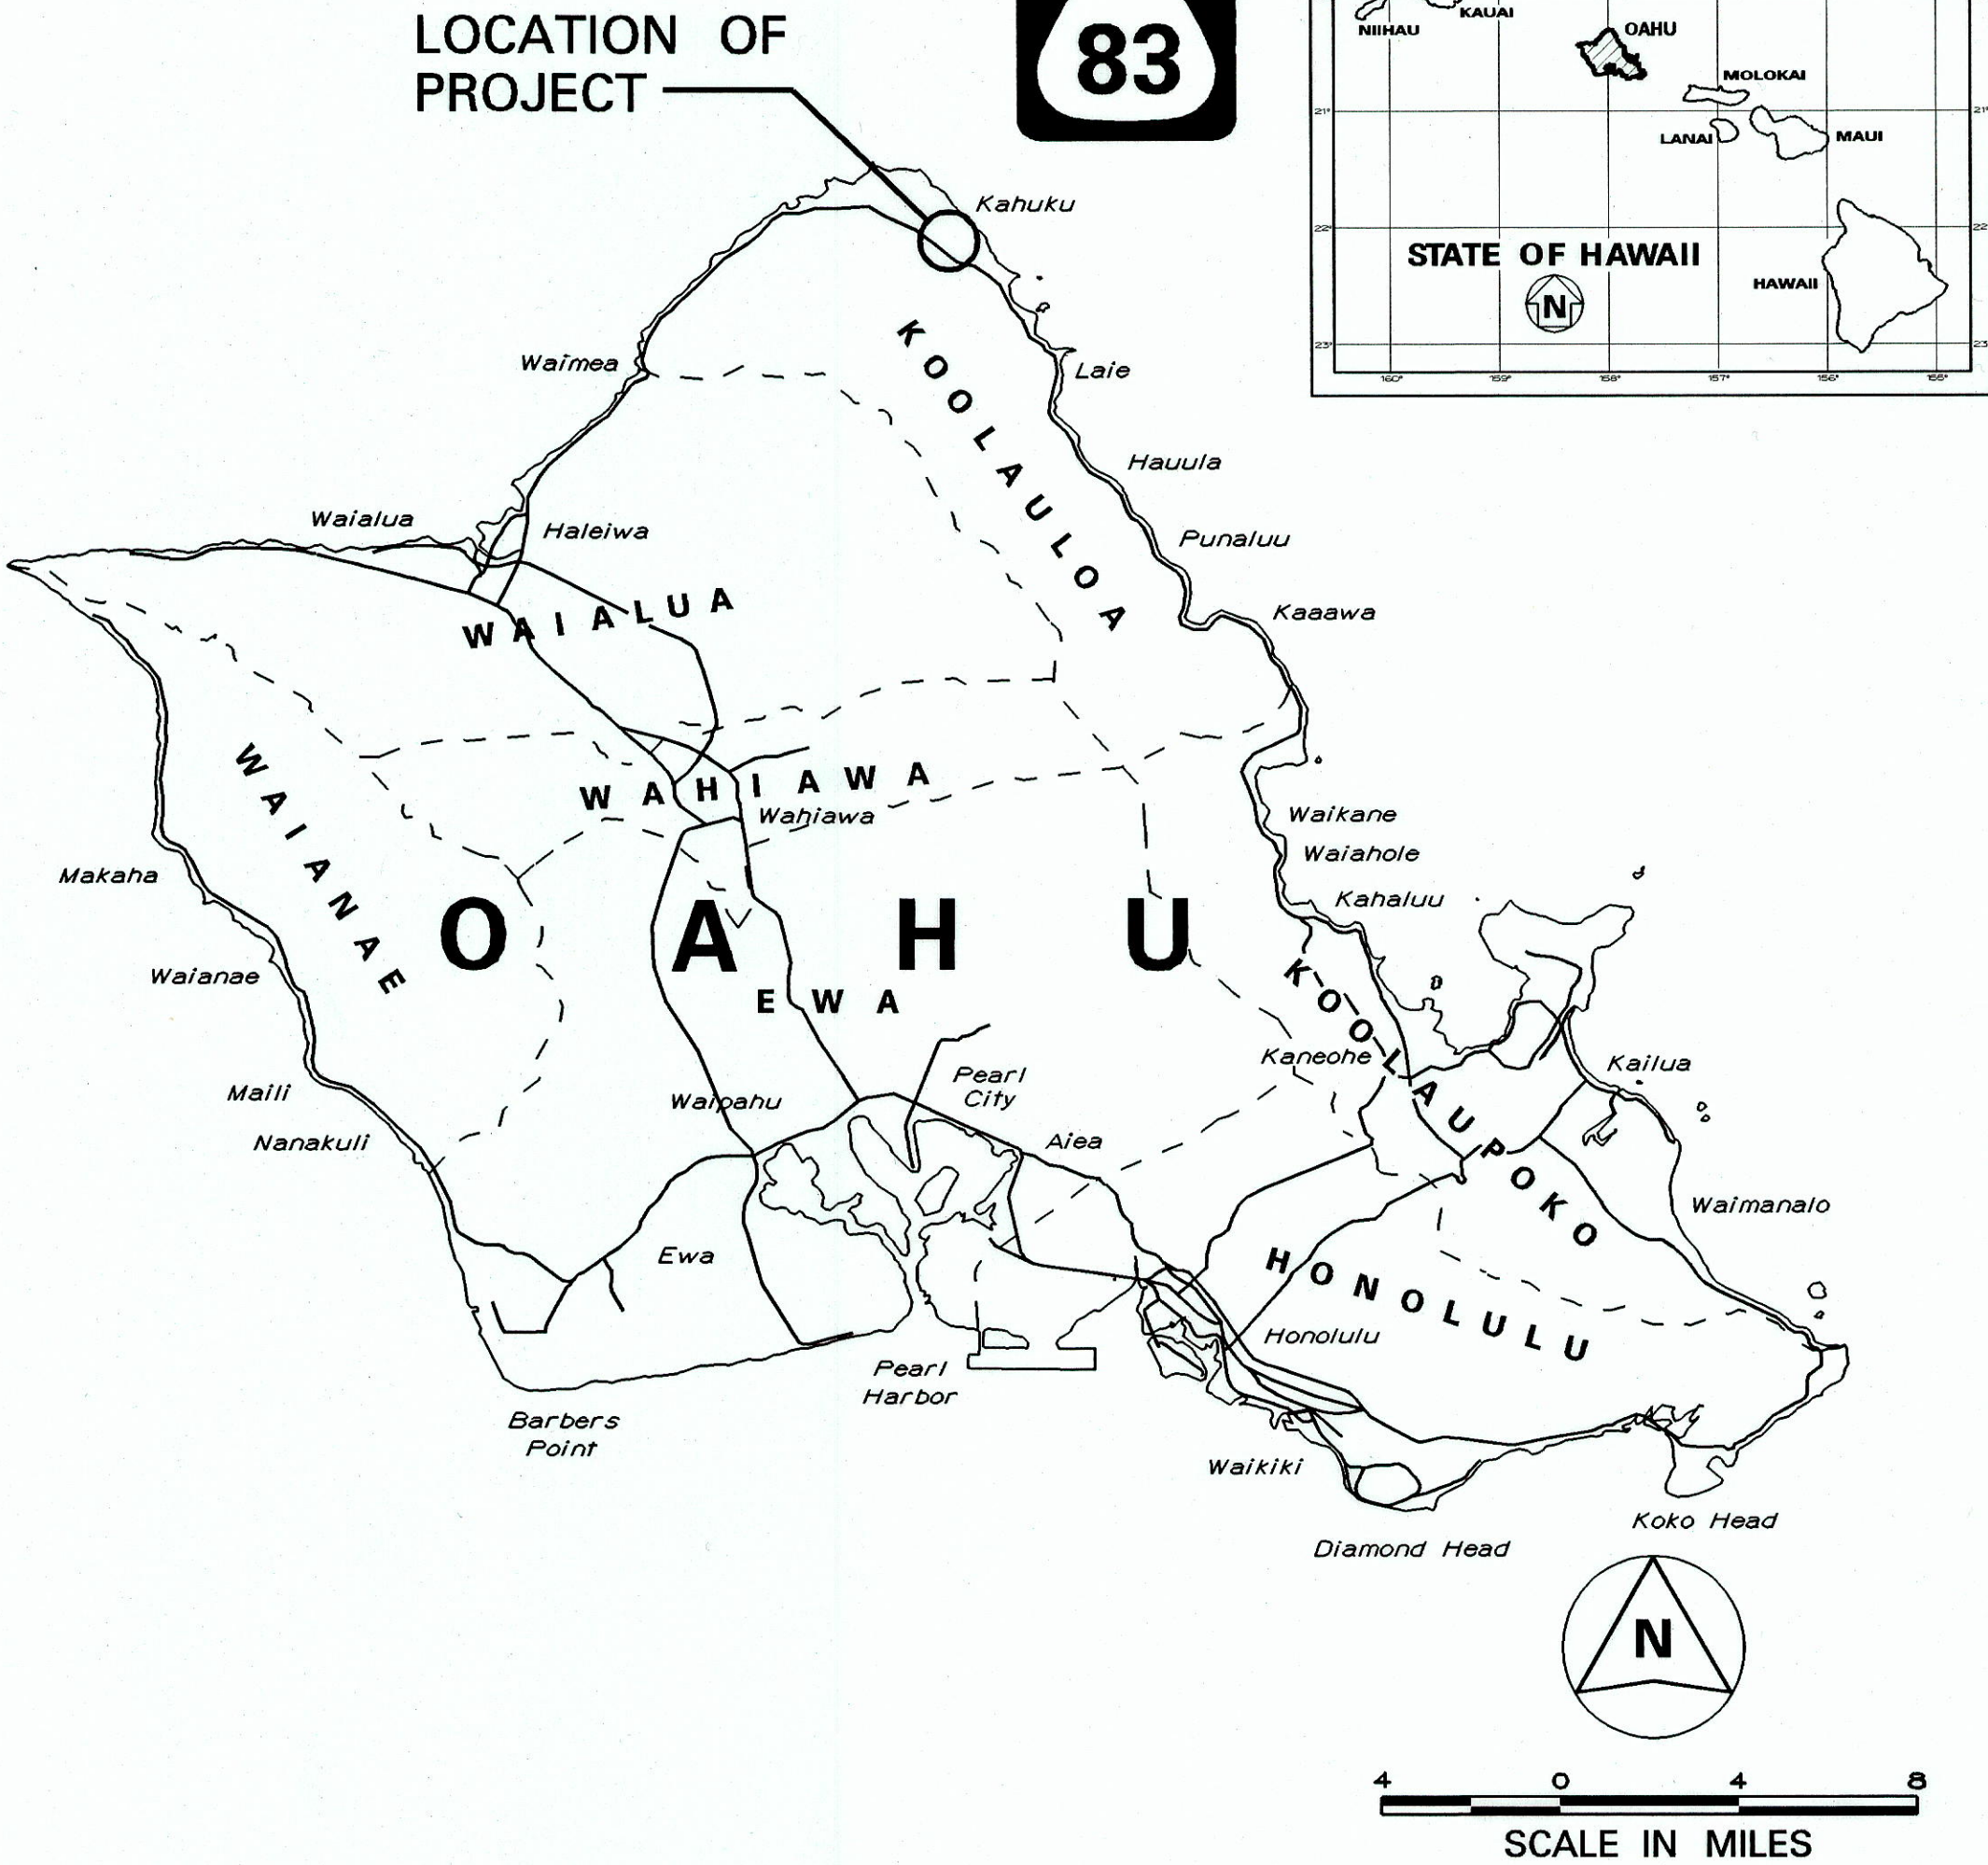


INDEX TO DRAWINGS	
SHEET NO.	DESCRIPTION
1	TITLE SHEET
2	STANDARD PLAN SUMMARY
3 - 5	GENERAL NOTES AND LEGEND
6 - 7	UTILITY NOTES
8 - 9	WATER POLLUTION & EROSION CONTROL NOTES
10 - 11	TYPICAL SECTIONS
12 - 13	ROADWAY PLANS
14 - 15	TEMPORARY UTILITY RELOCATION PLAN
16 - 18	PARCEL LAYOUT
19 - 20	CULVERT AND BRIDGE PLANS
21	TEMPORARY STREET LIGHT DETAIL
22	TILE-COLUMN BUS SHELTER
23 - 40	GUARDRAIL DETAILS AND NOTES
41 - 42	PORTABLE CONCRETE BARRIER
43 - 45	BORING LOGS
46 - 53	REFERENCE PLANS

STATE OF HAWAII
DEPARTMENT OF TRANSPORTATION
HIGHWAYS DIVISION
HONOLULU, HAWAII
"AS-BUILT"
DESIGN BUILD PLANS FOR
**KAMEHAMEHA HIGHWAY
DRAINAGE IMPROVEMENTS**
VICINITY OF KAHUKU HOSPITAL AND REPLACEMENT OF KII BRIDGE
FEDERAL AID PROJECT NO. NH-083-1(46)
DISTRICT OF KOOLAULOA
ISLAND OF OAHU


FED. ROAD DIST. NO.	STATE	PROJ. NO.	FISCAL YEAR	SHEET NO.	TOTAL SHEETS
HAWAII	HAW.	NH-083-1(46)	2002	1	53

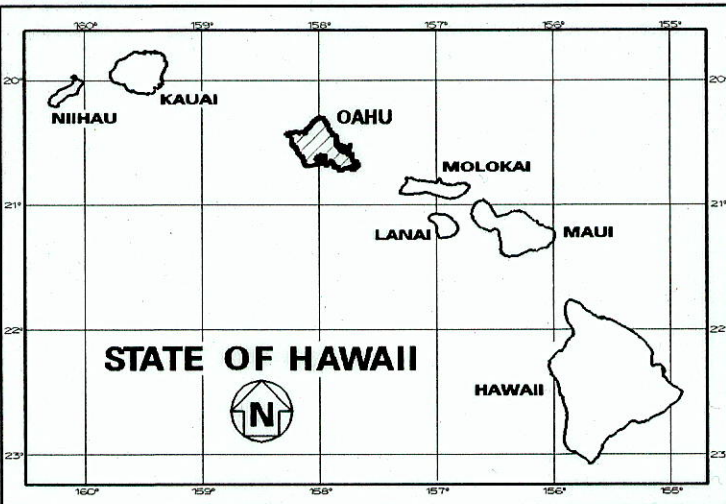

MILE POST 15.04 TO MILE POST 15.35

DESIGN DESIGNATION

ADT (2002).....	6,600
ADT (2022).....	7,600
DHV	700
D	55/45
T	4.0 %
T ₂₄	4.5 %
K	9.0
V	45 M.P.H.

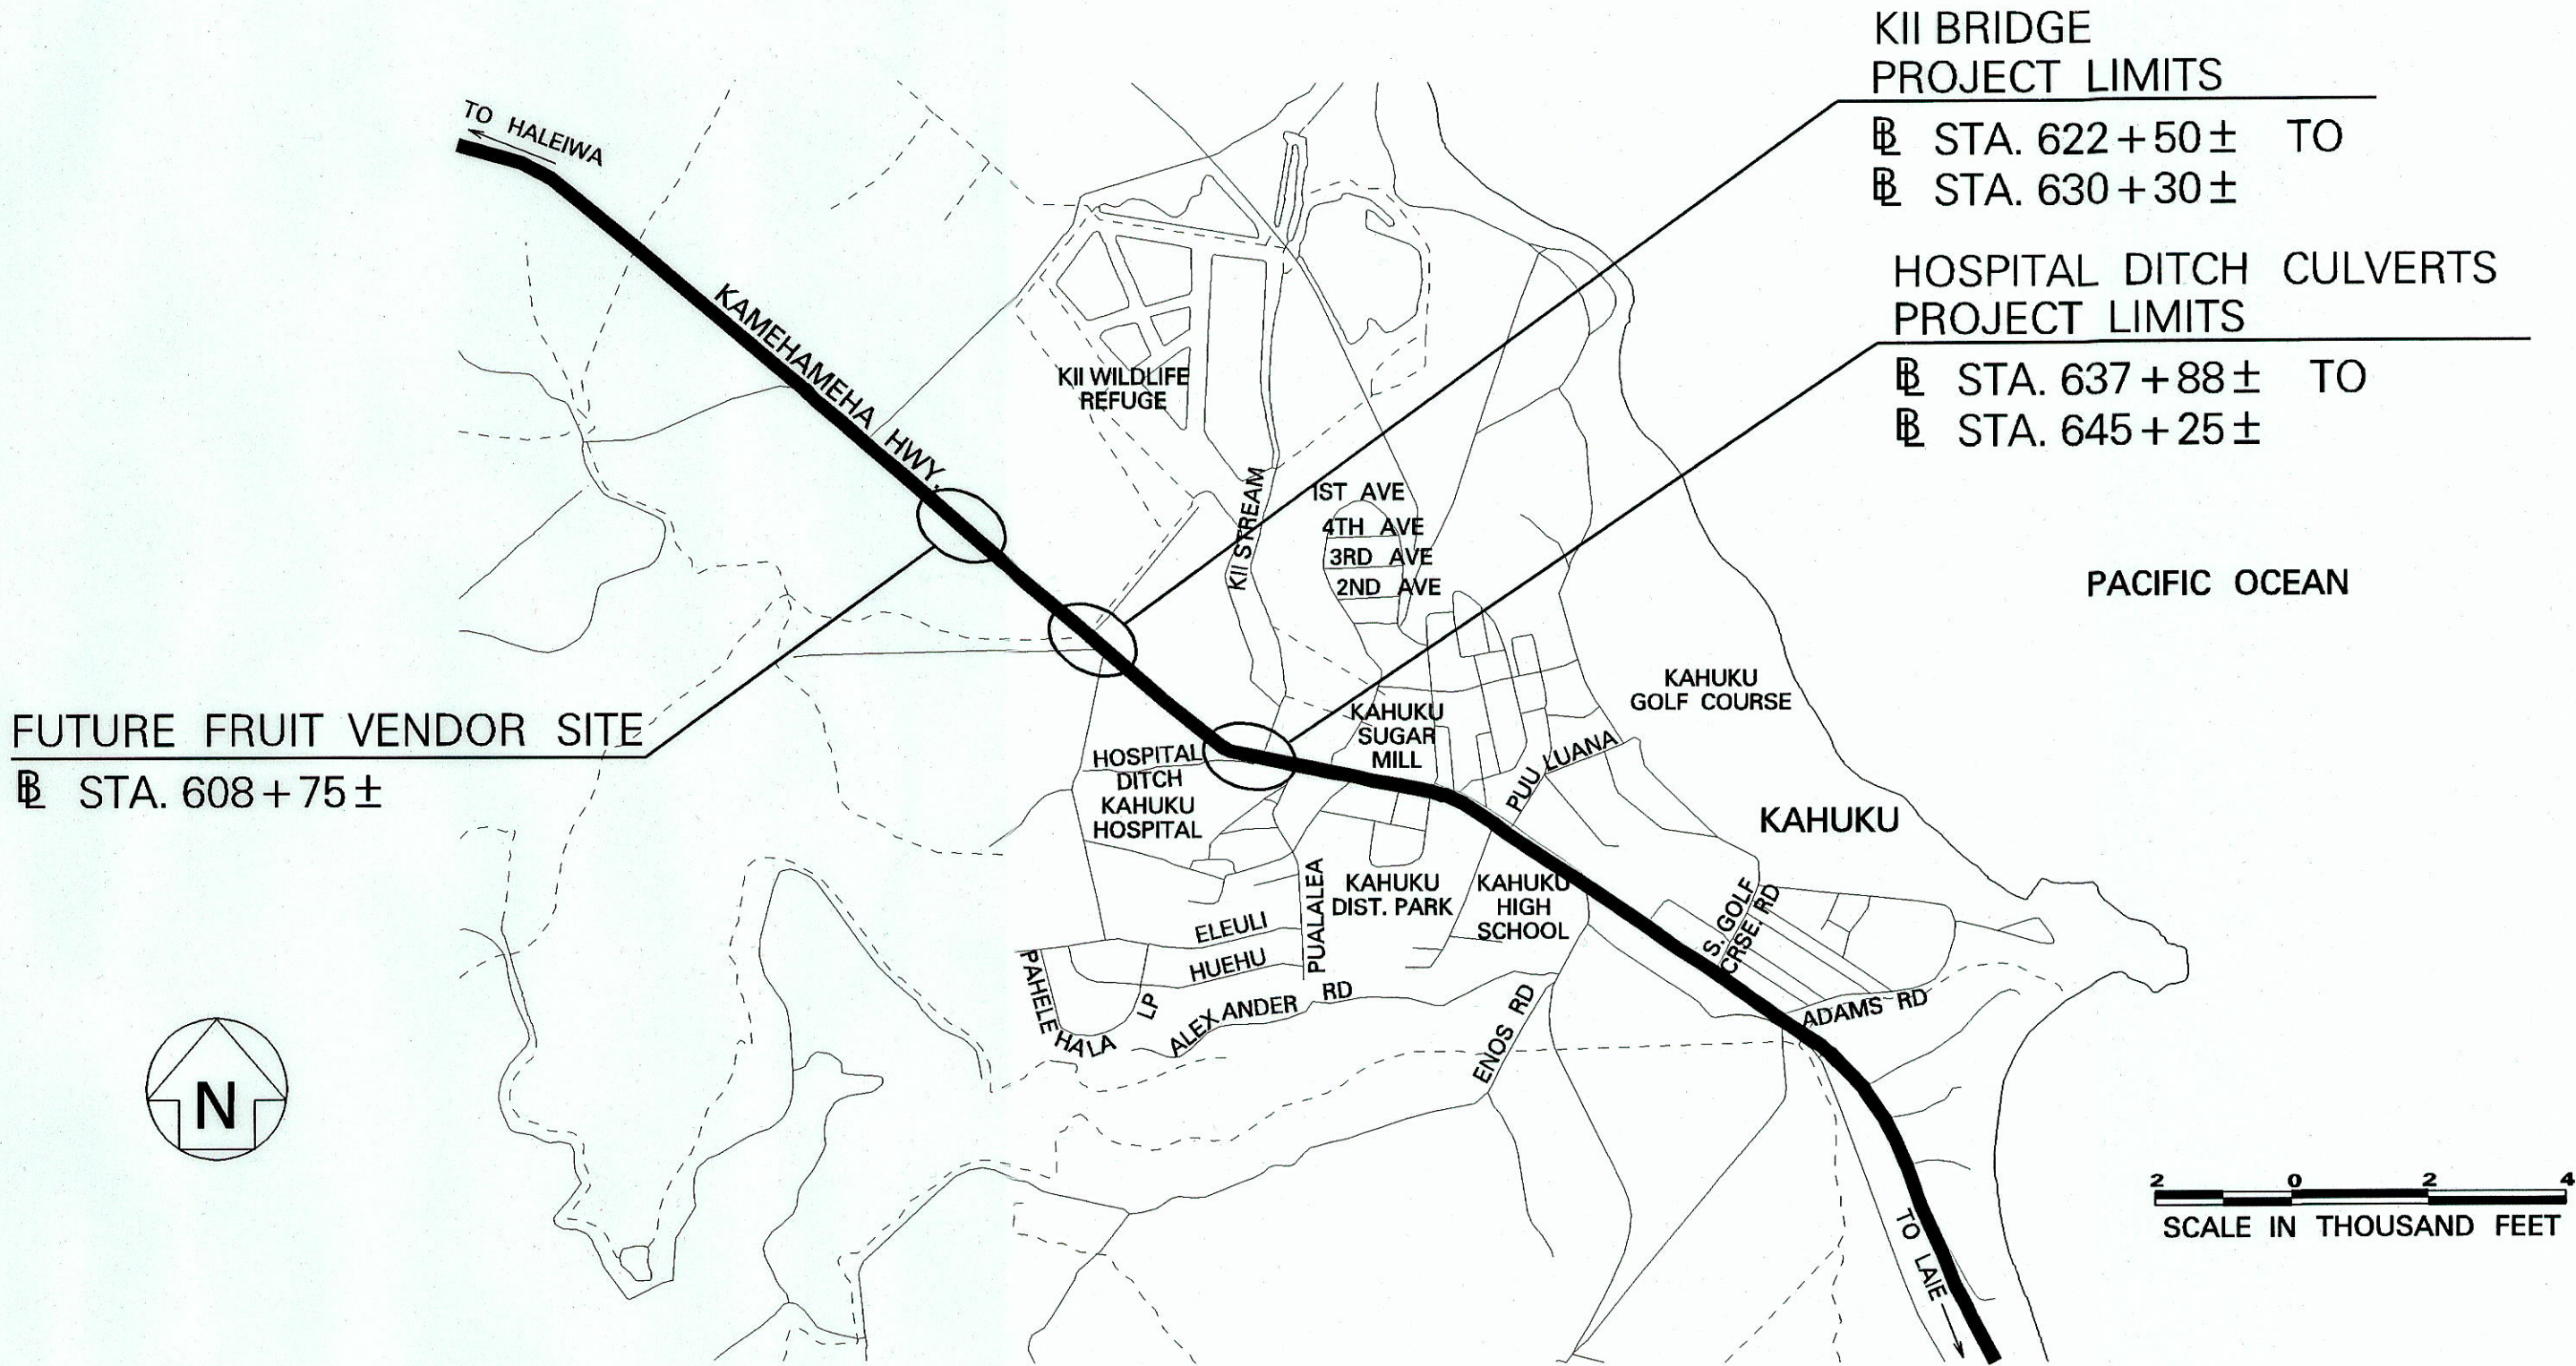

LAYOUT PLAN

GROSS LENGTH OF PROJECT..... 0.31 MILES
NET LENGTH OF PROJECT..... 0.31 MILES

CHANGES MADE DURING CONSTRUCTION HAVE BEEN INCORPORATED ON THESE PLANS EXCEPT CHANGES IN THE ORIGINAL THEORETICAL QUANTITIES. FOR ACTUAL QUANTITIES, REFER TO PROJECT LEDGER AND/OR COMPUTATION BOOK.
RESIDENT ENGINEER
DATE 9/1/15

DEPARTMENT OF TRANSPORTATION
STATE OF HAWAII
APPROVED:
for DIR. OF TRANSPORTATION
DATE 4-10-02

S. URADA
DESIGNED BY
P. S. & E. BY
692-7553
PHONE
APRIL 2002
DATE