
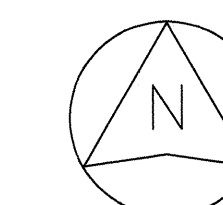
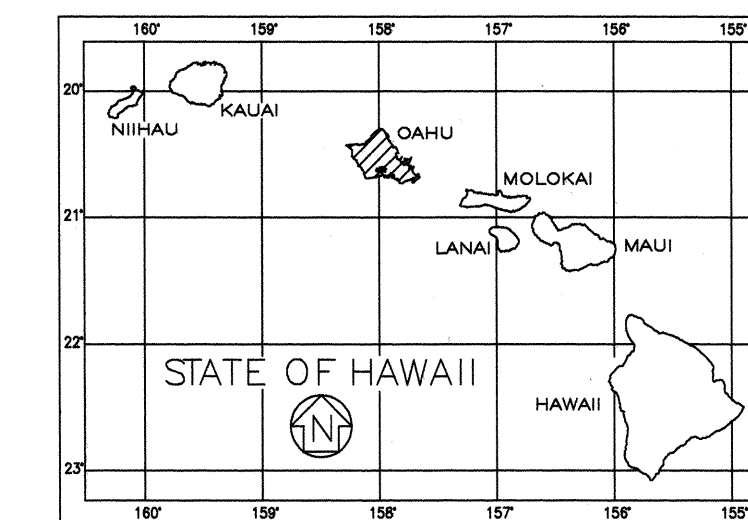


FED.ROAD DIST.NO.	STATE	PROJ. NO.	FISCAL YEAR	SHEET NO.	TOTAL SHEETS
HAWAII	HAW.	83A-01-98	1998	1	28

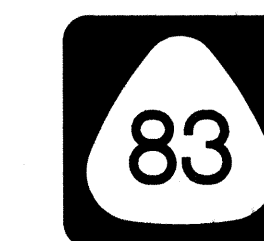


4 0 4

SCALE IN MILES

MILE POST 0 TO MILE POST 2.1

VICINITY MAP

T.M.K.'S: 6-2-07 AND 6-4-0

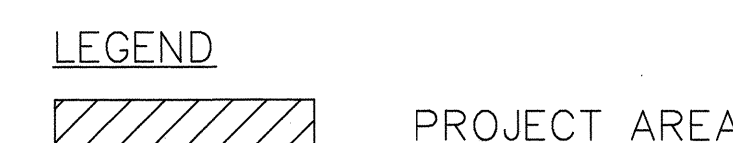

CHANGES MADE DURING CONSTRUCTION HAVE BEEN INCORPORATED ON THESE PLANS EXCEPT CHANGES IN THE ORIGINAL THEORETICAL QUANTITIES. FOR ACTUAL QUANTITIES, REFER TO PROJECT LEDGER AND/OR COMPUTATION BOOK.

RESIDENT ENGINEER

DEPARTMENT OF TRANSPORTATION STATE OF HAWAII	
APPROVED: <i>Suzanne Kuyarukiki</i> 5/19	
DIR. OF TRANSPORTATION	DATE

Disk: DOT-HWY.DWG File: TITLE SHEET(2) Plot: 1=1
MAY 1998 / 93011 / 1 / FINAL / PL

HAWAII DESIGN ASSOCIATES, INC.	H. KENNEDY	587-2124	MAY, 1998
DESIGNED BY:	P. S. & F. RY	PHONE	DATE

LAYOUT PLAN

GROSS LENGTH OF PROJECT..... 2.11 MILES
NET LENGTH OF PROJECT..... 1.79 MILES