
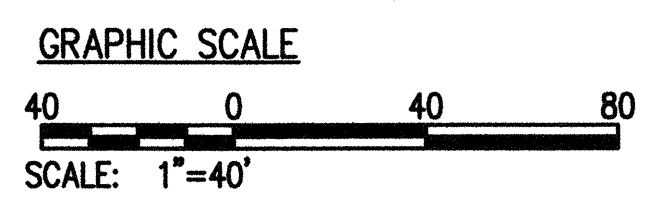


FED. ROAD DIST. NO.	STATE	FED. AID PROJ. NO.	FISCAL YEAR	SHEET NO.	TOTAL SHEETS
OAHU	HAW.	STP-083-1(45)	2000	ADD 8	39

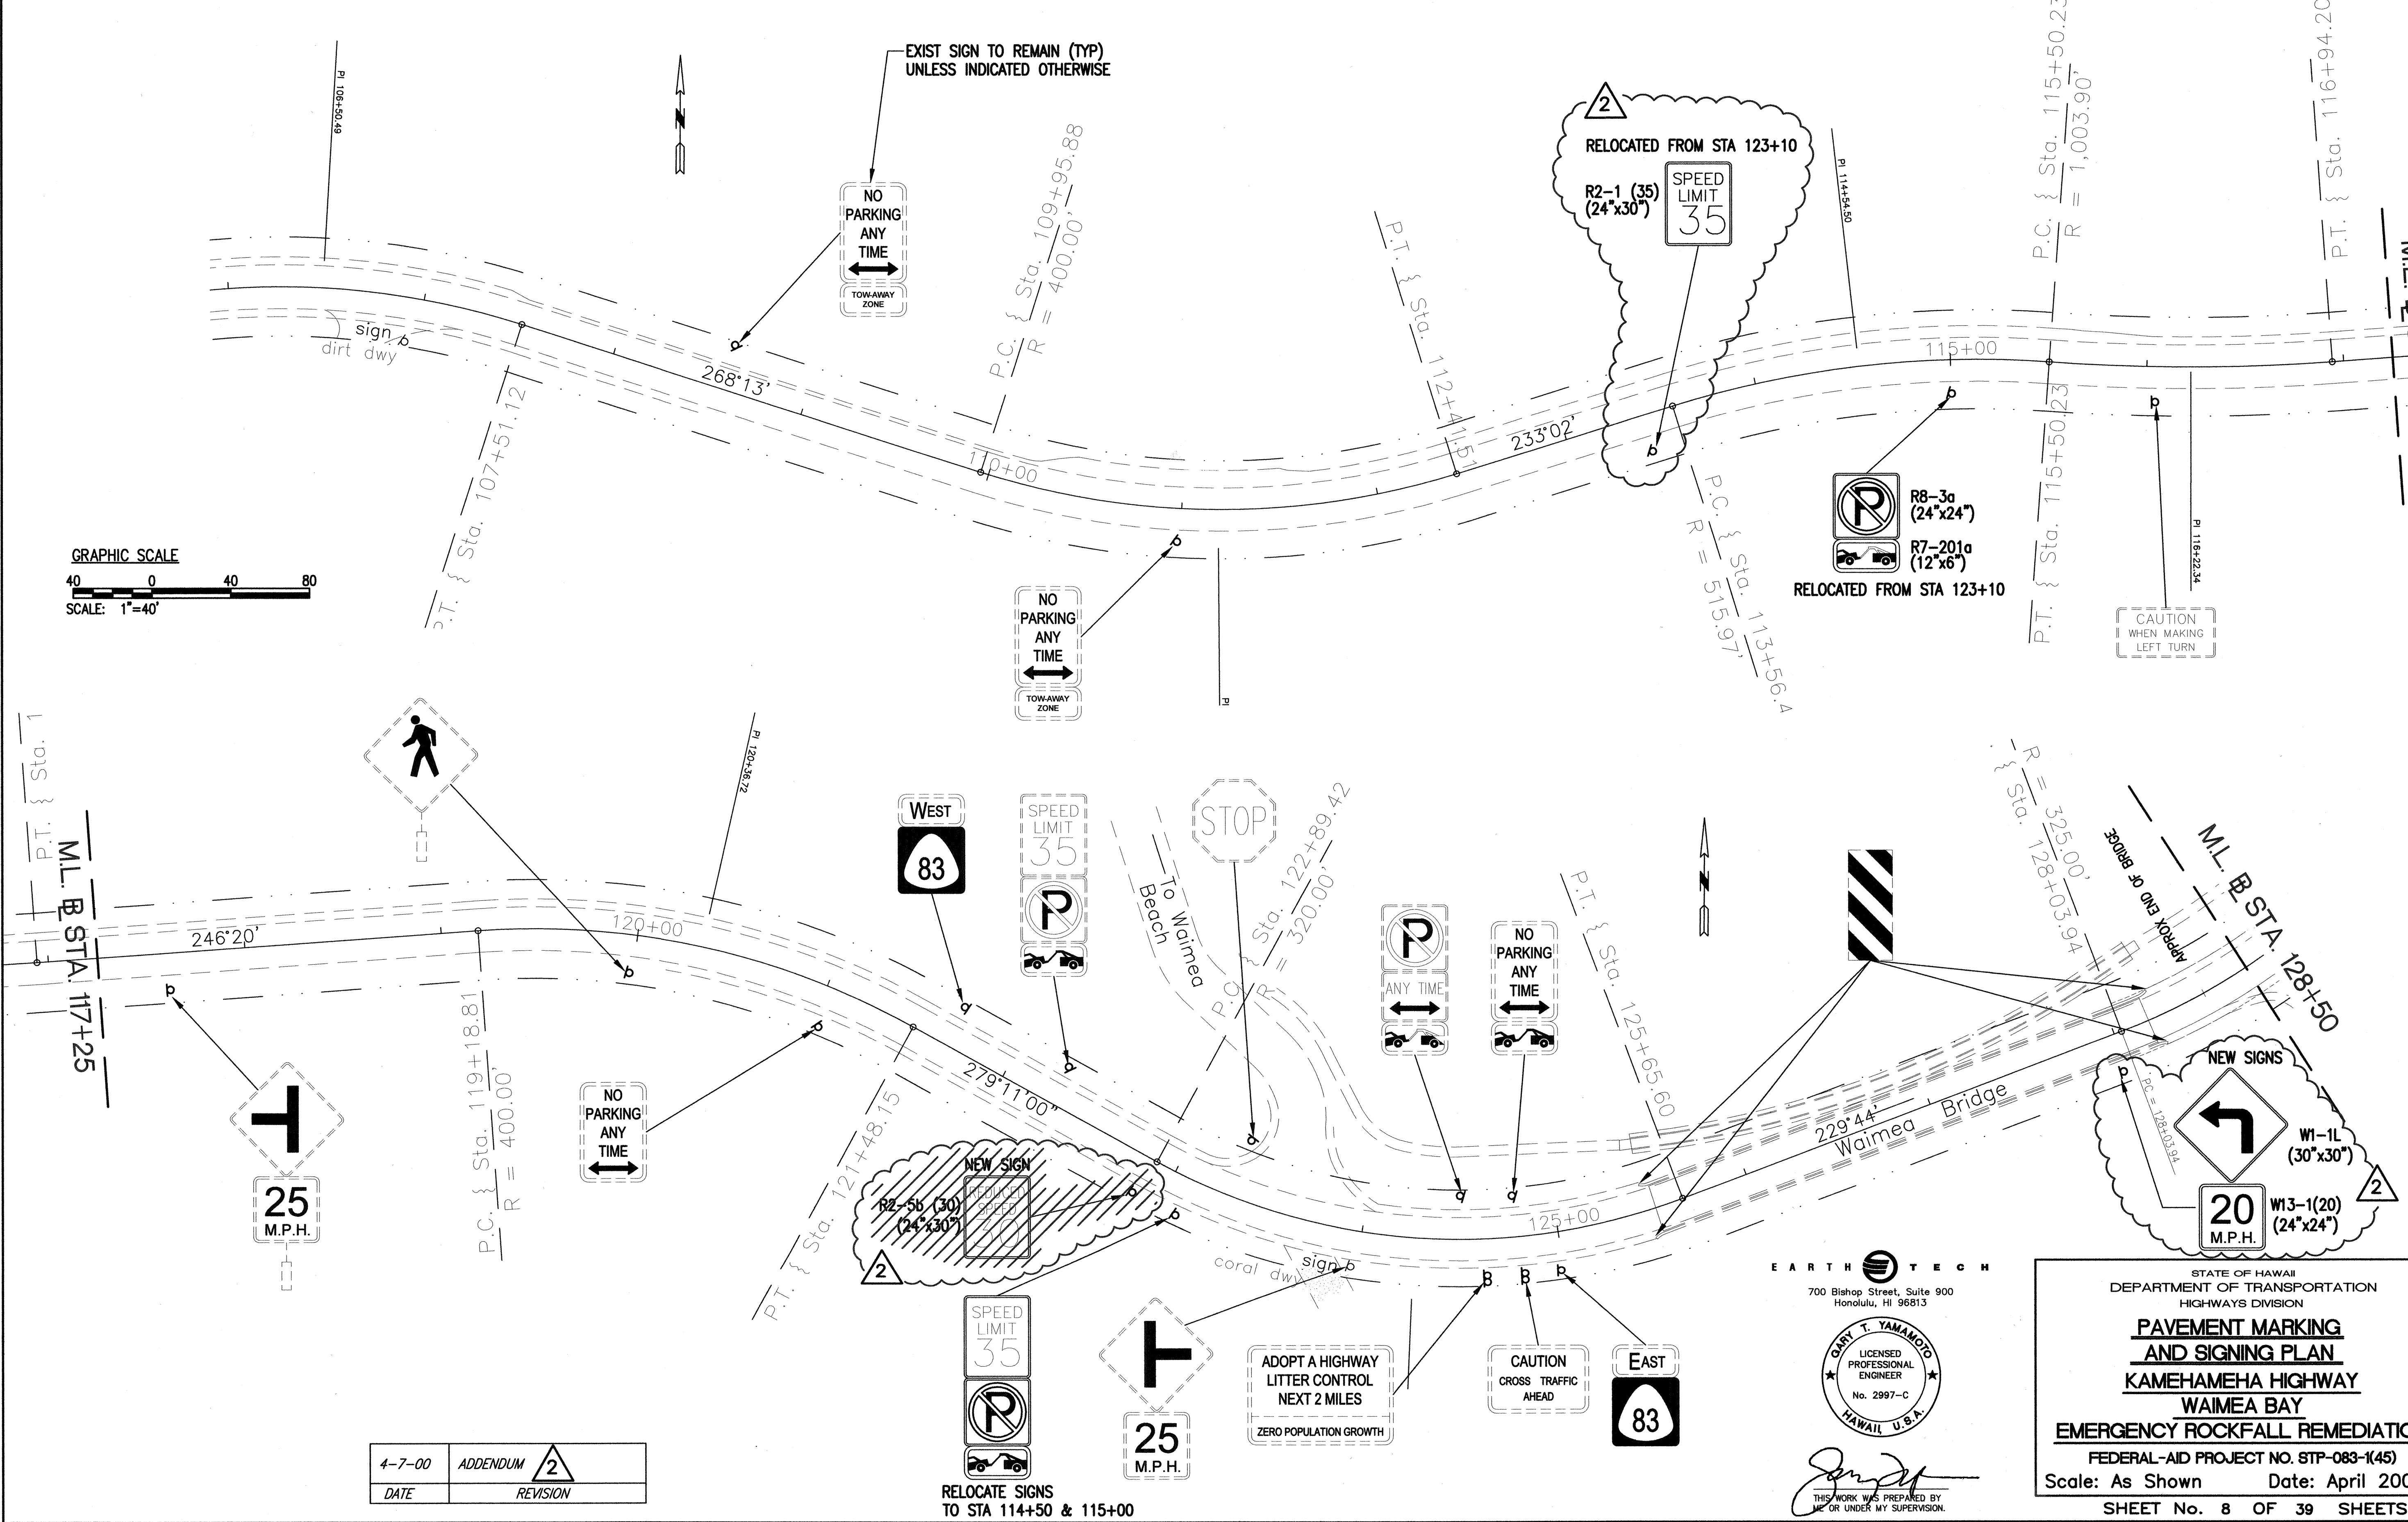

SURVEY PLOTTED BY	DATE
DRAWN BY	
DESIGNED BY	
QUANTITIES BY	
CHECKED BY	
NOTE BOOK No.	

4-7-00	ADDENDUM	2
DATE	REVISION	

RELOCATE SIGNS TO STA 114+50 & 115+00

EARTH TECH
 700 Bishop Street, Suite 900
 Honolulu, HI 96813

GARY T. YAMAMOTO
 LICENSED PROFESSIONAL ENGINEER
 No. 2997-C
 HAWAII, U.S.A.

THIS WORK WAS PREPARED BY ME OR UNDER MY SUPERVISION.

STATE OF HAWAII
 DEPARTMENT OF TRANSPORTATION
 HIGHWAYS DIVISION

PAVEMENT MARKING AND SIGNING PLAN
KAMEHAMEHA HIGHWAY
WAIMEA BAY
EMERGENCY ROCKFALL REMEDIATION

FEDERAL-AID PROJECT NO. STP-083-1(45)
 Scale: As Shown Date: April 2000
 SHEET No. 8 OF 39 SHEETS



"AS-BUILT"

ADD. 8

PAVEMENT MARKING SCHEDULE

BEGIN STA	END STA	PAVEMENT MARKING	STRIPING TYPE	RAISED MARKER
131+00	144+49.44	CENTERLINE	DOUBLE 4" YELLOW STRIPE	TYPE D, 20' ON CENTER
131+00	135+00	LEFT & RIGHT EDGE OF TRAVELWAY	8" WHITE EDGE STRIPE	TYPE C, 40' ON CENTER
135+00	144+49.44	LEFT & RIGHT EDGE OF TRAVELWAY	4" WHITE EDGE STRIPE	TYPE C, 40' ON CENTER

FED. ROAD DIST. NO.	STATE	FED. AID PROJ. NO.	FISCAL YEAR	SHEET NO.	TOTAL SHEETS
OAHU	HAW.	STP-083-1(45)	2000	ADD.9	39

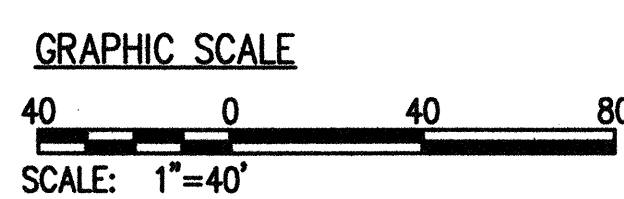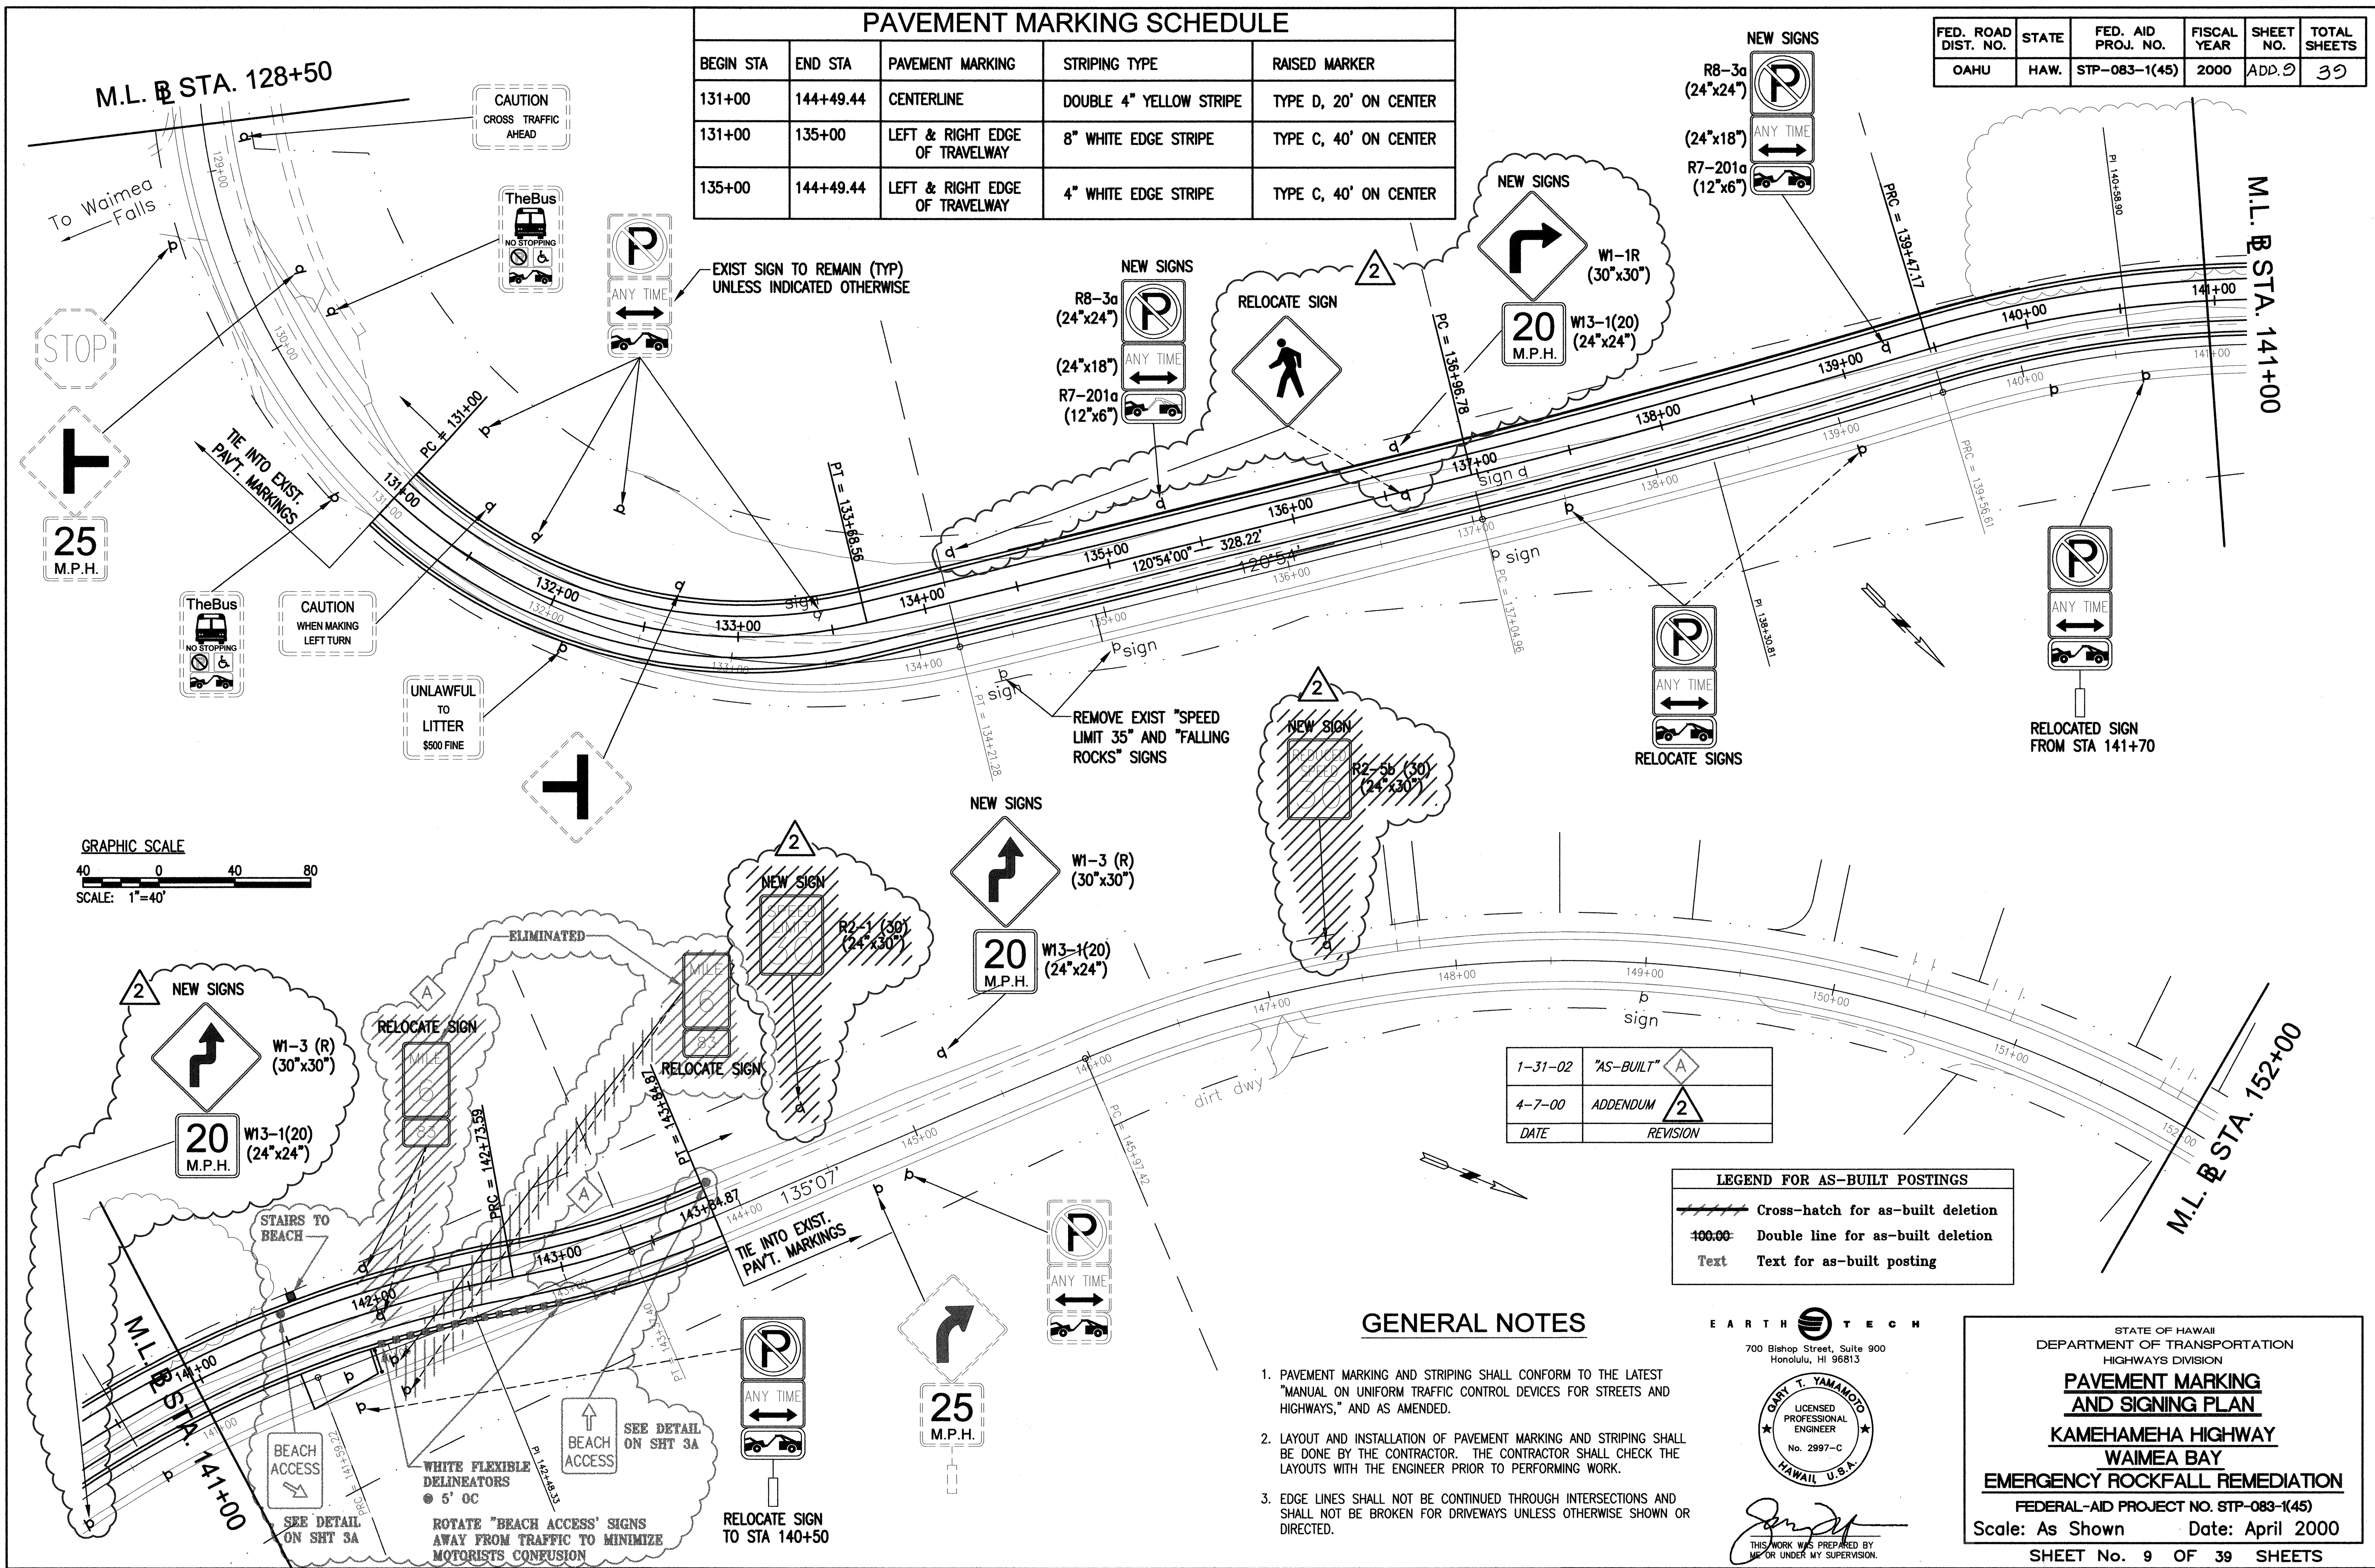

DATE	REVISION
1-31-02	"AS-BUILT" A
4-7-00	ADDENDUM 2


LEGEND FOR AS-BUILT POSTINGS

- Cross-hatch for as-built deletion
- Double line for as-built deletion
- Text for as-built posting

GENERAL NOTES

- PAVEMENT MARKING AND STRIPING SHALL CONFORM TO THE LATEST "MANUAL ON UNIFORM TRAFFIC CONTROL DEVICES FOR STREETS AND HIGHWAYS," AND AS AMENDED.
- LAYOUT AND INSTALLATION OF PAVEMENT MARKING AND STRIPING SHALL BE DONE BY THE CONTRACTOR. THE CONTRACTOR SHALL CHECK THE LAYOUTS WITH THE ENGINEER PRIOR TO PERFORMING WORK.
- EDGE LINES SHALL NOT BE CONTINUED THROUGH INTERSECTIONS AND SHALL NOT BE BROKEN FOR DRIVEWAYS UNLESS OTHERWISE SHOWN OR DIRECTED.

EARTH TECH
 700 Bishop Street, Suite 900
 Honolulu, HI 96813

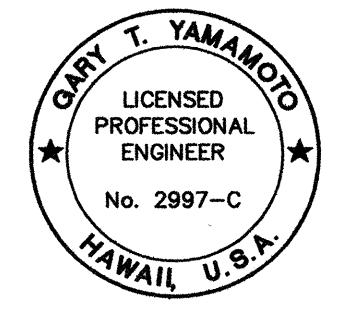

THIS WORK WAS PREPARED BY ME OR UNDER MY SUPERVISION.

STATE OF HAWAII
 DEPARTMENT OF TRANSPORTATION
 HIGHWAYS DIVISION
PAVEMENT MARKING AND SIGNING PLAN
 KAMEHAMEHA HIGHWAY
 WAIMEA BAY
EMERGENCY ROCKFALL REMEDIATION
 FEDERAL-AID PROJECT NO. STP-083-1(45)
 Scale: As Shown Date: April 2000
 SHEET No. 9 OF 39 SHEETS

SURVEY PLOTTED BY	DATE
DRAWN BY	
DESIGNED BY	
NOTE BOOK	
CHECKED BY	
No.	

"AS-BUILT"

ADD. 9