




FED. ROAD DIST. NO.	STATE	FED. AID PROJ. NO.	FISCAL YEAR	SHEET NO.	TOTAL SHEETS
OAHU	HAW.	STP-083-1(45)	2000	C.O. ADD. 4	39

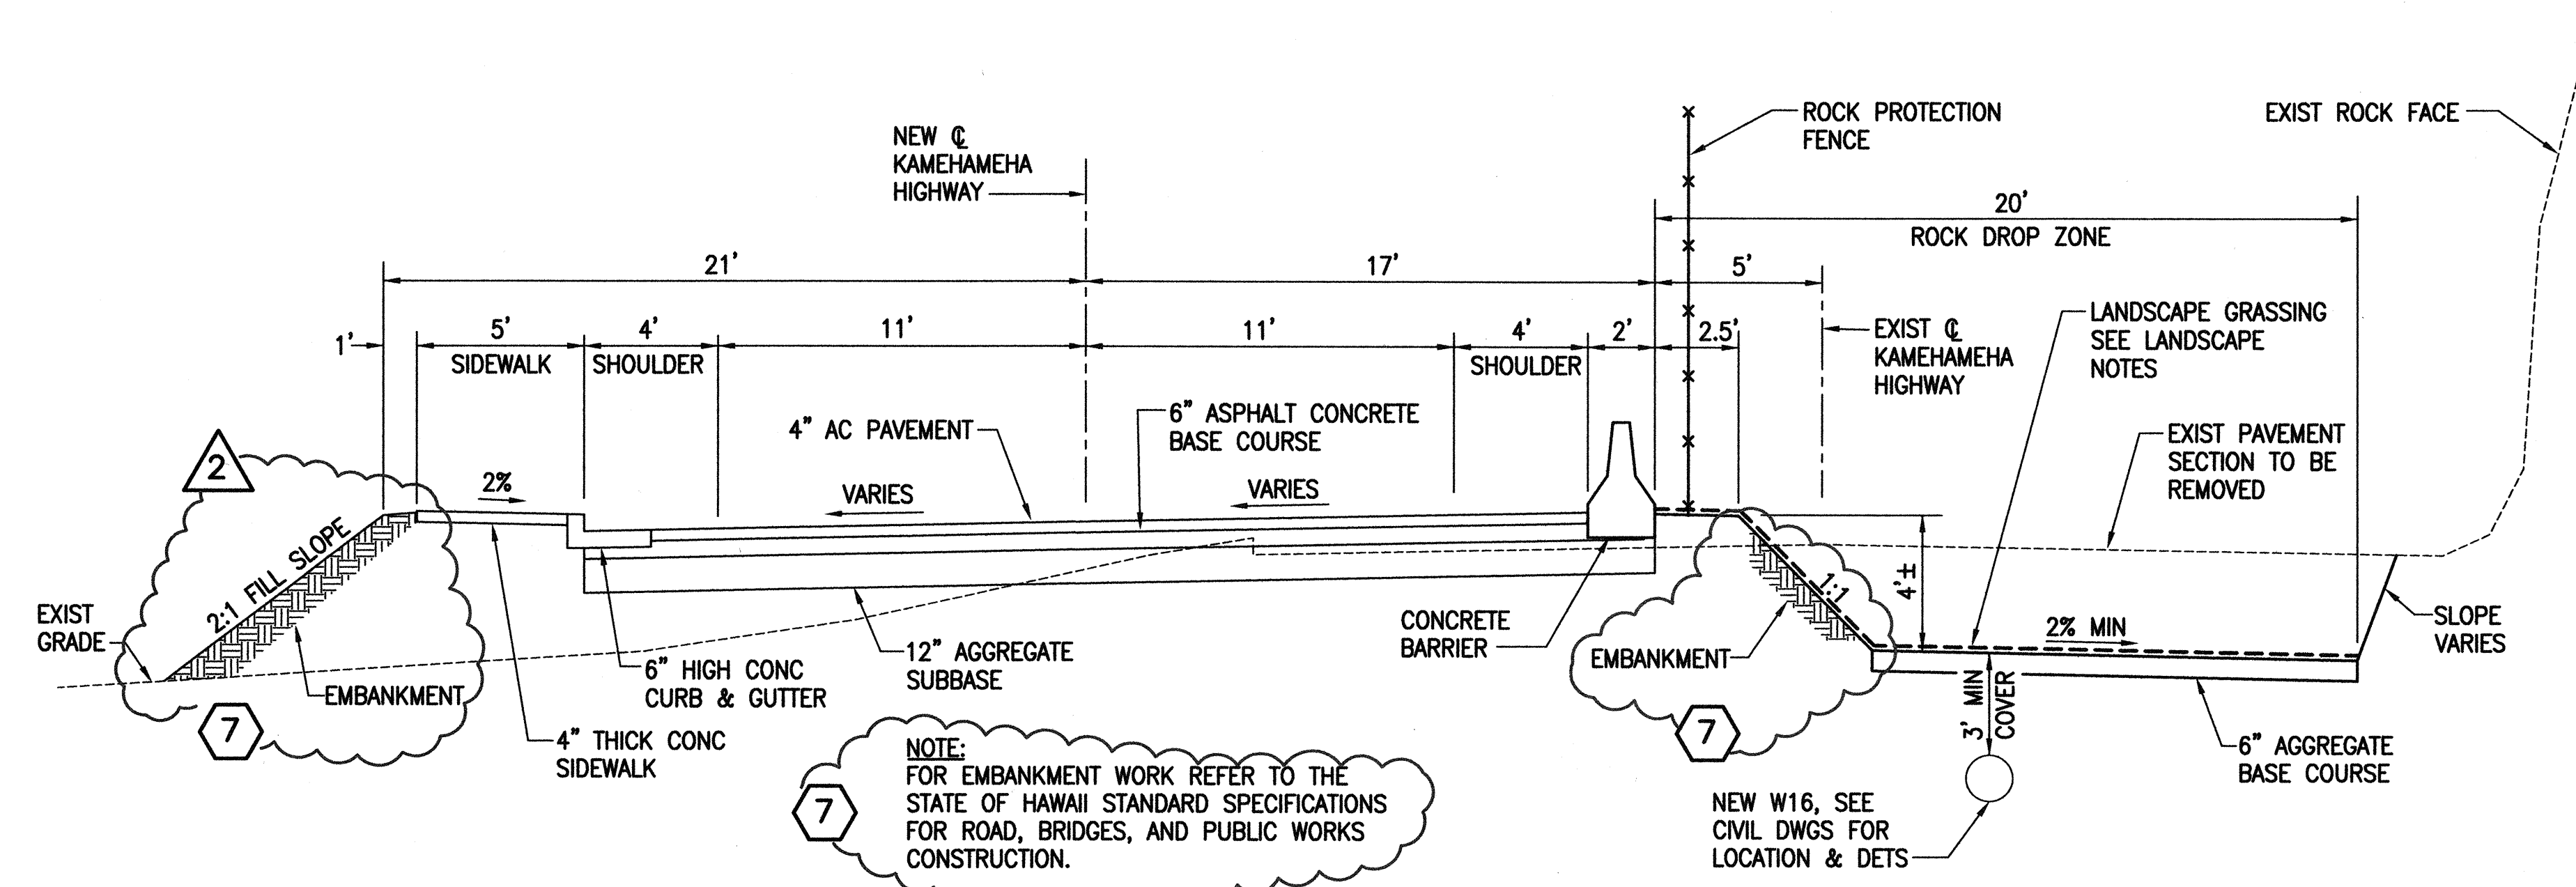

TYPICAL SUPERELEVATION SECTION WITH ROCK DROP ZONE
SCALE: 1/4"=1'-0"

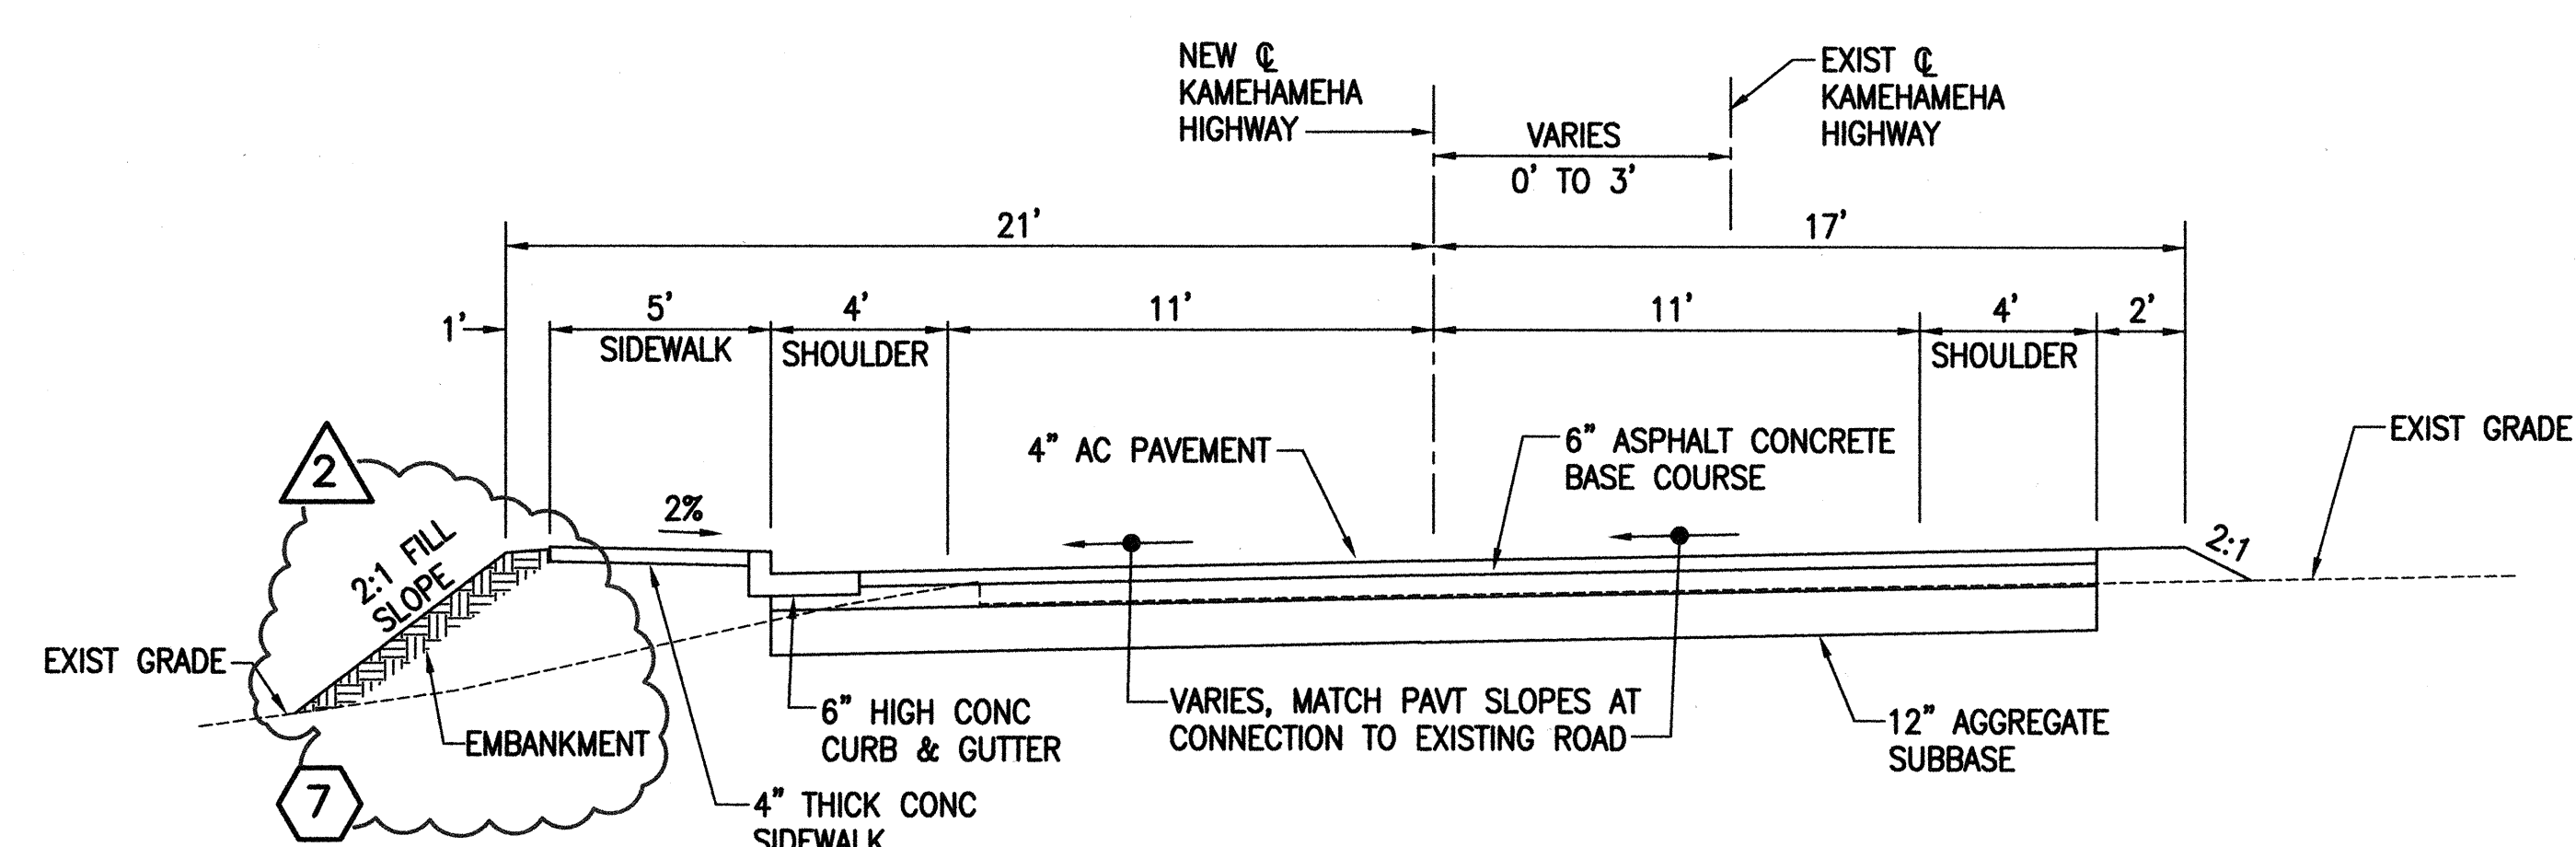

TYPICAL SUPERELEVATION SECTION
SCALE: 1/4"=1'-0"

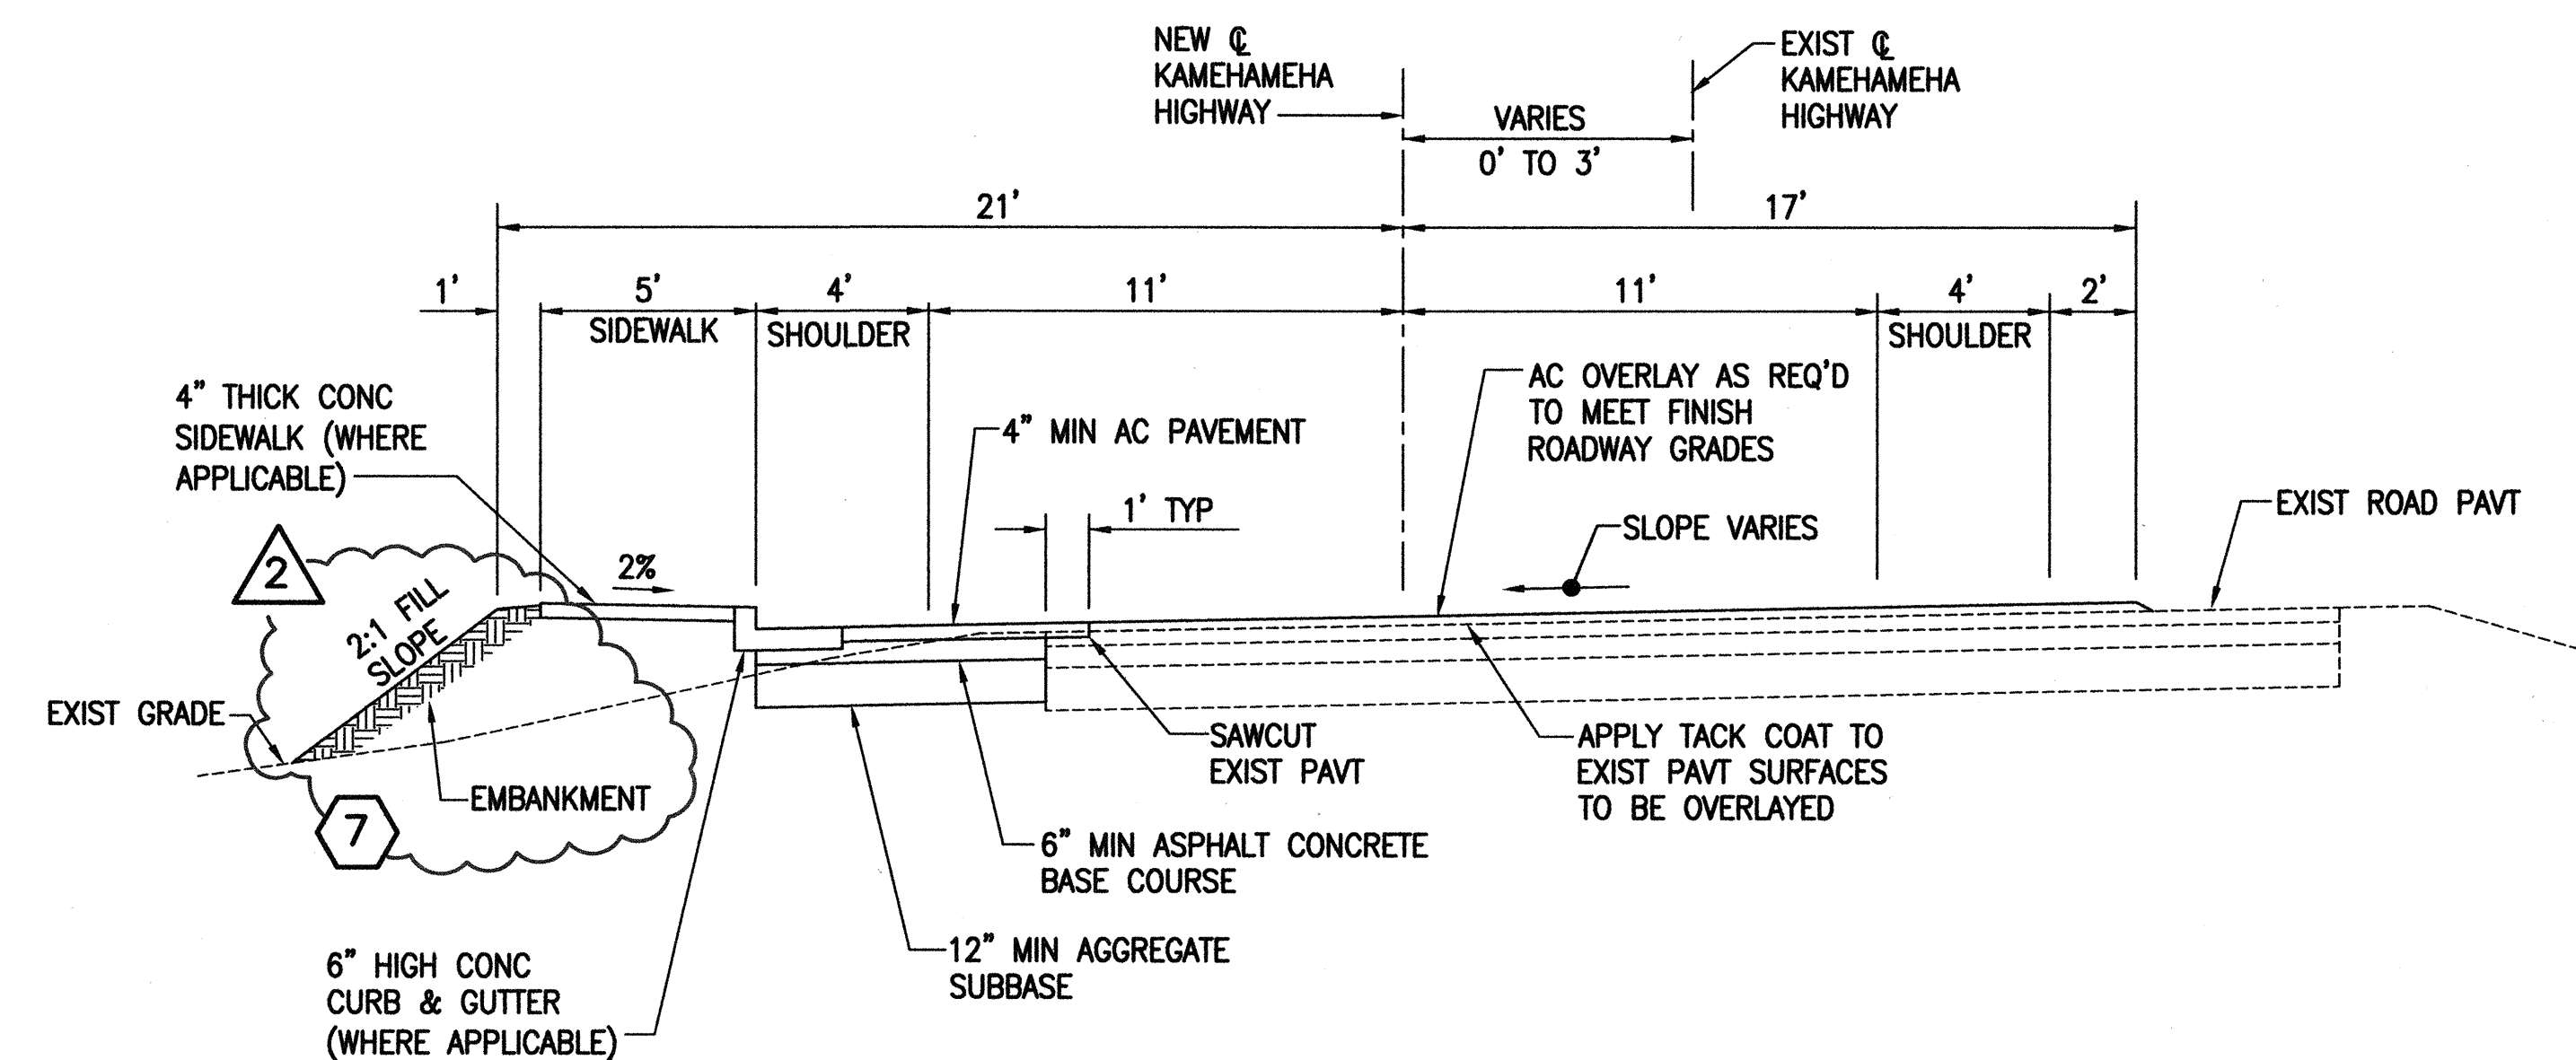

TYPICAL PAVEMENT TRANSITION SECTION
SCALE: 1/4"=1'-0"

DATE	_____
SURVEY PLOTTED BY	_____
DRAWN BY	_____
DESIGNED BY	_____
QUANTITIES BY	_____
CHECKED BY	_____
ORIGINAL PLAN	_____
NOTE BOOK	_____
No.	_____

5-22-00	REVISION	7
4-7-00	ADDENDUM	2
DATE	REVISION	

EARTH TECH
700 Bishop Street, Suite 900
Honolulu, HI 96813

QARI T. YAMAMOTO
LICENSED PROFESSIONAL ENGINEER
No. 2997-C
HAWAII, U.S.A.

[Signature]
THIS WORK WAS PREPARED BY ME OR UNDER MY SUPERVISION.

STATE OF HAWAII
DEPARTMENT OF TRANSPORTATION
HIGHWAYS DIVISION

TYPICAL CROSS SECTION

**KAMEHAMEHA HIGHWAY
WAIMEA BAY
EMERGENCY ROCKFALL REMEDIATION**




FEDERAL-AID PROJECT NO. STP-083-1(45)
Scale: As Shown Date: April 2000

SHEET No. 4 OF 39 SHEETS

"AS-BUILT"

C.O. ADD. 4


FED. ROAD DIST. NO.	STATE	FED. AID PROJ. NO.	FISCAL YEAR	SHEET NO.	TOTAL SHEETS
OAHU	HAW.	STP-083-1(45)	2000	C.O. ADD. 5	39

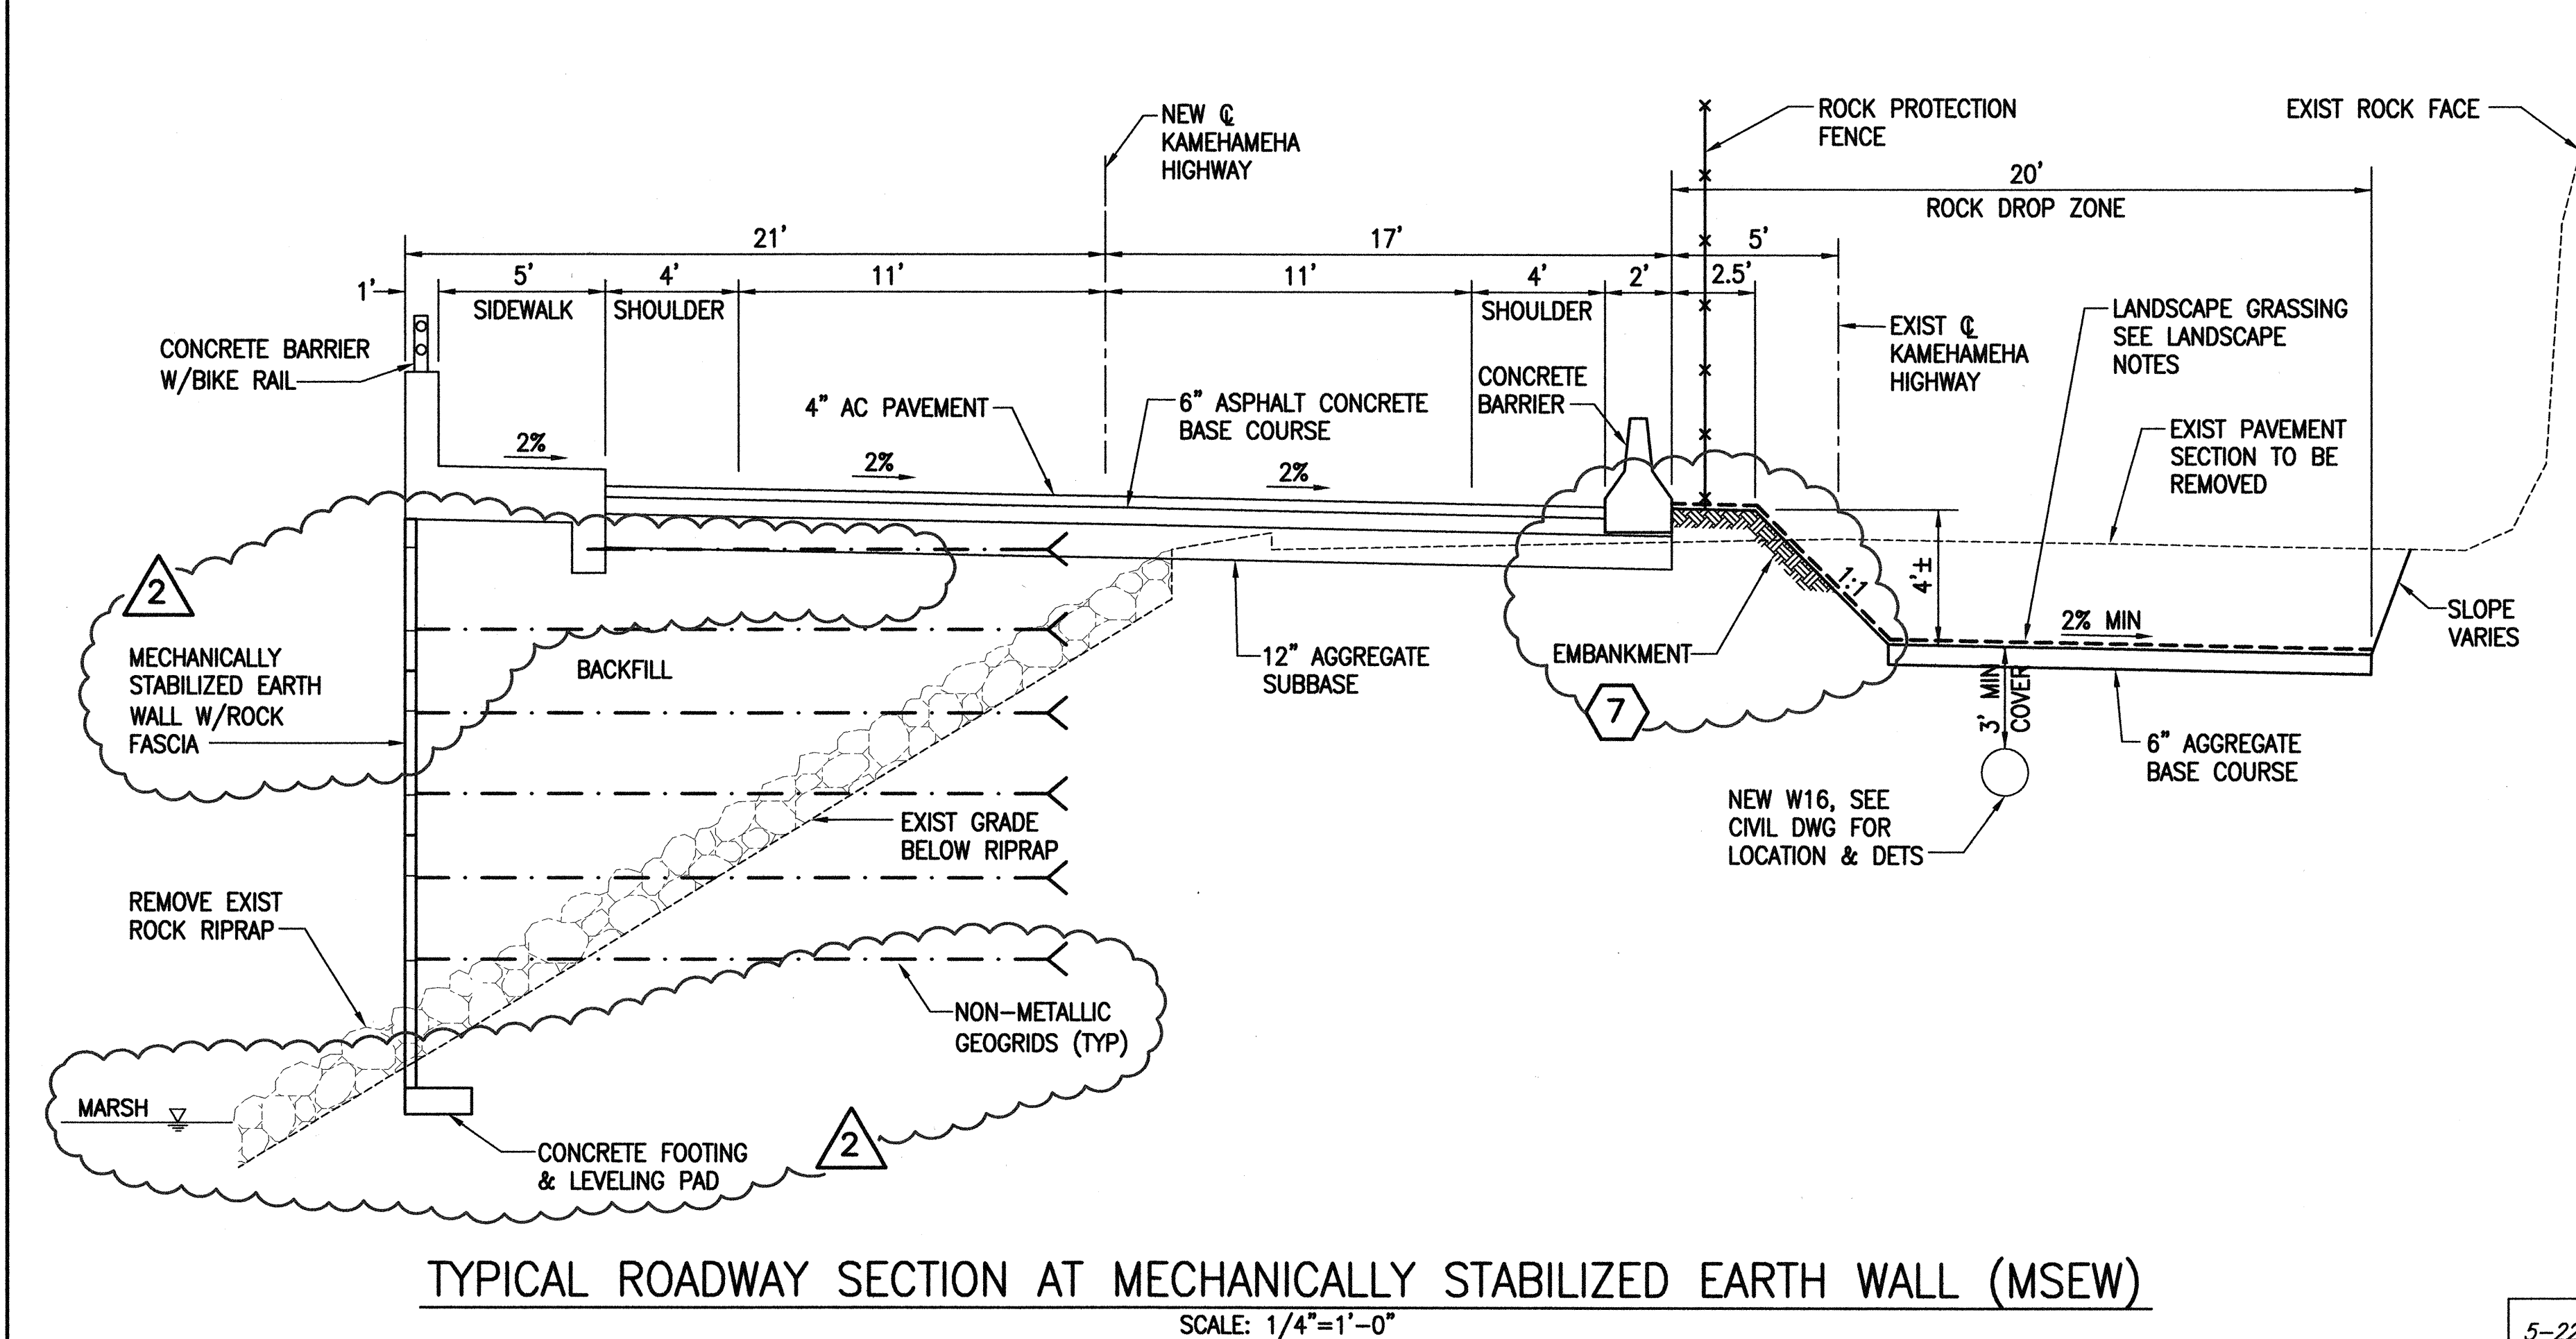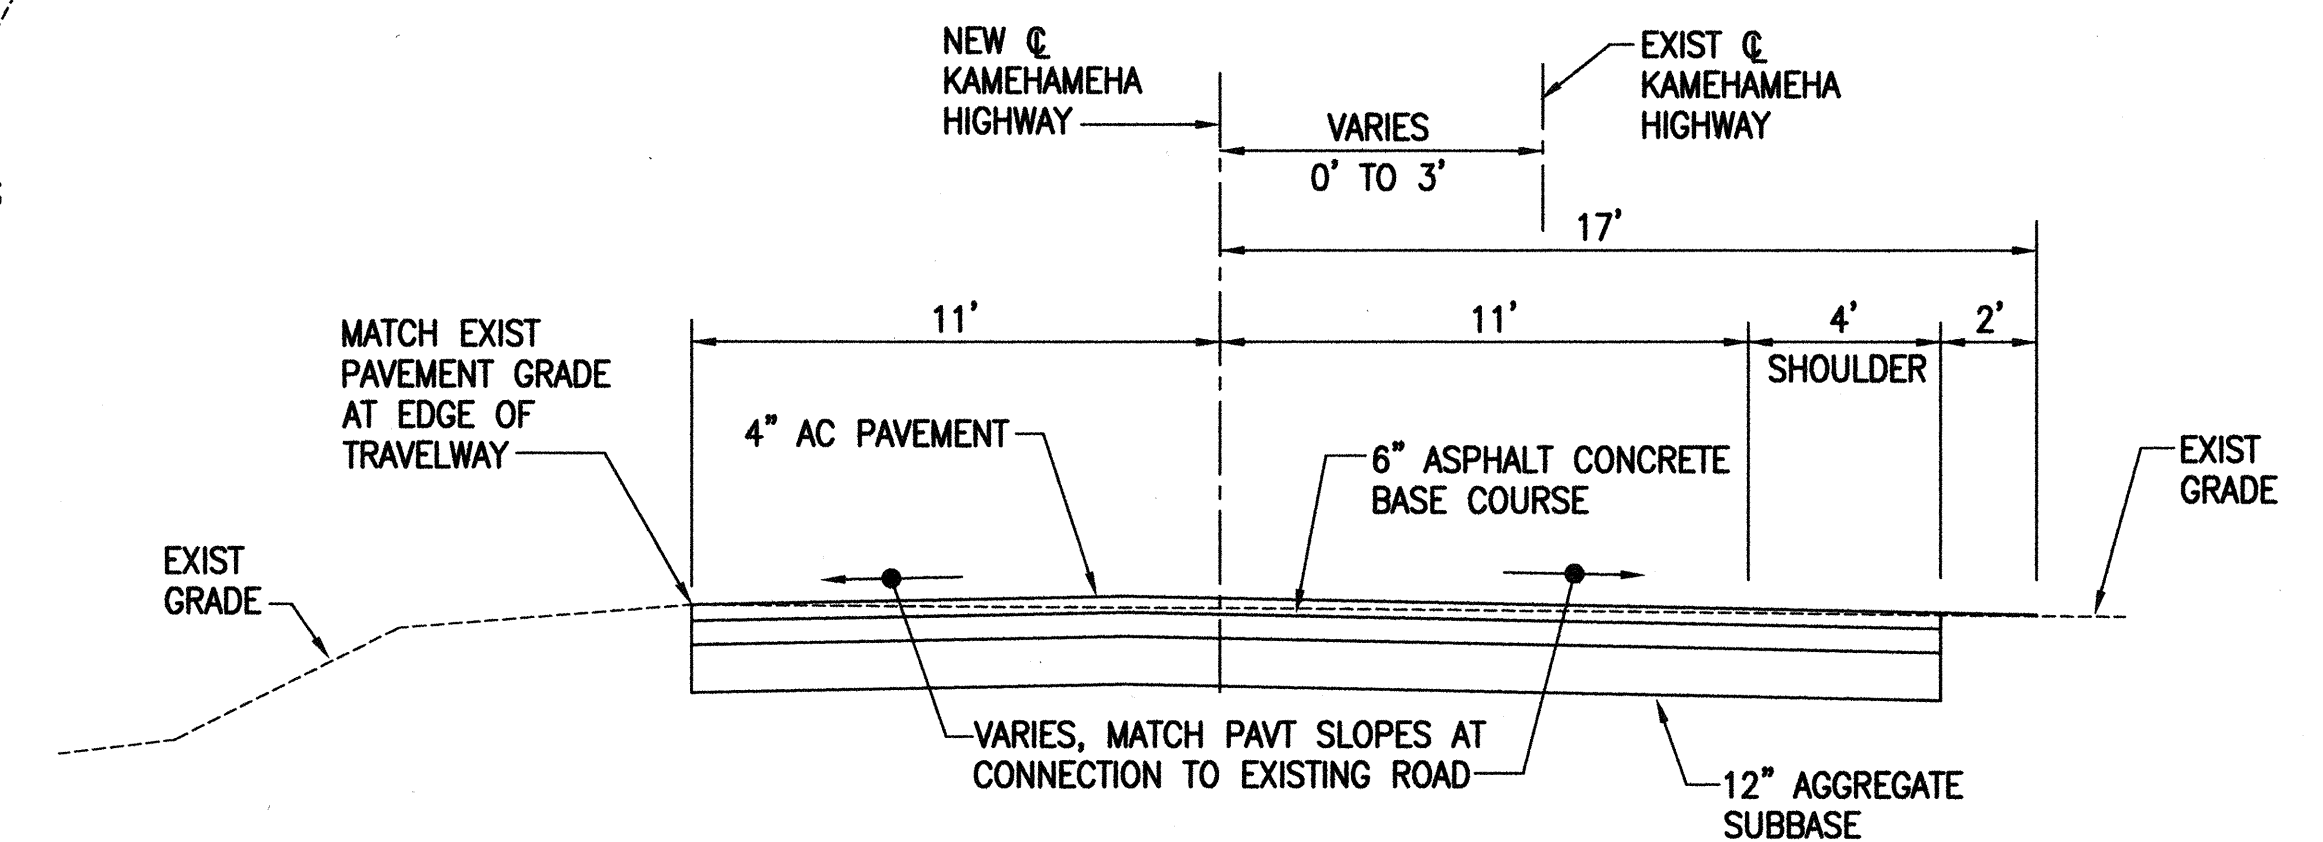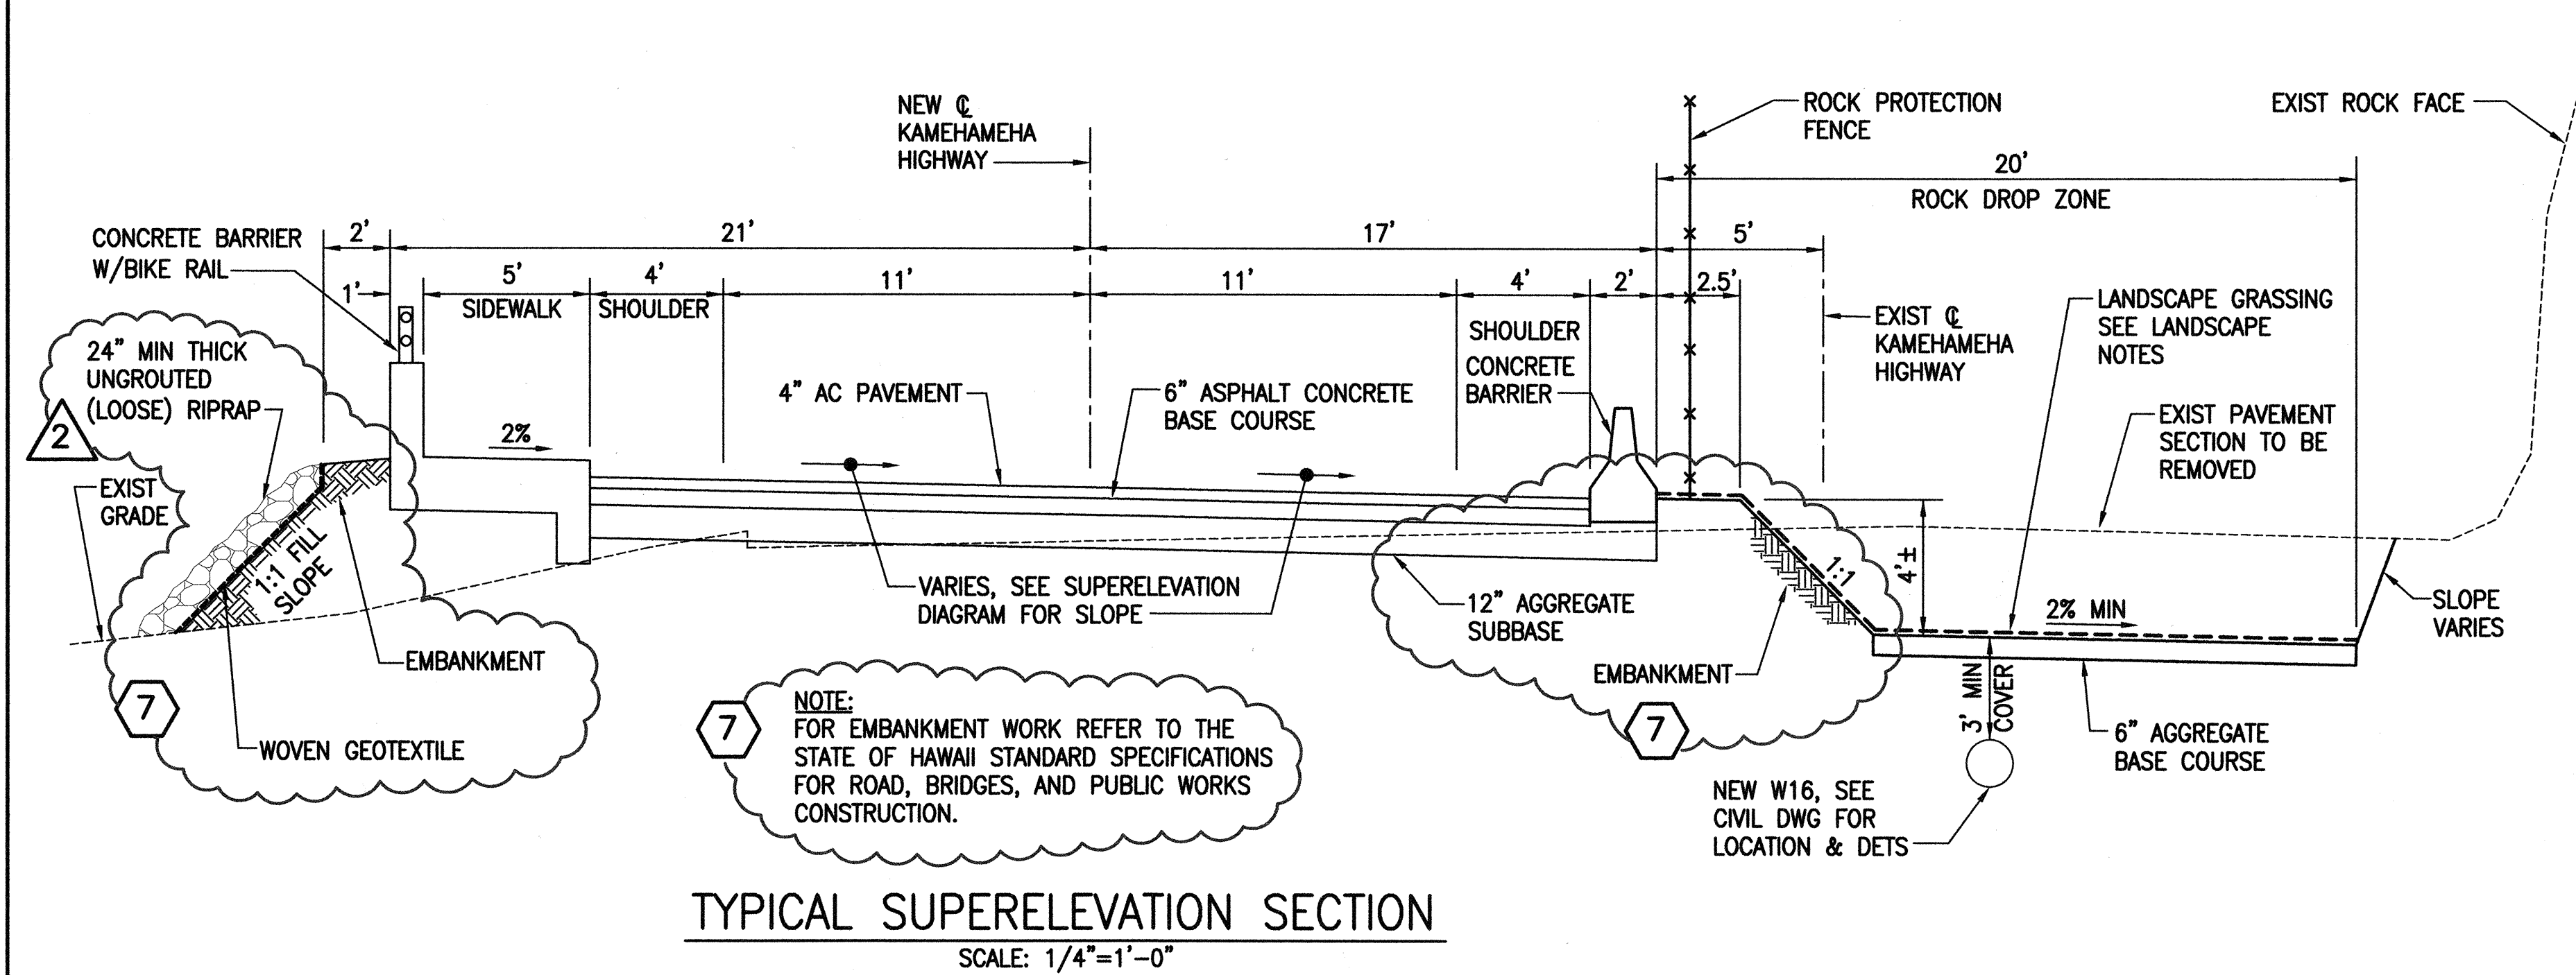

SURVEY PLOTTED BY	DATE
DRAWN BY	
DESIGNED BY	
QUANTITIES BY	
CHECKED BY	
ORIGINAL PLAN	
NOTE BOOK	
No.	

5-22-00	REVISION	7
4-7-00	ADDENDUM	2
DATE	REVISION	

EARTH TECH
700 Bishop Street, Suite 900
Honolulu, HI 96813

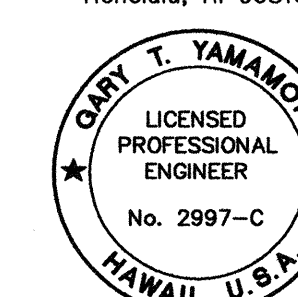

THIS WORK WAS PREPARED BY ME OR UNDER MY SUPERVISION.

STATE OF HAWAII
DEPARTMENT OF TRANSPORTATION
HIGHWAYS DIVISION

TYPICAL CROSS SECTION

**KAMEHAMEHA HIGHWAY
WAIMEA BAY
EMERGENCY ROCKFALL REMEDIATION**

FEDERAL-AID PROJECT NO. STP-083-1(45)
Scale: As Shown Date: April 2000

SHEET No. 5 OF 39 SHEETS

"AS-BUILT"

C.O. ADD. 5