




FED. ROAD DIST. NO.	STATE	FED. AID PROJ. NO.	FISCAL YEAR	SHEET NO.	TOTAL SHEETS
HAWAII	HAWAII	NH-083-1(49)	2003	C.O. 21	78

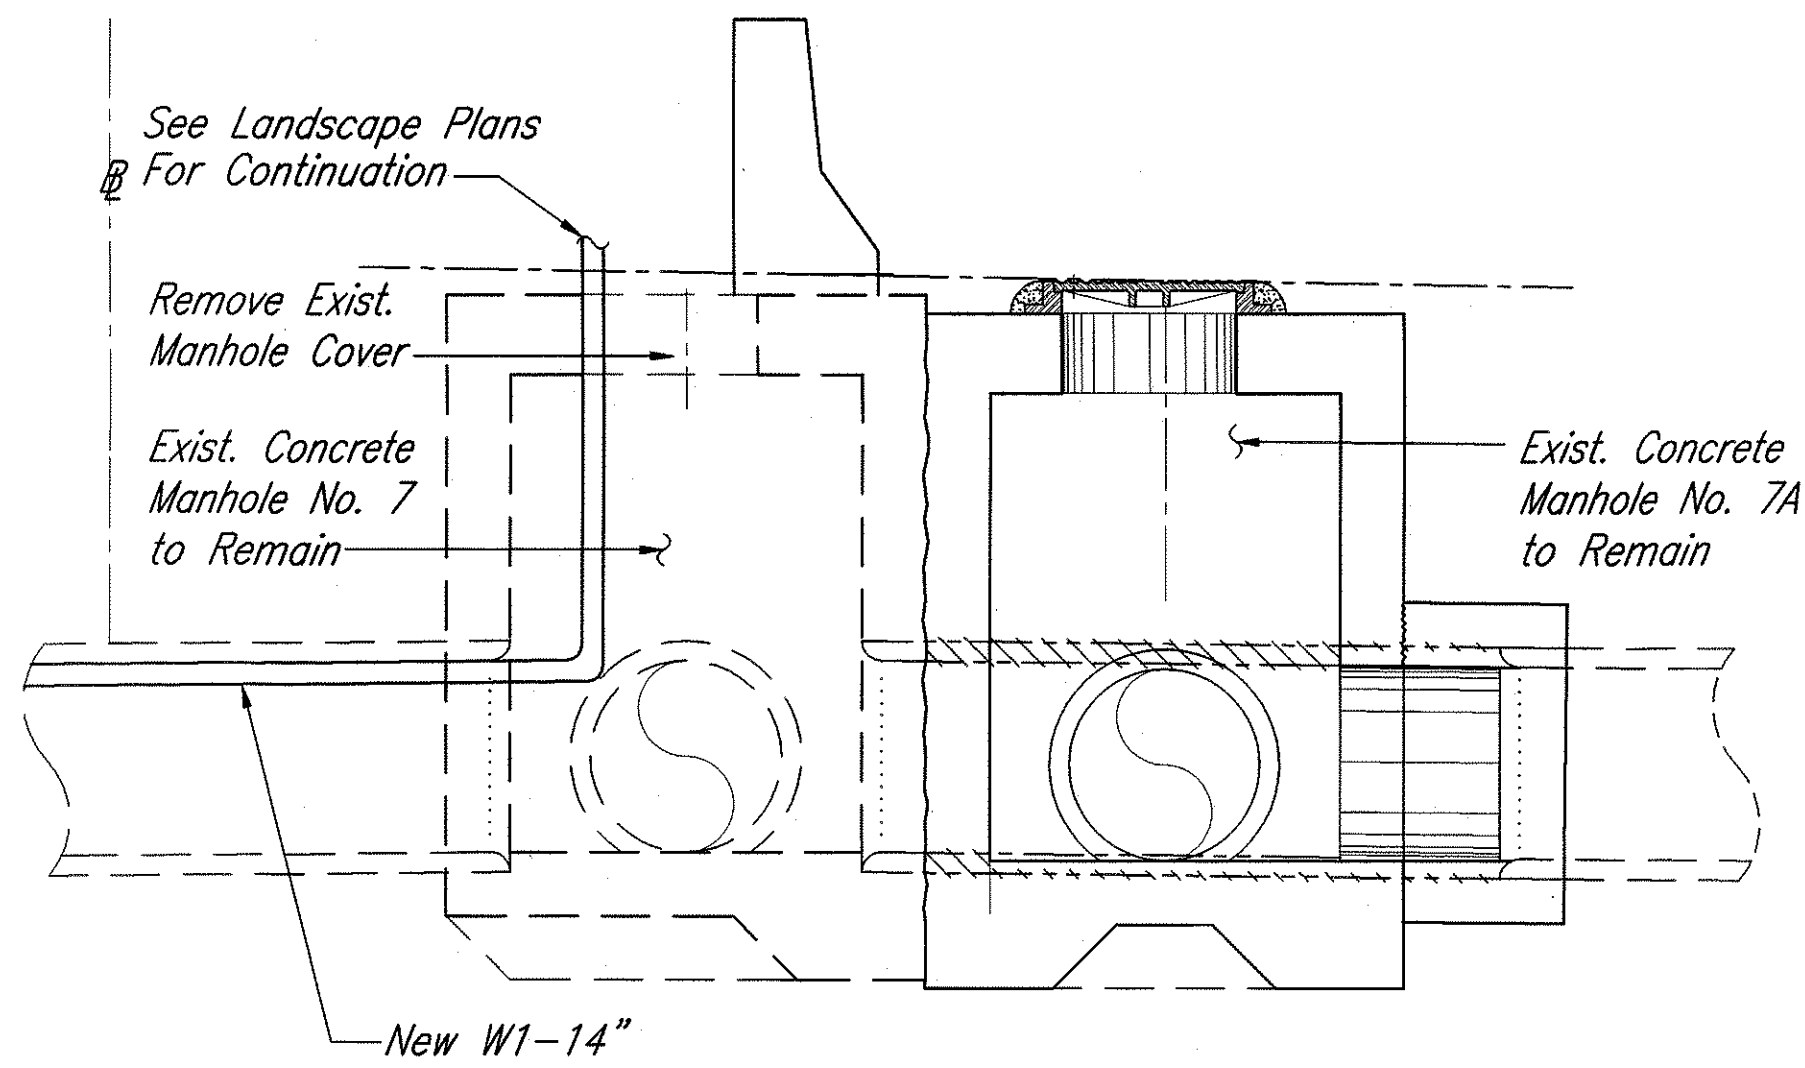


Elevation

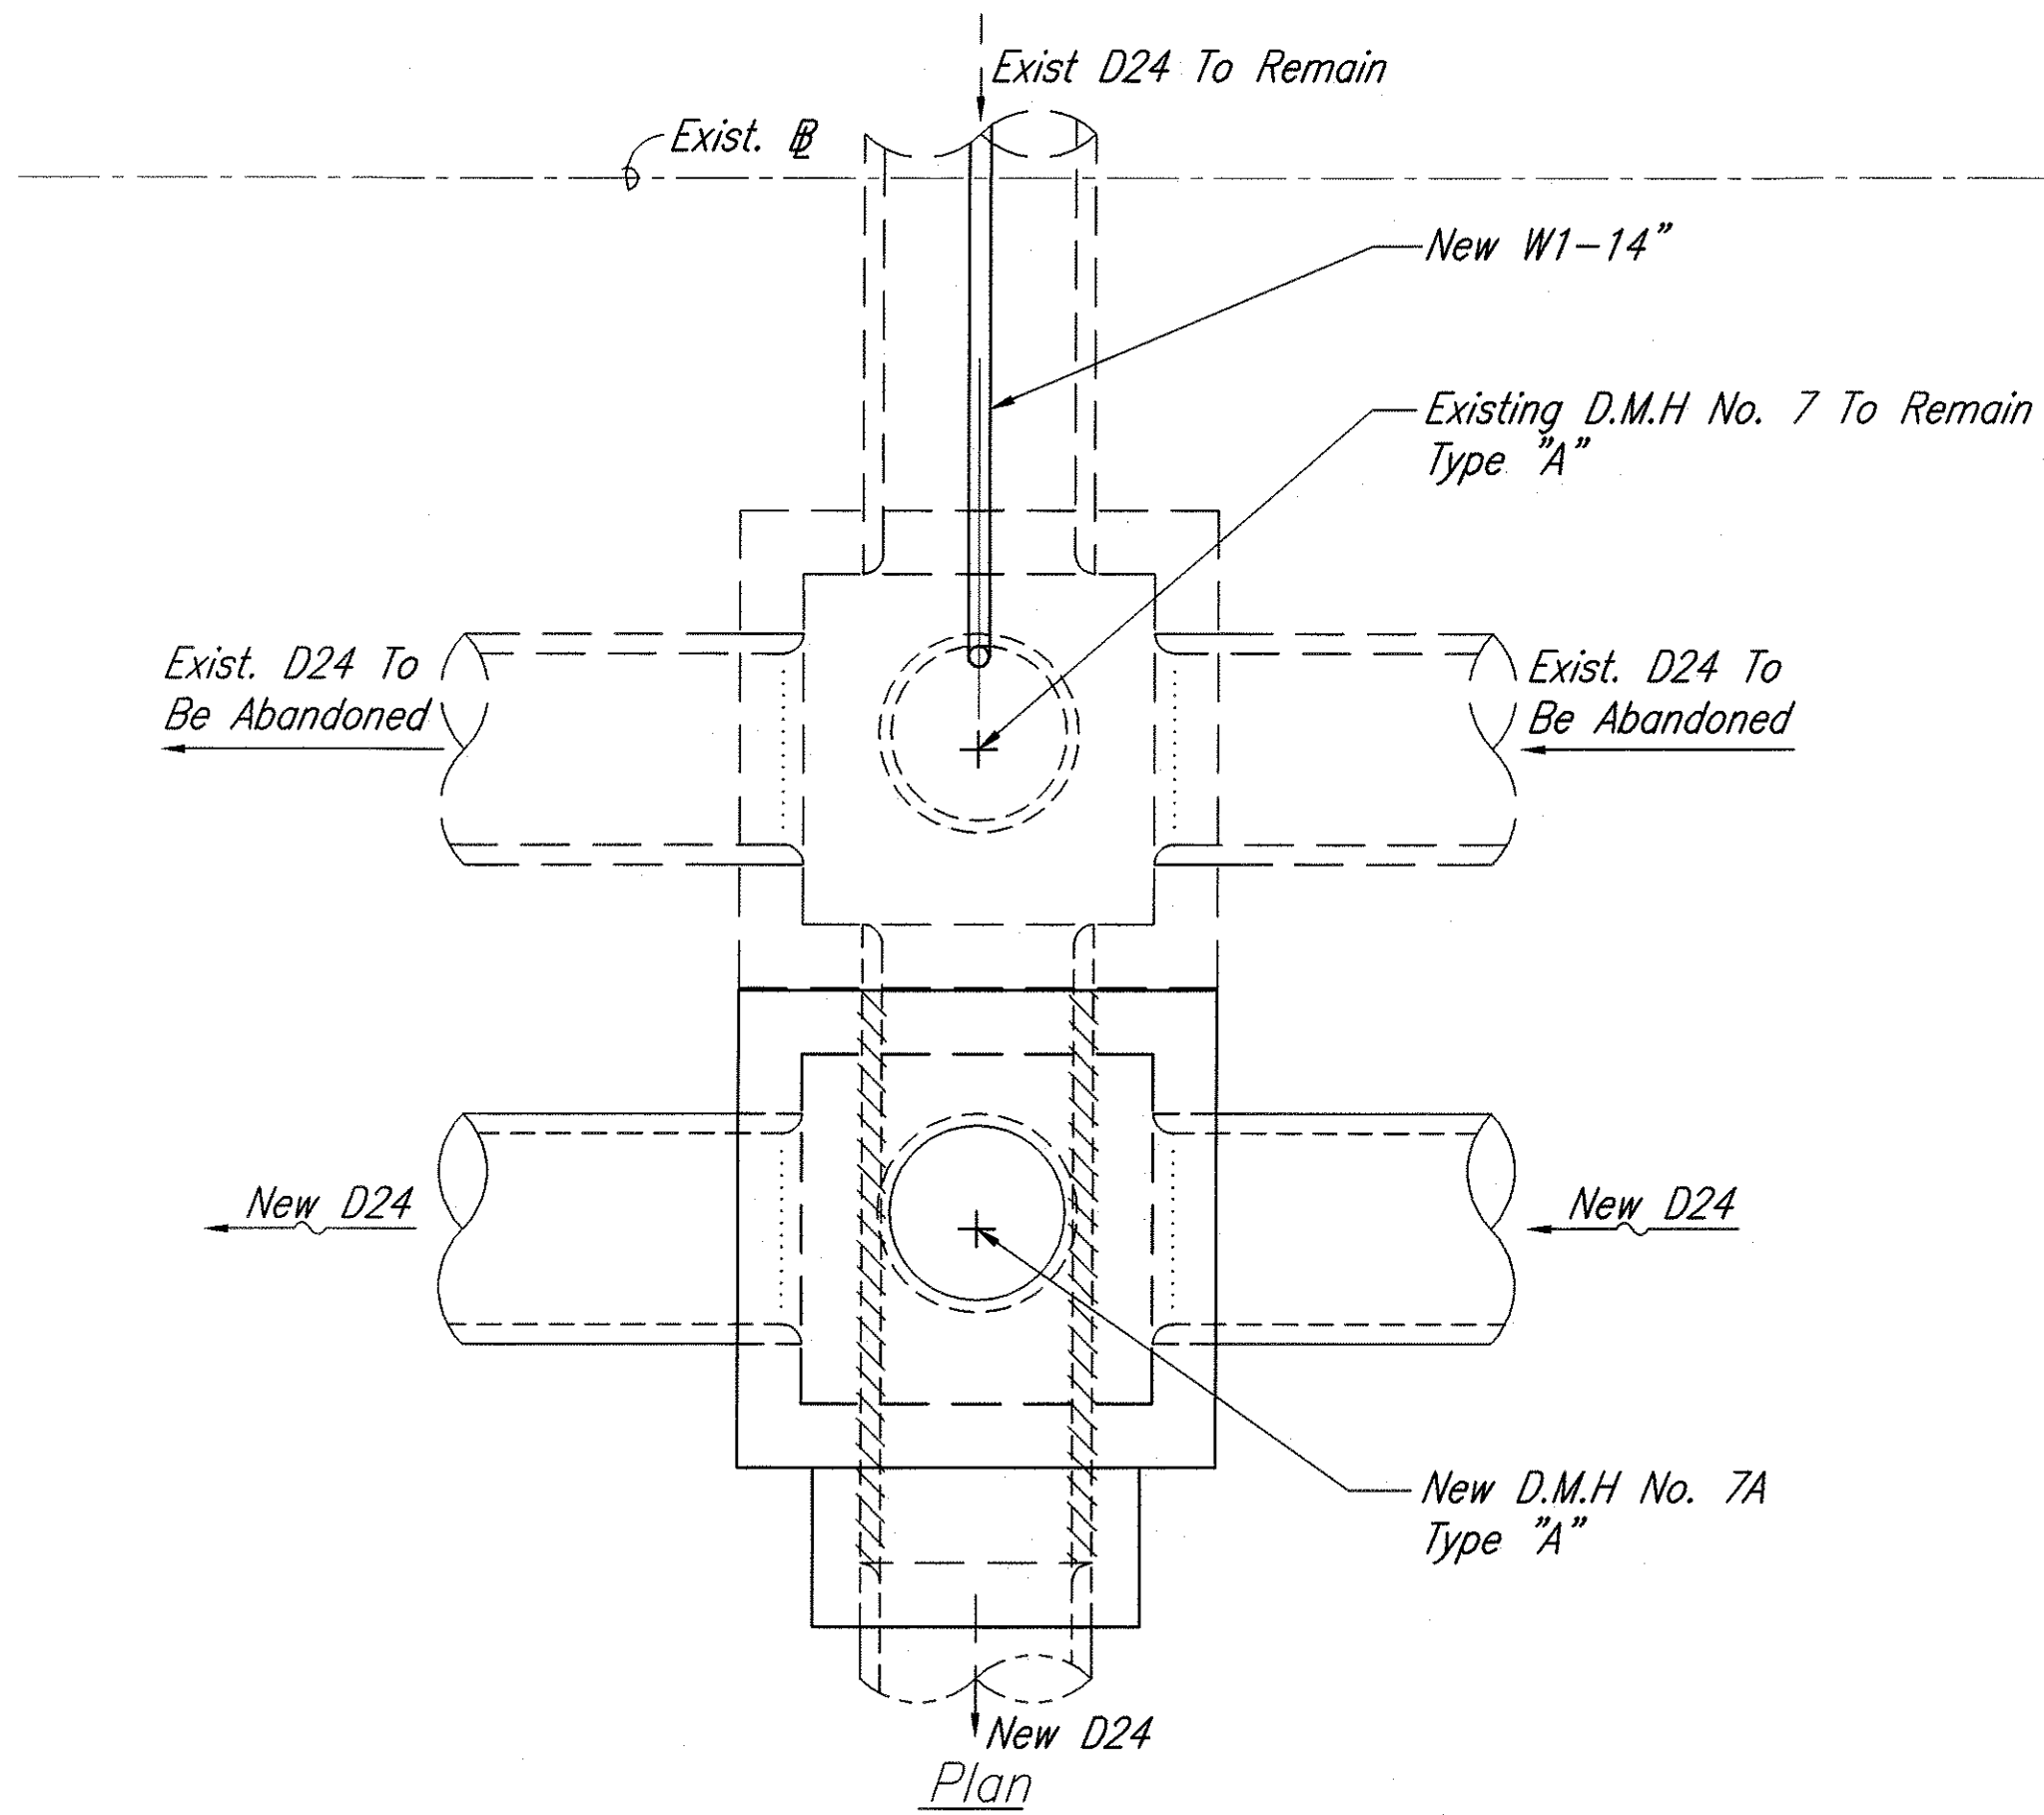


IRRIGATION LINE THROUGH DRAIN MANHOLE 7
Scale: 1/2" = 1'-0"

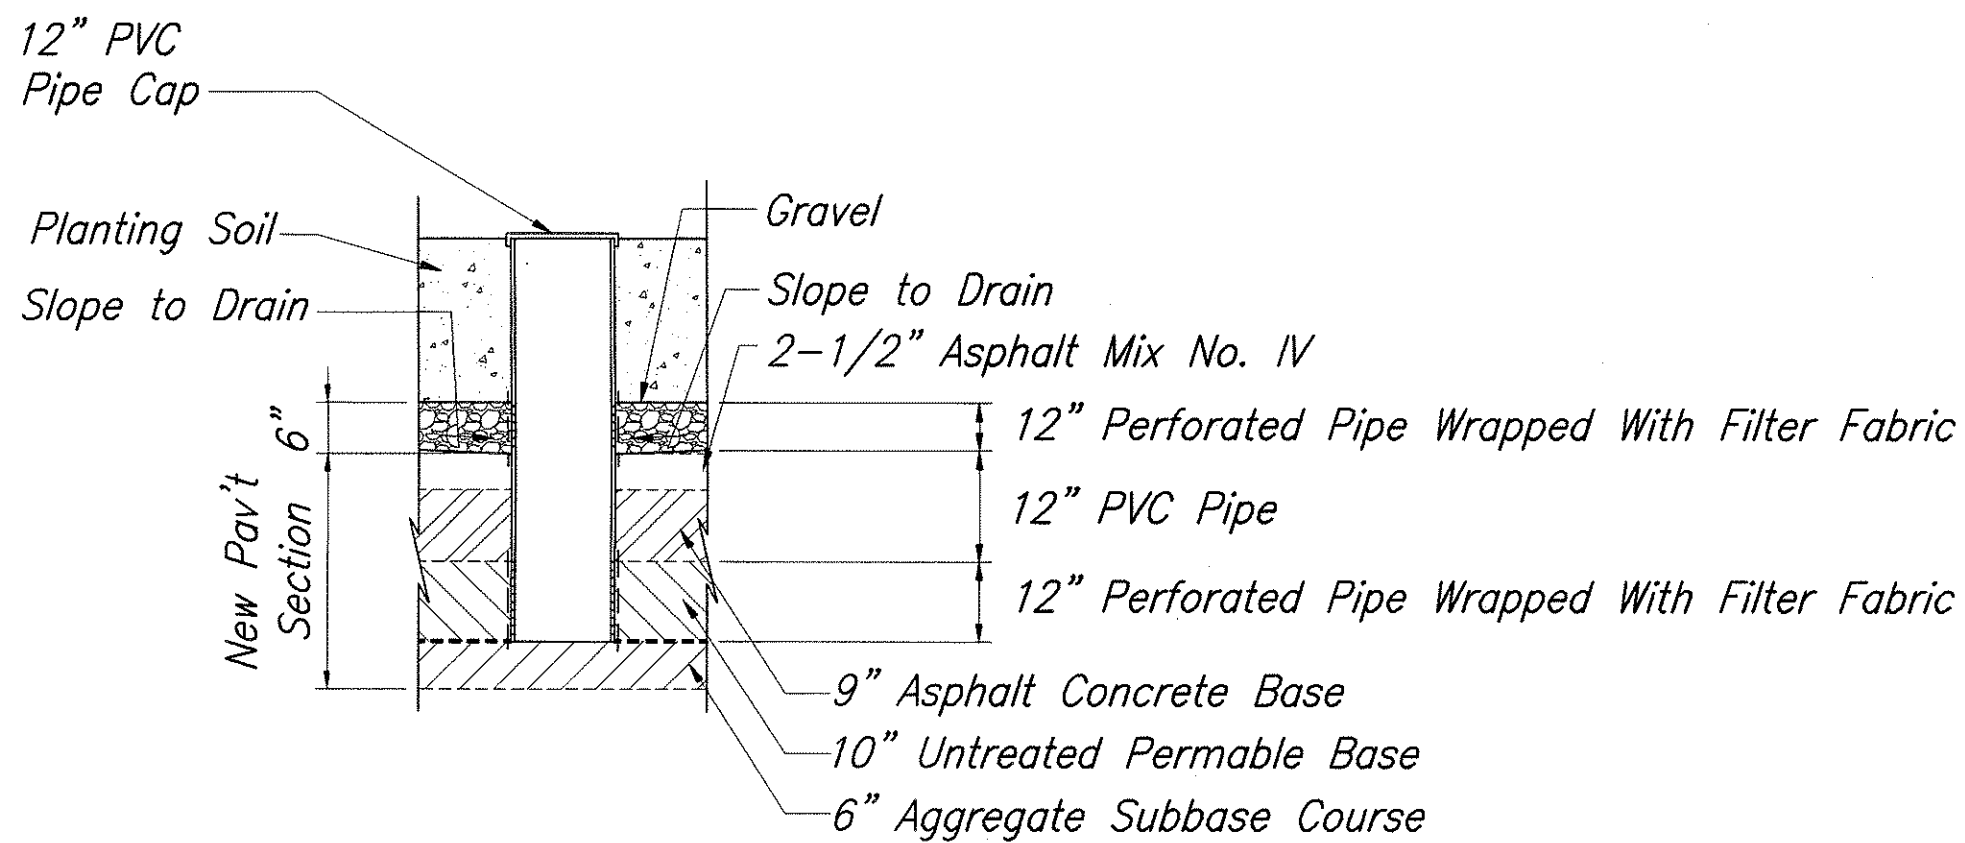


MEDIAN DRAIN DETAIL
Scale: 1/2" = 1'-0"

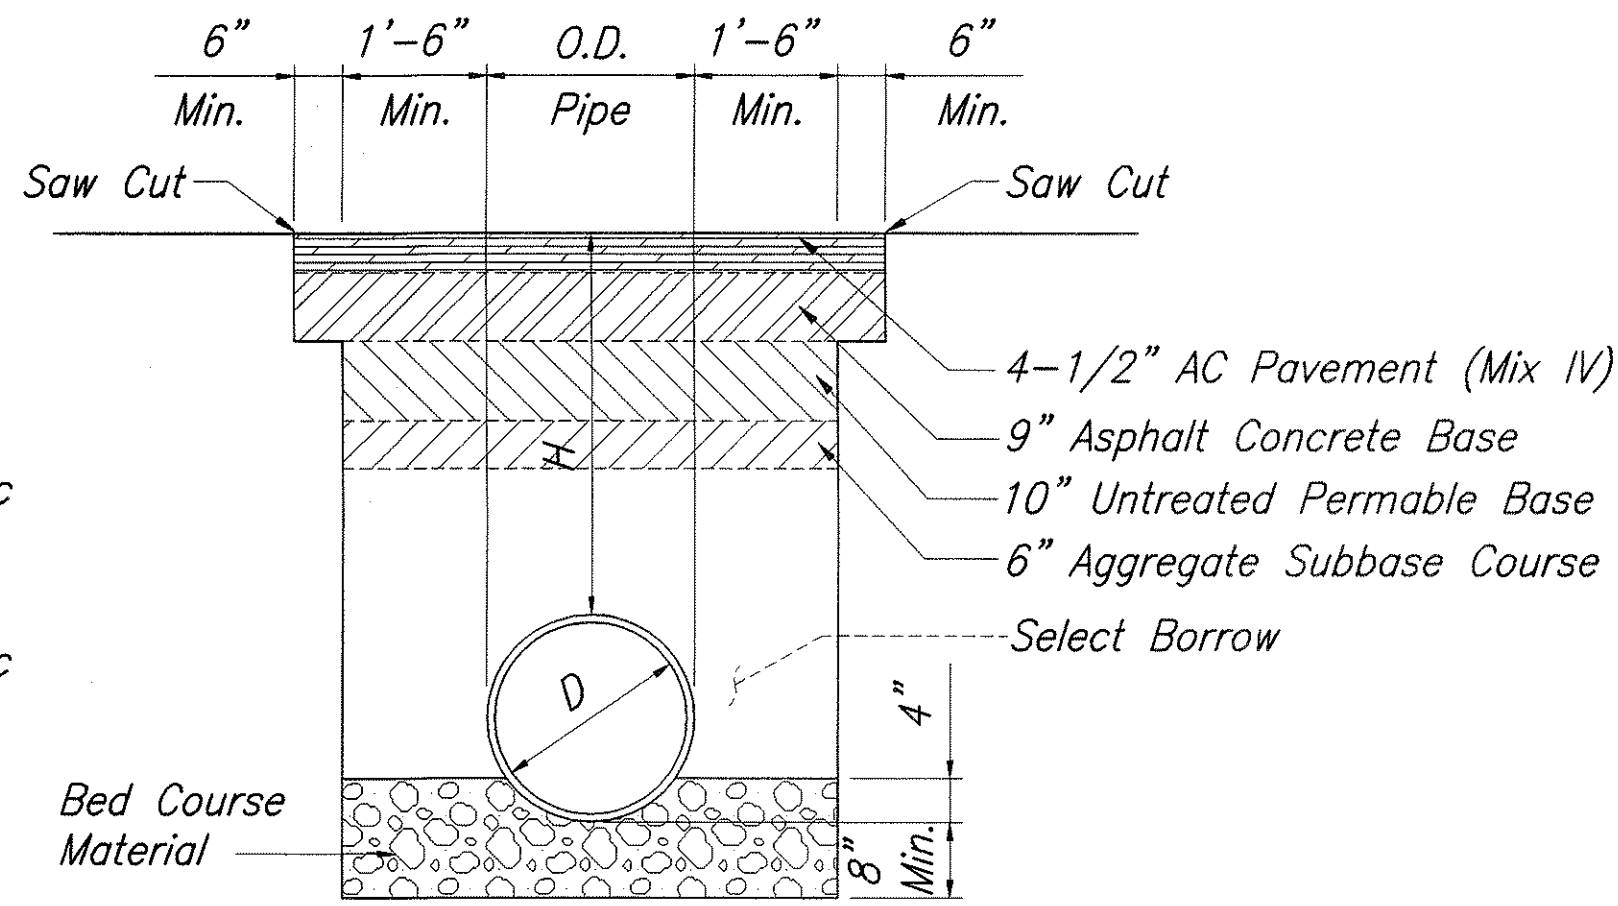

TYP. TRENCH FOR DRAIN PIPES
NOT TO SCALE

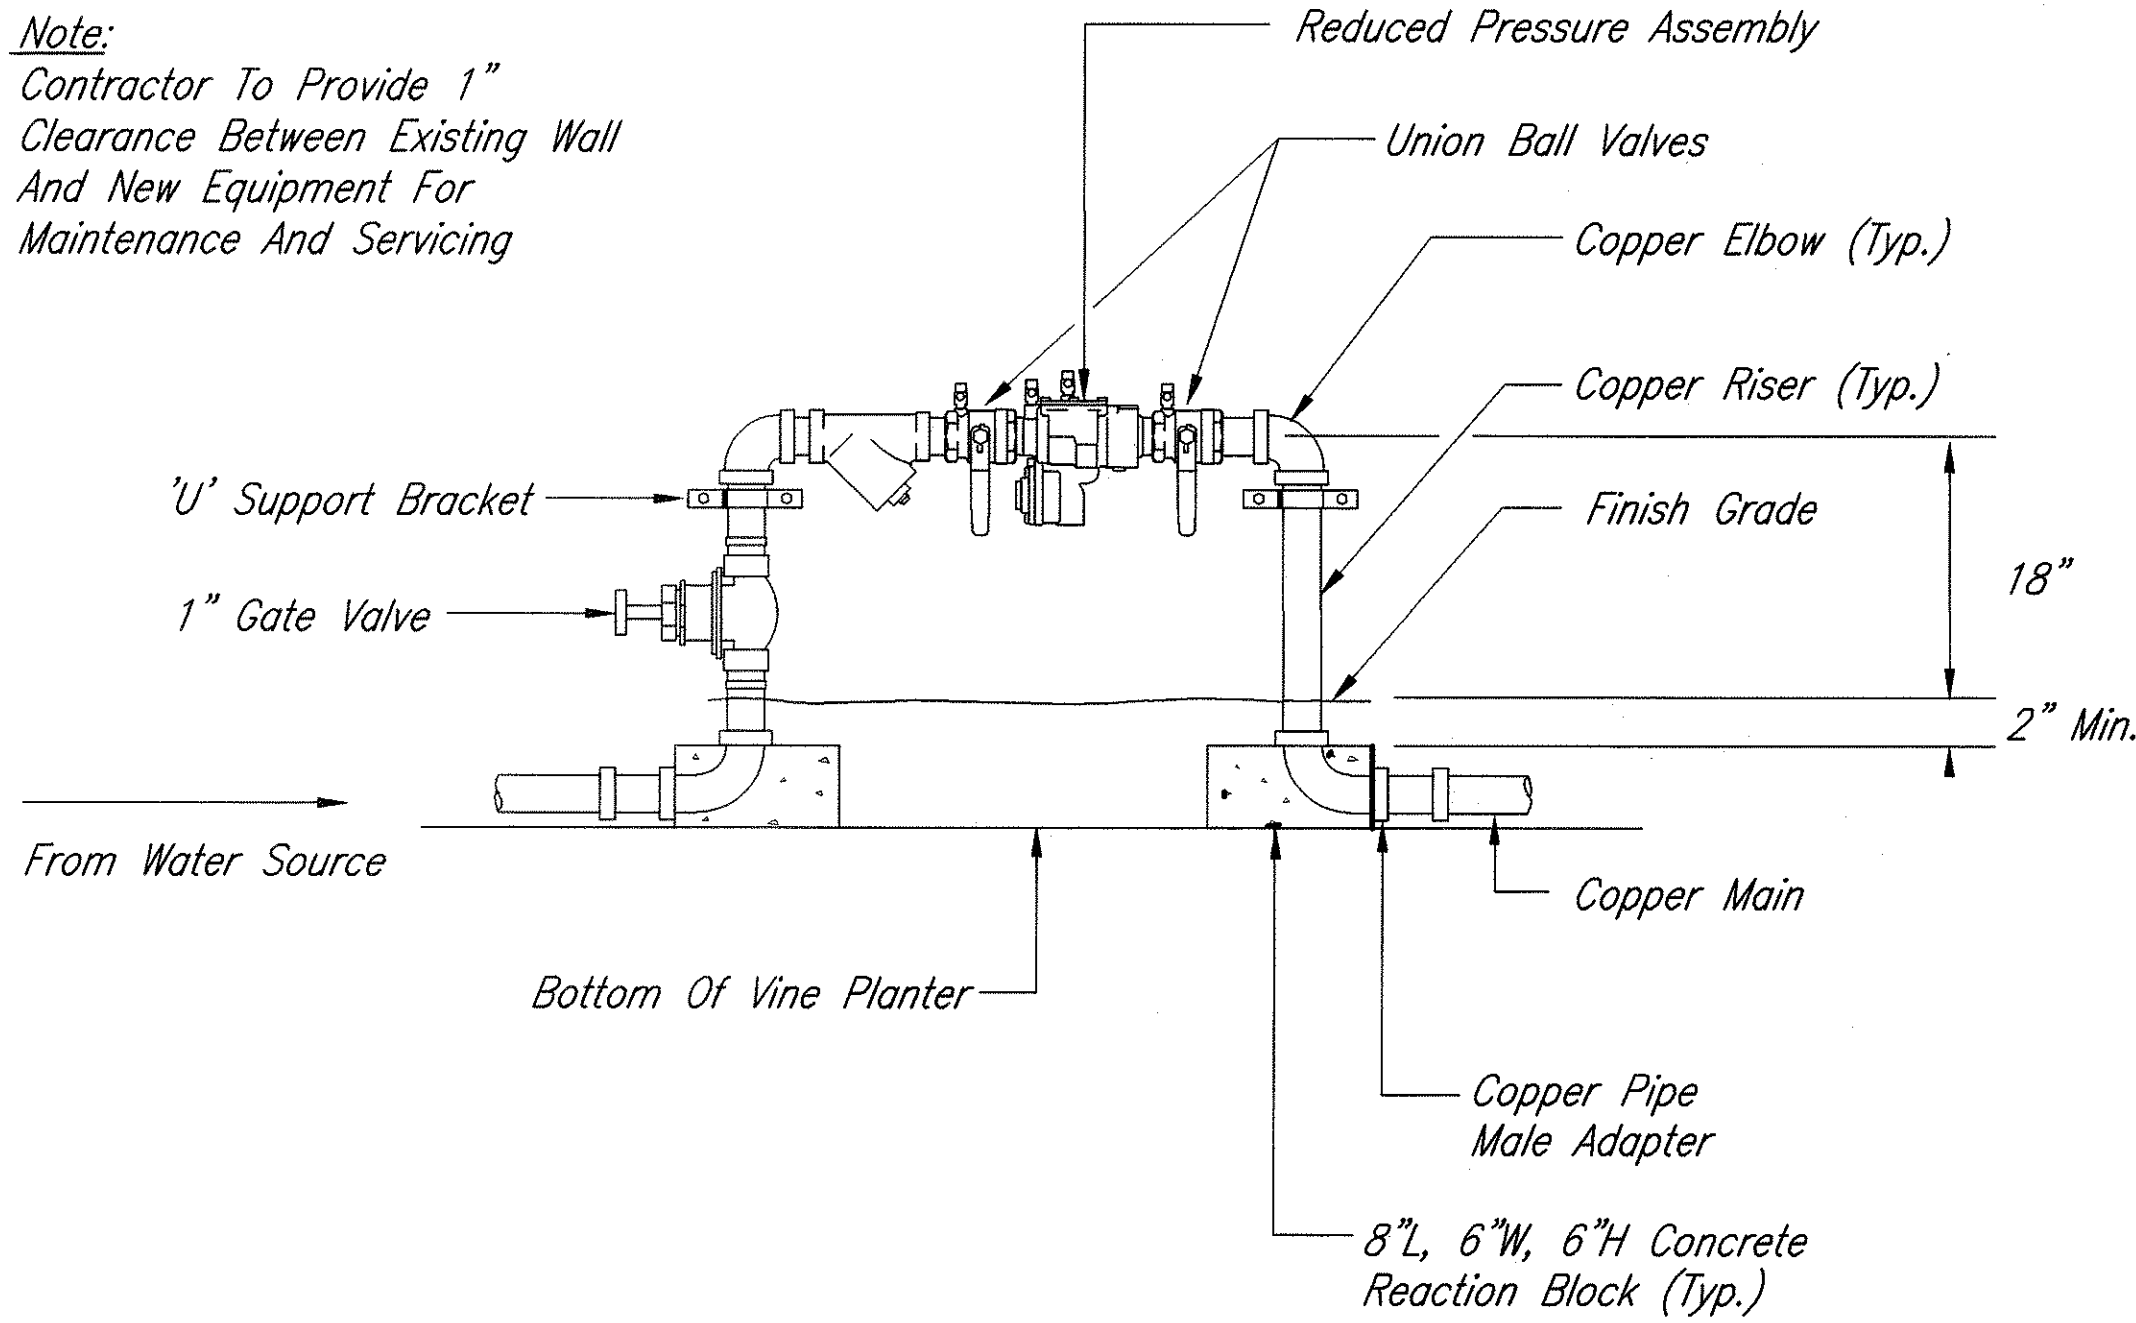


1 REDUCED PRESSURE BACKFLOW PREVENTER ASSEMBLY AND GATE VALVE
NOT TO SCALE

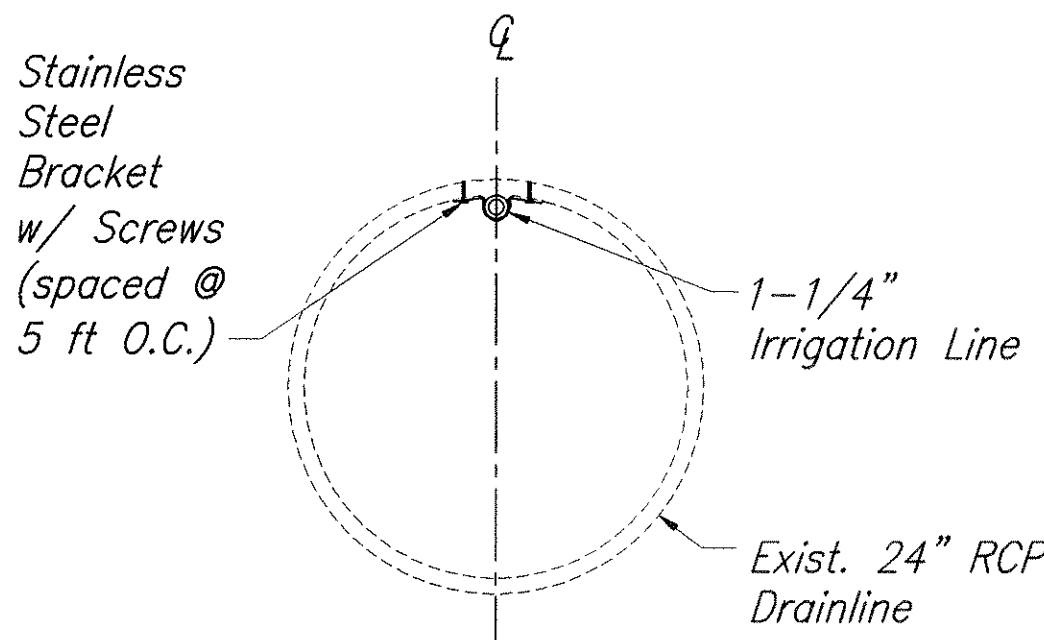

IRRIGATION LINE IN DRAINLINE DETAIL
Scale: 1" = 1'-0"


ORIGINAL PLAN	NO. 1
DESIGNED BY	J. BAQUILAR
CHECKED BY	E. IIDA
DATE	12/02
DESIGNED BY	J. BAQUILAR
CHECKED BY	E. IIDA
DATE	12/02

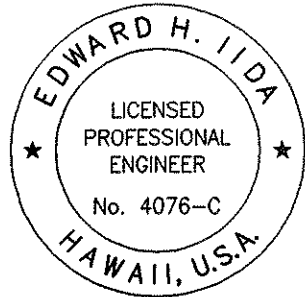


THIS WORK WAS PREPARED BY ME OR UNDER MY SUPERVISION
MITSUNAGA & ASSOCIATES

05/07/03	Deleted Backflow Preventer Box Details, Added Backflow Preventer Detail
DATE	REVISIONS
STATE OF HAWAII DEPARTMENT OF TRANSPORTATION HIGHWAYS DIVISION	
MISCELLANEOUS DETAILS - 1	
KAHEKILI HIGHWAY LANDSCAPING Kulukeoe Street to Vicinity of Haiku Road Federal Aid Project No. NH-083-1(49) Scale: As Noted Date: Apr. 2002	
SHEET No. 1 OF 2 SHEETS	


FED. ROAD DIST. NO.	STATE	FED. AID PROJ. NO.	FISCAL YEAR	SHEET NO.	TOTAL SHEETS
HAWAII	HAWAII	NH-083-1(49)	2003	22	78

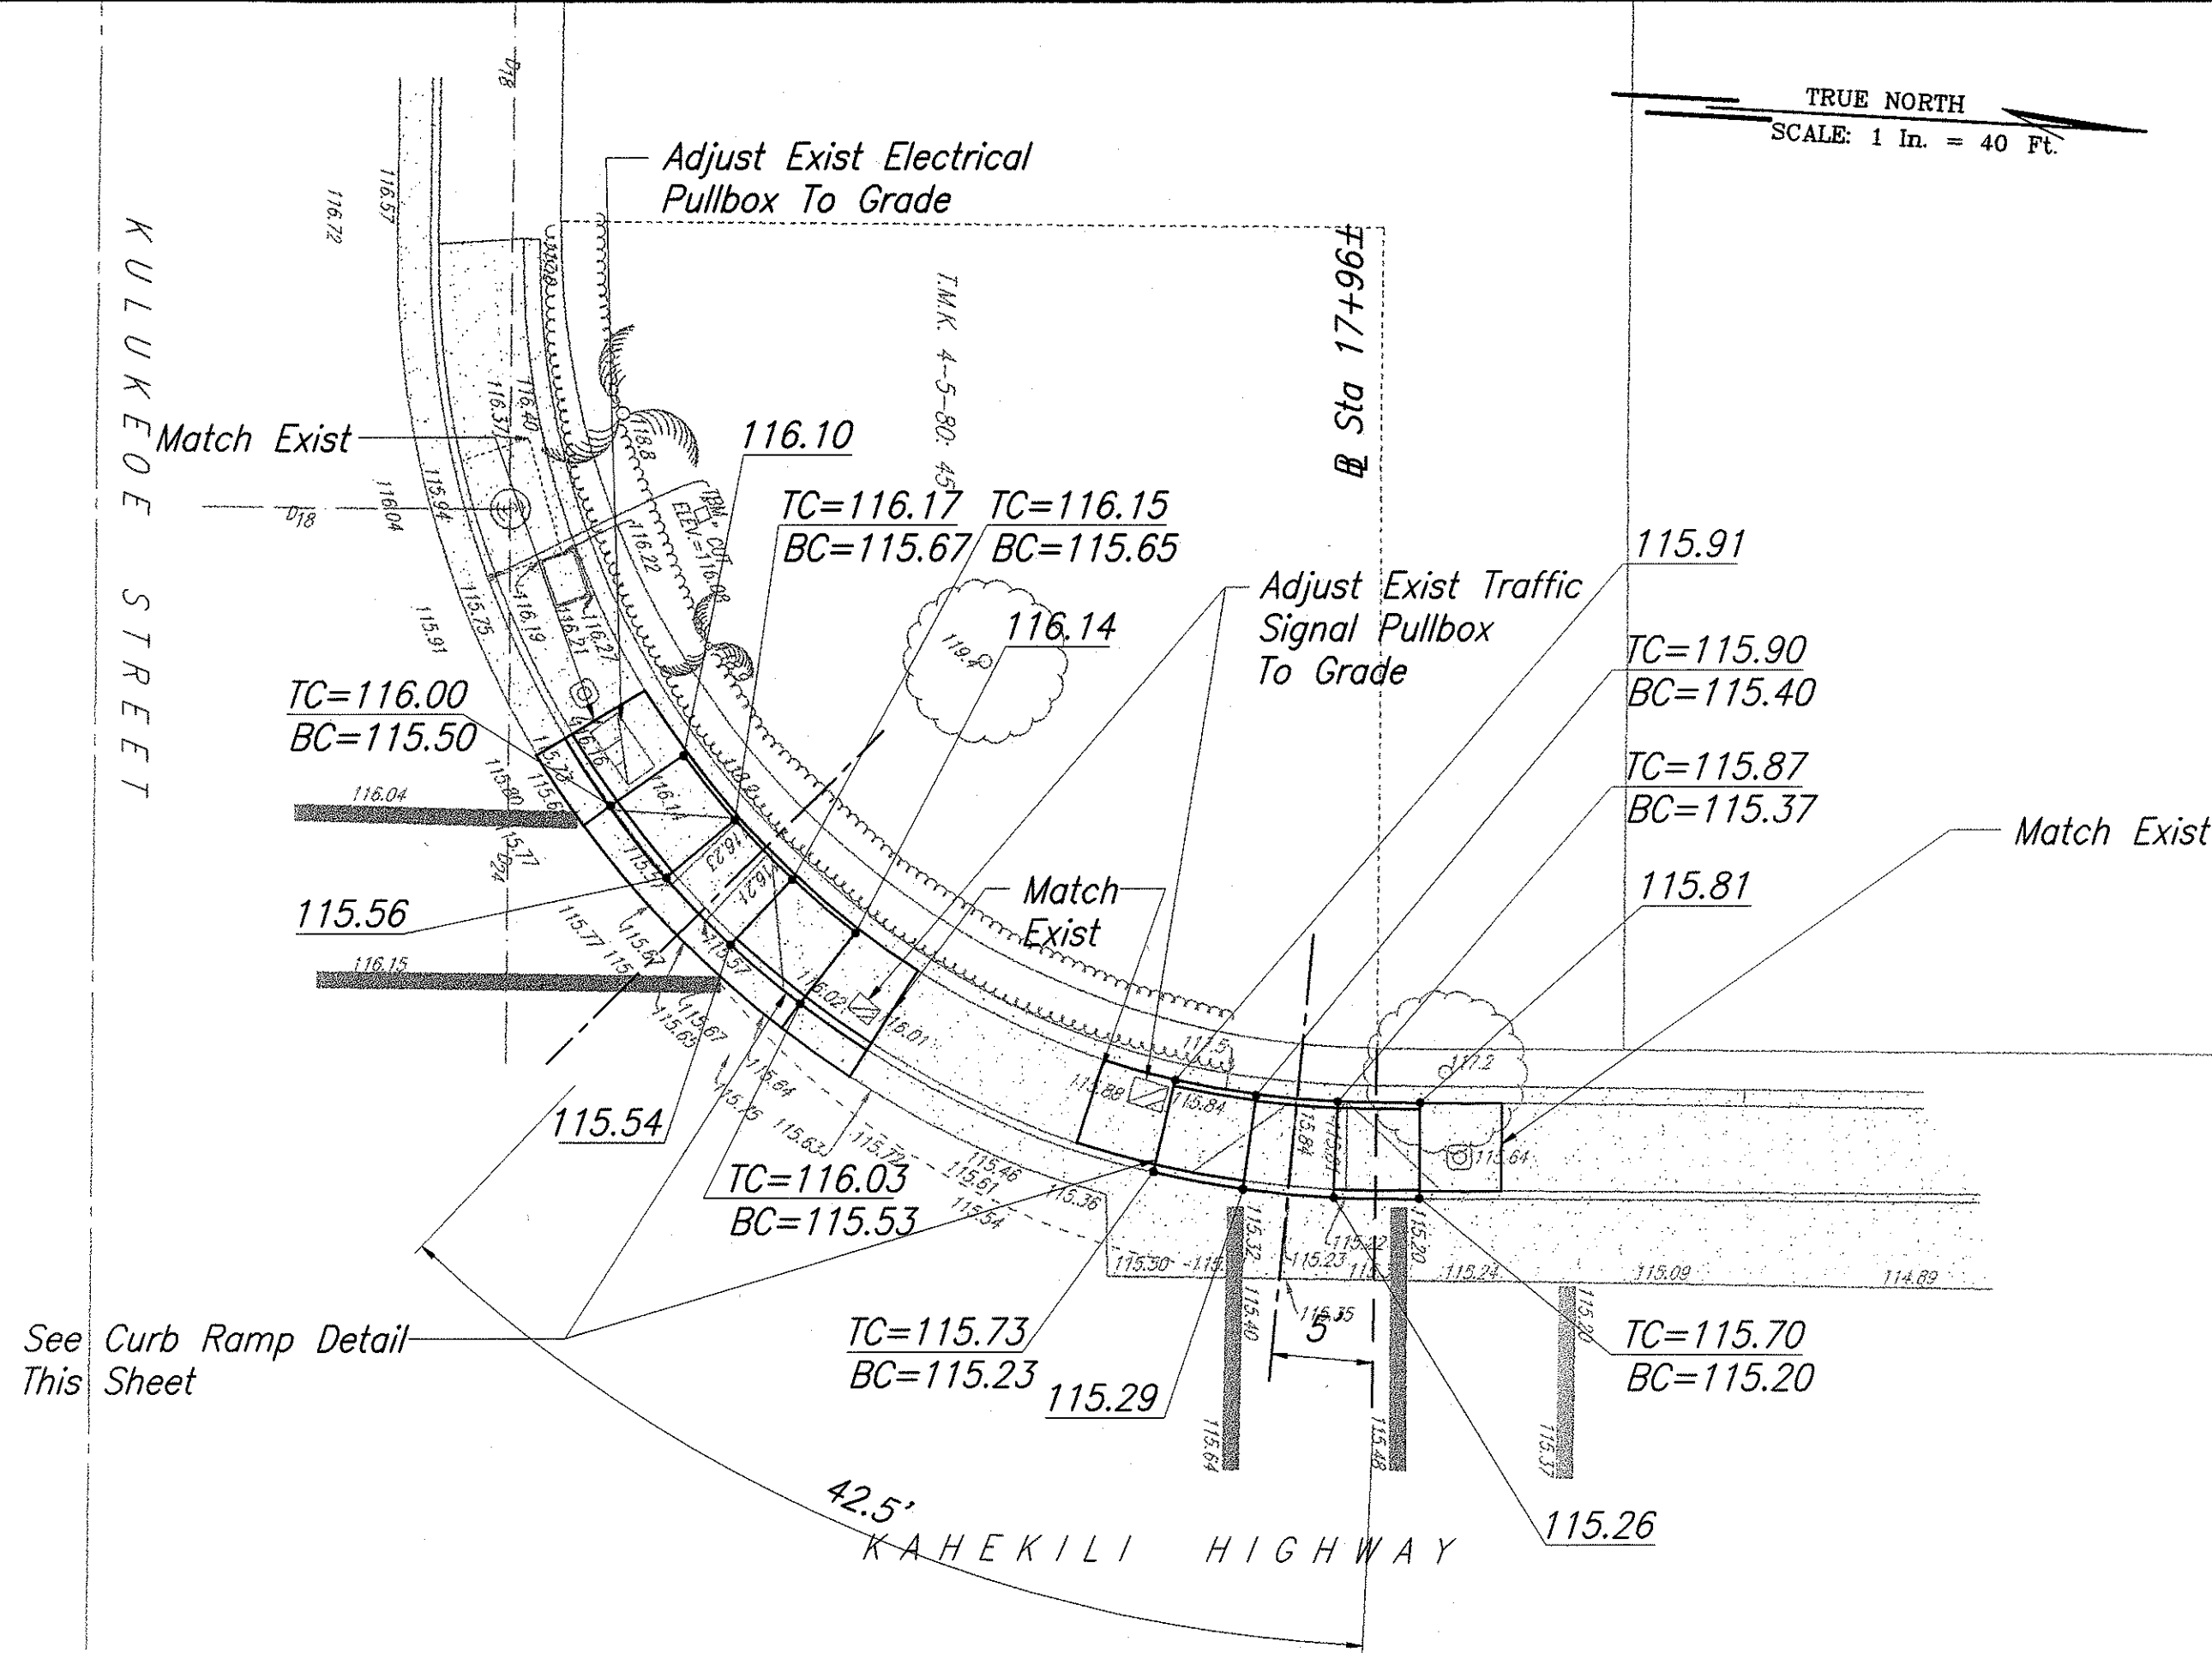

CURB RAMP PLAN
Scale: 1" = 10'

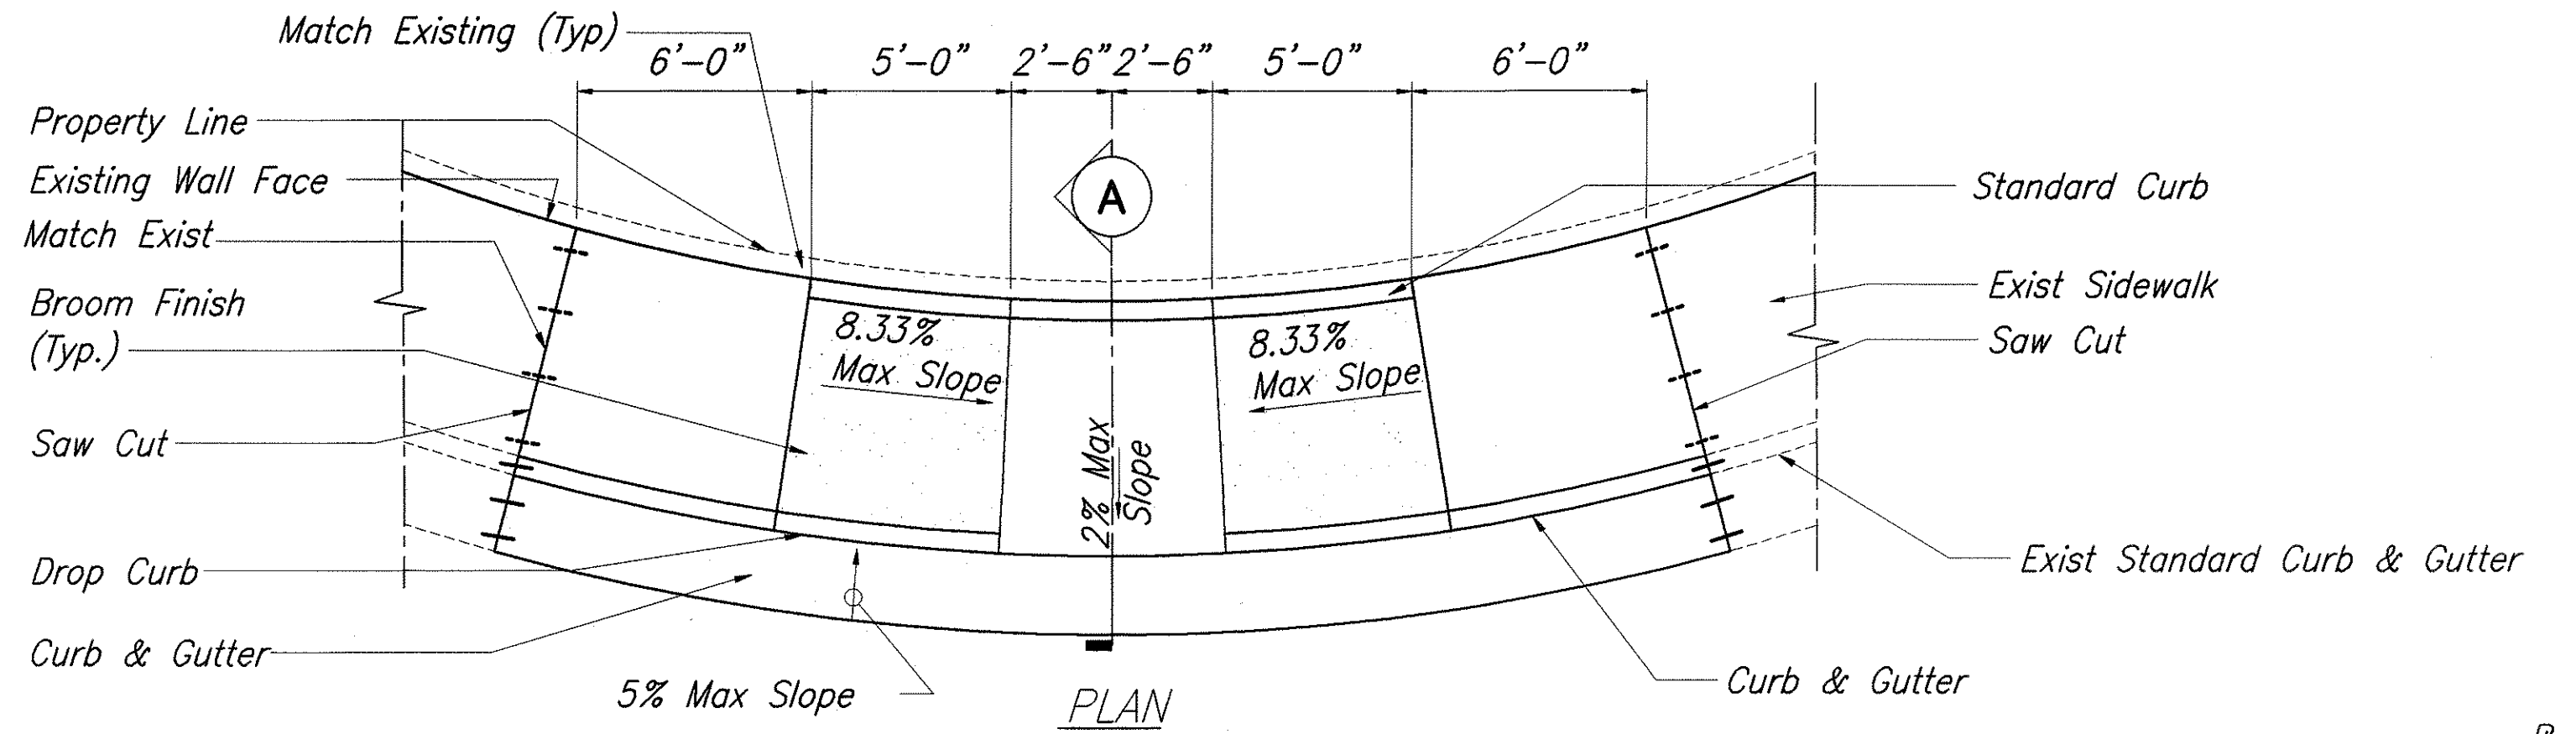


PLAN

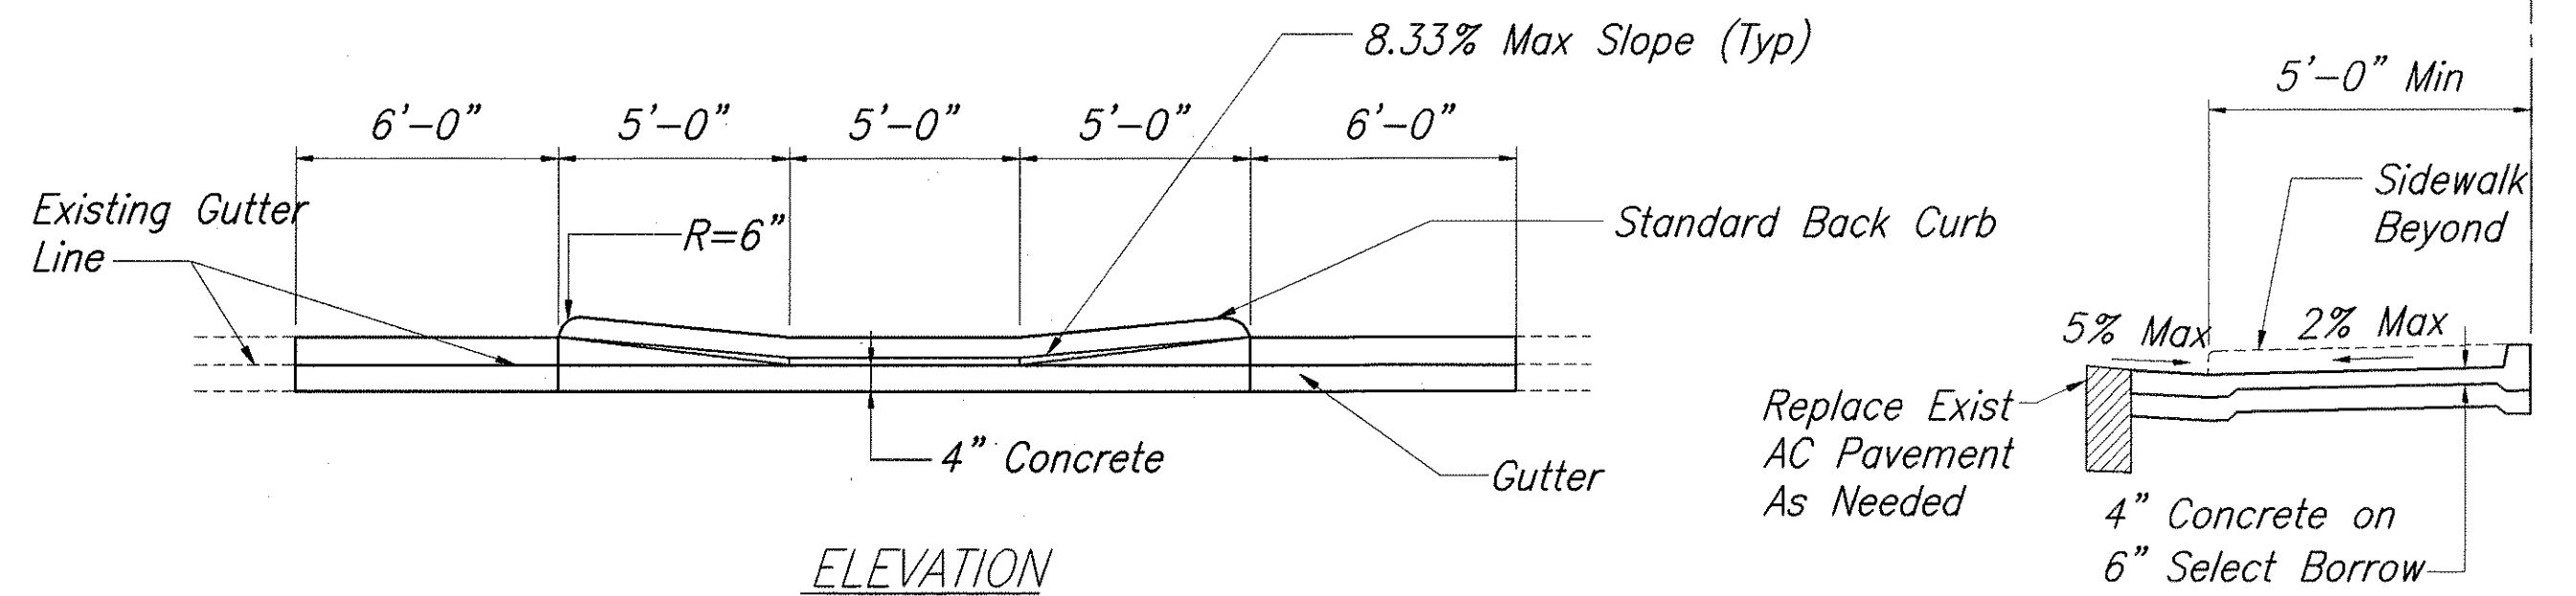


ELEVATION

CURB RAMP DETAIL
Scale: 1/4" = 1'-0"


SECTION A-A

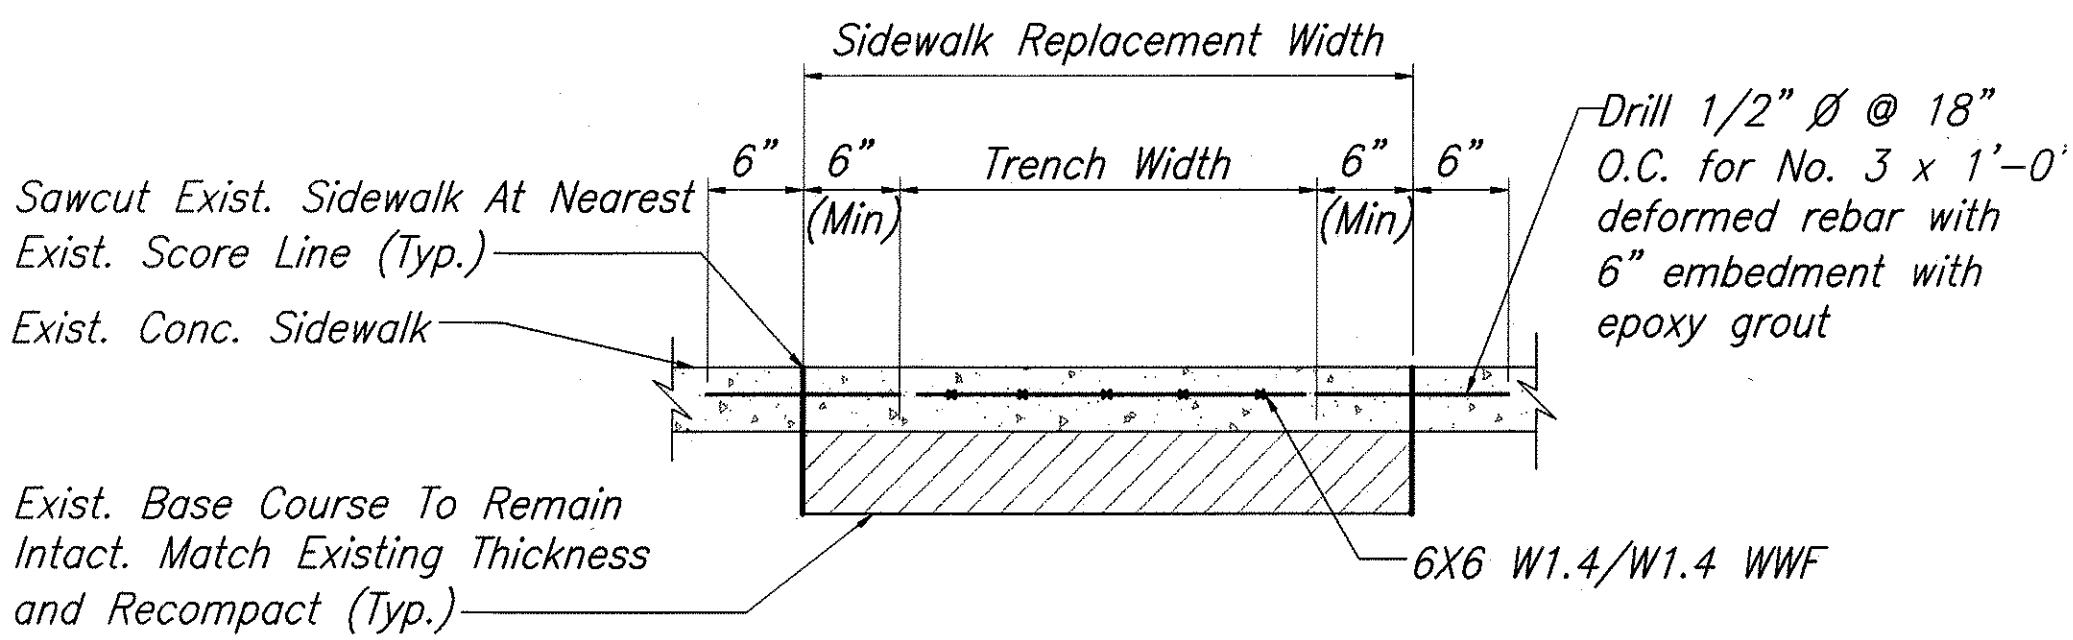

CONC. SIDEWALK RESTORATION
Scale: 1" = 1'-0"

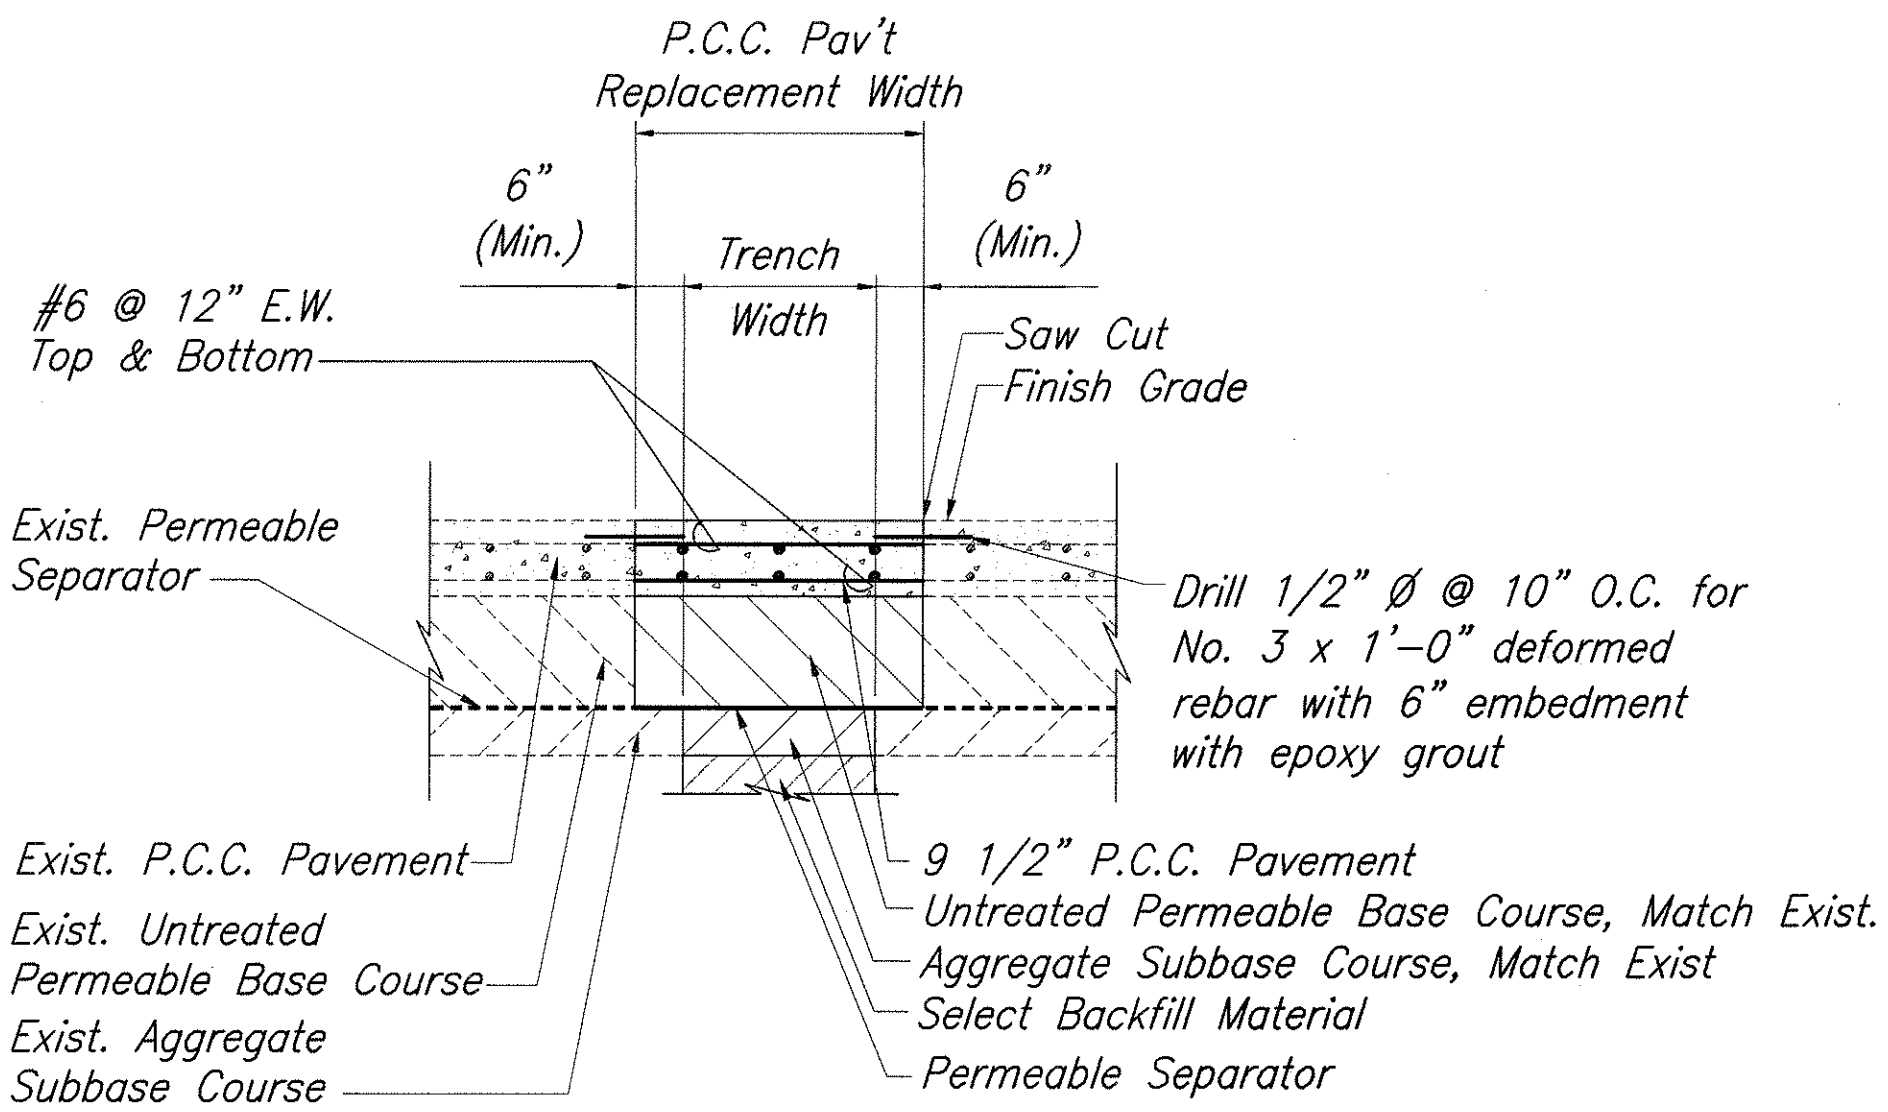


REINFORCED CONCRETE RESTORATION DETAIL
Scale: 1/2" = 1'-0"

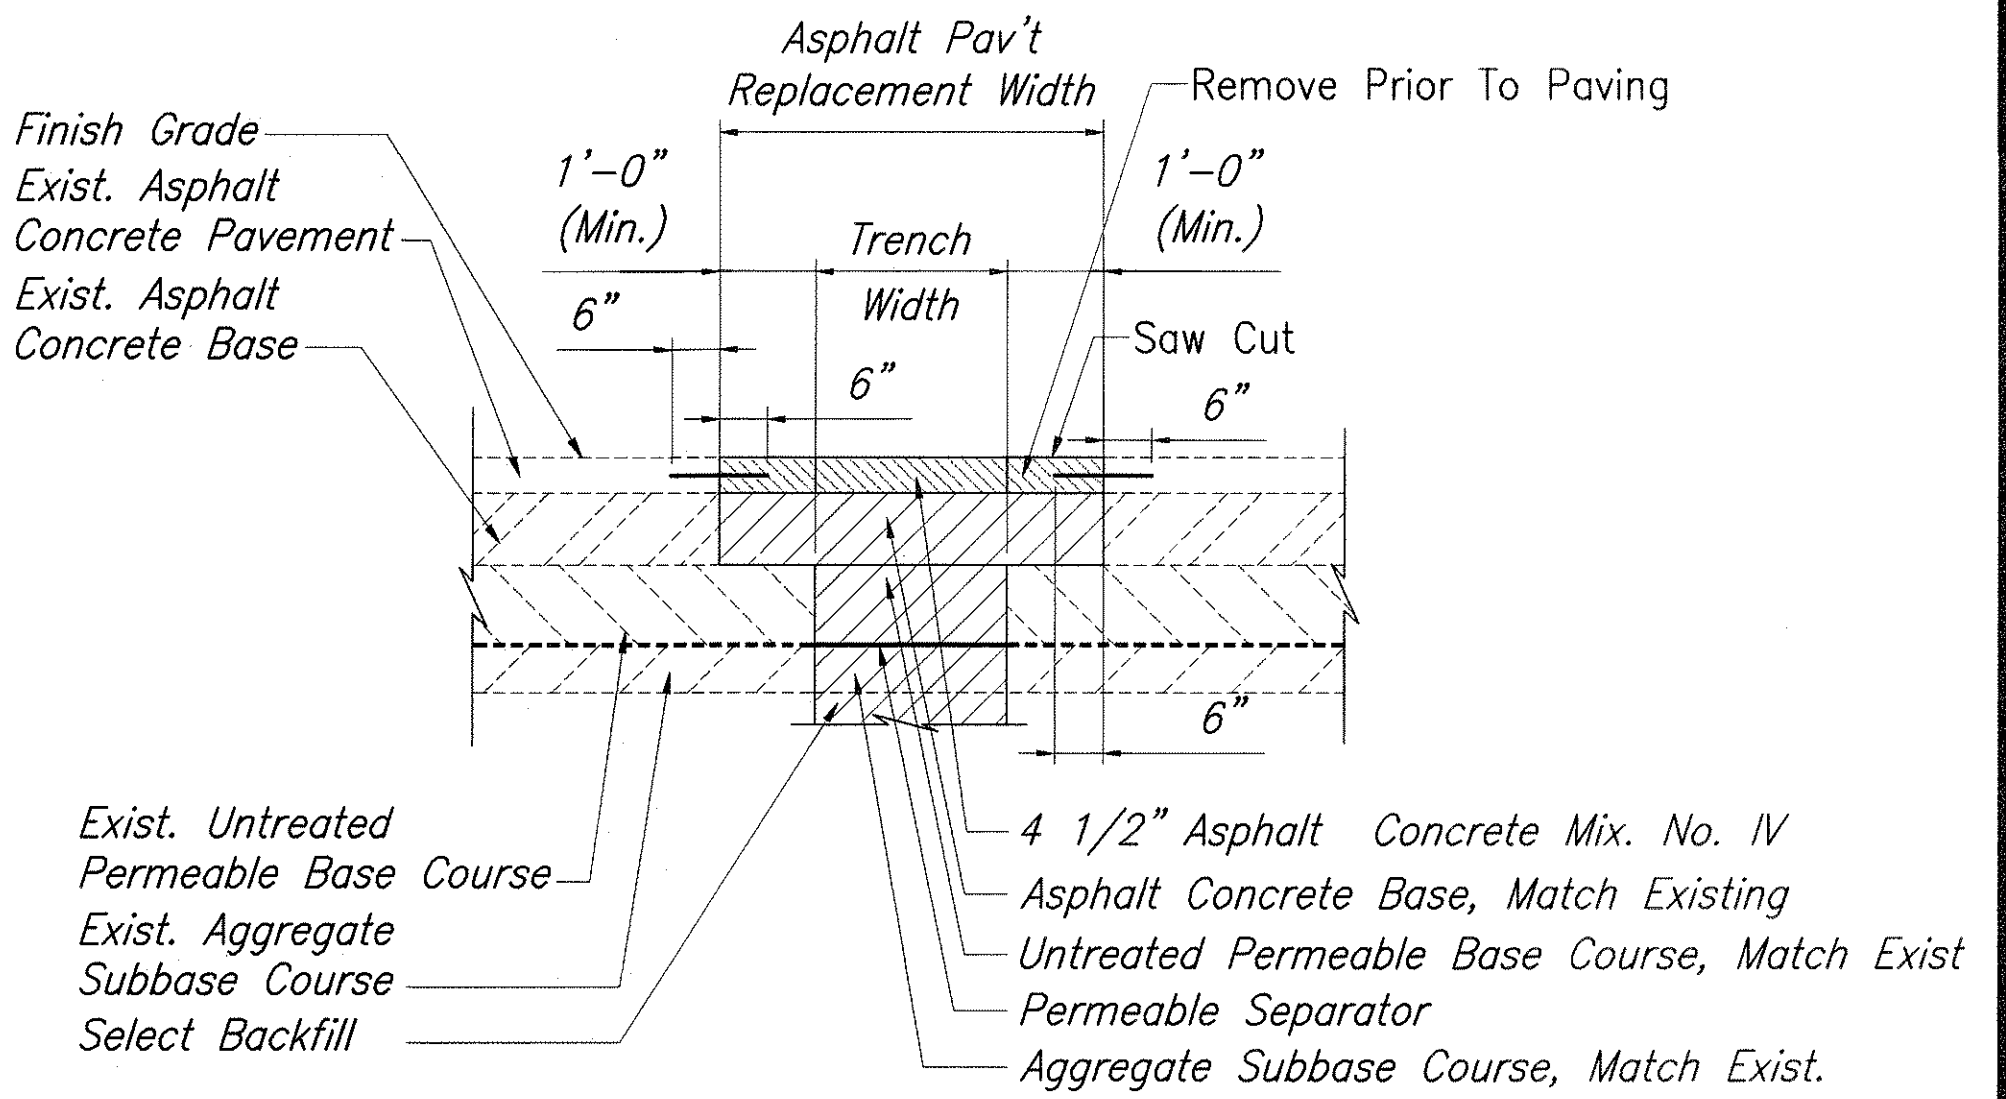

ASPHALT PAVEMENT RESTORATION DETAIL
Scale: 1/2" = 1'-0"

DATE	12/02
SURVEY PLANNED BY	J. BAIGULAR
DRAWN BY	J. BAIGULAR
DESIGNED BY	E. MIA
QUANTITIES BY	J. BAIGULAR
CHECKED BY	E. MIA
ORIGINAL PLAN	No.
NOTE BOOK	No.

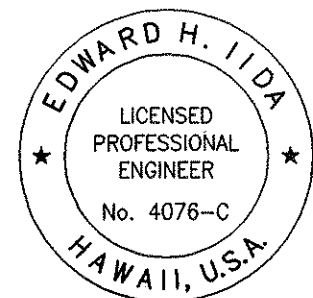

STATE OF HAWAII
DEPARTMENT OF TRANSPORTATION
HIGHWAYS DIVISION

MISCELLANEOUS DETAILS - 2

KAHEKILI HIGHWAY LANDSCAPING
Kulukeoe Street to Vicinity of Haiku Road
Federal Aid Project No. NH-083-1(49)
Scale: As Noted Date: Apr. 2002

SHEET No. 2 OF 2 SHEETS