



FED. ROAD DIST. NO.	STATE	PROJ. NO.	FISCAL YEAR	SHEET NO.	TOTAL SHEETS
HAWAII	HAW.	83G-01-03M	2005	20	47

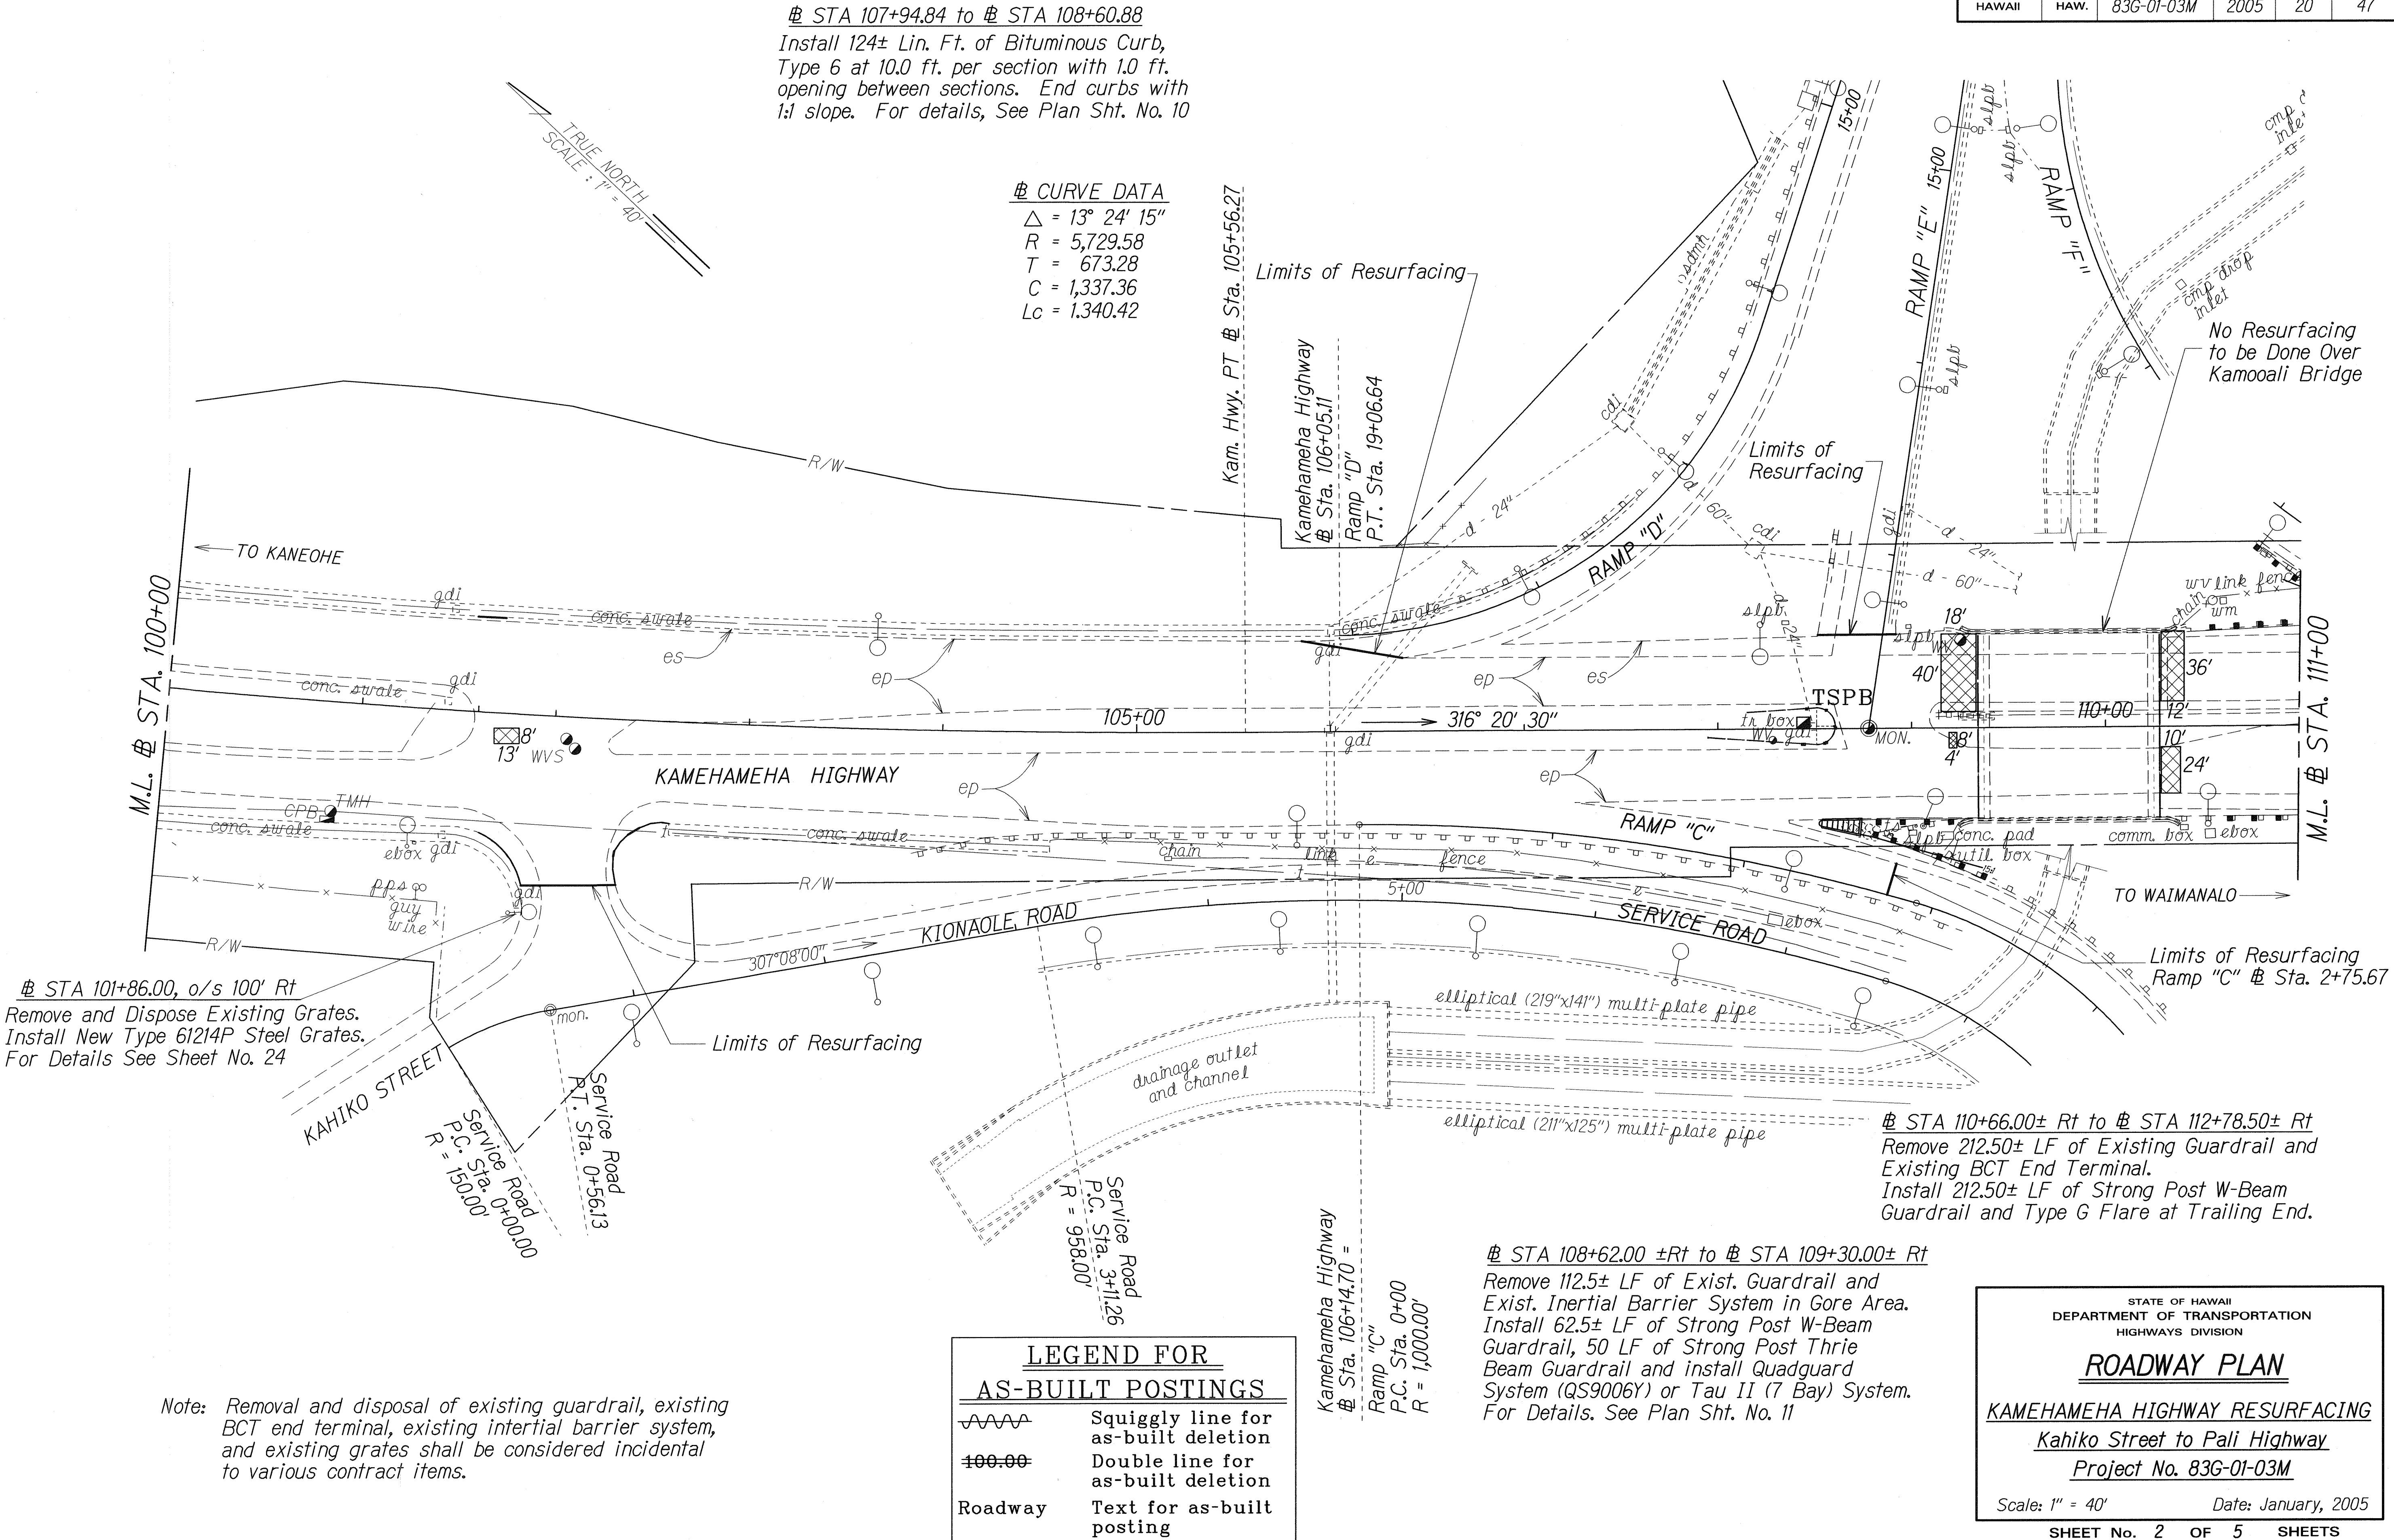

FED. ROAD DIST. NO.	STATE	PROJ. NO.	FISCAL YEAR	SHEET NO.	TOTAL SHEETS
HAWAII	HAW.	83G-01-03M	2005	21	47

@ STA 111+26.00± Lt to @ STA 111+50.00± Lt
 Remove 147.5± LF exist. guardrail and
 exist. inertial barrier System in Gore Area.
 Install 62.5± LF Strong Post W-Beam Guardrail,
 85± LF of Strong Post Thrie Beam Guardrail,
 and Quadguard System (QS9006Y) or
 Tau II (7 Bay) System. For Details,
 See Plan Sht. No. 11

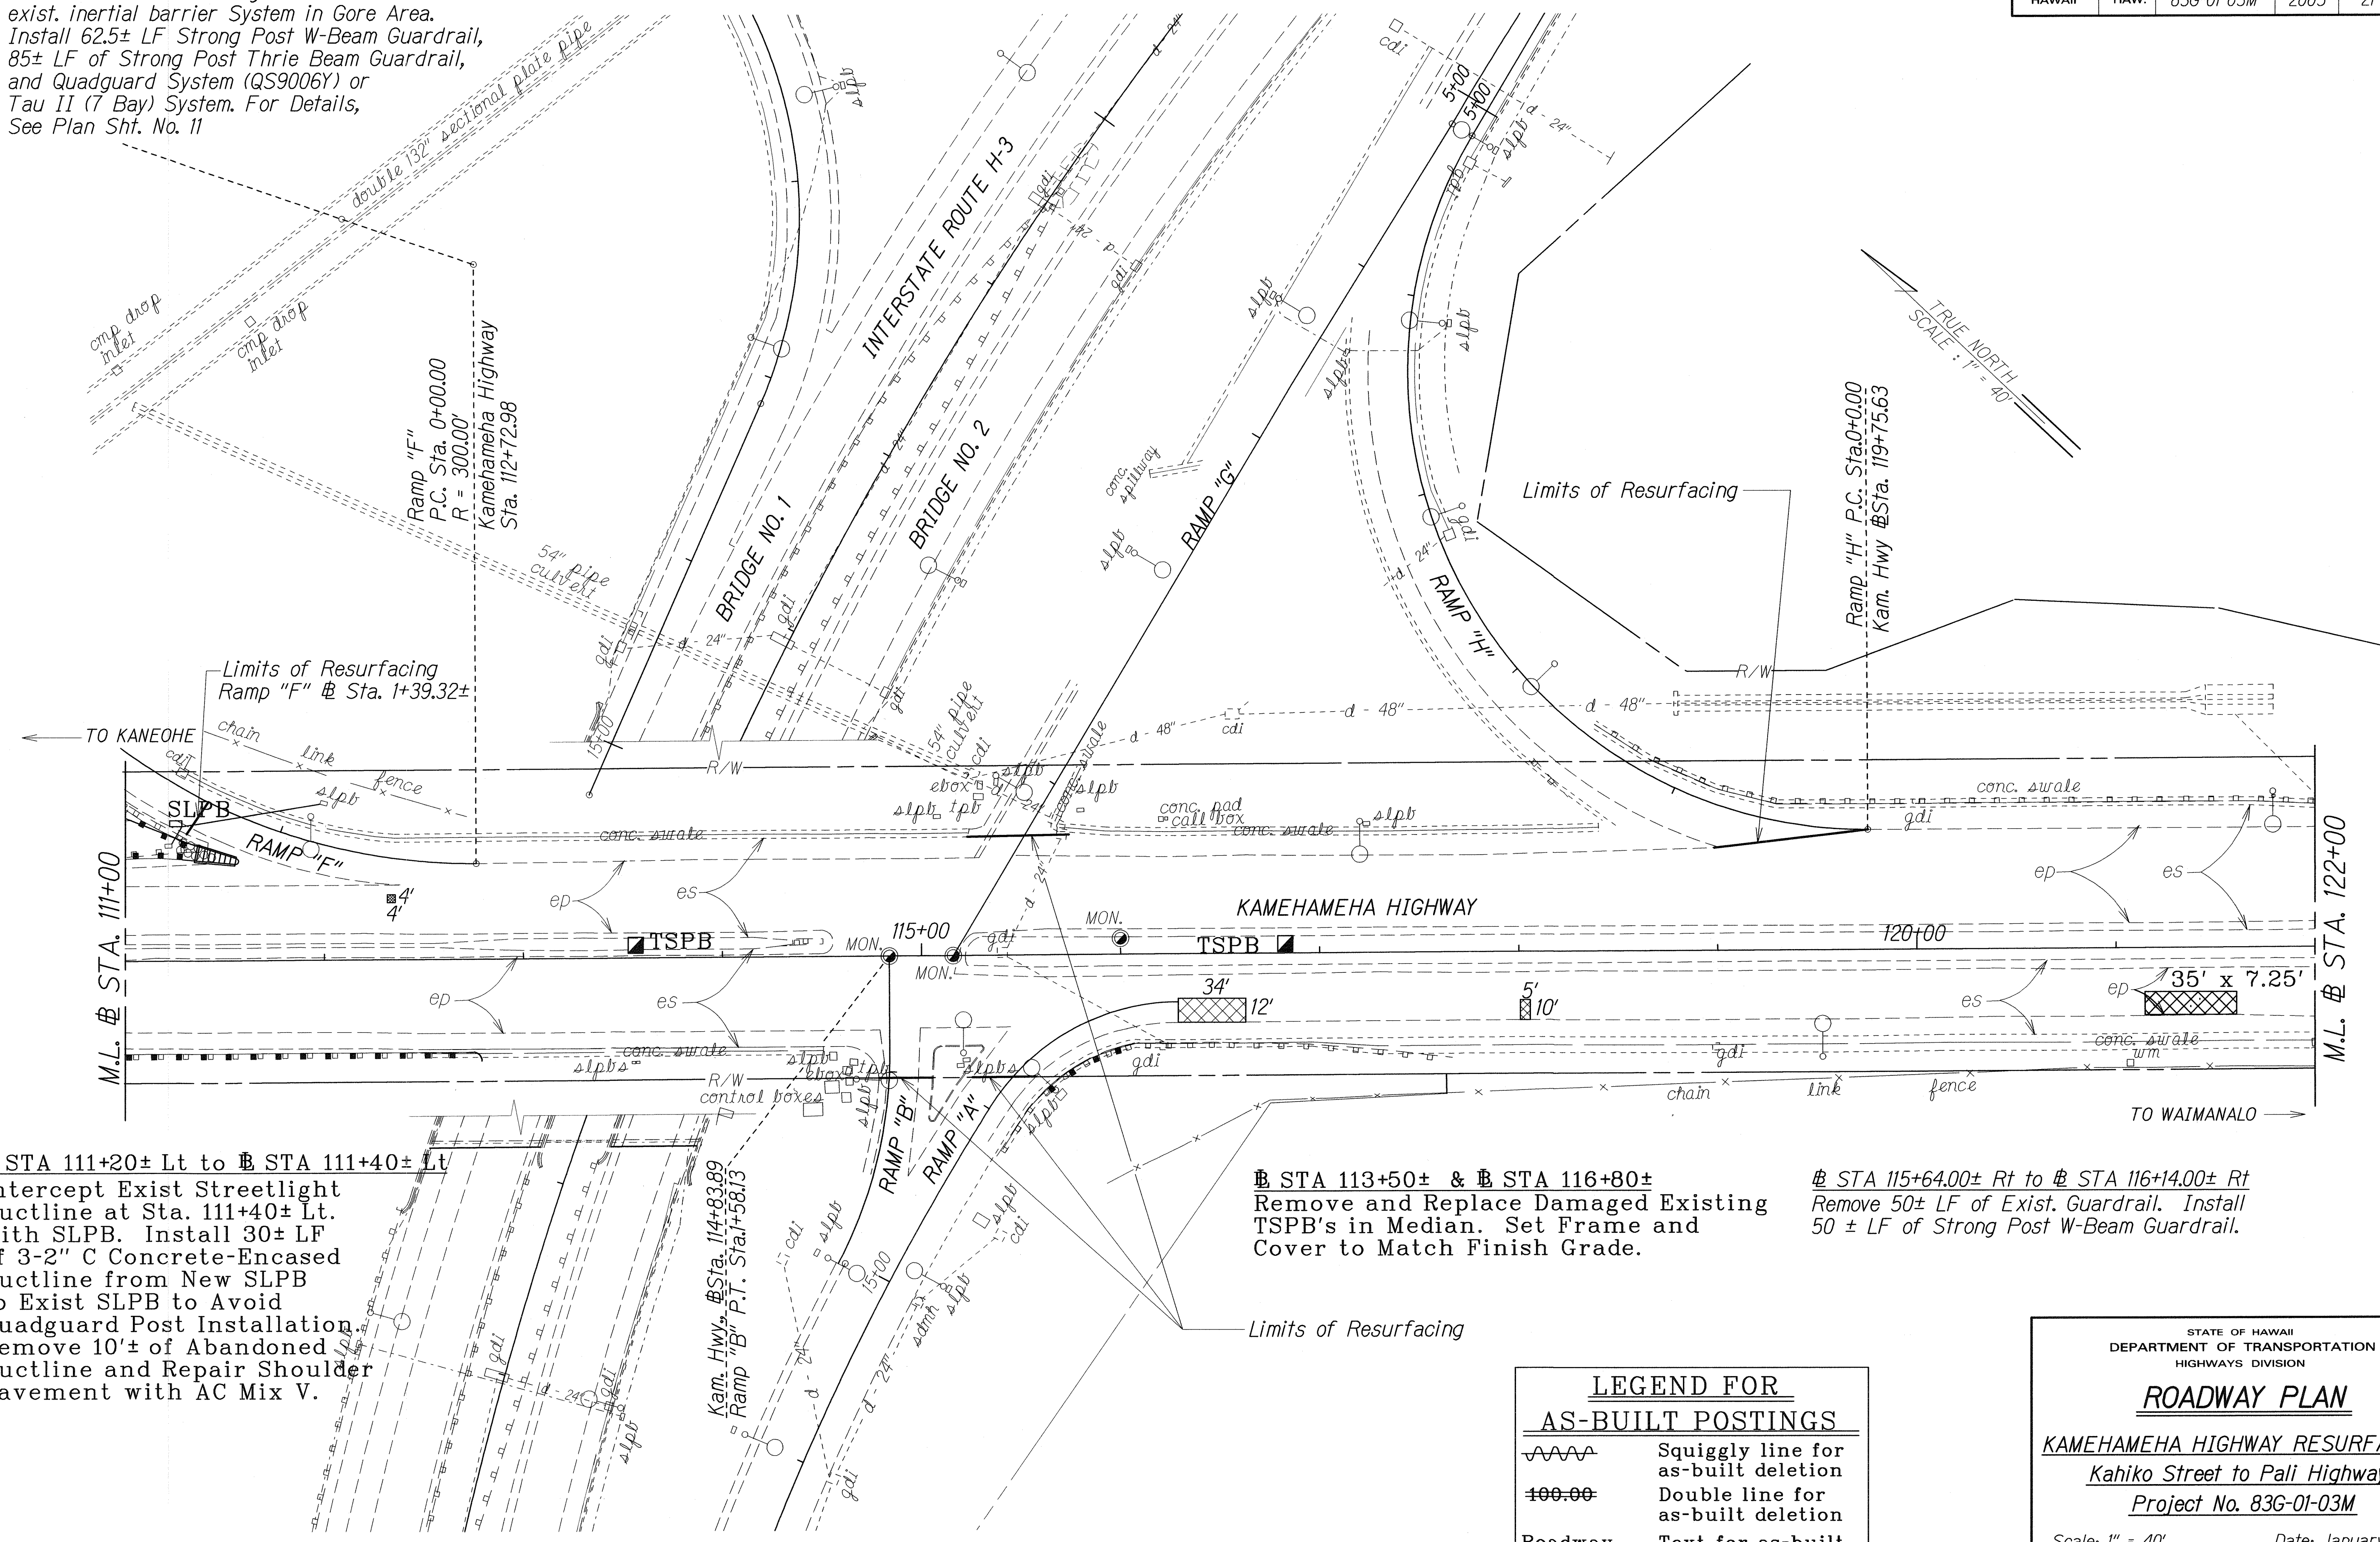

@ STA 111+20± Lt to @ STA 111+40± Lt
 Intercept Exist Streetlight
 Ductline at Sta. 111+40± Lt.
 with SLPB. Install 30± LF
 of 3-2" C Concrete-Encased
 Ductline from New SLPB
 to Exist SLPB to Avoid
 Quadguard Post Installation
 Remove 10'± of Abandoned
 Ductline and Repair Shoulder
 Pavement with AC Mix V.

@ STA 113+50± & @ STA 116+80±
 Remove and Replace Damaged Existing
 TSPB's in Median. Set Frame and
 Cover to Match Finish Grade.

@ STA 115+64.00± Rt to @ STA 116+14.00± Rt
 Remove 50± LF of Exist. Guardrail. Install
 50 ± LF of Strong Post W-Beam Guardrail.

LEGEND FOR AS-BUILT POSTINGS	
	Squiggly line for as-built deletion
	Double line for as-built deletion
Roadway	Text for as-built posting


STATE OF HAWAII
 DEPARTMENT OF TRANSPORTATION
 HIGHWAYS DIVISION

ROADWAY PLAN
 KAMEHAMEHA HIGHWAY RESURFACING
 Kahiko Street to Pali Highway
 Project No. 83G-01-03M
 Scale: 1" = 40' Date: January, 2005

SHEET No. 3 OF 5 SHEETS

ORIGINAL PLAN	DATE
DESIGNED BY	2/17/03
TRACED BY	
NOTED BY	
QUANTITIES BY	
CHECKED BY	

FED. ROAD DIST. NO.	STATE	PROJ. NO.	FISCAL YEAR	SHEET NO.	TOTAL SHEETS
HAWAII	HAW.	83G-01-03M	2005	ADD22	47

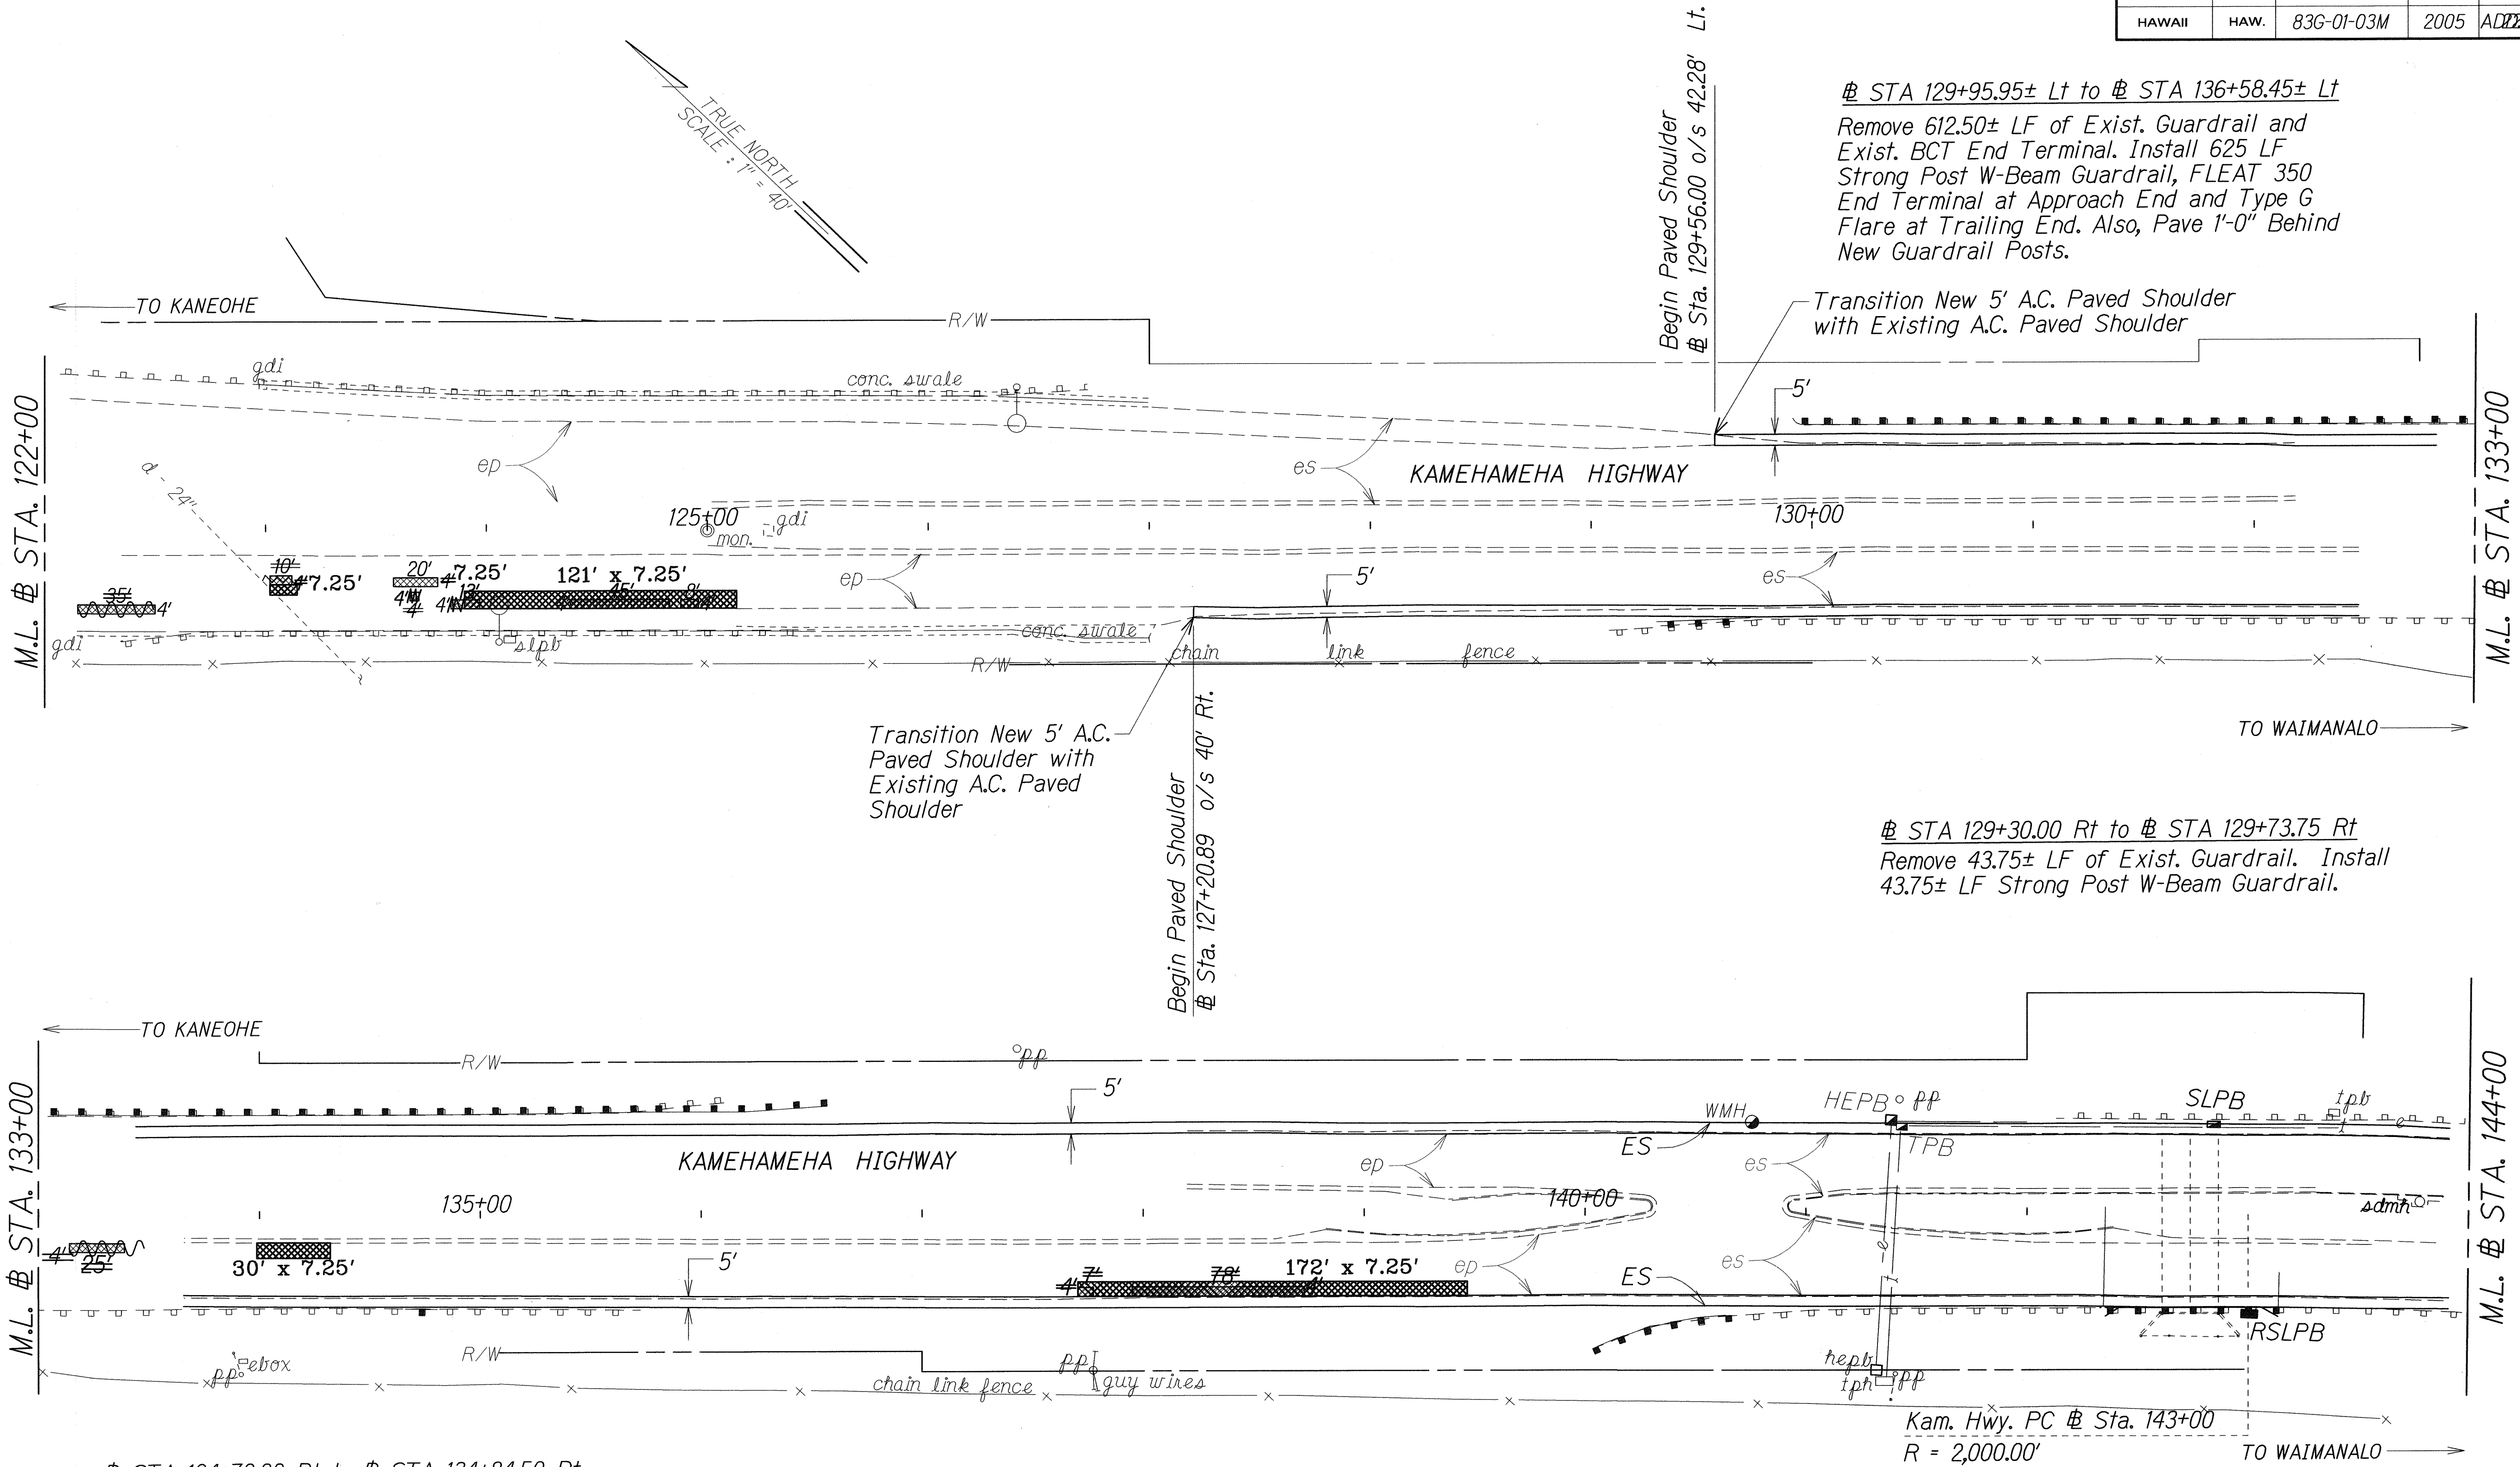

STA 134+72.00 Rt to # STA 134+84.50 Rt
Remove 12.5± LF of Existing Guardrail. Install 12.5± LF Strong Post W-Beam Guardrail.

STA 140+00.00 Rt to # STA 140+62.50 Rt
Remove 62.50± LF of Existing Guardrail. Existing End Anchorage to Remain in Place. Install New Type "A" Flare Strong Post W-Beam Guardrail. For Details, See Plan Sheet No. 16 Install New Rubrail.

STA 142+35.50± Rt to # STA 143+10.50± Rt
Remove 75± LF of Exist. Guardrail. Install W-Beam Rubrail and Strong Post W-Beam Guardrail. For Details, See Plan Sht. No. 30

LEGEND FOR AS-BUILT POSTINGS	
	Squiggly line for as-built deletion
	Double line for as-built deletion
Roadway	Text for as-built posting

6/16/05	Revised Note described for # Sta. 129+95.95± Lt to # Sta. 136+58.45± Lt. Revised Note described for # Sta. 140+00 Rt. to # Sta. 140+62.50 Rt.
DATE	REVISION

STATE OF HAWAII
DEPARTMENT OF TRANSPORTATION
HIGHWAYS DIVISION

ROADWAY PLAN


KAMEHAMEHA HIGHWAY RESURFACING
Kahiko Street to Pali Highway
Project No. 83G-01-03M

Scale: 1" = 40' Date: January, 2005

SHEET No. 4 OF 5 SHEETS

ORIGINAL PLAN	DATE
DESIGNED BY	8/1/03
DRAWN BY	
CHECKED BY	
APPROVED BY	

STA 146+20.00 Lt to # STA 146+76.25 Lt
Remove 56.25± LF of Existing Guardrail. Install

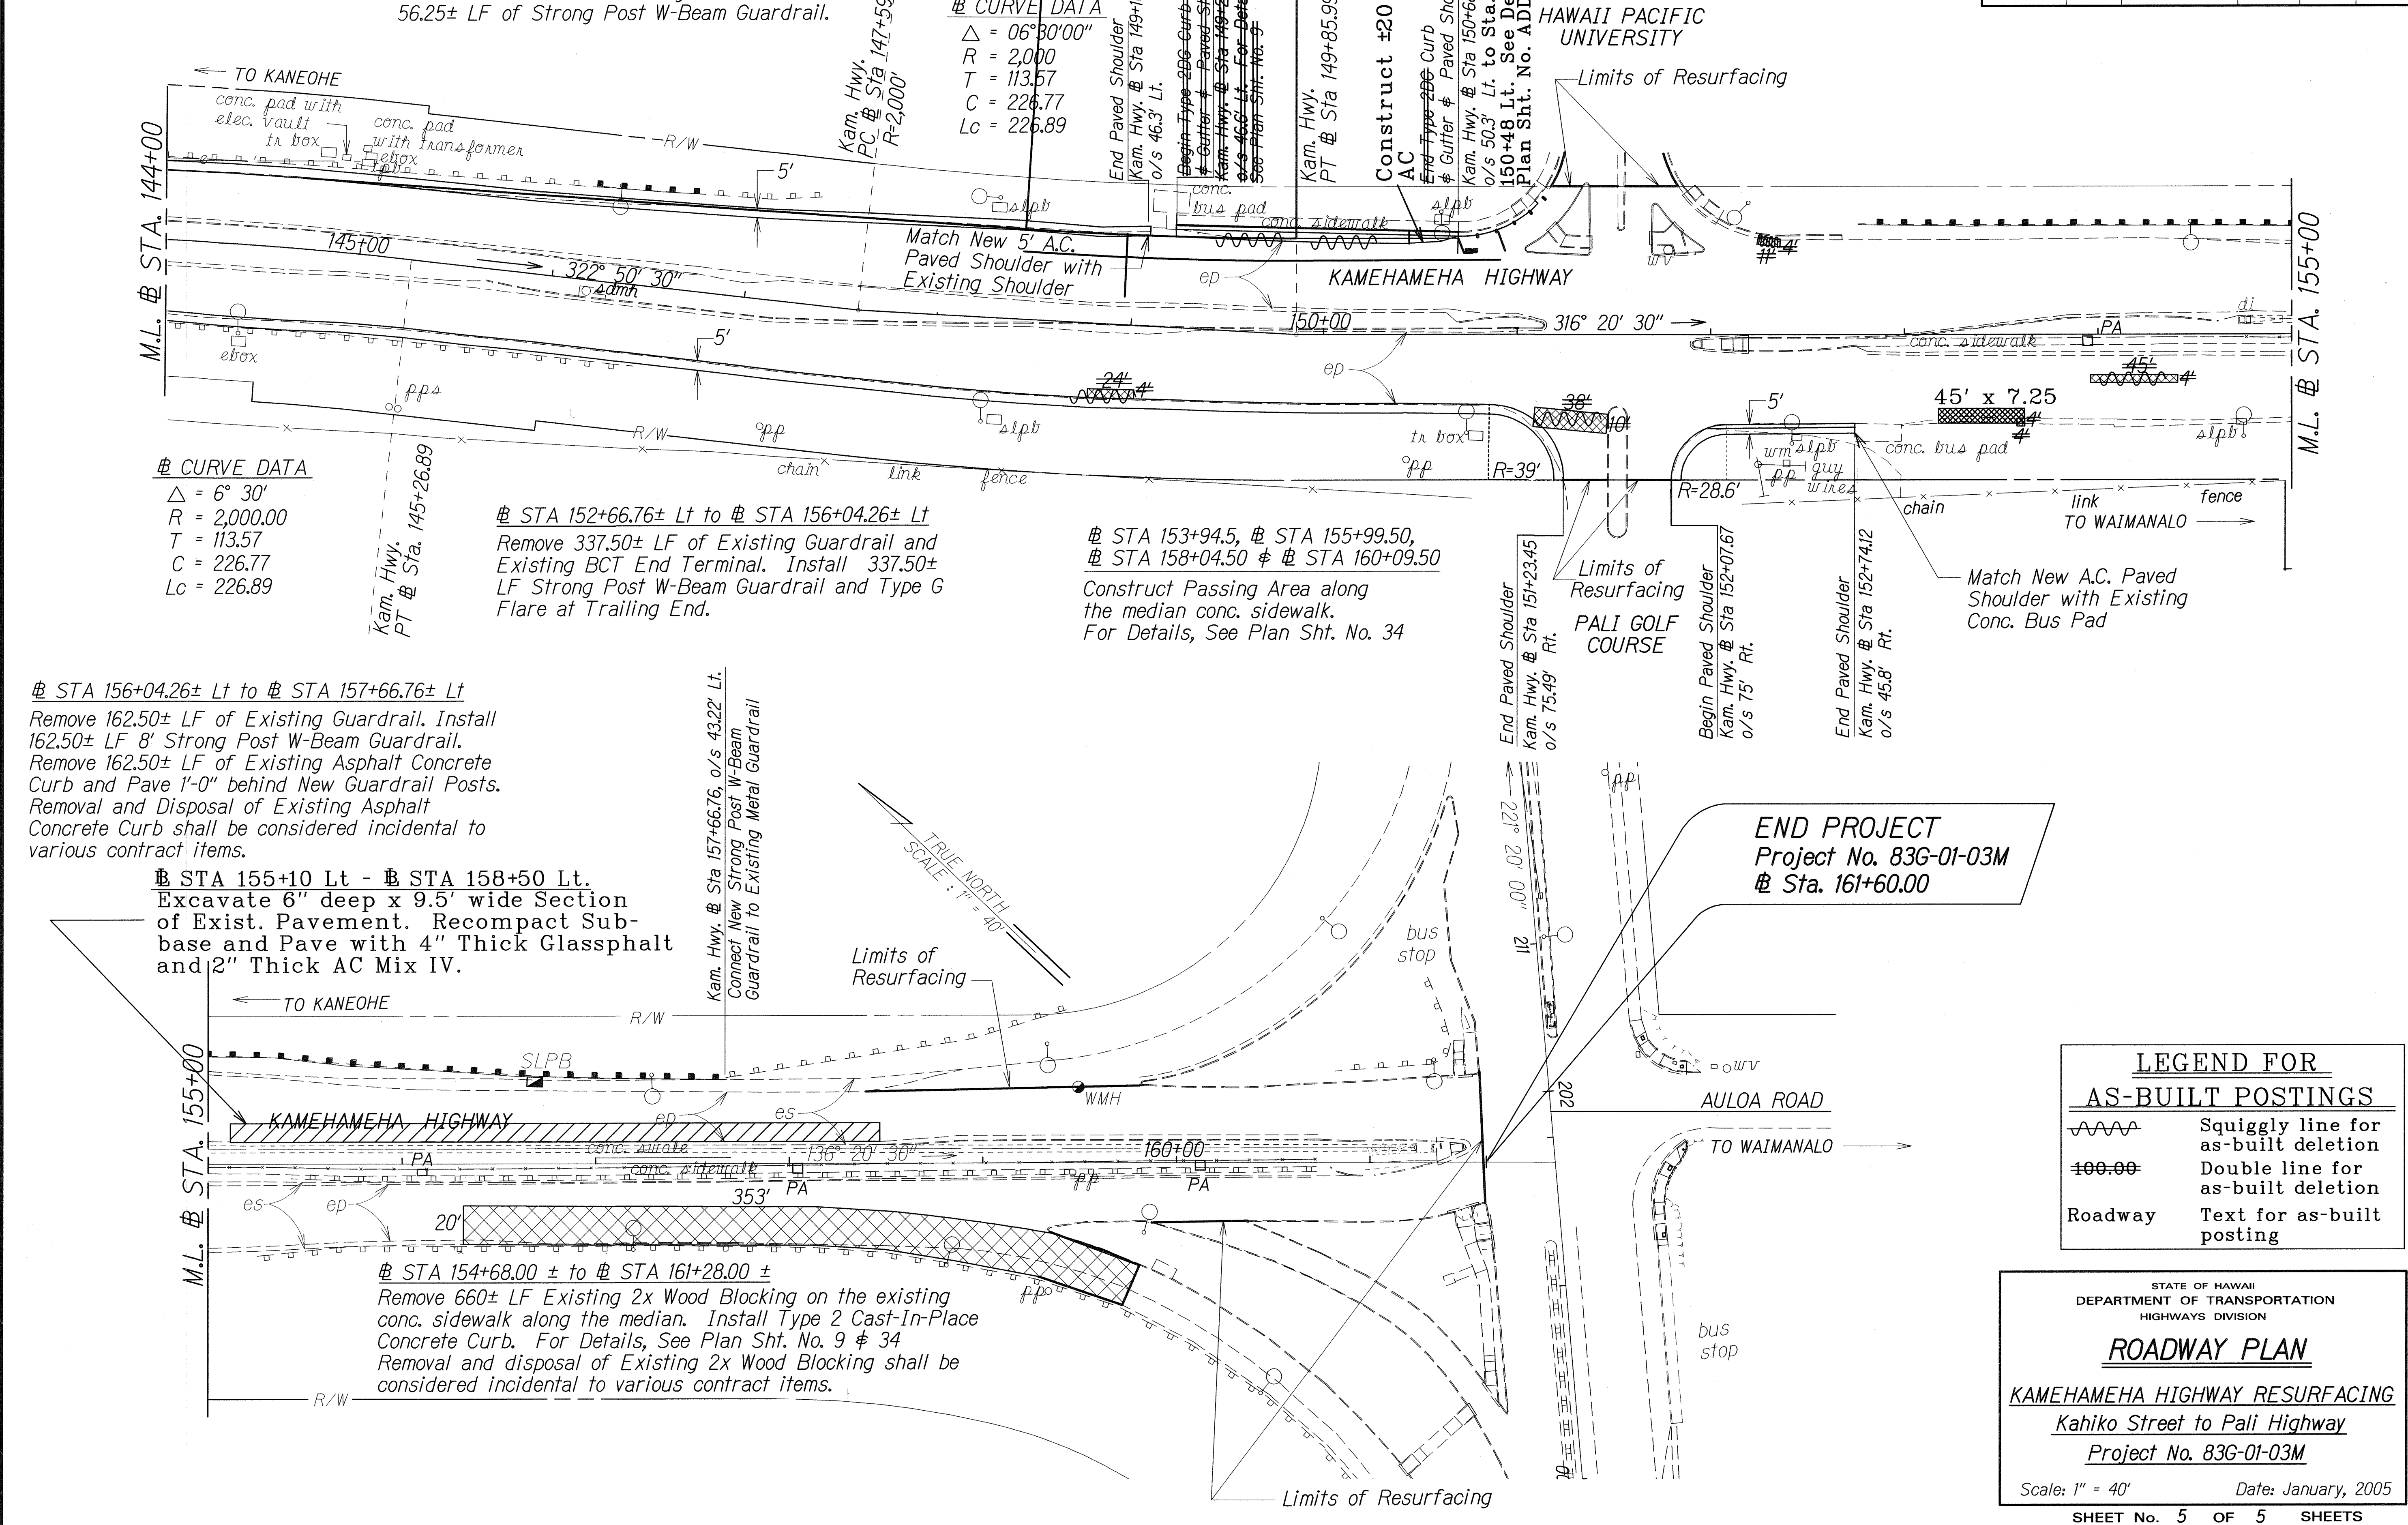

23