



FED. ROAD DIST. NO.	STATE	PROJ. NO.	FISCAL YEAR	SHEET NO.	TOTAL SHEETS
HAWAII	HAW.	83F-01-99	2006	C.O.ADD.22	28

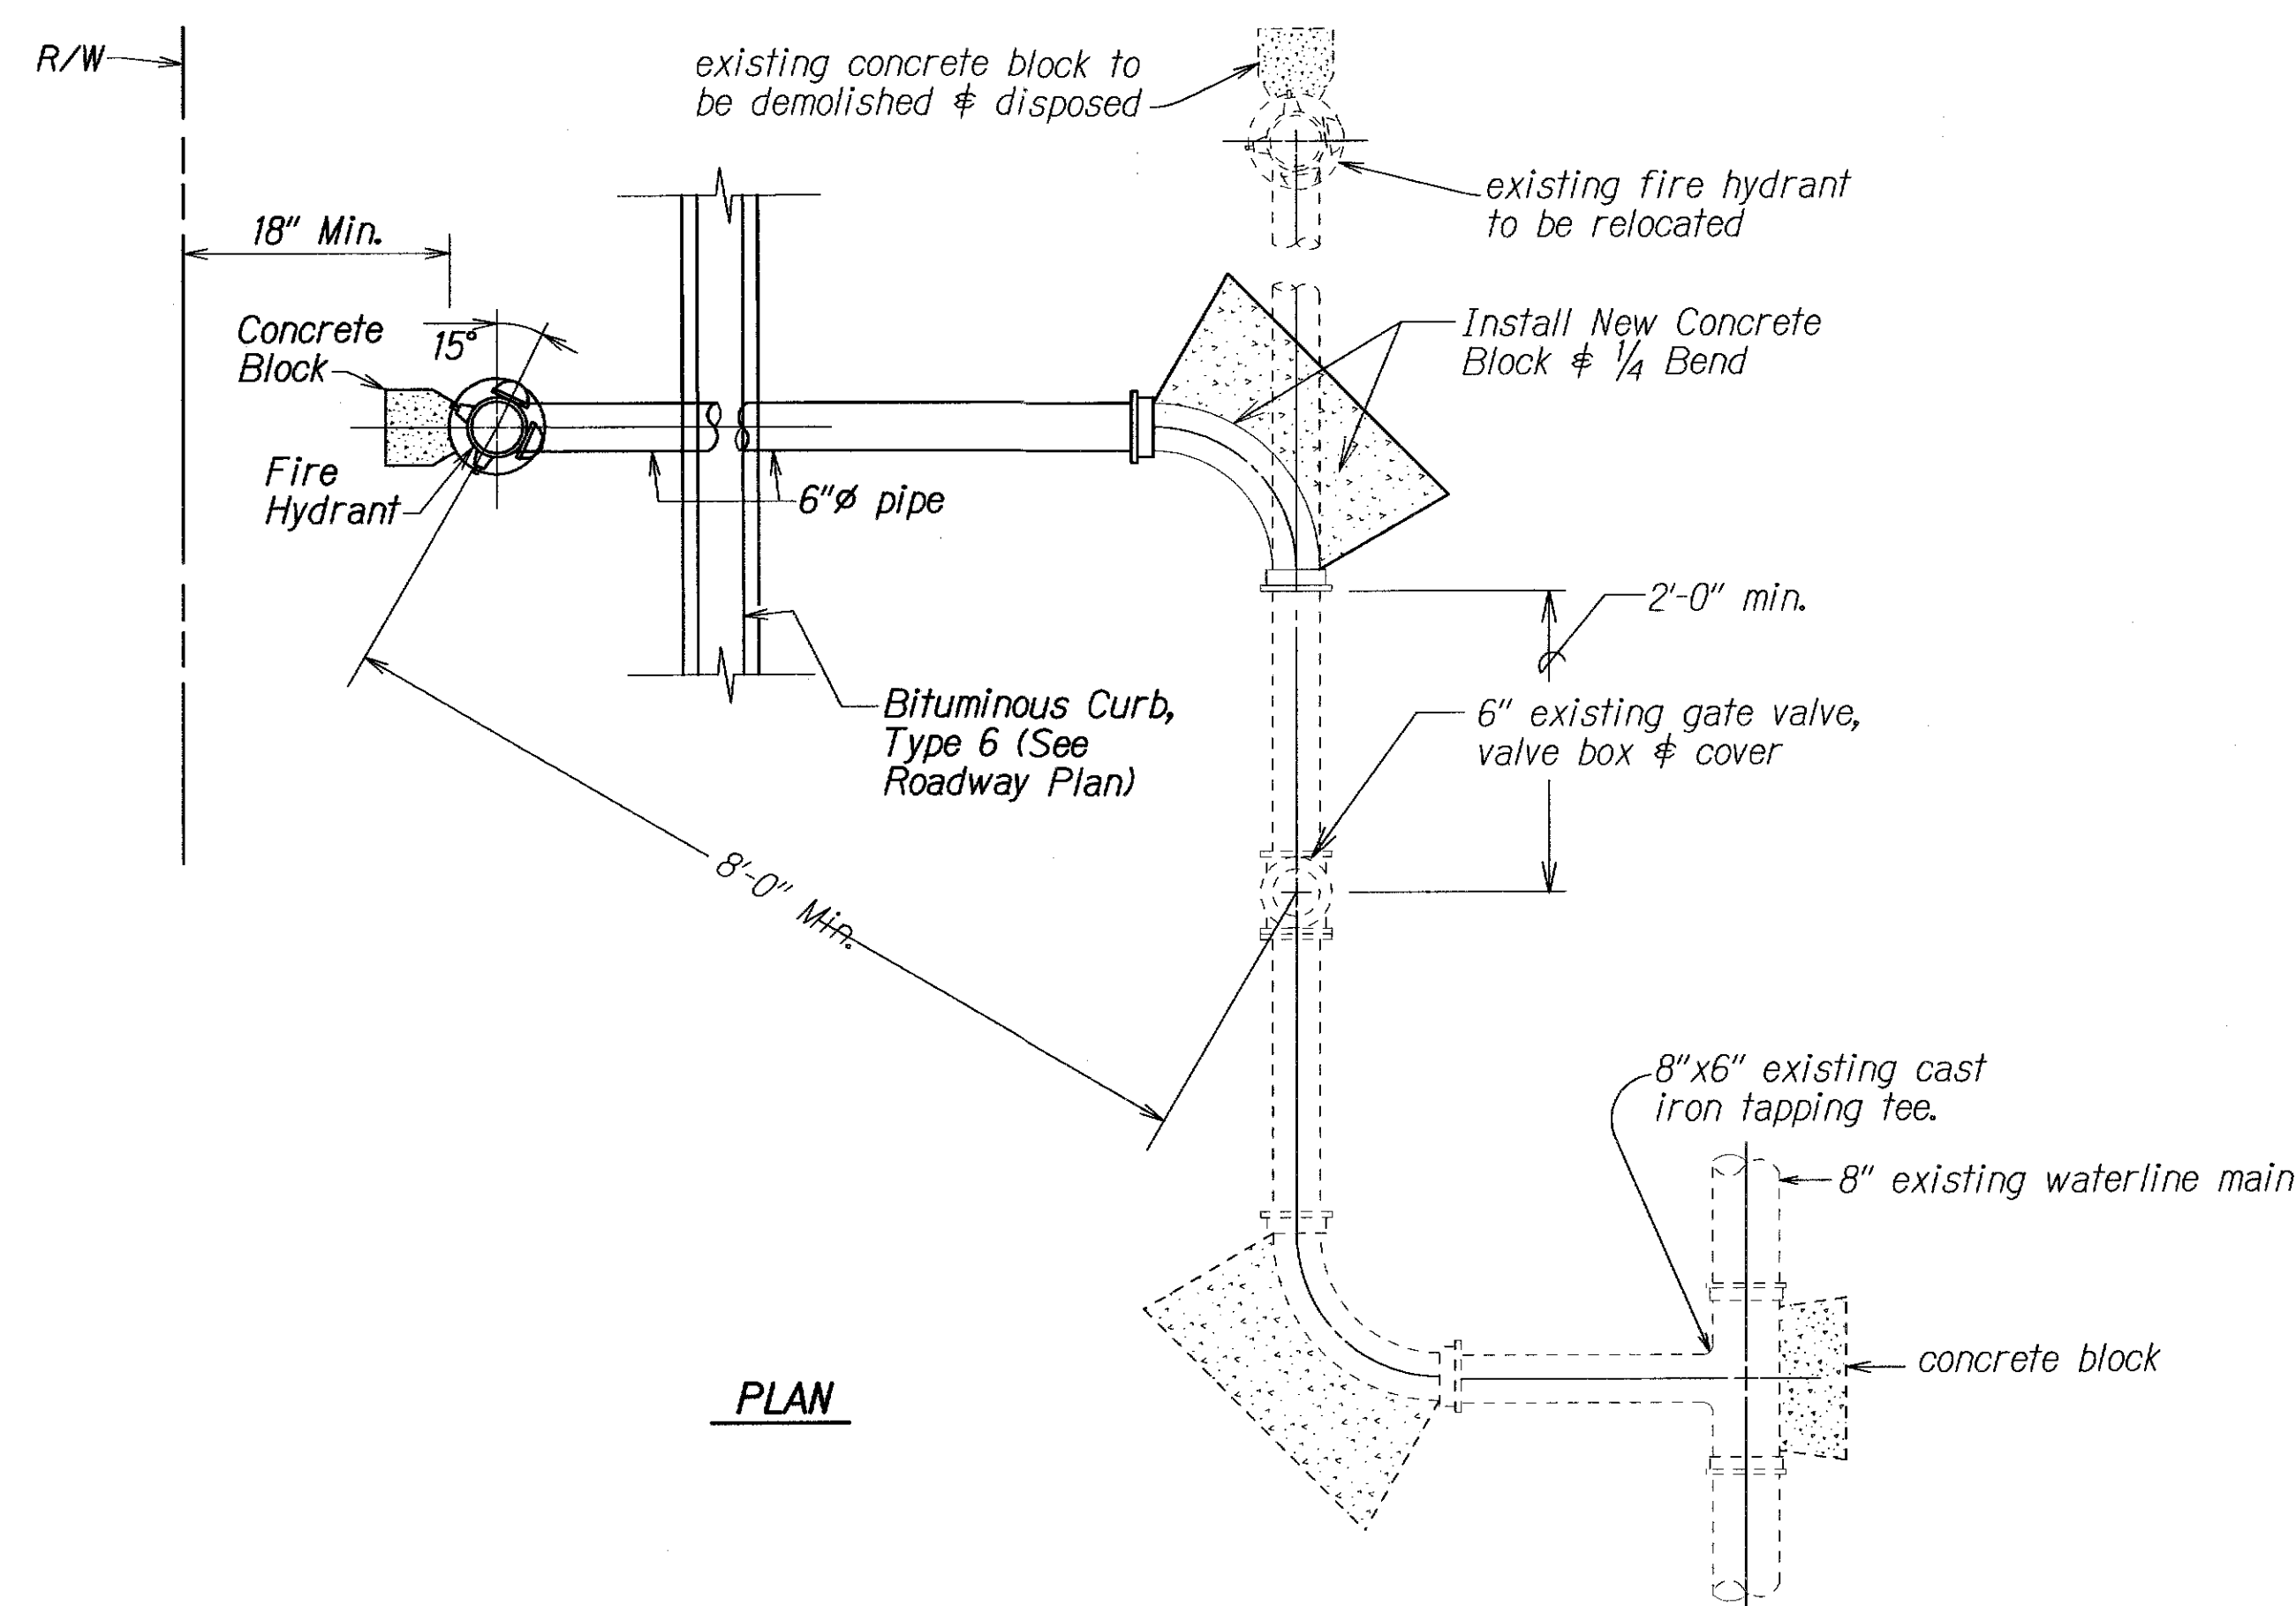

PLAN

- # Sta. 240+02±, Rt.
Relocate Existing Fire Hydrant
1 - Relocate FH (#W724)
2 - 6" 1/4 Bend
1 - Valve Box with Concrete Slab
2 - Concrete Block
1 - Fire Hydrant Extension Piece
1 - Fire Hydrant Marker
1 - 6" Sleeve, 12" Long
8± L.F. 6" D.I. Pipe, Cl. 52
Temp. For Testing
1 - 6" Cap with 2 1/2" Clean Out
1 - Concrete Block

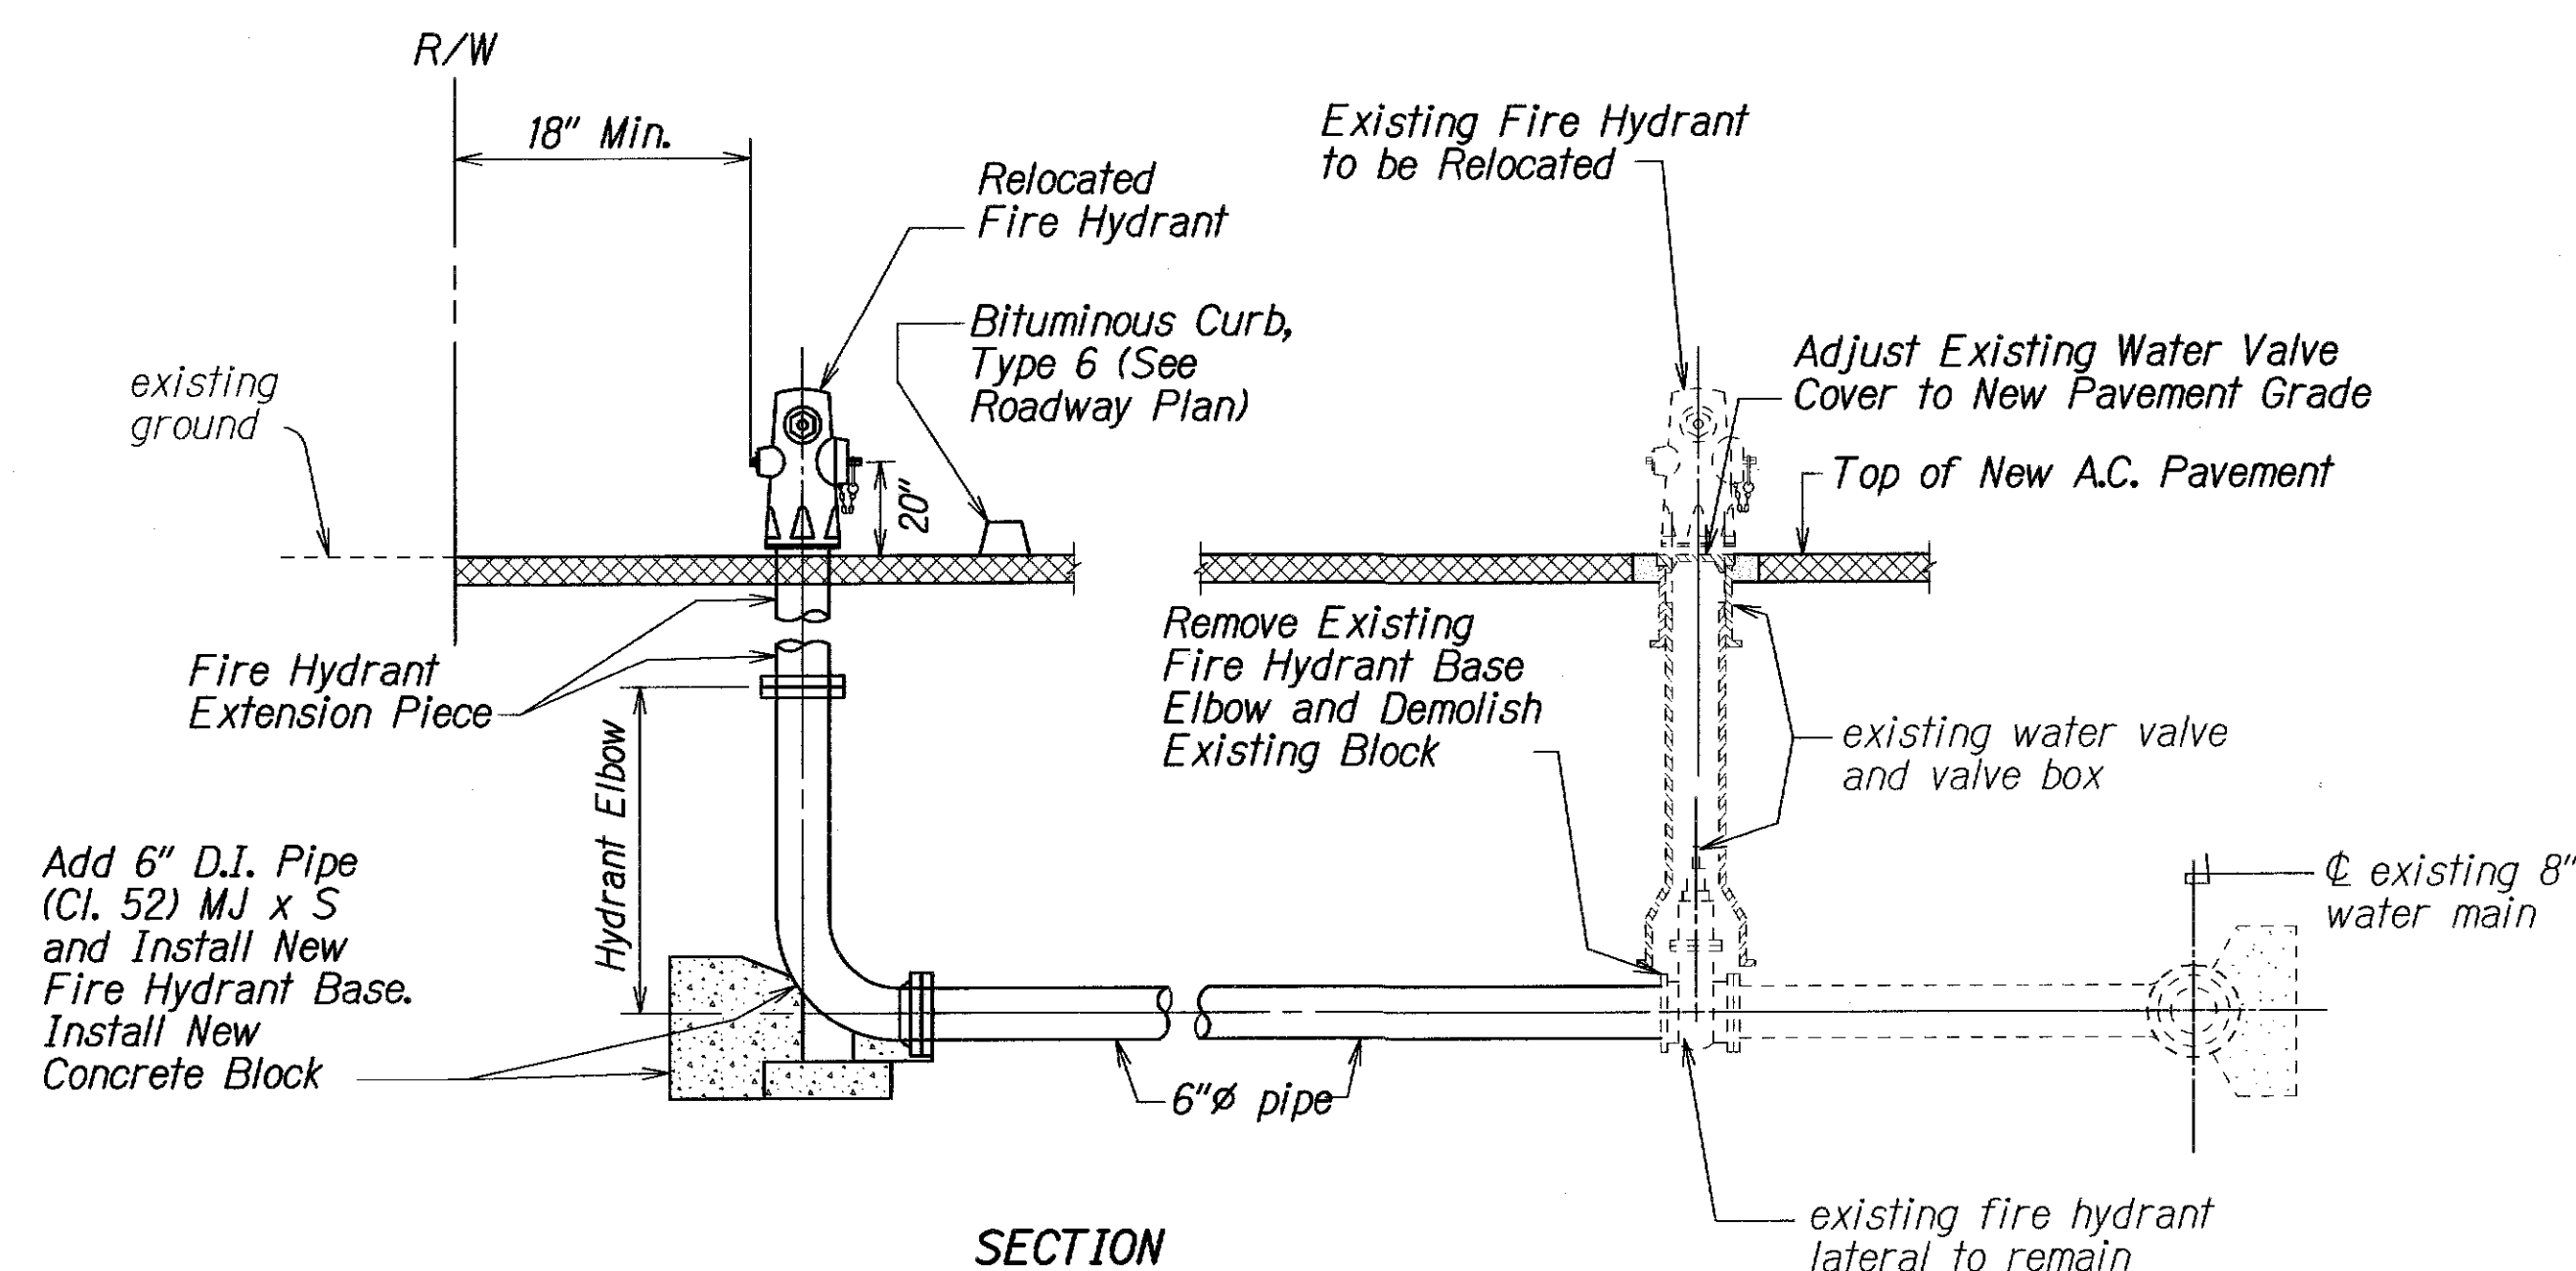

SECTION
Not to Scale

FIRE HYDRANT CONNECTION PLAN
STA. 240+02± o/s 0.5±, Rt.
Not to Scale

Note:
All ductile iron pipe, fittings and valves shall be wrapped with two layers of 8 mil. polyethylene wrap. The work shall be considered incidental to the Relocation of Existing Fire Hydrant.

APPROVED BY:

Domini v. Ito
CHIEF, CAPITAL PROJECTS DIVISION
BOARD OF WATER SUPPLY
CITY AND COUNTY OF HONOLULU

8/7/07
DATE

7/17/09	Relocate Fire Hdrant and Waterline.
6/19/06	Revise Plan to show Existing Fire Hydrant and Added BWS Approval Signature.

DATE	REVISION
------	----------

STATE OF HAWAII DEPARTMENT OF TRANSPORTATION HIGHWAYS DIVISION
FIRE HYDRANT RELOCATION
KAMEHAMEHA HIGHWAY Intersection Improvements At Kahekili Highway Project No. 83F-01-99
Date: November, 2005

SHEET No. 1 OF 1 SHEETS

C.O.ADD.22

ORIGINAL PLAN	DATE
DRAWN BY	
DESIGNED BY	
CHECKED BY	
NOTE BOOK	
NO.	