

INDEX TO DRAWINGS	
SHEET NO.	DESCRIPTION
1	TITLE SHEET
2	STANDARD PLANS SUMMARY
3	GENERAL NOTES AND LEGEND
4 - 5	WATER POLLUTION AND EROSION CONTROL NOTES
6 - 8	UTILITY NOTES
9 - 12	TYPICAL SECTIONS
13	GUARDRAIL DETAILS
14 - 16	ROADWAY PLANS
17 - 18	DETAIL ROADWAY PLANS
19 - 21 ①	DRAINAGE DETAILS
22	FIRE HYDRANT RELOCATION PLAN
23 - 24 ②	HIGHWAY LIGHTING DETAILS
25 ③	PAVEMENT MARKING LEGEND, NOTES AND DETAILS
26 - 28	PAVEMENT MARKINGS AND SIGNING PLANS

Sheet Nos. ① C.O. 21S-1; ② ADD. 24S-1 and ③ ADD 25S-1 are Supplementary Sheets to this Project. Total sheet count After "AS-BUILT" Posting 31 sheets.

DESIGNED BY

HWY-D

MANAGED BY

HWY-DD

PHONE

692-7570

DATE

MAY, 2006

STATE OF HAWAII

DEPARTMENT OF TRANSPORTATION

HIGHWAYS DIVISION

HONOLULU, HAWAII


"AS-BUILT"

PLANS FOR

KAMEHAMEHA HIGHWAY

INTERSECTION IMPROVEMENTS AT KAHEKILI HIGHWAY

PROJECT NO. 83F-01-99

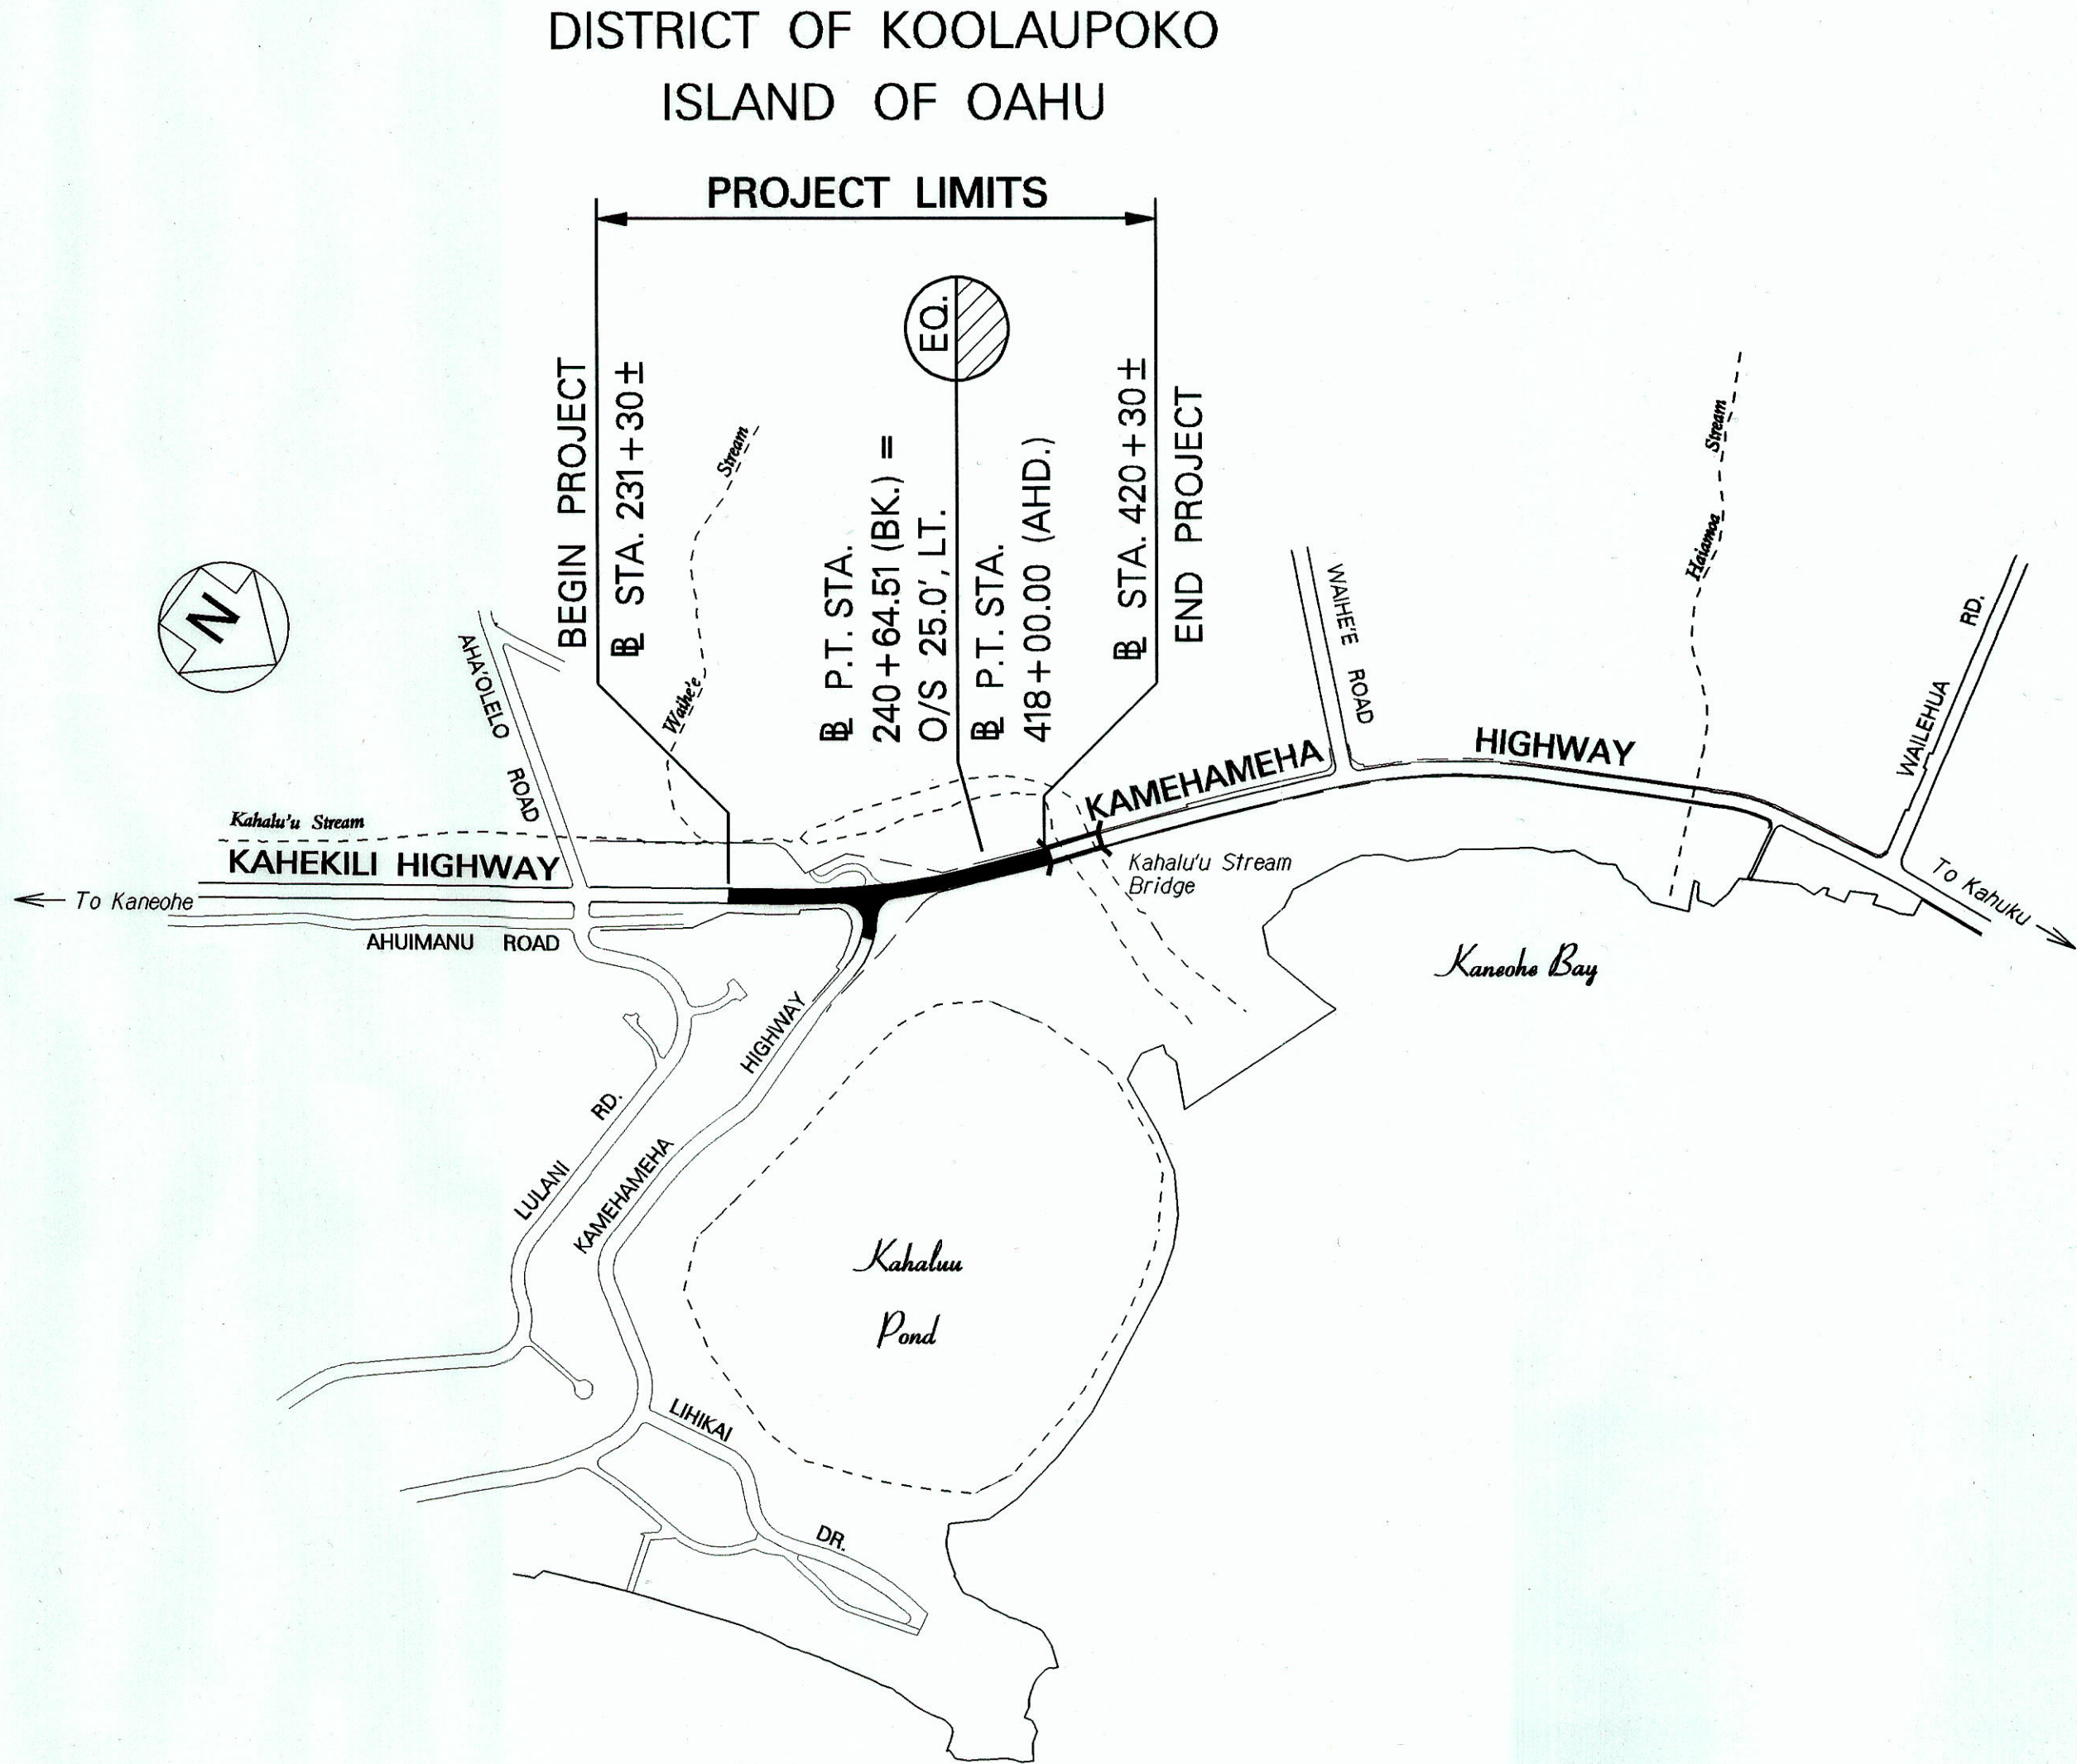



LOCATION PLAN

LENGTH OF PROJECT.....0.22 MILE

0.5 0 0.5 1 1.5

SCALE IN THOUSAND FEET

FED. ROAD DIST. NO.	STATE	PROJ. NO.	FISCAL YEAR	SHEET NO.	TOTAL SHEETS
HAWAII	HAW.	83F-01-99	2006	1	28

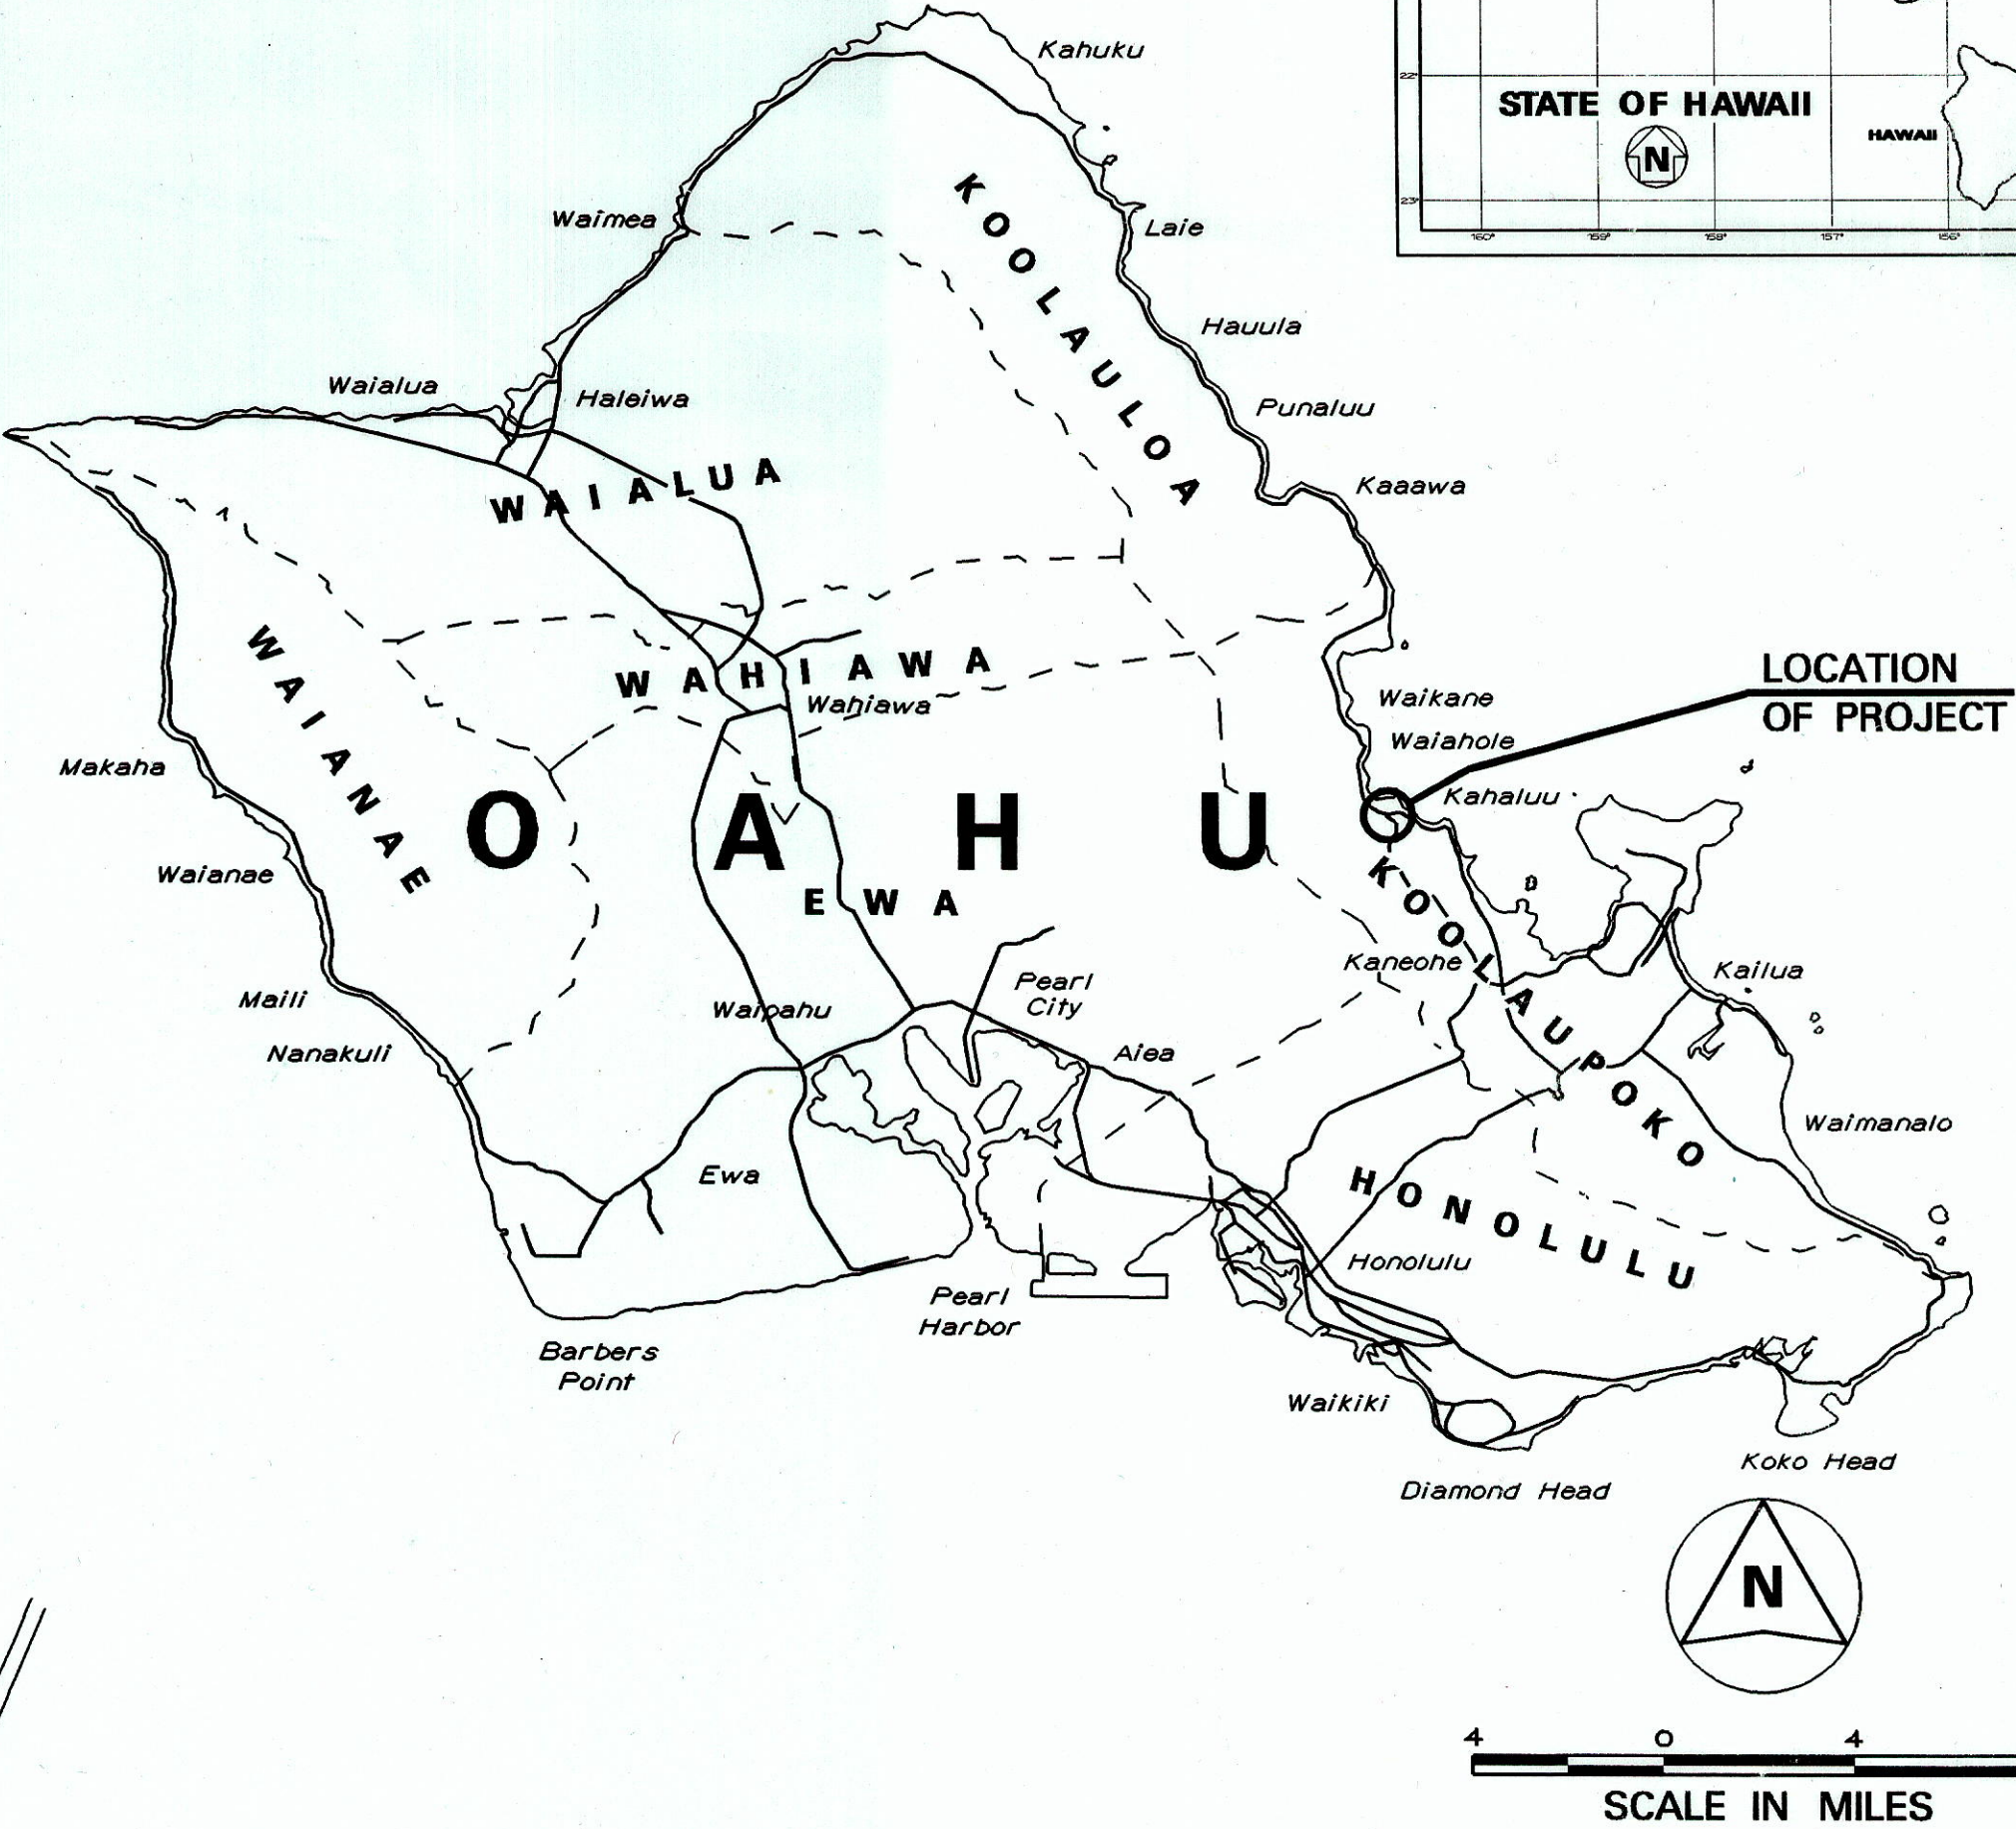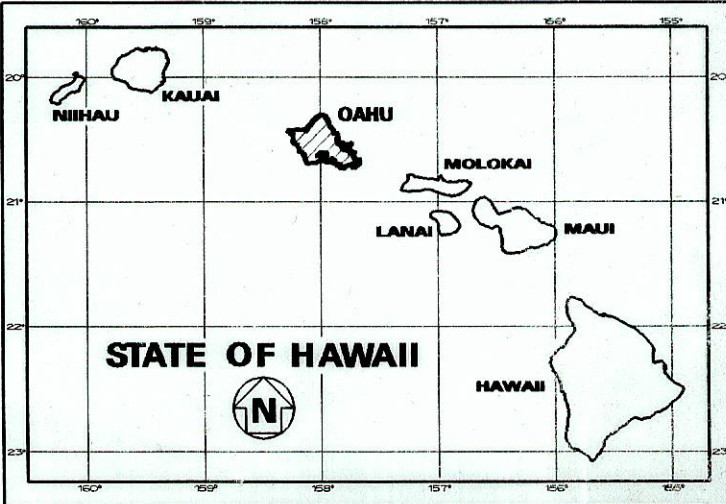

MILE POST 36.41 TO MILE POST 36.19

CHANGES MADE DURING CONSTRUCTION HAVE BEEN INCORPORATED ON THESE PLANS EXCEPT CHANGES IN THE ORIGINAL THEORETICAL QUANTITIES. FOR ACTUAL QUANTITIES, REFER TO PROJECT LEDGER AND/OR COMPUTATION BOOK.

Matthew Monte 4/16/21
RESIDENT ENGINEER DATE

DEPARTMENT OF TRANSPORTATION
STATE OF HAWAII

APPROVED:

Dir. of Transportation 5.22.06
DATE