

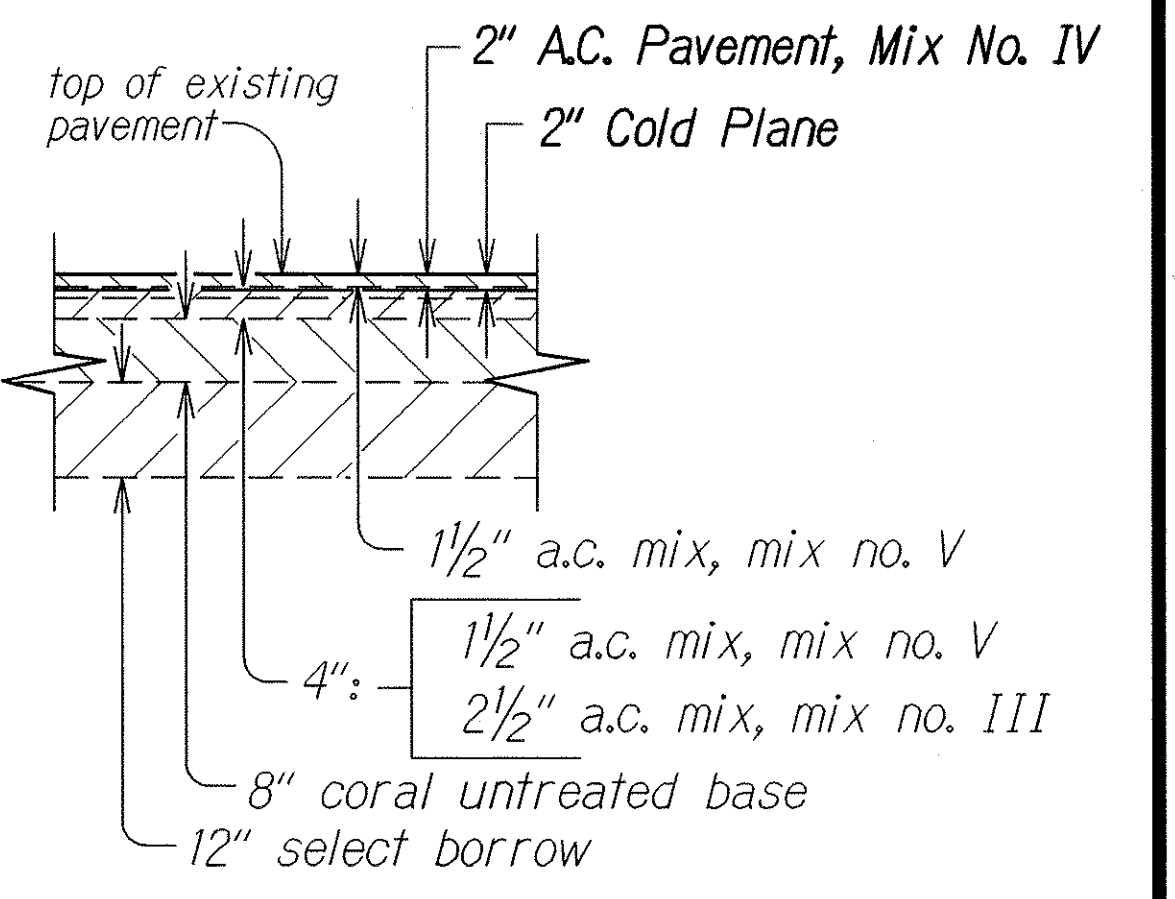


FED. ROAD DIST. NO.	STATE	PROJ. NO.	FISCAL YEAR	SHEET NO.	TOTAL SHEETS
HAWAII	HAW.	83F-01-99	2006	ADD.9	28

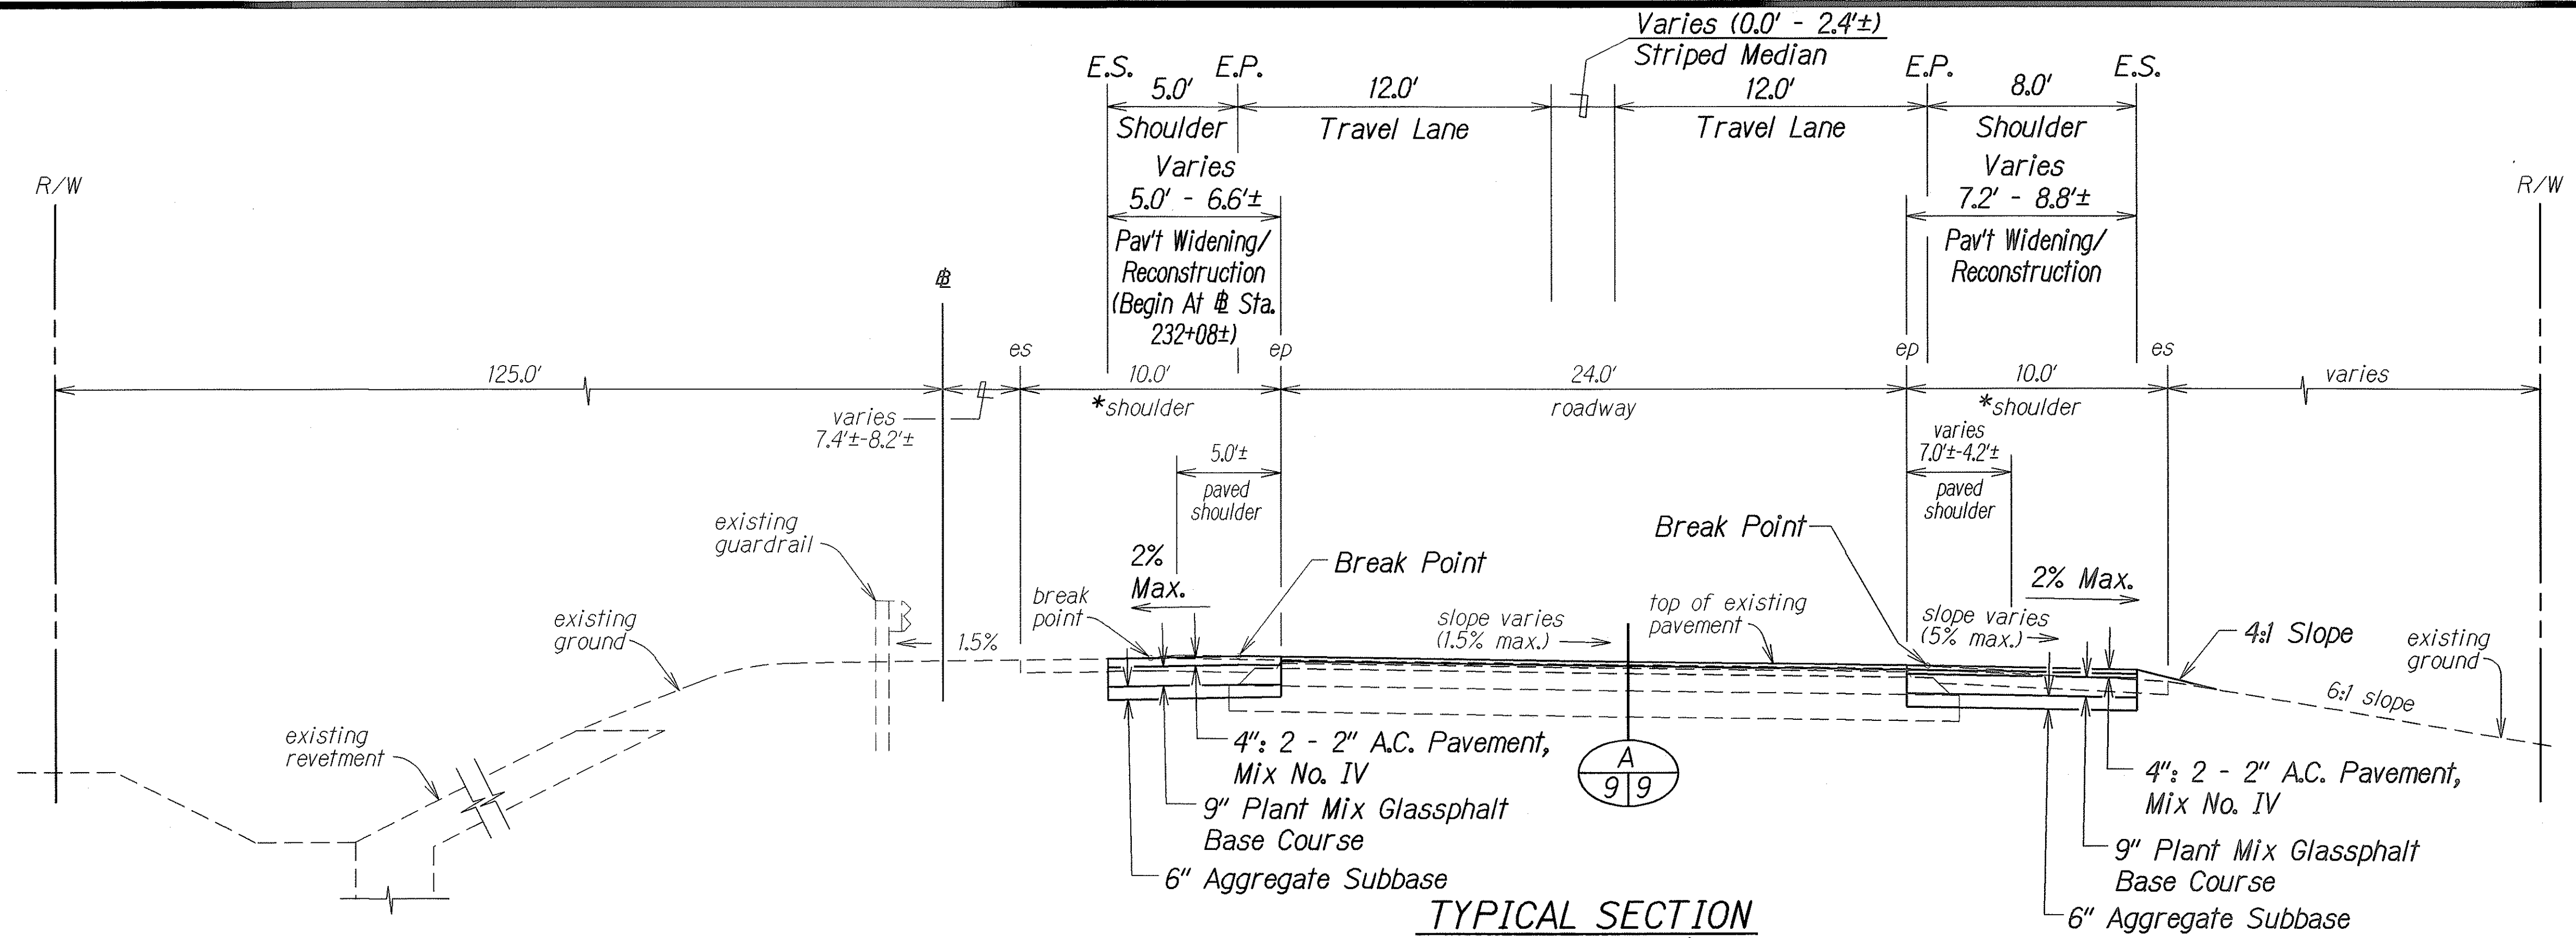

TYPICAL SECTION
BEGIN OF PROJECT TO STA. 232+75±
 Scale: 1/4" = 1'-0"

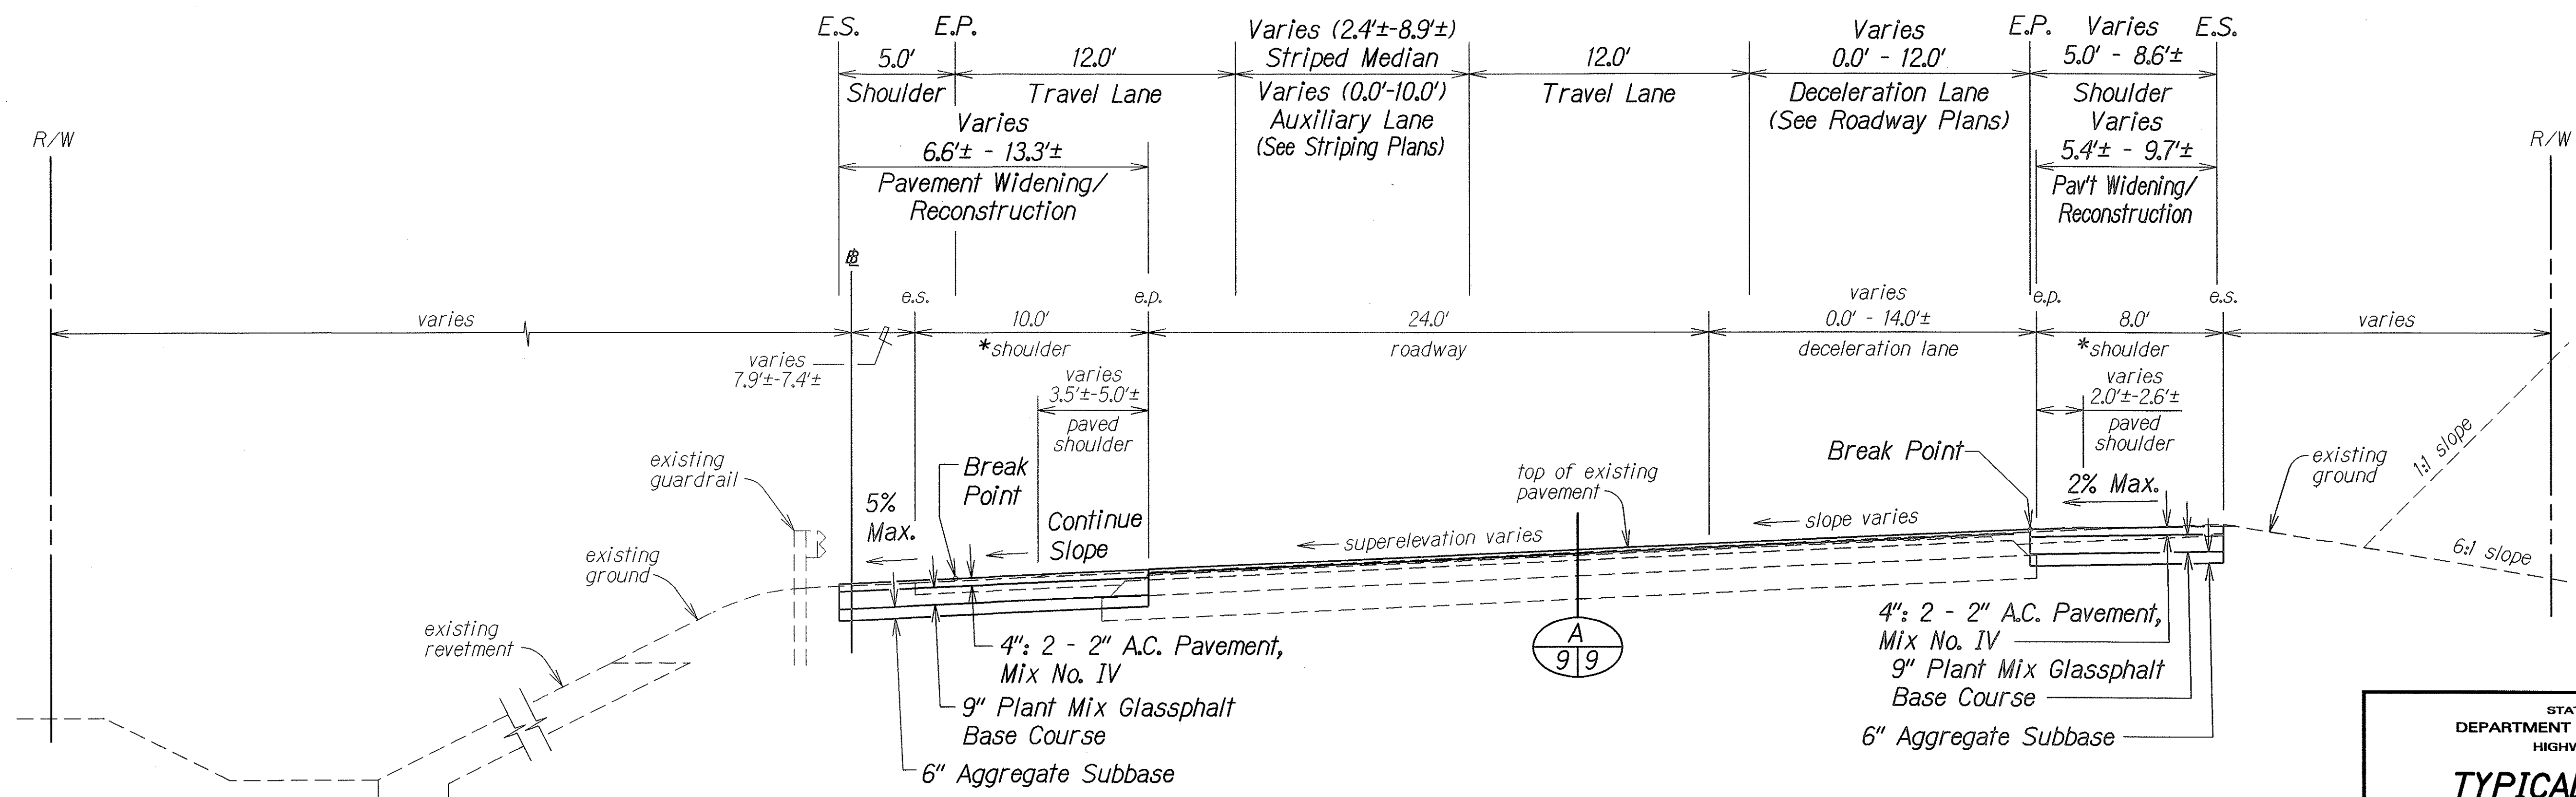

TYPICAL SECTION
STA. 232+75± TO STA. 236+00±
 Scale: 1/4" = 1'-0"

*Note: Existing 6" coral untreated base with bituminous seal coat

DESIGNED BY	DATE
DRAWN BY	
CHECKED BY	
NOTED BY	
QUANTITIES BY	
CHECKED BY	

6/19/06	Delete "Saw Cut" Note.
DATE	REVISION


STATE OF HAWAII
 DEPARTMENT OF TRANSPORTATION
 HIGHWAYS DIVISION

TYPICAL SECTIONS
KAMEHAMEHA HIGHWAY
Intersection Improvements At
Kaheki Highway
Project No. 83F-01-99


Scale: As Shown Date: November, 2005

SHEET No. 1 OF 4 SHEETS


FED. ROAD DIST. NO.	STATE	PROJ. NO.	FISCAL YEAR	SHEET NO.	TOTAL SHEETS
HAWAII	HAW.	83F-01-99	2006	ADD.10	28

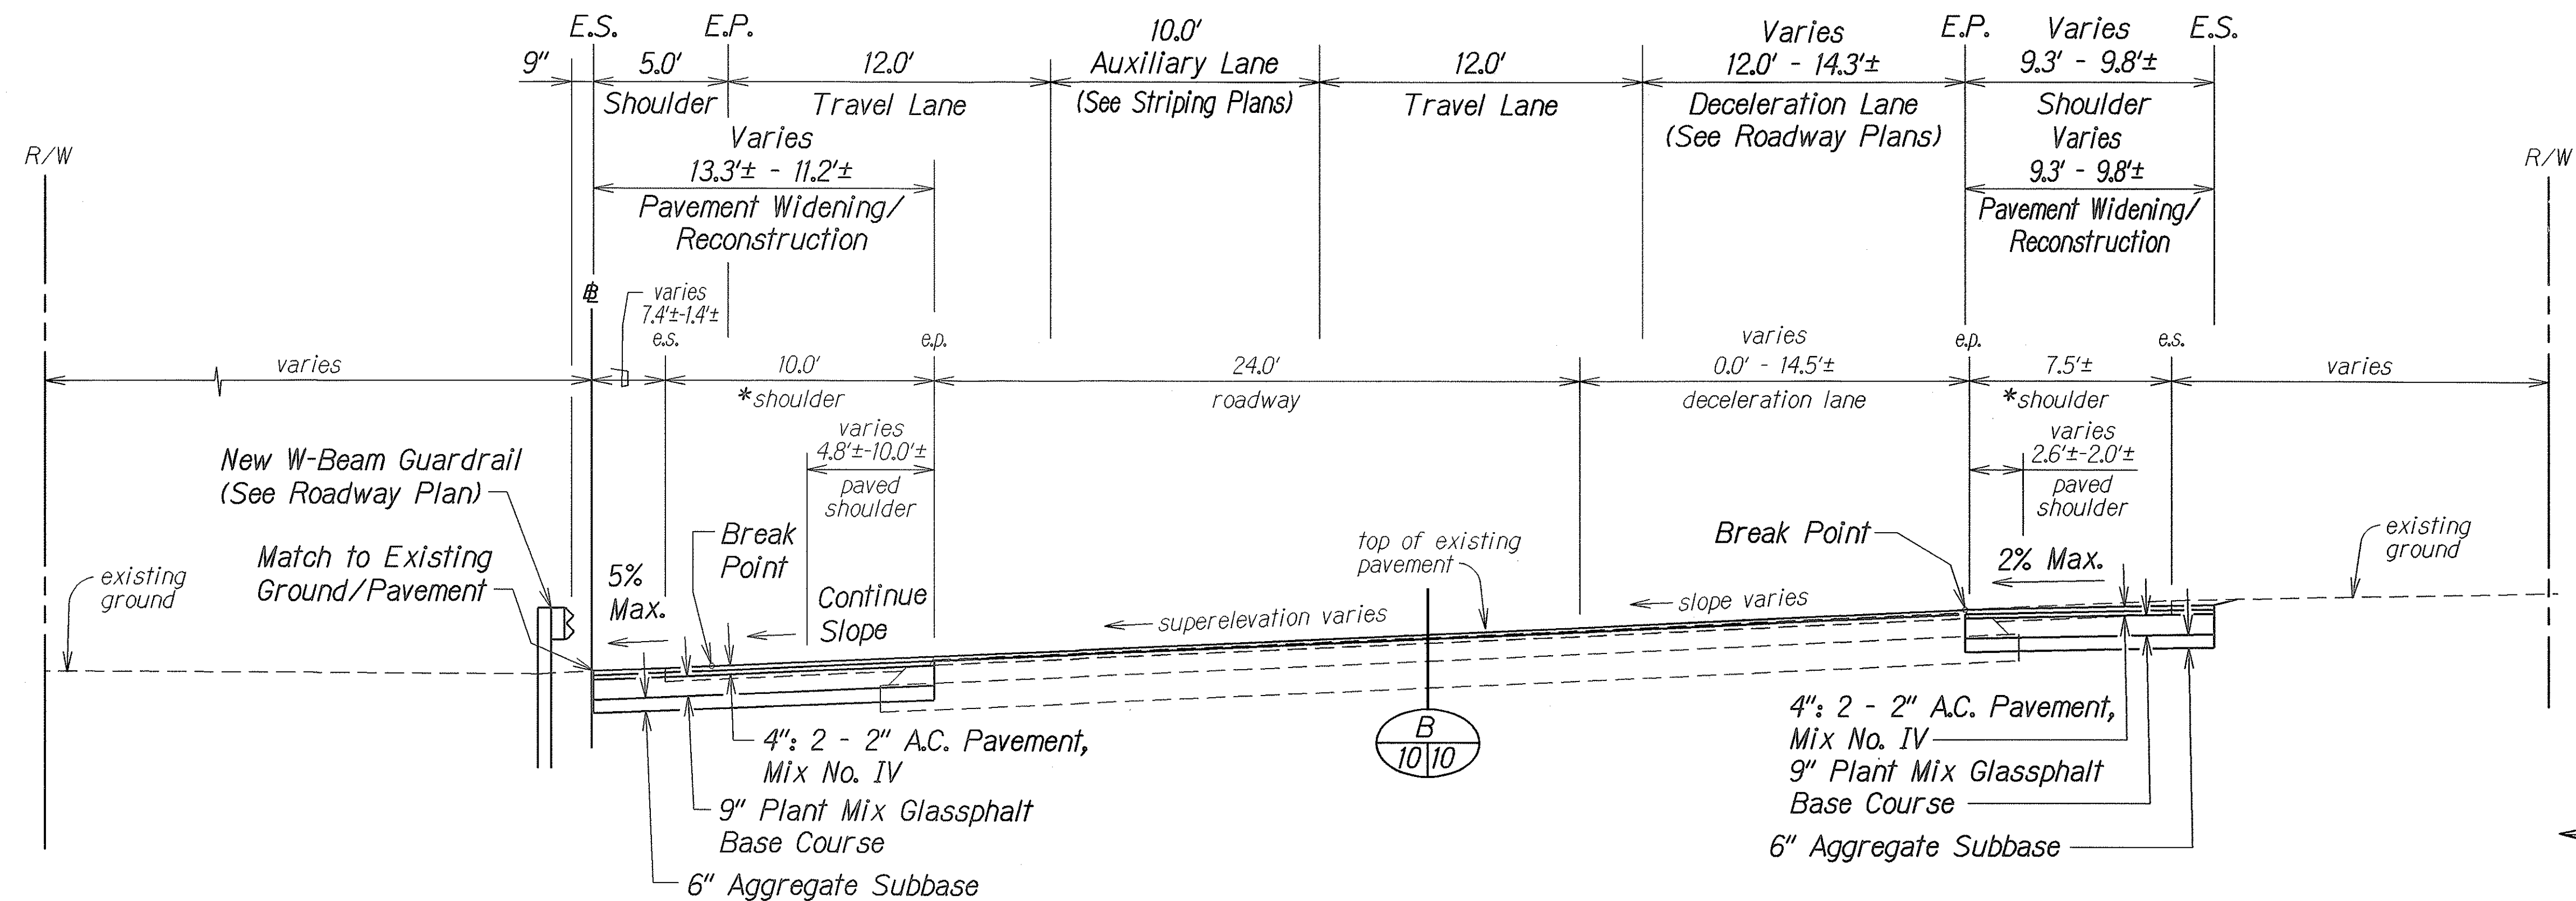

TYPICAL SECTION
 STA. 236+00± TO STA. 236+88±
 Scale: 1/4" = 1'-0"

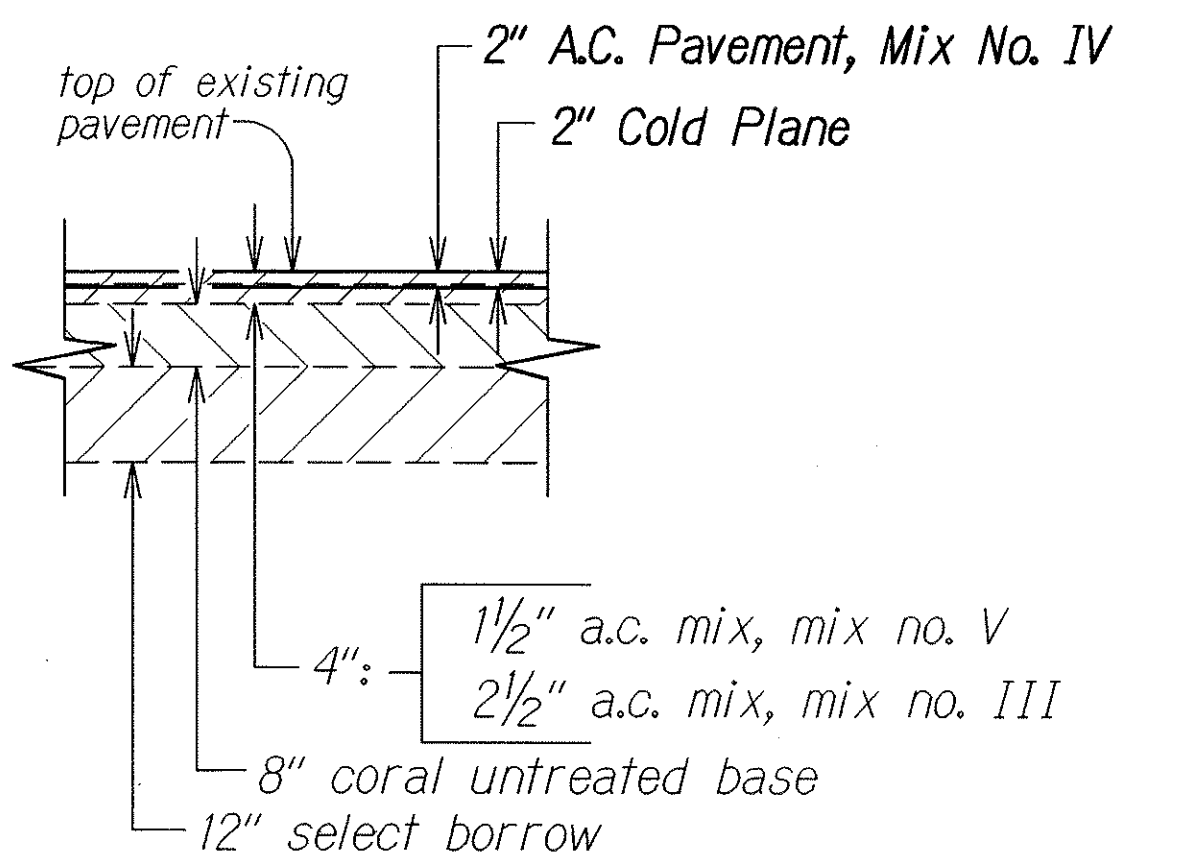

SECTION "B"
 Scale: 1/2" = 1'-0"

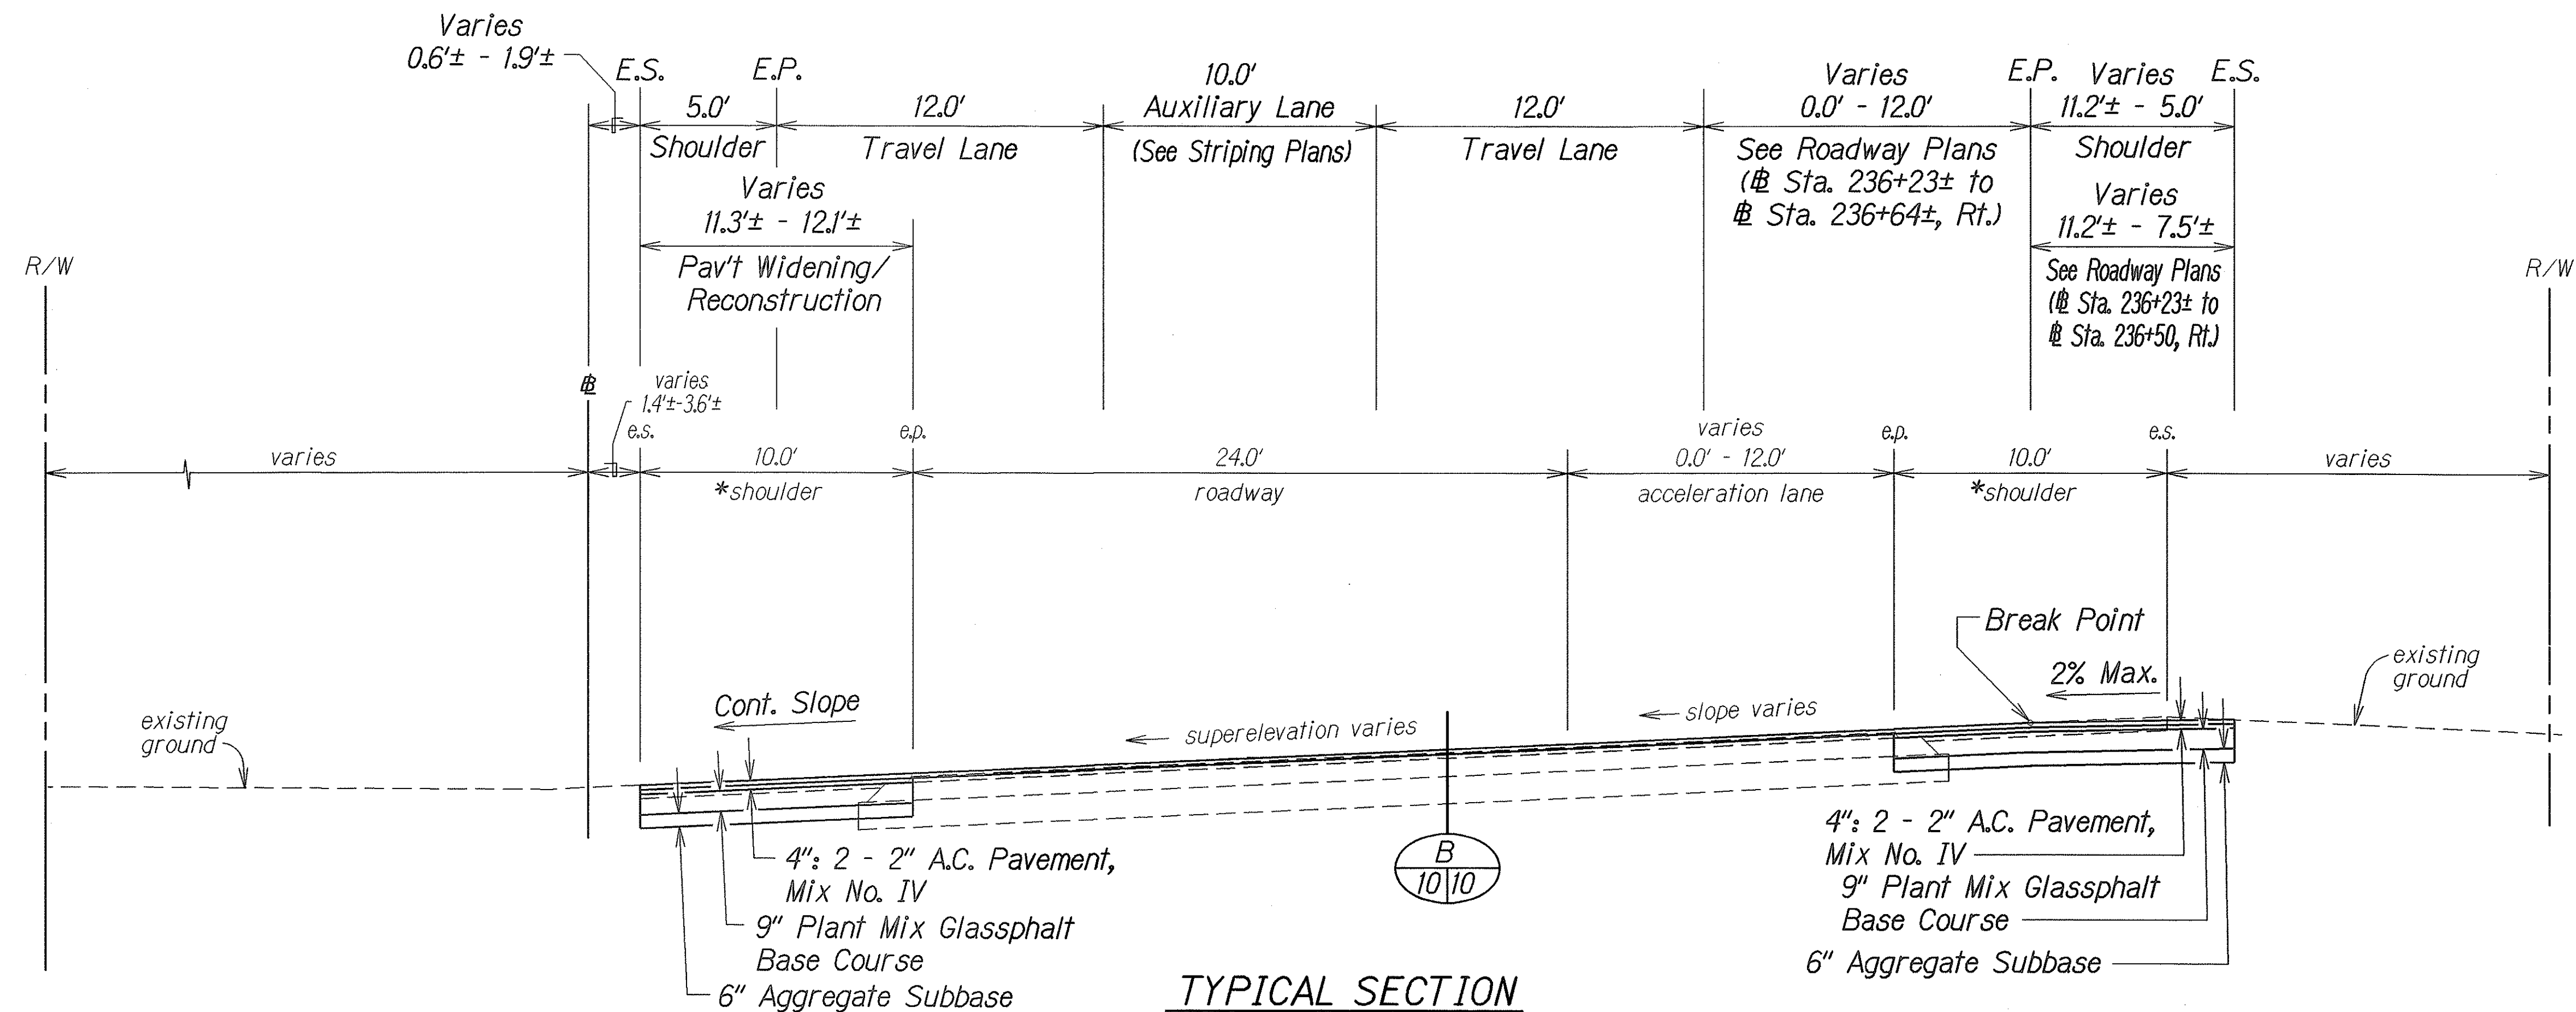

TYPICAL SECTION
 STA. 236+88± TO STA. 238+64±
 Scale: 1/4" = 1'-0"

*Note: Existing 6" coral untreated base with bituminous seal coat

DATE	10/10/05
SURVEY PLOTTED BY	Y
DRAWN BY	Y
TRACED BY	Y
NOTE BOOK	601-1
QUANTITIES BY	Y
CHECKED BY	Y

6/19/06 Delete "Saw Cut" Note.

DATE REVISION

STATE OF HAWAII
 DEPARTMENT OF TRANSPORTATION
 HIGHWAYS DIVISION

TYPICAL SECTIONS

KAMEHAMEHA HIGHWAY

Intersection Improvements At

Kahekili Highway


Project No. 83F-01-99

Scale: As Shown Date: November, 2005

SHEET No. 2 OF 4 SHEETS


ADD.10

FED. ROAD DIST. NO.	STATE	PROJ. NO.	FISCAL YEAR	SHEET NO.	TOTAL SHEETS
HAWAII	HAW.	83F-01-99	2006	ADD.11	28

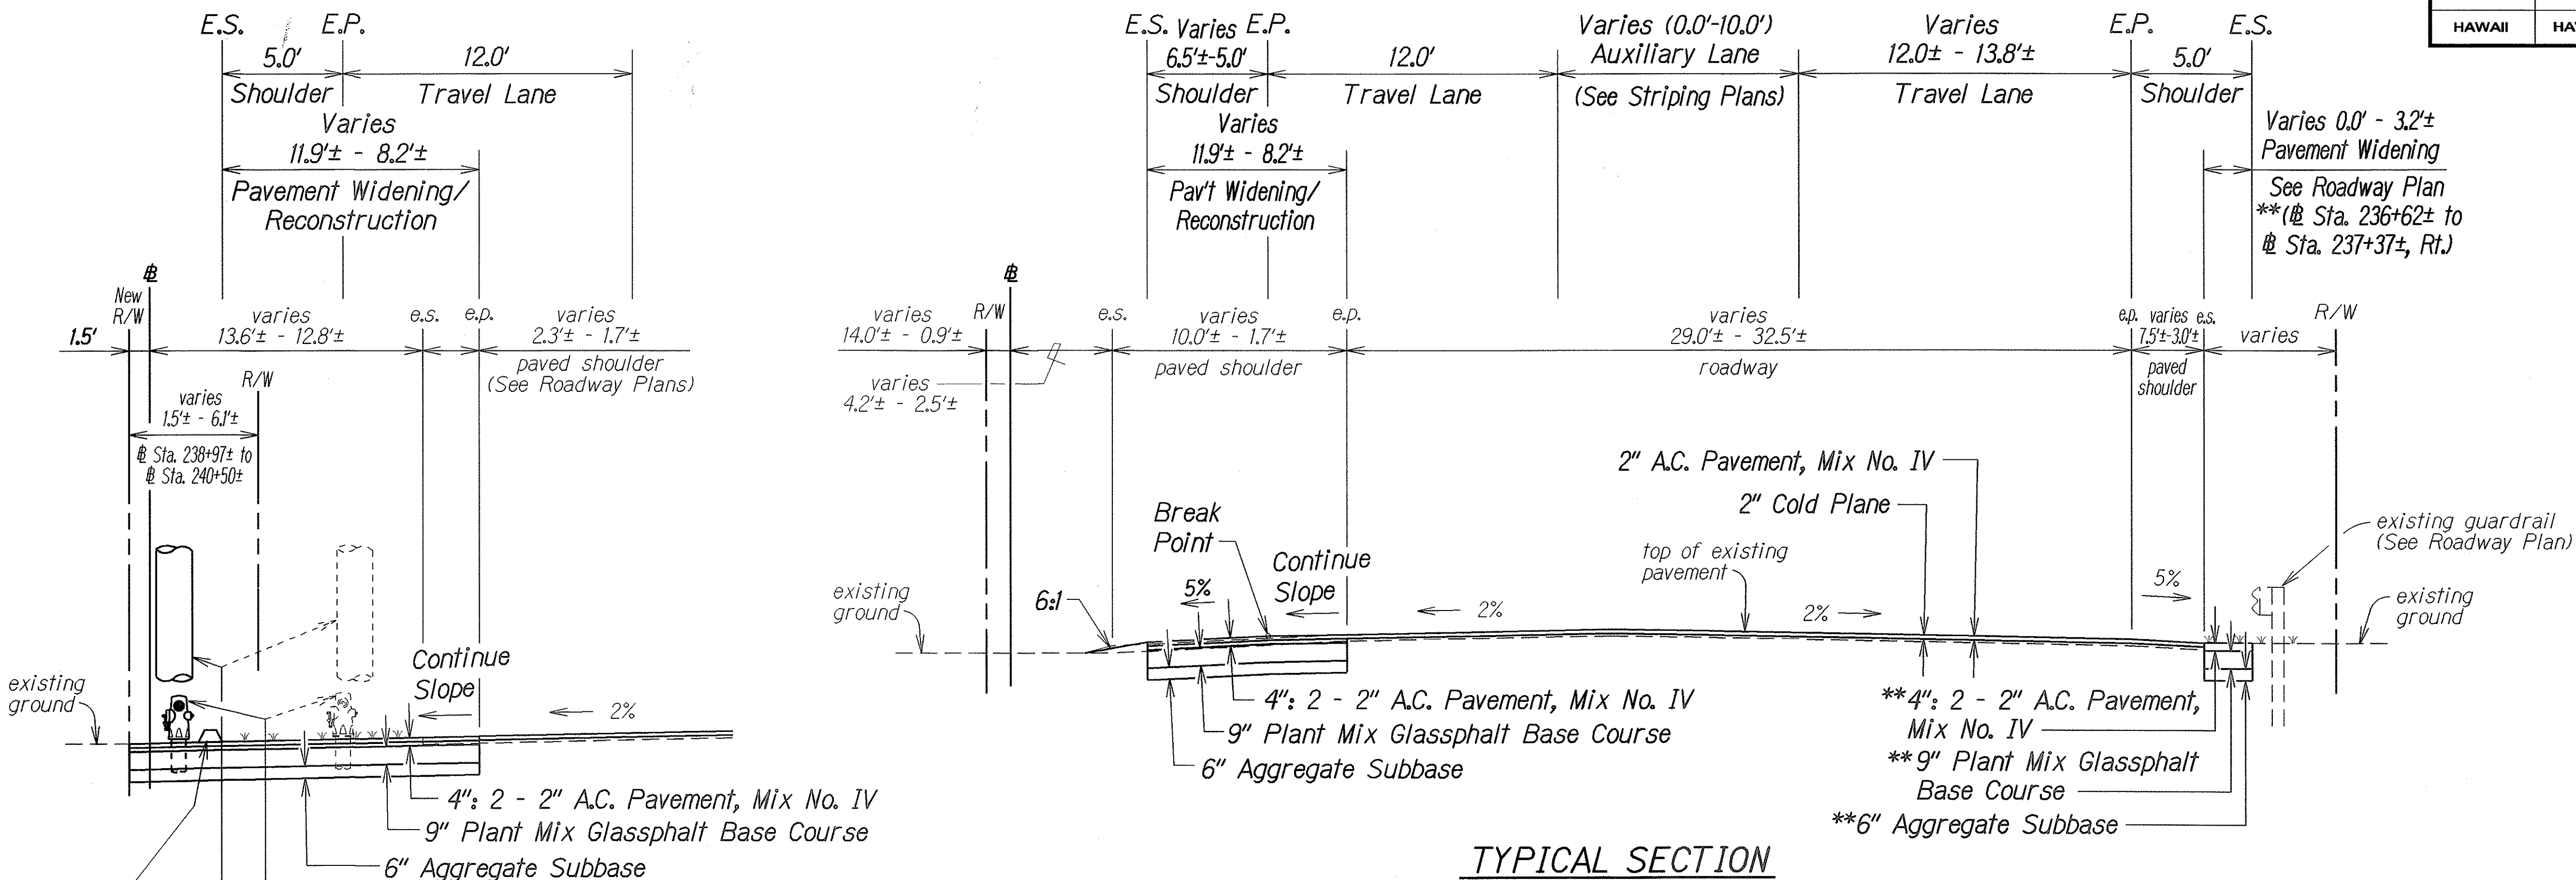

TYPICAL SECTION
 # STA. 238+64± TO # STA. 240+64.51 (Back)
 Scale: 1/4" = 1'-0"

PARTIAL TYPICAL SECTION
 # STA. 239+60± TO # STA. 240+10±, Rt.
 Scale: 1/4" = 1'-0"

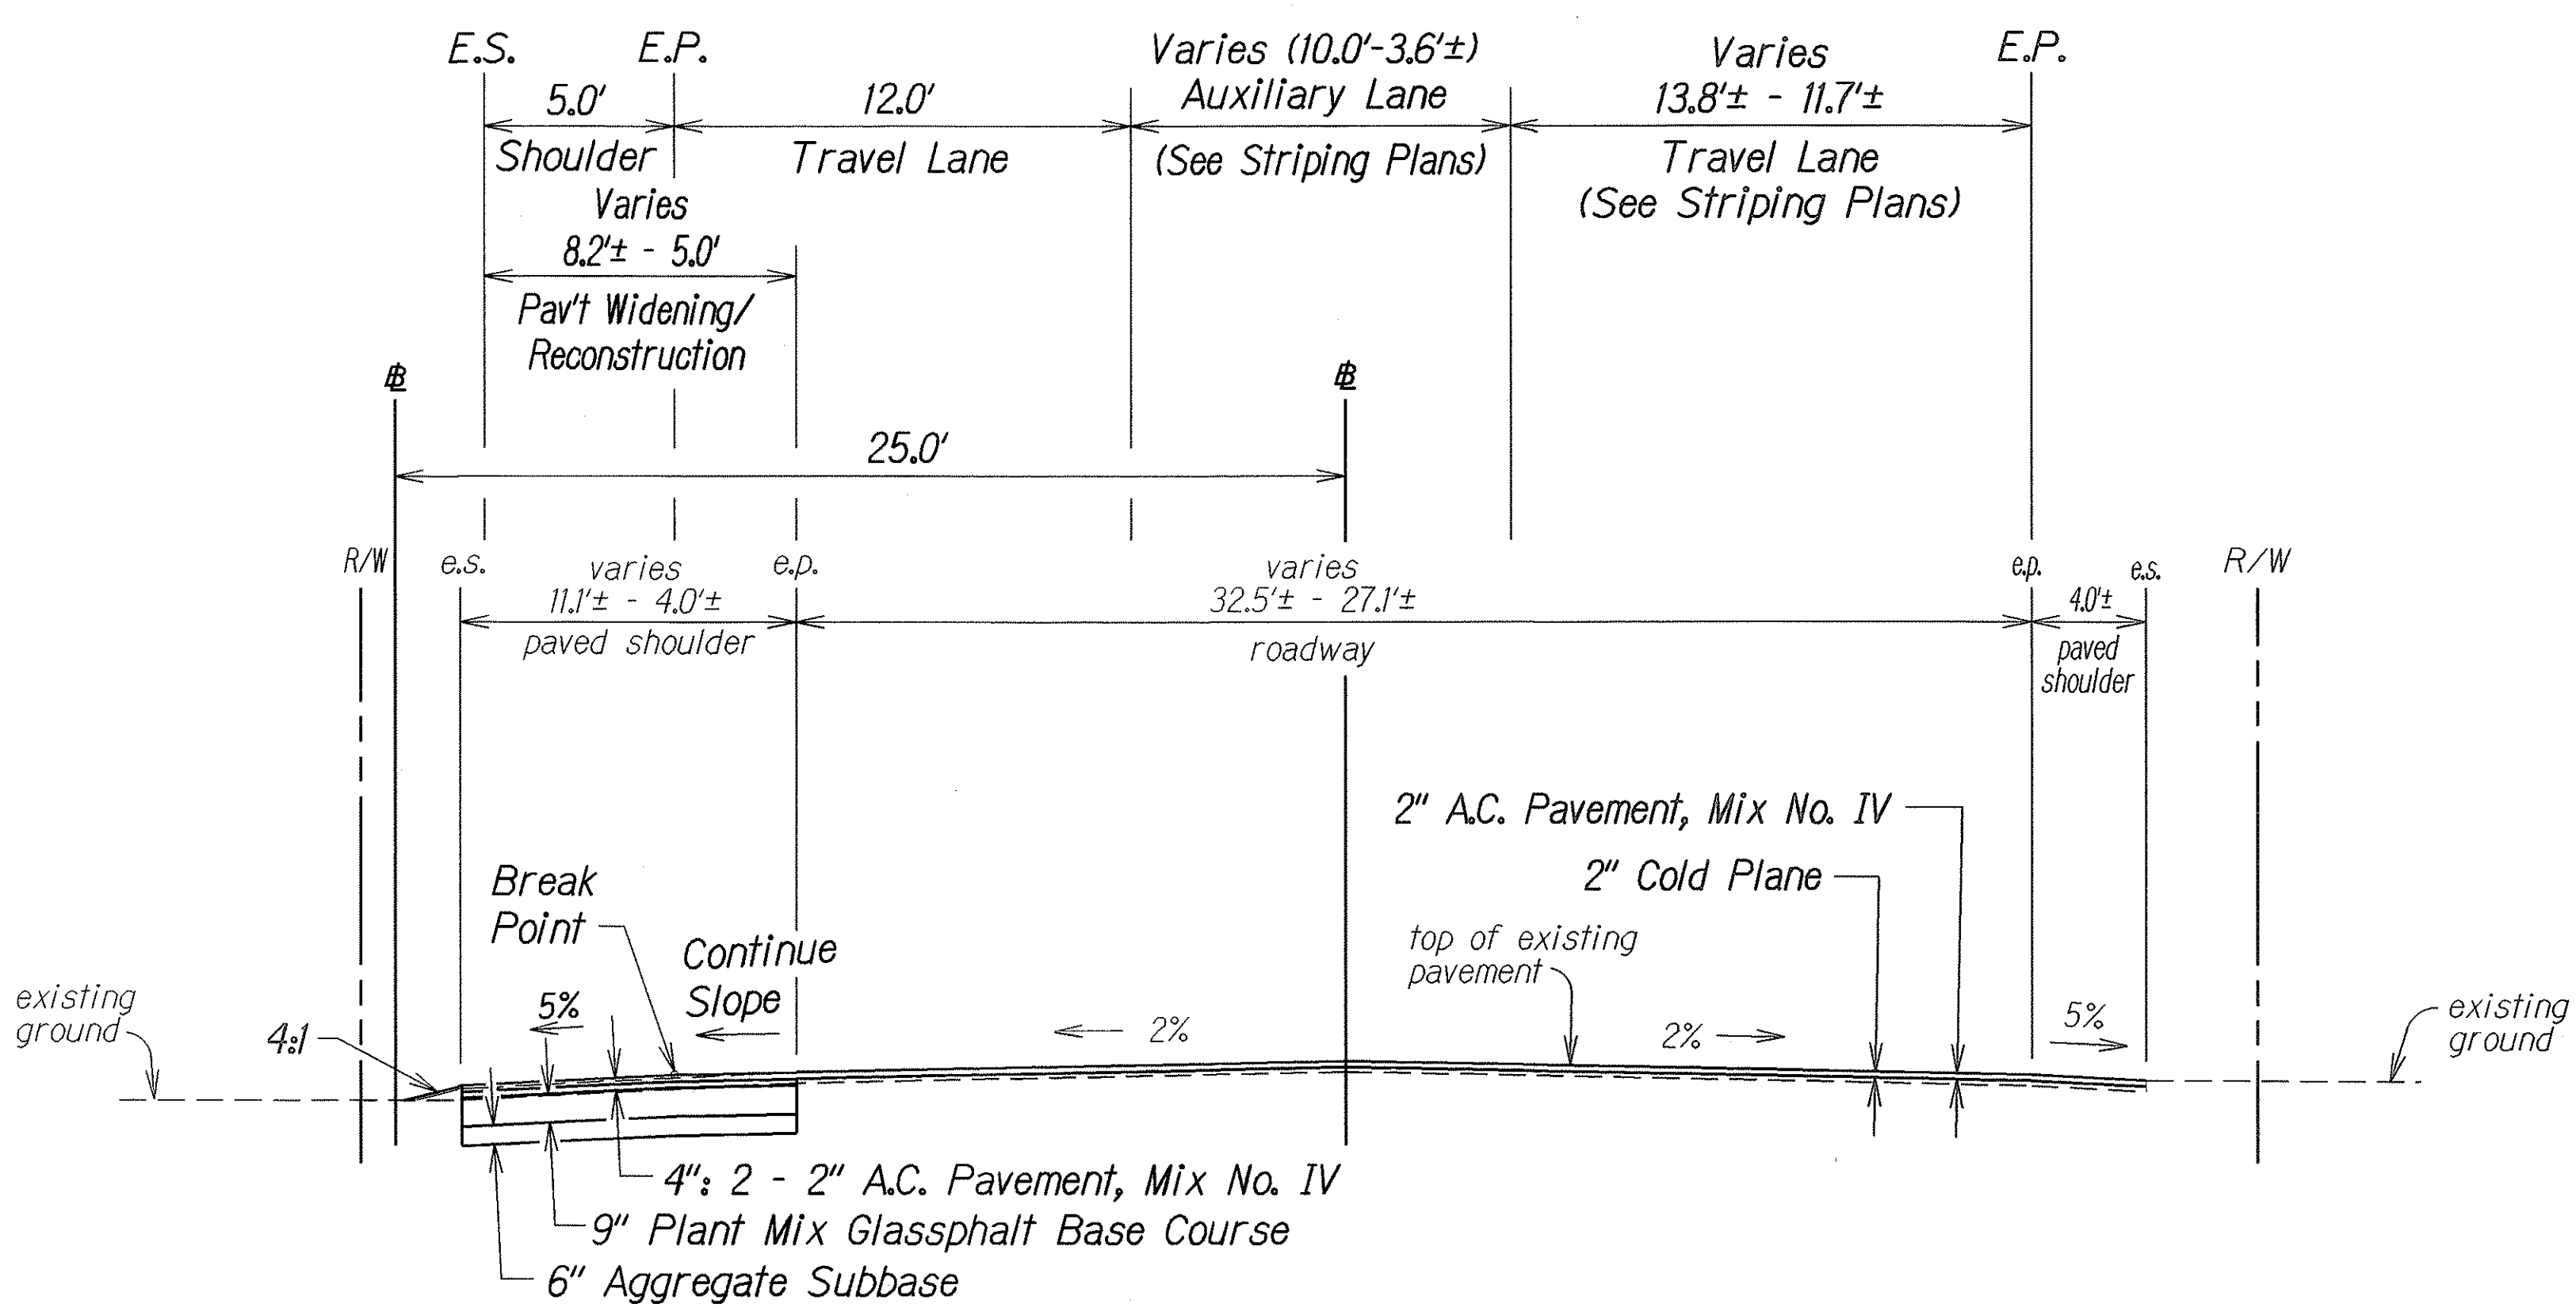


TYPICAL SECTION
 # STA. 418+00.00 (Ahead) TO END OF PROJECT
 Scale: 1/4" = 1'-0"


ORIGINAL PLAN	DATE
DRAWN BY	
DESIGNED BY	
CHECKED BY	
NOTED BY	
DATE	

6/19/06	Delete "Saw Cut" Note.
DATE	REVISION
STATE OF HAWAII DEPARTMENT OF TRANSPORTATION HIGHWAYS DIVISION TYPICAL SECTIONS KAMEHAMEHA HIGHWAY Intersection Improvements At Kahekili Highway Project No. 83F-01-99 Scale: As Shown Date: November, 2005 SHEET No. 3 OF 4 SHEETS	

FED. ROAD DIST. NO.	STATE	PROJ. NO.	FISCAL YEAR	SHEET NO.	TOTAL SHEETS
HAWAII	HAW.	83F-01-99	2006	ADD.12	27

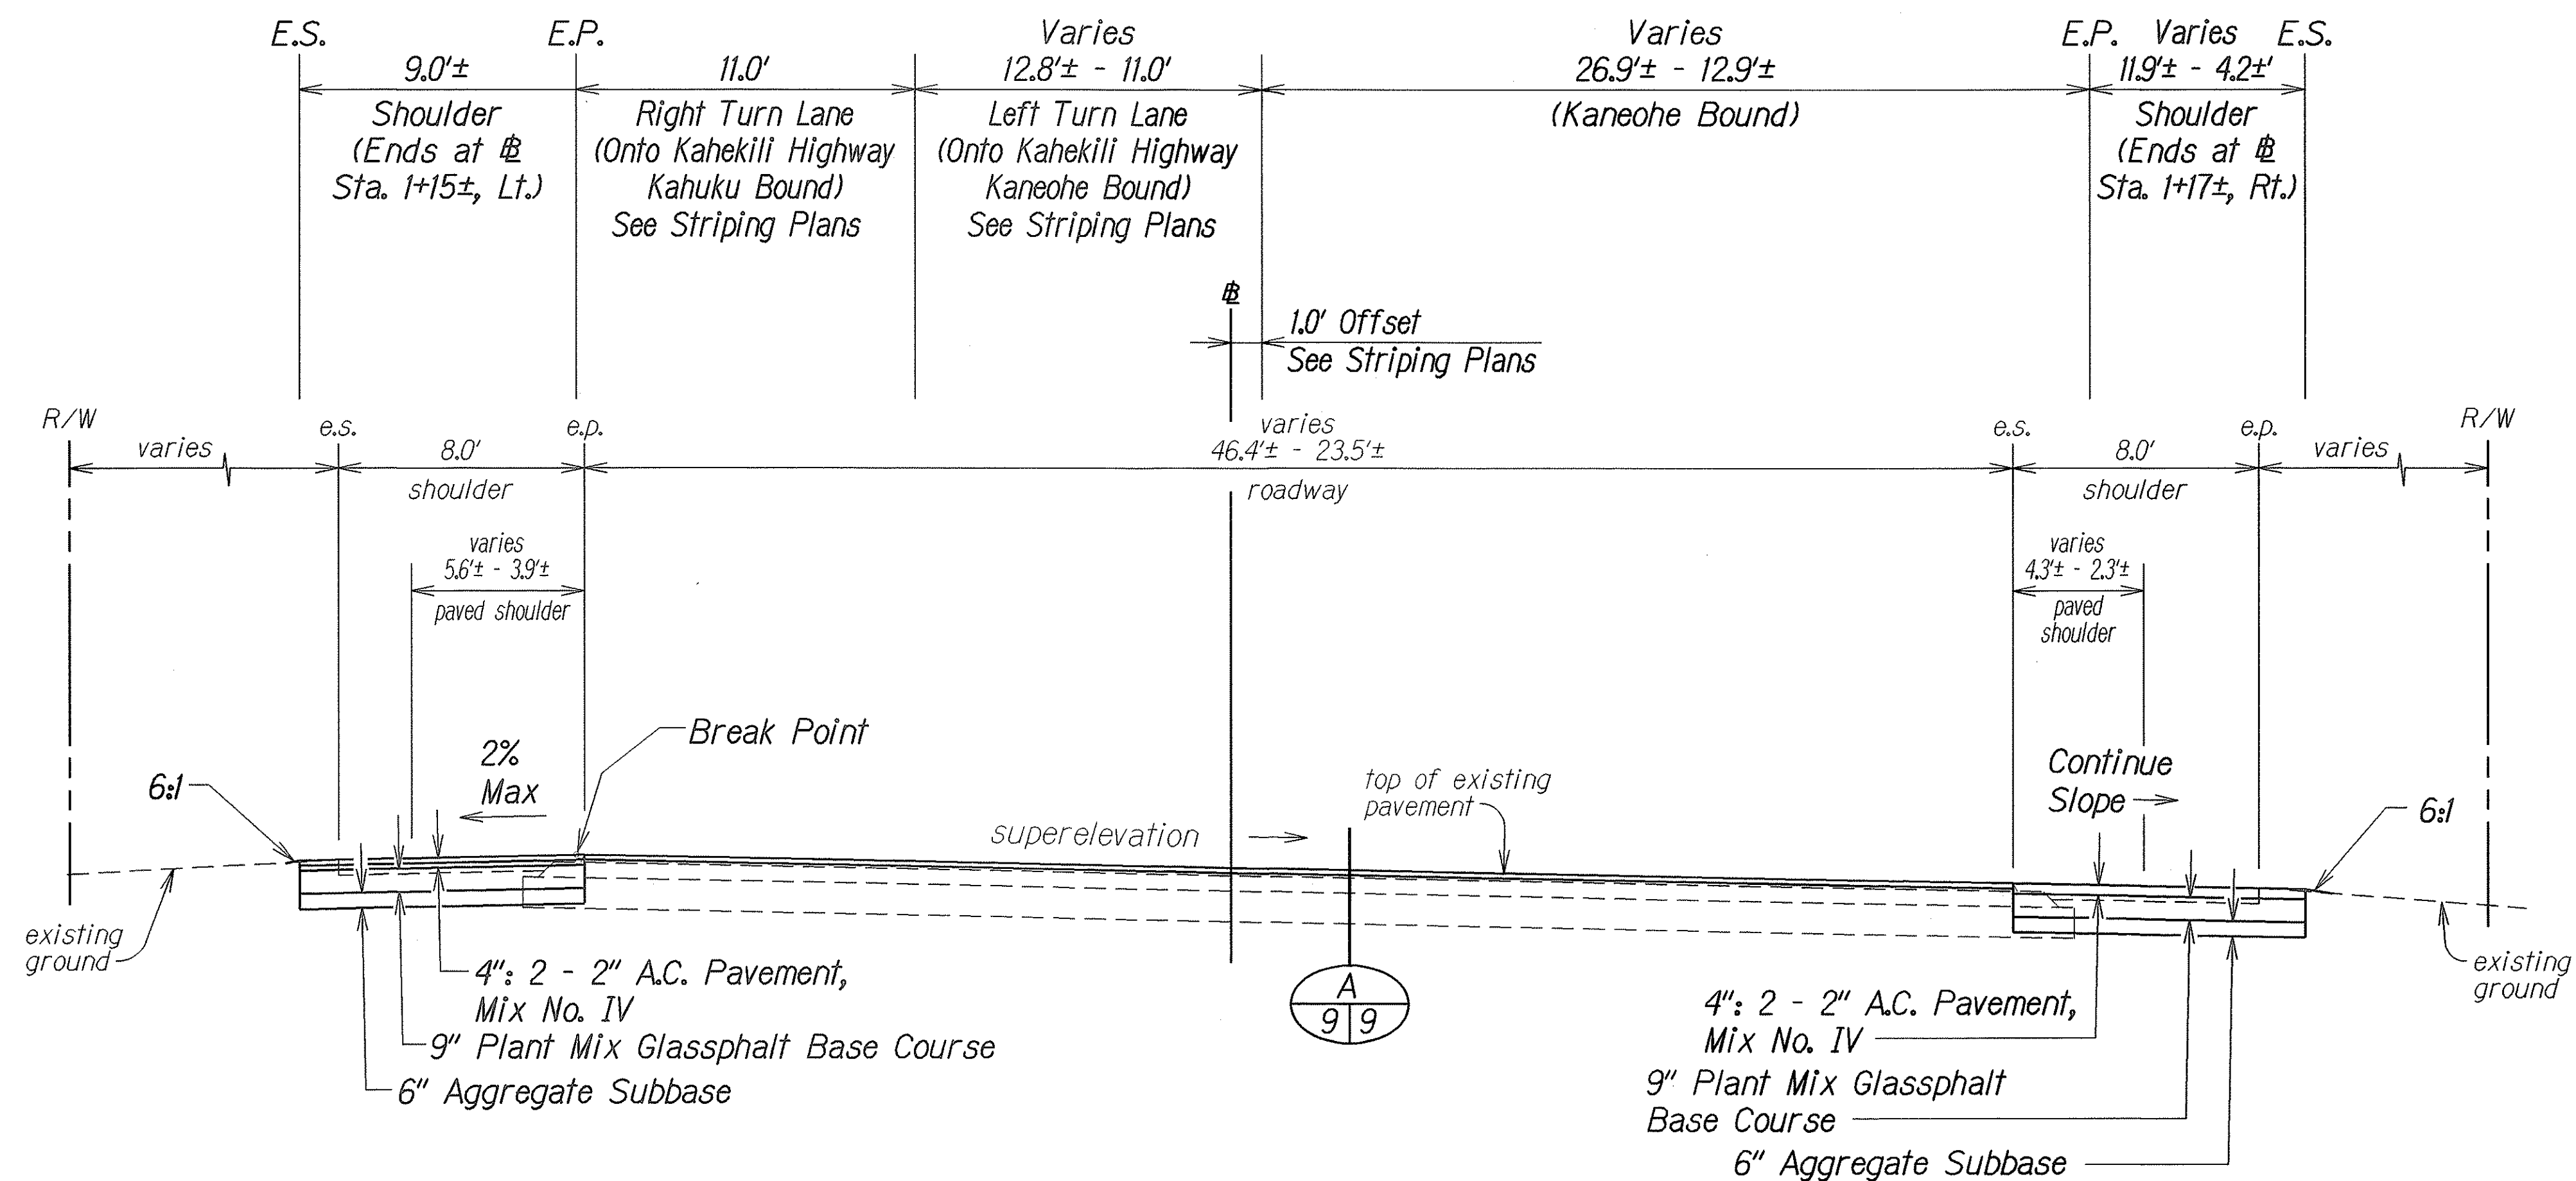


TYPICAL SECTION
KAMEHAMEHA HIGHWAY
± STA. 0+76± TO ± STA. 1+18±
 Scale: 1/4" = 1'-0"

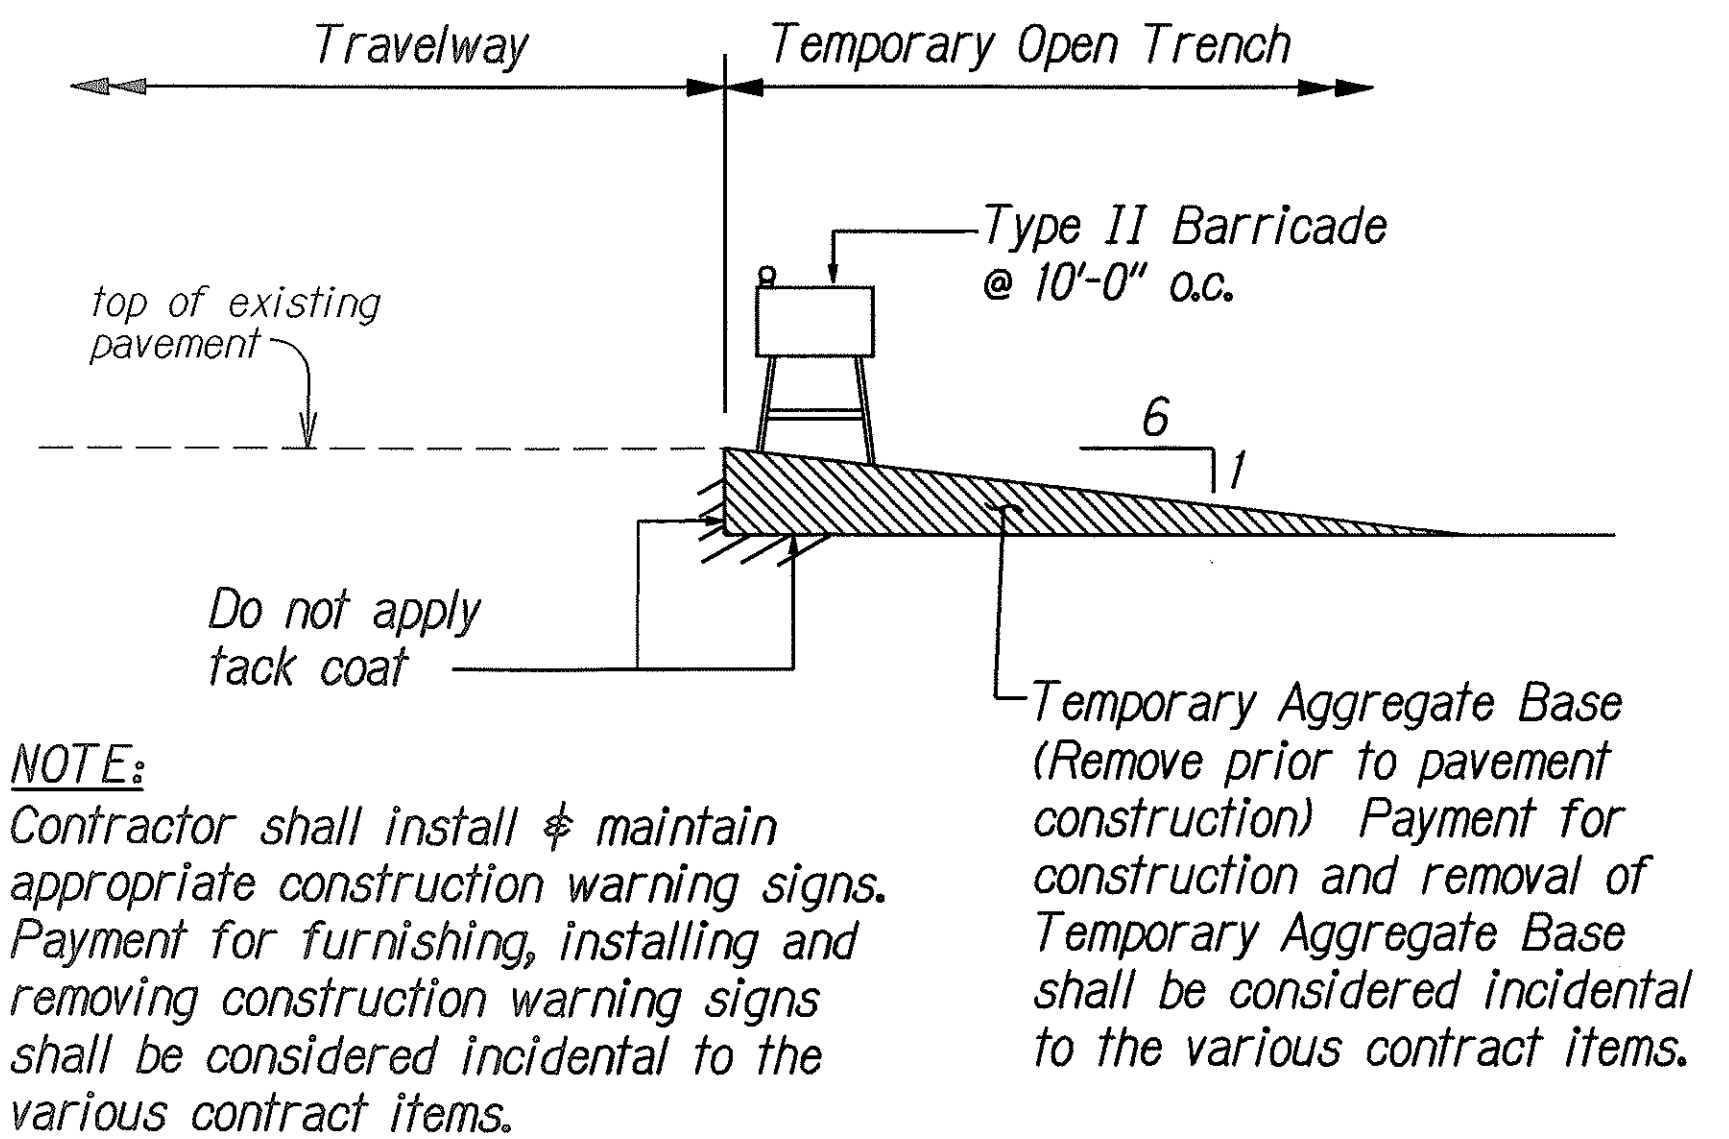


TRANSITION TAPER DETAIL
 Not to Scale

NOTE:
 Contractor shall install & maintain appropriate construction warning signs. Payment for furnishing, installing and removing construction warning signs shall be considered incidental to the various contract items.

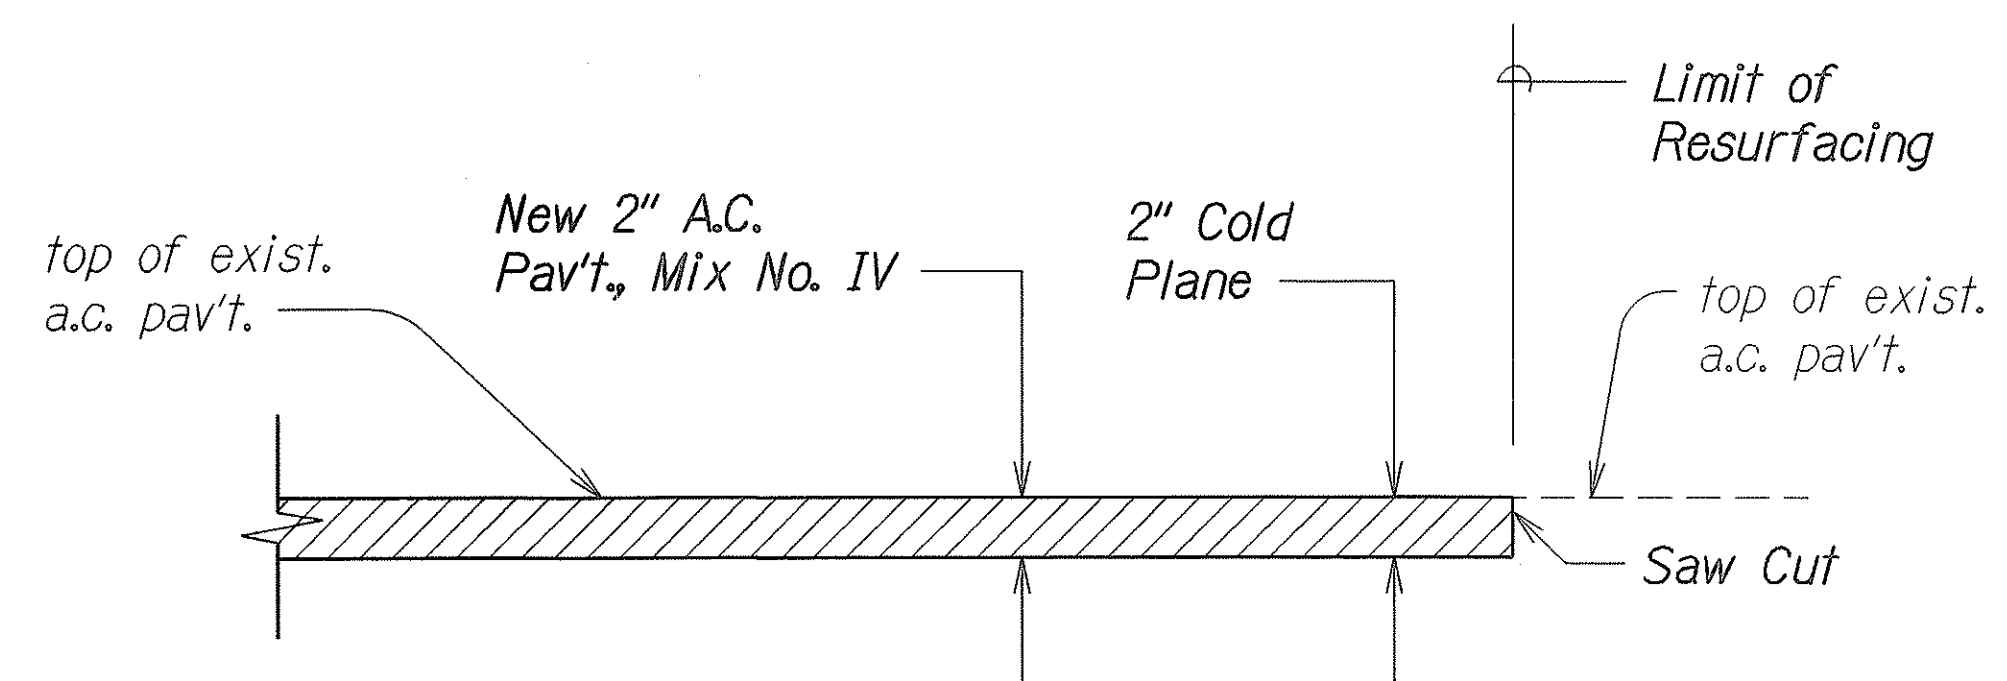

COLD PLANING TRANSITION
TO EXISTING PAVEMENT DETAIL
 Not to Scale

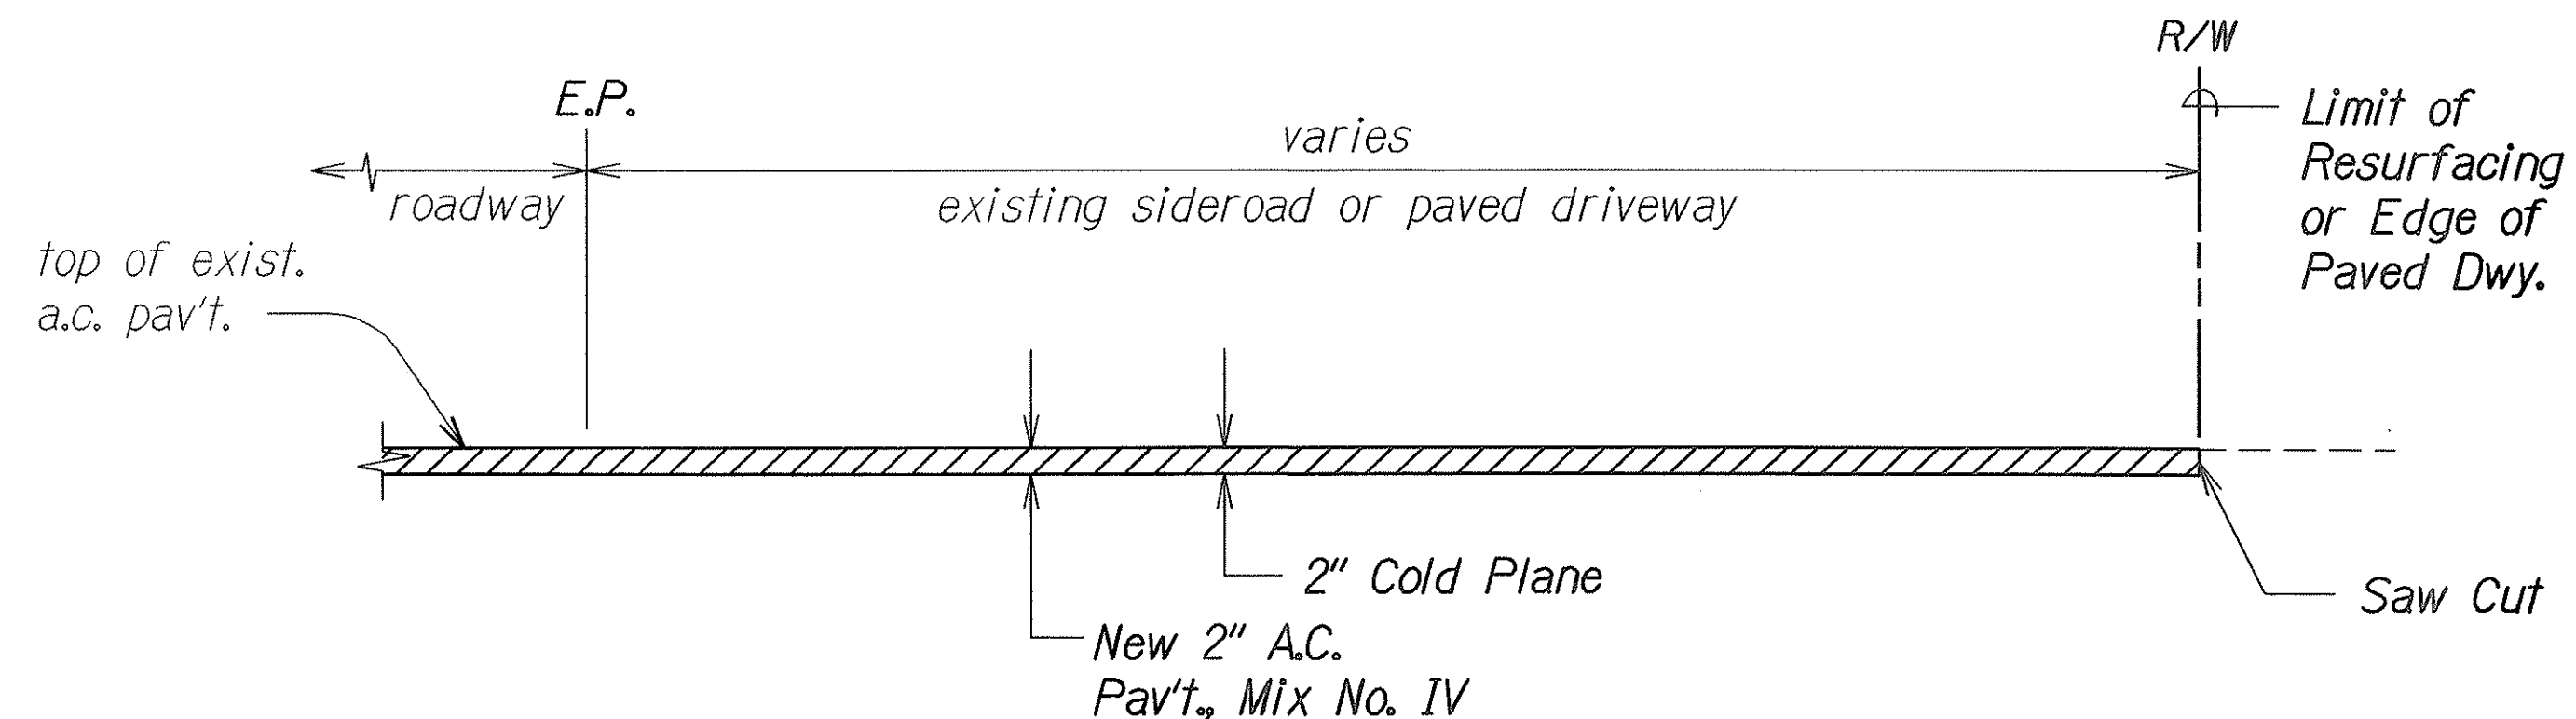

RESURFACING AT PAVED SIDEROAD
OR PAVED DRIVEWAY DETAIL
 Not to Scale

6/19/06	Delete "Saw Cut" Note. Added Transition Taper Detail.
DATE	REVISION
STATE OF HAWAII DEPARTMENT OF TRANSPORTATION HIGHWAYS DIVISION TYPICAL SECTIONS KAMEHAMEHA HIGHWAY Intersection Improvements At Kahekili Highway Project No. 83F-01-99 Scale: As Shown Date: November, 2005 SHEET No. 4 OF 4 SHEETS	