

		GUARDRAIL SUMMARY				
		Number	61701-4950	61702-0000	61703-0000	61707-0000
Location		Side	GUARDRAIL SYSTEM MGS, TYPE 3, CLASS B STEEL POSTS	TERMINAL SECTION	TERMINAL END	STRUCTURE TRANSITION RAILING
			LNFT	EACH	EACH	LNFT
Nanahu	West Approach	LT	39	1	1	25
		RT	113	1	1	25
	Bridge					
	East Approach	LT	39	1	1	25
Kawela		RT	113	1	1	25
	West Approach	LT	122	1	1	25
		RT	94	1	1	25
	Bridge					
	East Approach	LT	70	1	1	25
		RT	14	1	1	25
		TOTAL	603	8	8	200

MISCELLANEOUS ITEMS SUMMARY					
Item Number	61901-0000	FIO	63620-0000	FIO	61102-3545
Location	FENCE	CONDUIT 4-INCH	POLE	NETCOM Manhole	12-INCH WATERLINE
	LNFT	LPSM	EACH	LPSM	LNFT
Nanahu	235	LPSM	2	LPSM	320
Kawela	112	LPSM	4	LPSM	0
TOTAL	347	ALL	6	ALL	320

- Note(s):
1.

The quantities shown here are approximate and are subject to field adjustment.
2.

See C Series, sheet V5, and W Series for location(s).


THESE PLANS HAVE BEEN PREPARED UTILIZING INFORMATION PROVIDED BY THE PROJECT CONTRACTOR. THE UPDATED CONSTRUCTION INFORMATION DEPICTED HEREIN HAS NOT BEEN VERIFIED FOR ACCURACY AND COMPLETENESS. NO REPRESENTATION IS BEING MADE TO ITS VALIDITY.

DRAINAGE & EROSION CONTROL SUMMARY			
Location	15705-1500	15706-1600	Remarks
	SOIL EROSION CONTROL, COMPOST SOCK	SOIL EROSION CONTROL, STABILIZED CONSTRUCTION EXIT	
	LNFT	EACH	
Nanahu	1452	2	
Kawela	1677	2	
Project Total	3129	4	

- Note(s):
1.

The quantities shown here are approximate and are subject to field adjustment.
2.

See sheet E1 for Erosion and Sediment Control Plan.

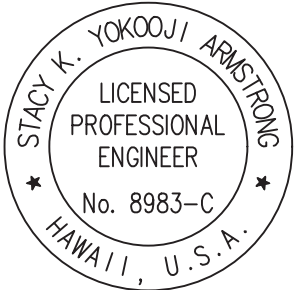

EXPIRATION DATE 04/30/2020

Stacy K. Yokooji

THIS WORK WAS PREPARED BY ME OR UNDER MY SUPERVISION AND CONSTRUCTION OF THIS PROJECT WILL BE UNDER MY OBSERVATION.

U.S. DEPARTMENT OF TRANSPORTATION
FEDERAL HIGHWAY ADMINISTRATION
CENTRAL FEDERAL LANDS HIGHWAY DIVISION

U.S. CUSTOMARY

**DRAINAGE & EROSION
CONTROL AND
MISCELLANEOUS
SUMMARIES**