
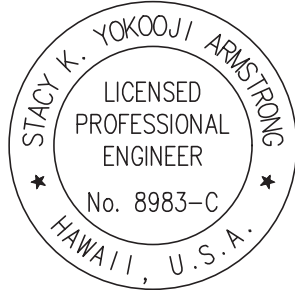


STATE	PROJECT	SHEET NO.
HI	HI STP SR 83(1) & (2)	C5

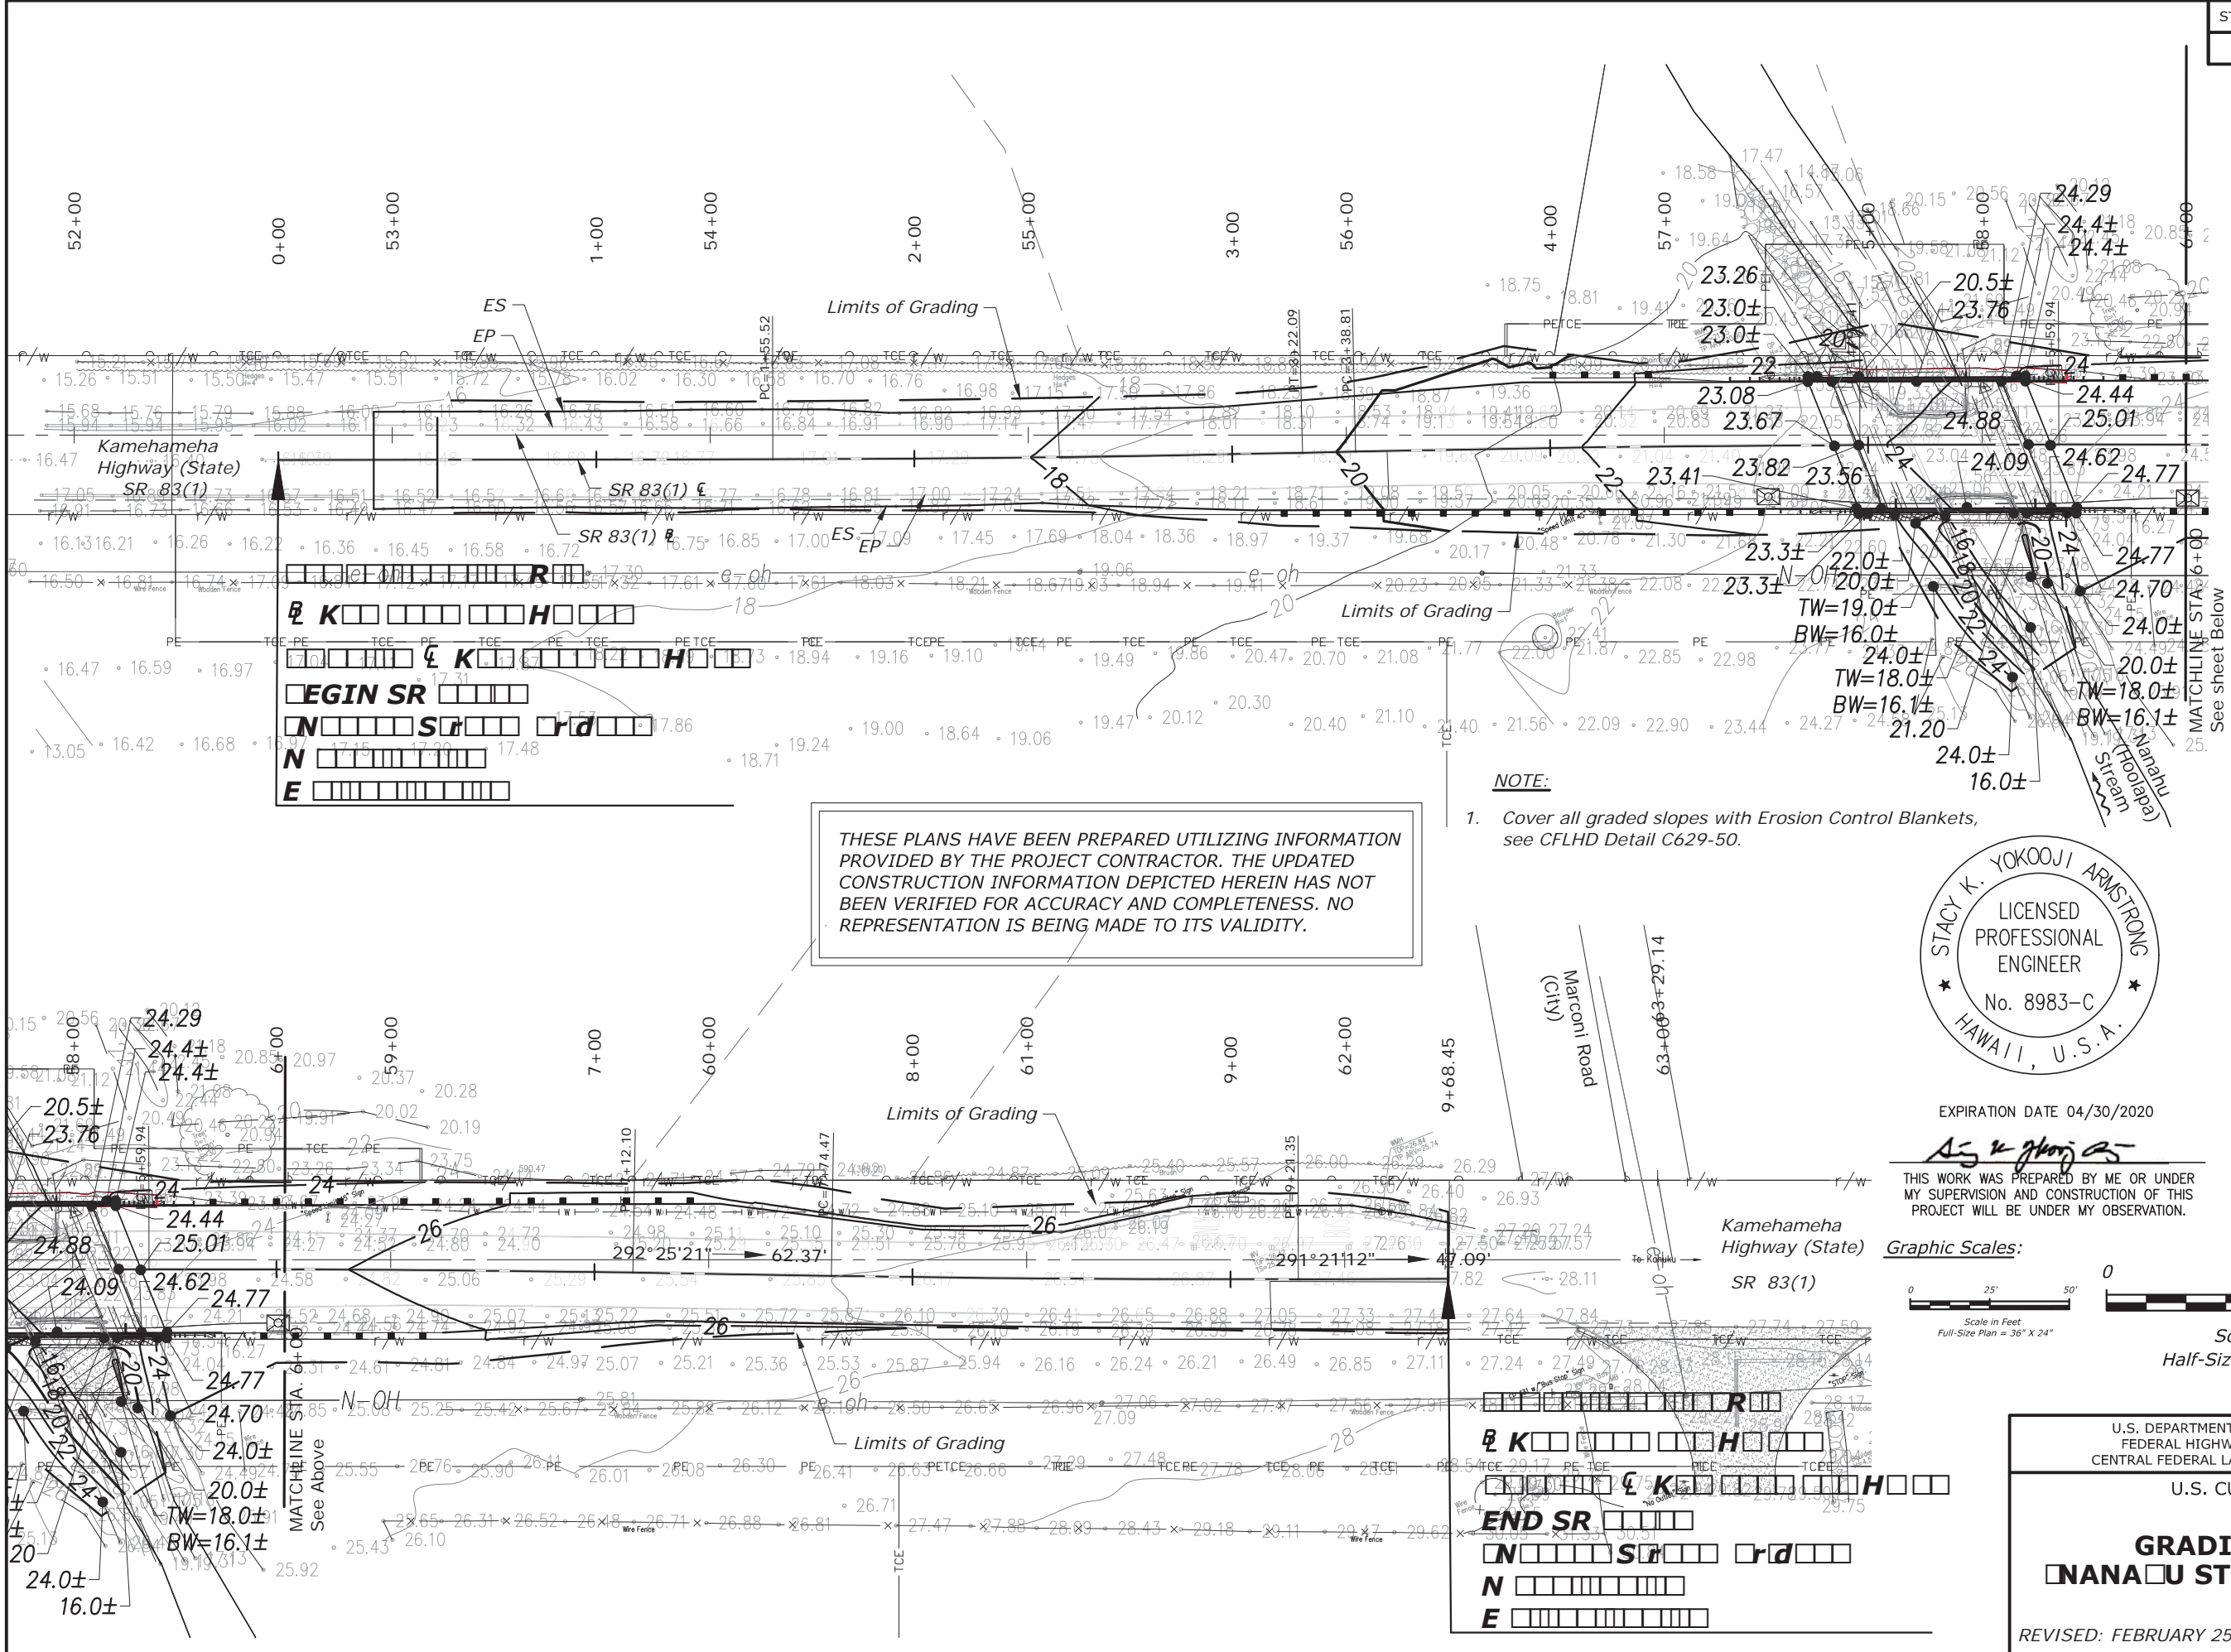

EXPIRATION DATE 04/30/2020

THIS WORK WAS PREPARED BY ME OR UNDER MY SUPERVISION AND CONSTRUCTION OF THIS PROJECT WILL BE UNDER MY OBSERVATION.

Graphic Scales:






U.S. DEPARTMENT OF TRANSPORTATION  
FEDERAL HIGHWAY ADMINISTRATION  
CENTRAL FEDERAL LANDS HIGHWAY DIVISION  
U.S. CUSTOMARY  
**GRADING PLAN**  
**NANA O STREAM BRIDGE**  
REVISED: FEBRUARY 25, 2020

12:09:44 PM K:\civil\123256 DB Kawela\_Nanahu Bridges\Drawings\Base Dwg5


AS-BUILT DRAWINGS



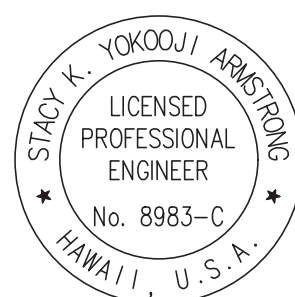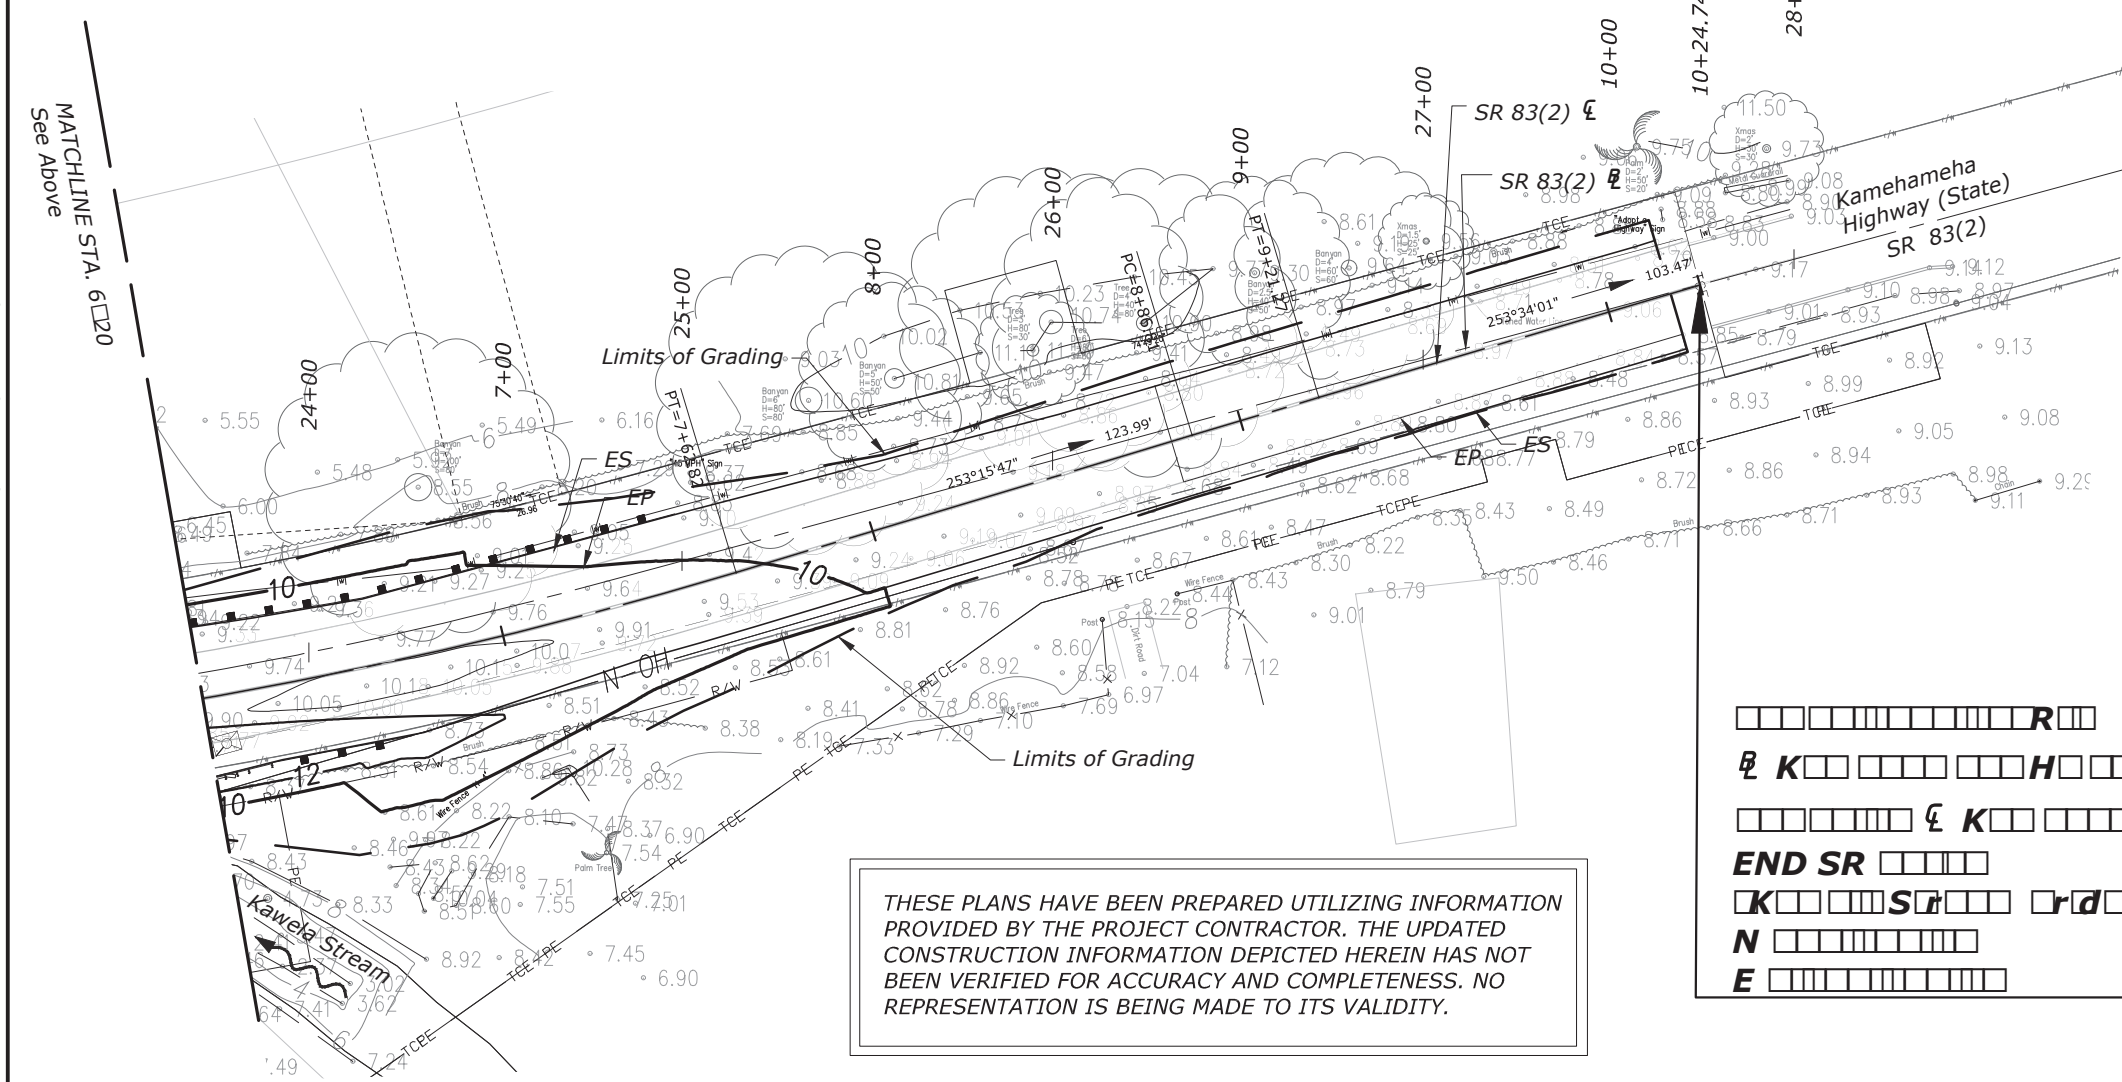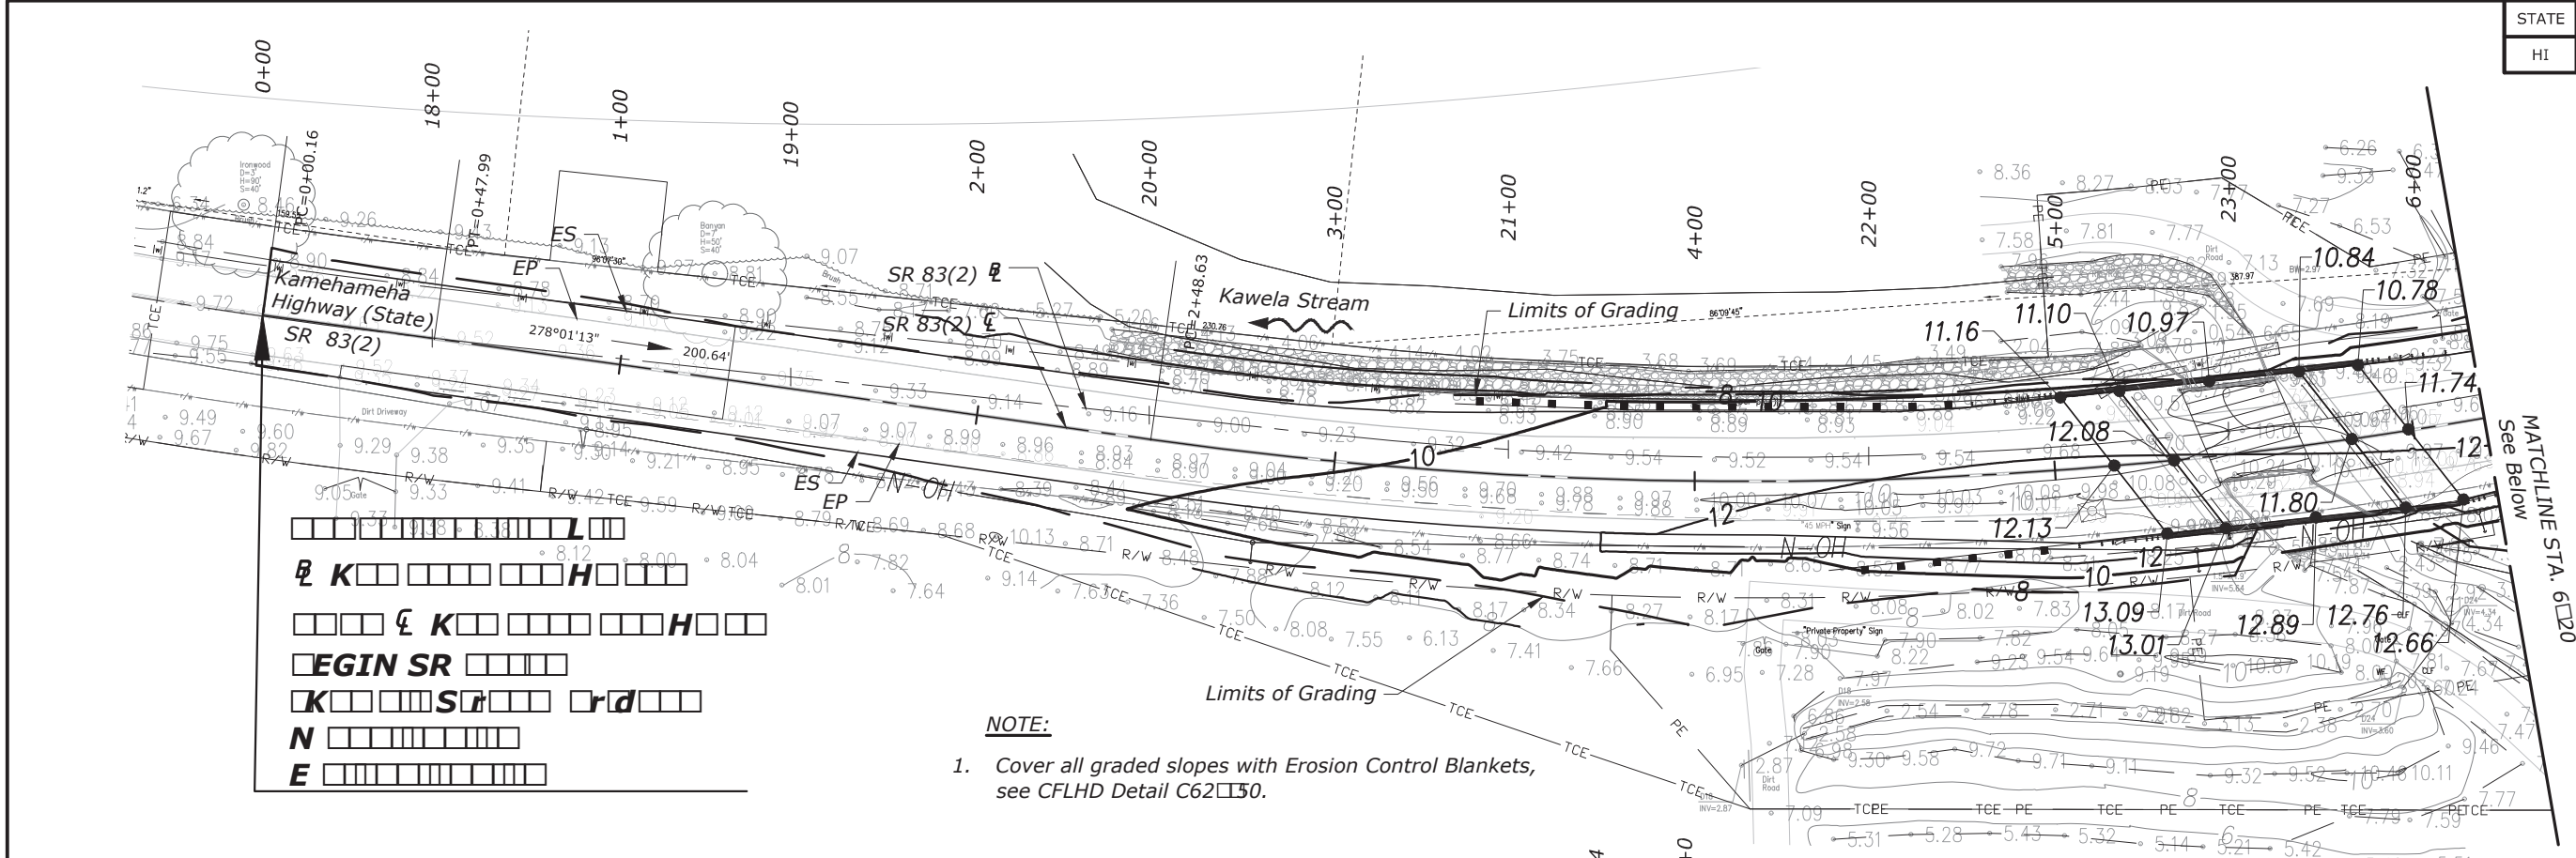

EXPIRATION DATE 04/30/2020

THIS WORK WAS PREPARED BY ME OR UNDER MY SUPERVISION AND CONSTRUCTION OF THIS PROJECT WILL BE UNDER MY OBSERVATION.

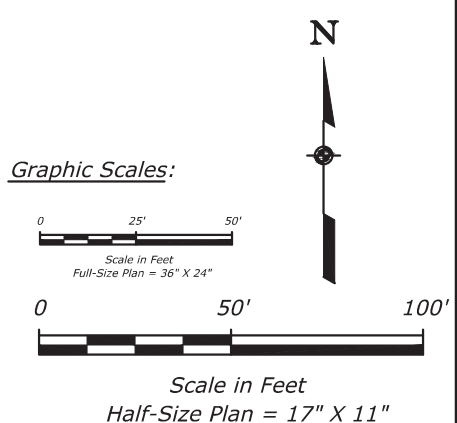

THESE PLANS HAVE BEEN PREPARED UTILIZING INFORMATION PROVIDED BY THE PROJECT CONTRACTOR. THE UPDATED CONSTRUCTION INFORMATION DEPICTED HEREIN HAS NOT BEEN VERIFIED FOR ACCURACY AND COMPLETENESS. NO REPRESENTATION IS BEING MADE TO ITS VALIDITY.

Legend for the lower section of the plan:

□ □ □ □ □ □ □ □ □ □ R □ □

□ □ □ □ □ □ □ □ □ □ K □ □ □ □ □ □ H □ □ □

□ □ □ □ □ □ □ □ □ □ EGIN SR □ □ □ □

□ □ □ □ □ □ □ □ □ □ KSR □ □ □ □ rd □ □ □

N □ □ □ □ □ □ □ □

E □ □ □ □ □ □ □ □

U.S. DEPARTMENT OF TRANSPORTATION  
FEDERAL HIGHWAY ADMINISTRATION  
CENTRAL FEDERAL LANDS HIGHWAY DIVISION

U.S. CUSTOMARY

**GRADING PLAN**

**LA STREAM BRIDGE**

6:02:59 PM K:\civil\123256 DB Kawela\_Nanahu Bridges\Drawings\Base Dwg

AS-BUILT DRAWINGS