


STATE	PROJECT	SHEET NO.
HI	HI STP SR 83(1) & (2)	T2

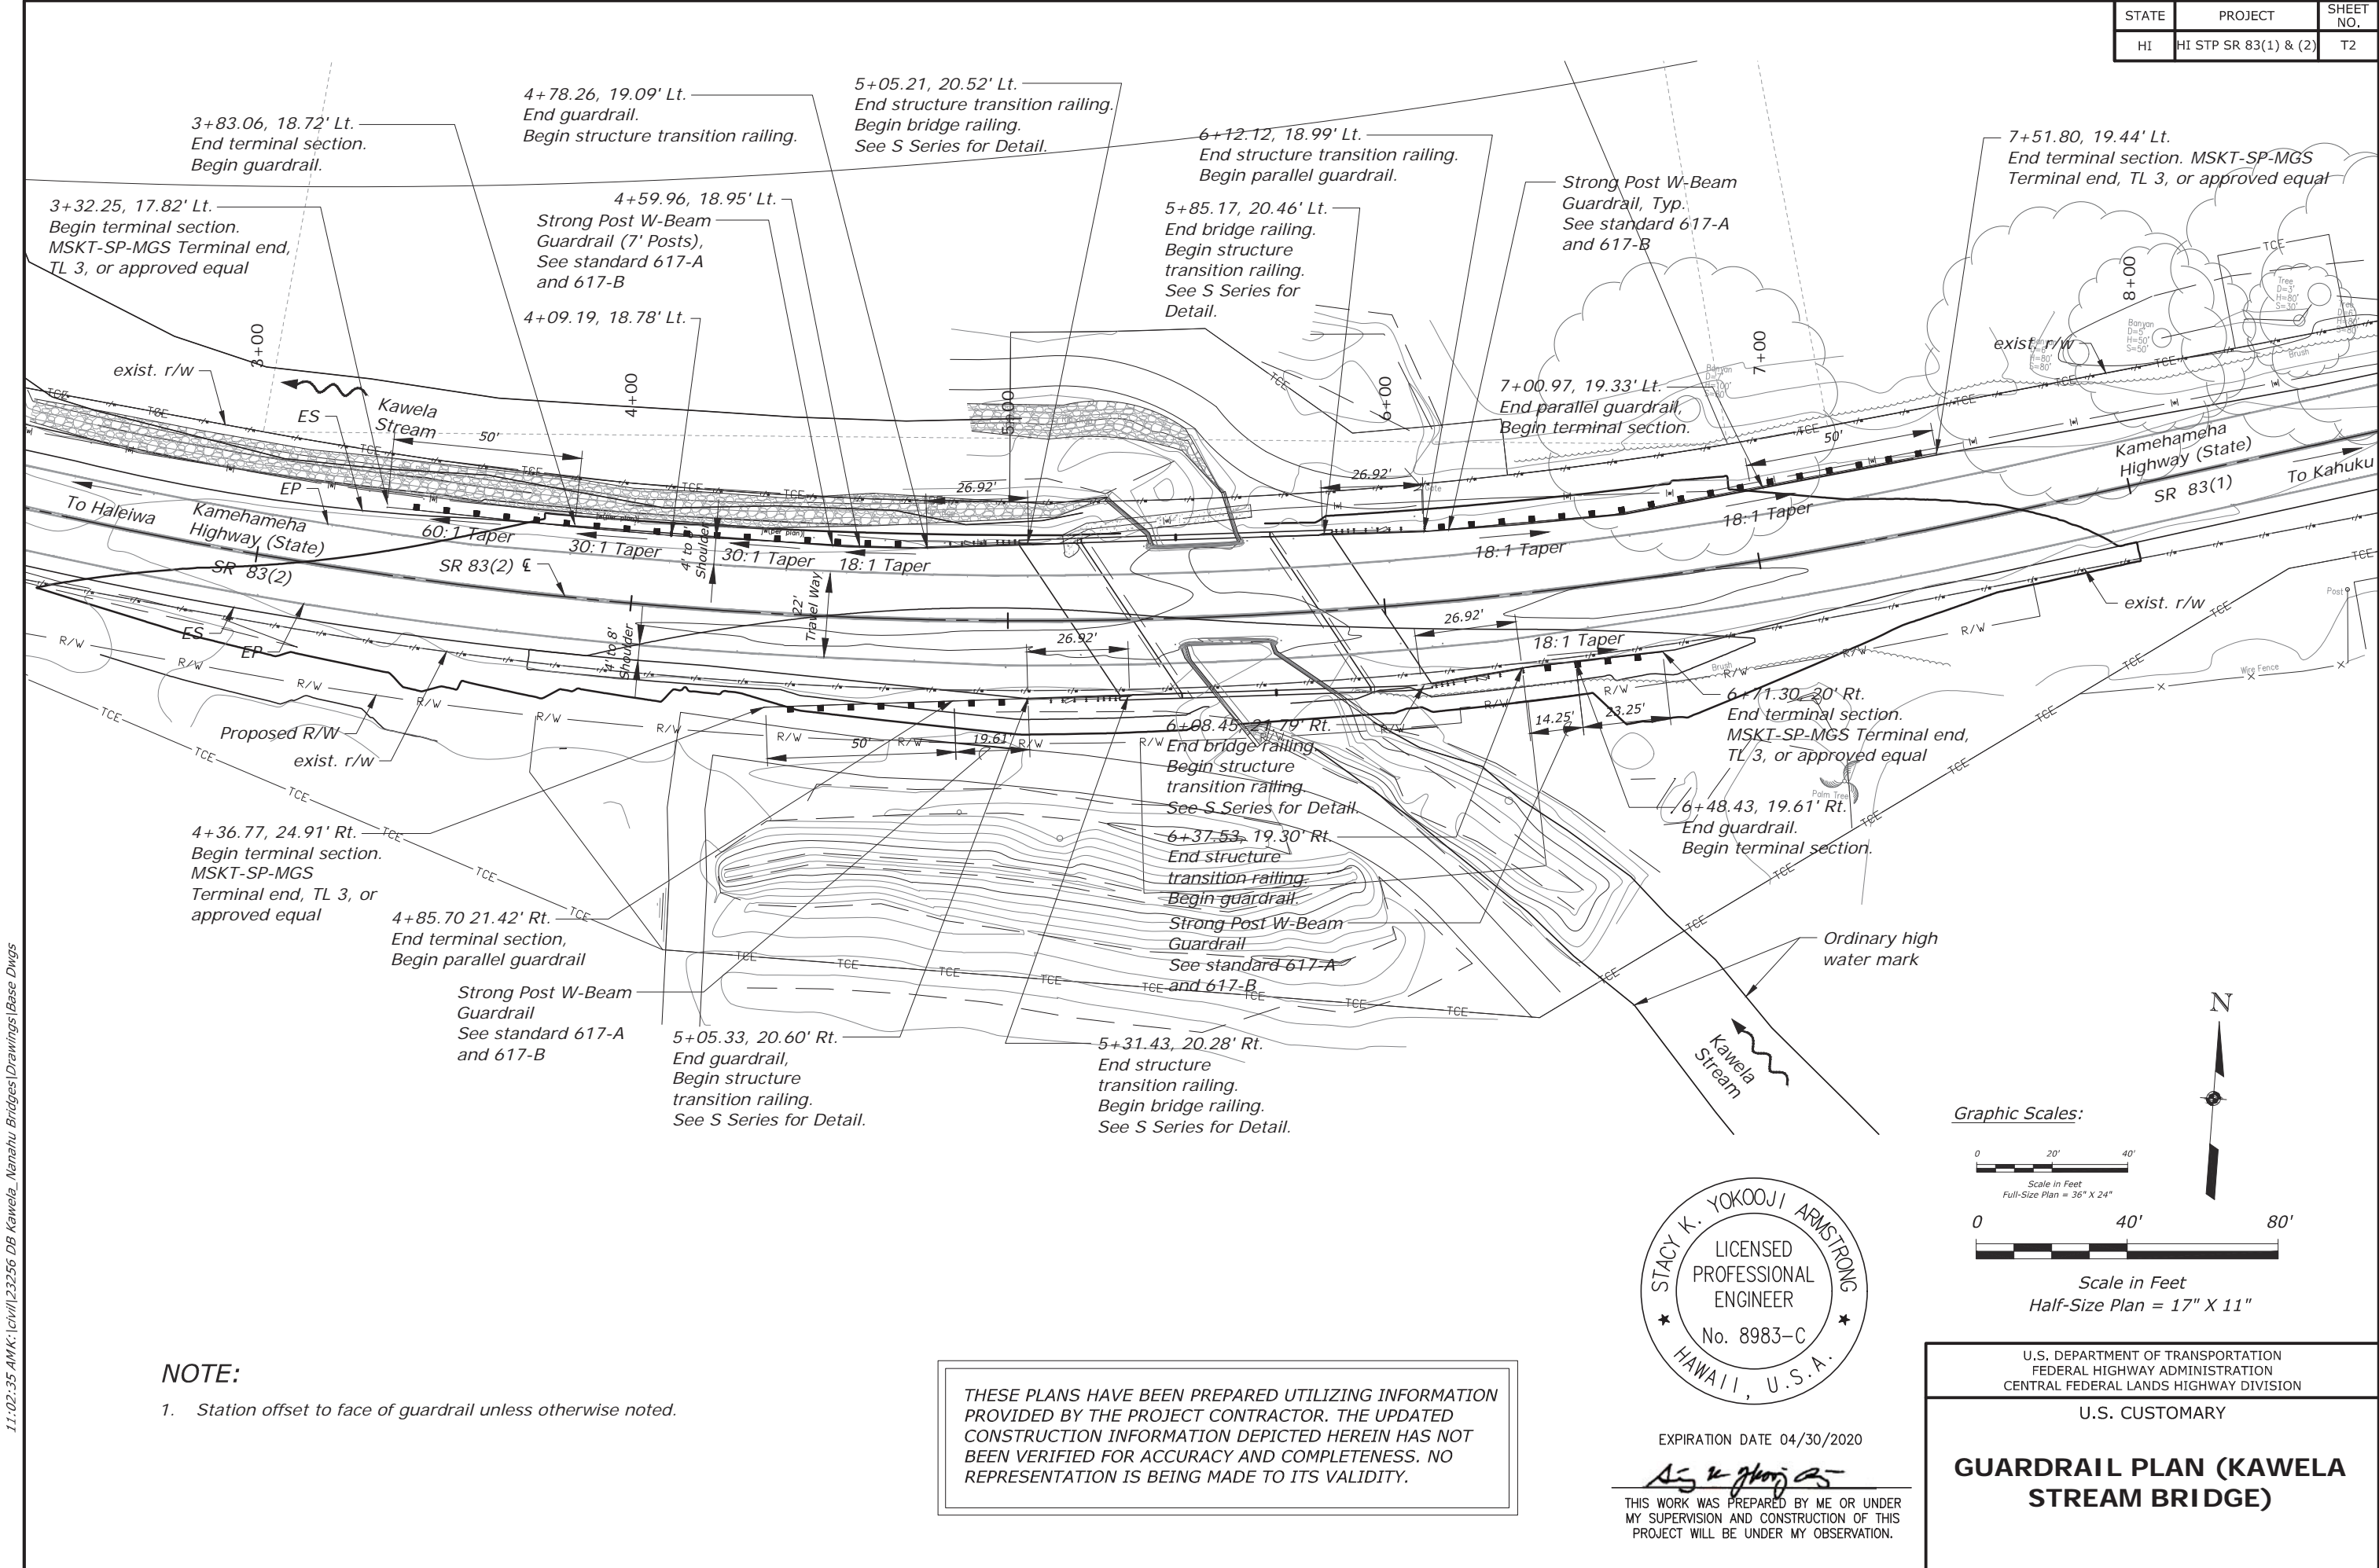


NOTE:


1. Station offset to face of guardrail unless otherwise noted.

THESE PLANS HAVE BEEN PREPARED UTILIZING INFORMATION PROVIDED BY THE PROJECT CONTRACTOR. THE UPDATED CONSTRUCTION INFORMATION DEPICTED HEREIN HAS NOT BEEN VERIFIED FOR ACCURACY AND COMPLETENESS. NO REPRESENTATION IS BEING MADE TO ITS VALIDITY.

EXPIRATION DATE 04/30/2020

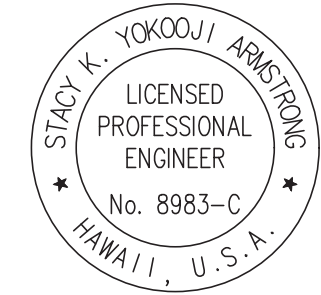

THIS WORK WAS PREPARED BY ME OR UNDER MY SUPERVISION AND CONSTRUCTION OF THIS PROJECT WILL BE UNDER MY OBSERVATION.

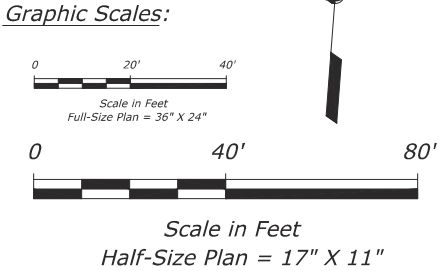

U.S. DEPARTMENT OF TRANSPORTATION
FEDERAL HIGHWAY ADMINISTRATION
CENTRAL FEDERAL LANDS HIGHWAY DIVISION

U.S. CUSTOMARY

**GUARDRAIL PLAN (KAWELA
STREAM BRIDGE)**

11:02:35 AM K:\civil\123256 DB Kawela_Nanahu Bridges\Drawings\Base Dwg

AS-BUILT DRAWINGS