

PERMANENT PAVEMENT MARKINGS SUMMARY									
Item Number									
Location	LEFT		RIGHT						
	Edge Solid White 4 inches w/ Type "C" RPM @ 40' O.C.	Centerline Solid Yellow 4 inches w/ Type "D" RPM @ 20' O.C.	Edge Solid White 4 inches w/ Type "C" RPM @ 40' O.C.	Centerline Solid Yellow 4 inches w/ Type "D" RPM @ 20' O.C.	White Word Marking "BUS"	White Word Marking "Only"	4" White (Extension Lines for Bus Bay)	Edge Solid White 4 inches (for Bus Bay)	Type C RPM (for Bus Bay)
	LNFT	LNFT	LNFT	LNFT	EA	EA	LNFT	LNFT	EA
Nanahu	940.5	968.5	938.8	968.5	1.0	1.0	100.0	50.0	3.0
Kawela	1019.8	1024.6	1021.5	1024.9	---	---	---	---	---
Note(s):									
1. Items and quantities are shown for estimate purposes only.									
2. See U Series for permanent Signage and Striping Plan.									


PERMANENT SIGN SUMMARY					
Item Number					
Location	Side	MUTCD Reference	Description	Sign Panel	Remarks
				in x in	
Nanahu	LT/RT	R2-1	Speed Limit	24 x 30	
	LT/RT	RM-4(L)	Vertical rectangle with diagonal alternating black and yellow stripes. The stripes are at a 45-degree angle beginning at the upper left and slanting down to the right.	12 x 36	
	LT/RT	RM-4(R)	Vertical rectangle with diagonal alternating black and yellow stripes. The stripes are at a 45-degree angle, beginning at the upper right and slanting down to the left.	12 x 36	
Kawela	LT/RT	Special 1	Private Property	#N/A	Existing Sign to be used
	RT	R2-1	Speed Limit	24 x 30	
	LT/RT	RM-4(L)	Vertical rectangle with diagonal alternating black and yellow stripes. The stripes are at a 45-degree angle beginning at the upper left and slanting down to the right.	12 x 36	
	LT/RT	RM-4(R)	Vertical rectangle with diagonal alternating black and yellow stripes. The stripes are at a 45-degree angle, beginning at the upper right and slanting down to the left.	12 x 36	
Note(s):					
1. Items and quantities are shown for estimate purposes only.					
2. See U Series for permanent Signage and Striping Plan.					

THESE PLANS HAVE BEEN PREPARED UTILIZING INFORMATION PROVIDED BY THE PROJECT CONTRACTOR. THE UPDATED CONSTRUCTION INFORMATION DEPICTED HEREIN HAS NOT BEEN VERIFIED FOR ACCURACY AND COMPLETENESS. NO REPRESENTATION IS BEING MADE TO ITS VALIDITY.

U.S. DEPARTMENT OF TRANSPORTATION  
FEDERAL HIGHWAY ADMINISTRATION  
CENTRAL FEDERAL LANDS HIGHWAY DIVISION

U.S. CUSTOMARY  
PERMANENT SIGNAGE  
AND STRIPING  
SUMMARIES

6:00:35 PM K:\civil\123256 DB Kawela\_Nanahu Bridges\Drawings\Base Dwgs

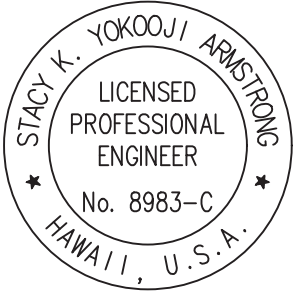

EXPIRATION DATE 04/30/2020

THIS WORK WAS PREPARED BY ME OR UNDER MY SUPERVISION AND CONSTRUCTION OF THIS PROJECT WILL BE UNDER MY OBSERVATION.