
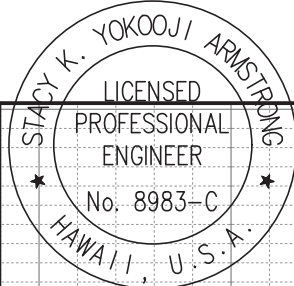



STATE	PROJECT	SHEET NO.
HI	HI STP SR 83(1) & (2)	C1

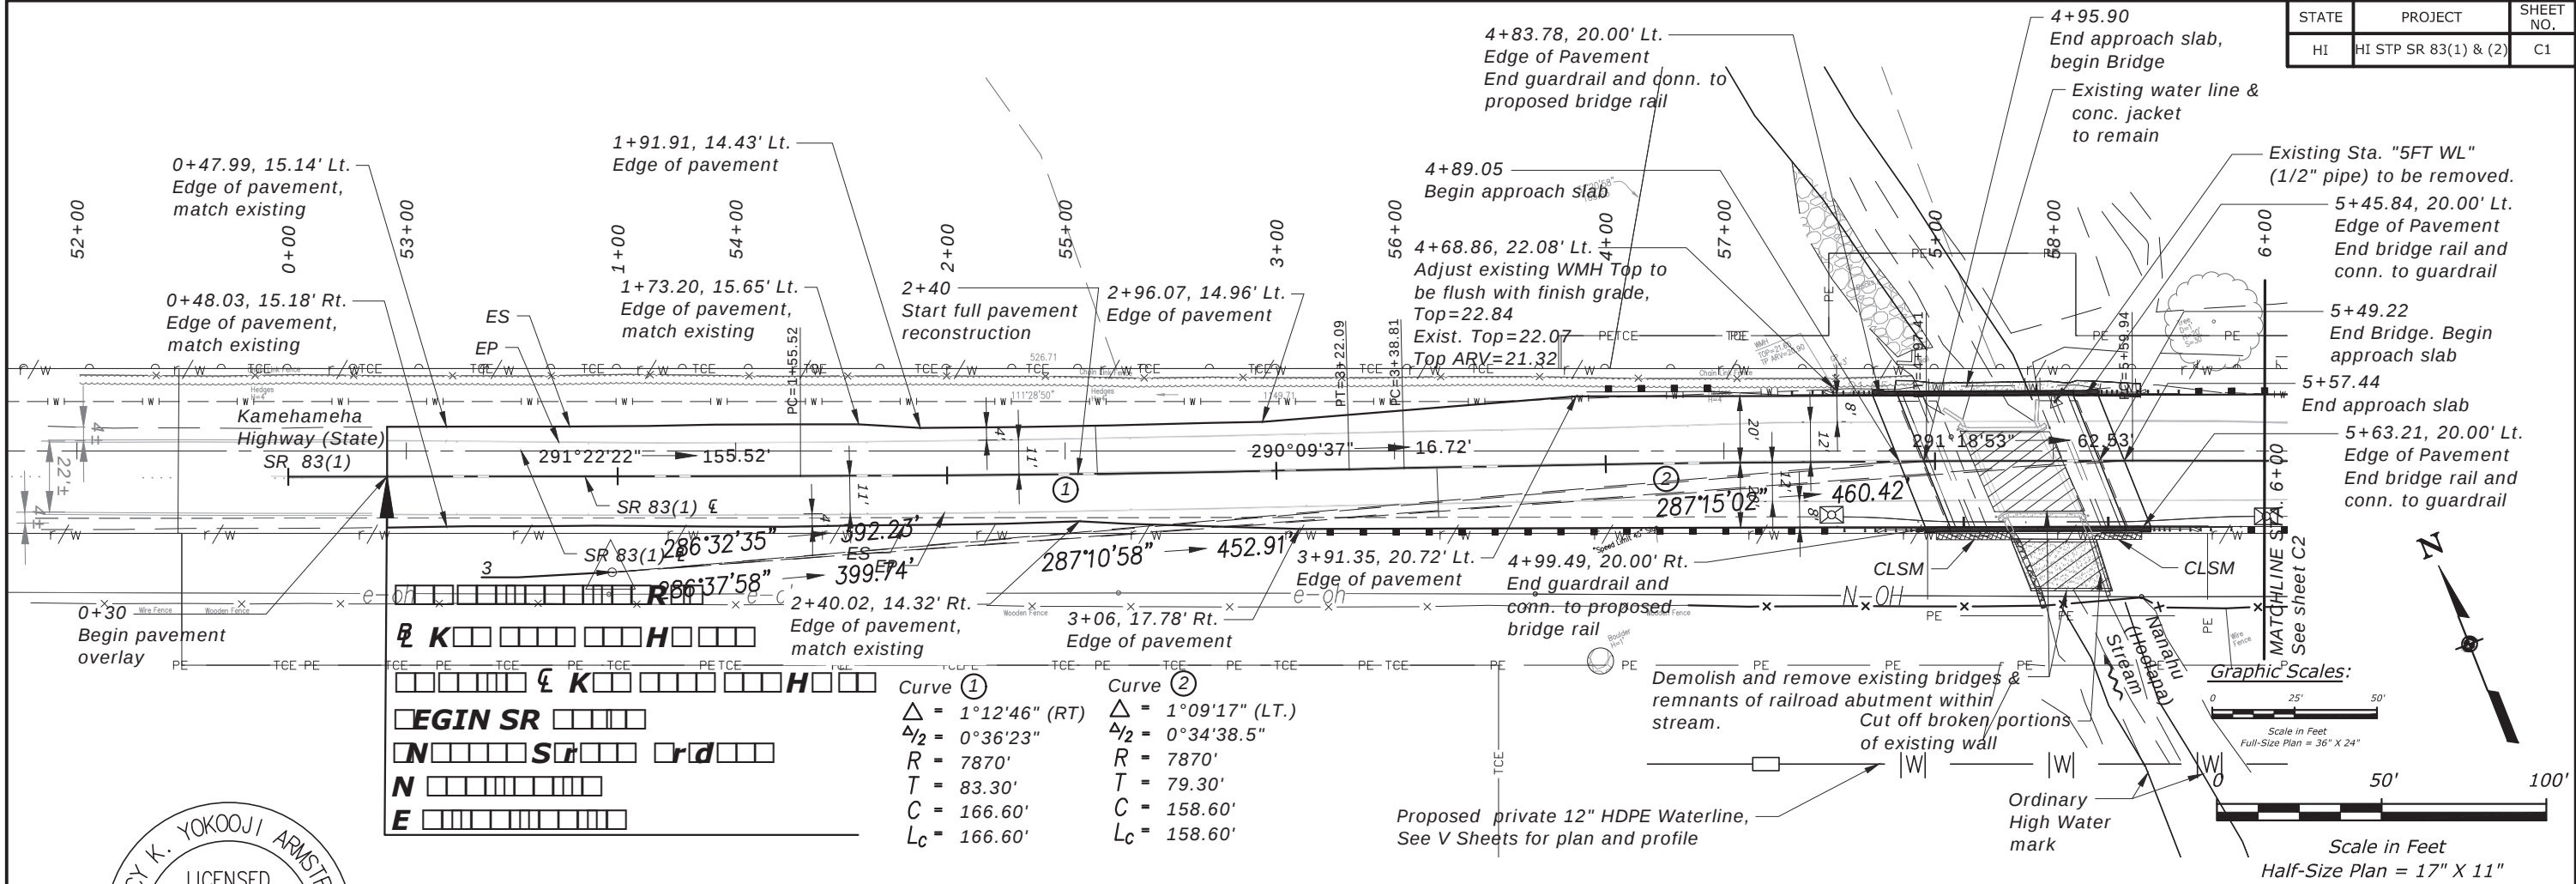

EXPIRATION DATE 04/30/2020

THIS WORK WAS PREPARED BY ME OR UNDER MY SUPERVISION AND CONSTRUCTION OF THIS PROJECT WILL BE UNDER MY OBSERVATION.

THESE PLANS HAVE BEEN PREPARED UTILIZING INFORMATION PROVIDED BY THE PROJECT CONTRACTOR. THE UPDATED CONSTRUCTION INFORMATION DEPICTED HEREIN HAS NOT BEEN VERIFIED FOR ACCURACY AND COMPLETENESS. NO REPRESENTATION IS BEING MADE TO ITS VALIDITY.

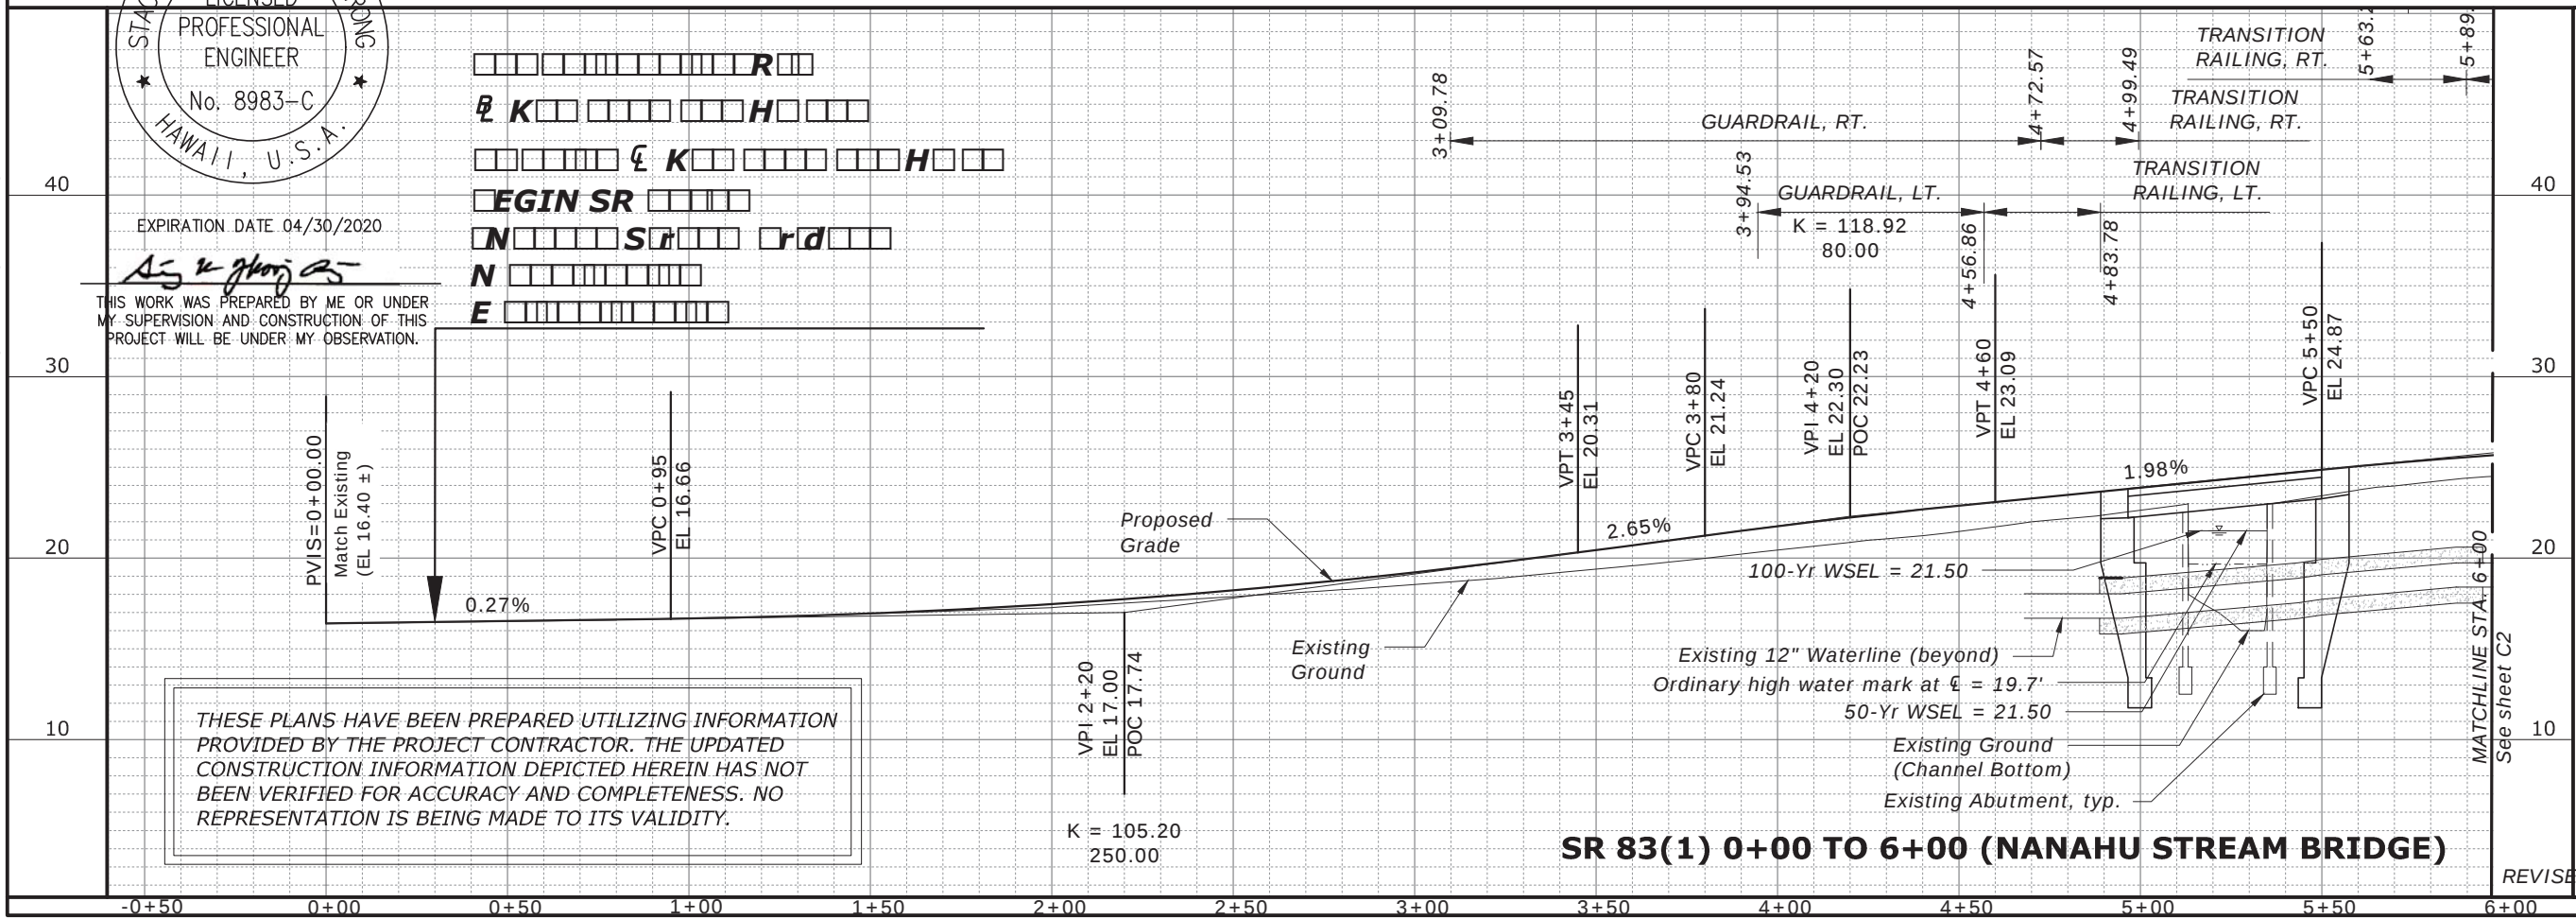

SR 83(1) 0+00 TO 6+00 (NANAHU STREAM BRIDGE)

REVISED: FEBRUARY 5, 2020




NOTES:

- Contractor to permanently stabilize disturbed areas using vegetative coverings.
- See U Series for permanent signage and striping information.
- See S Series for bridge plan, profile, and details and reinforced soil slope details.
- See T Series for Guardrail Plan
- See W Series for utility pole relocation.
- See E Series for Erosion and Sediment Control Plan and details.

12:53:37 PM K:\civil\123256 DB Kawela_Nanahu Bridges\Drawings\Base Dwgs


AS-BUILT DRAWINGS

STATE	PROJECT	SHEET NO.
HI	HI STP SR 83(1) & (2)	C2

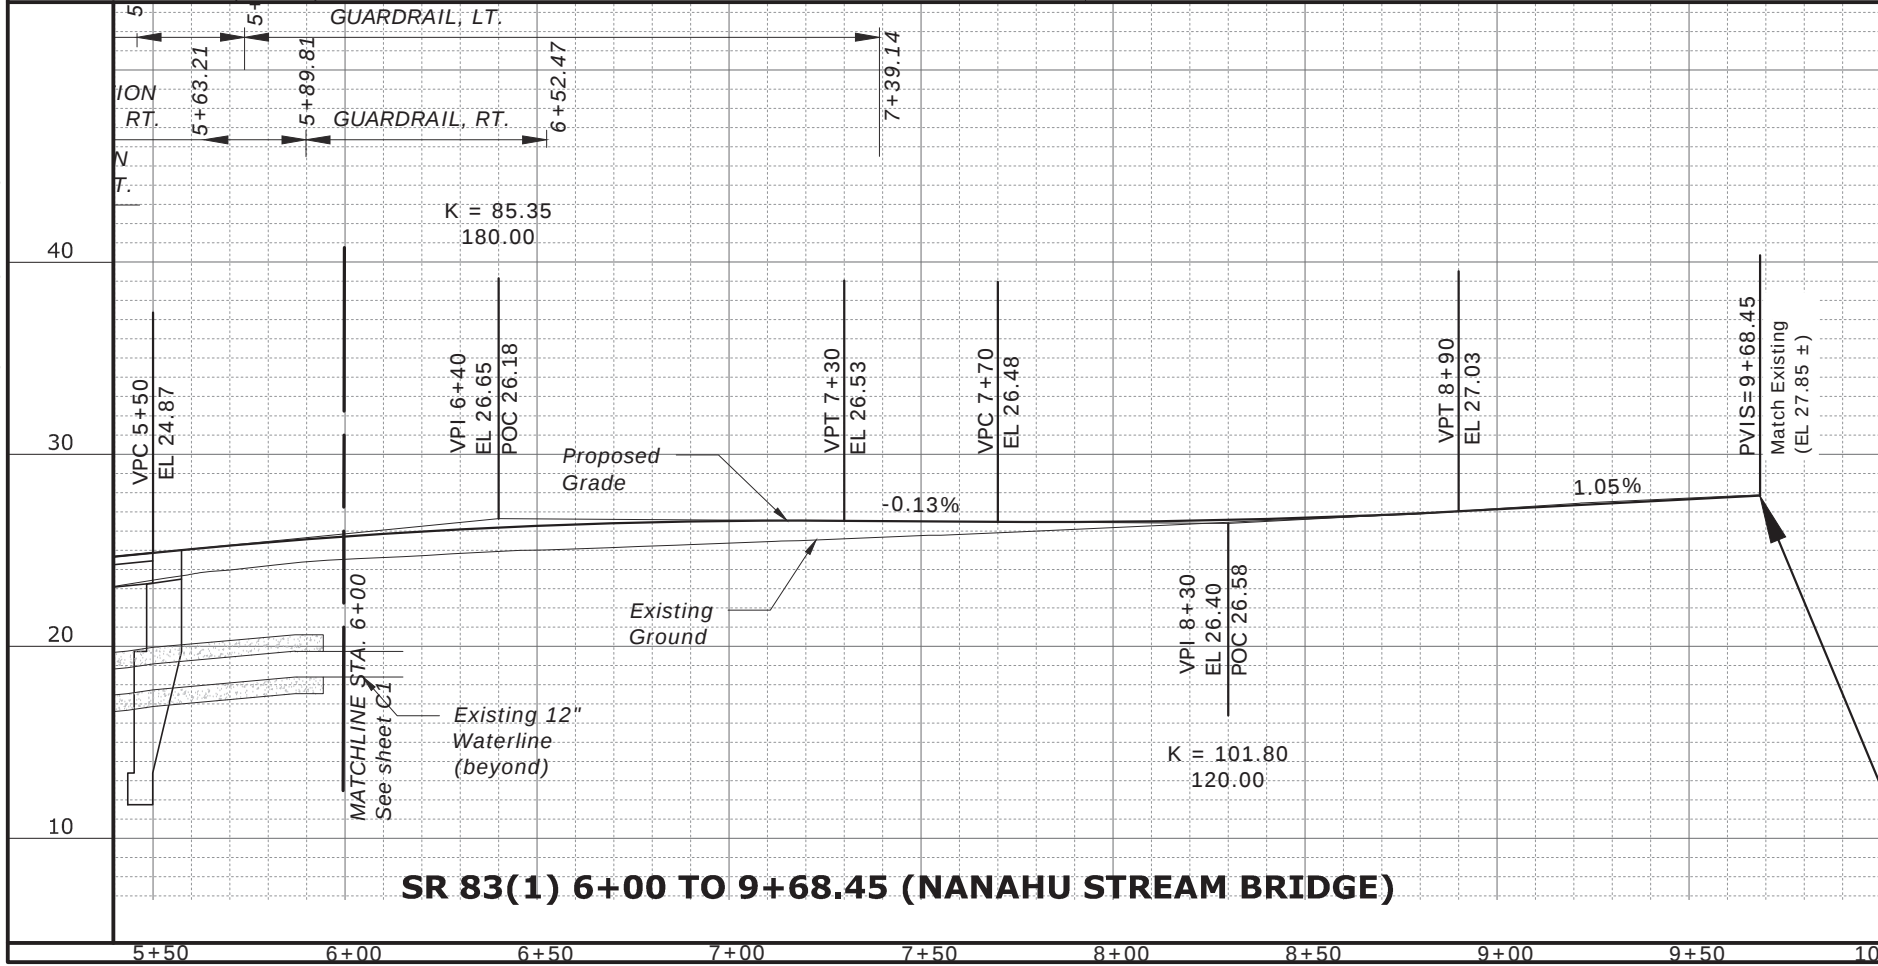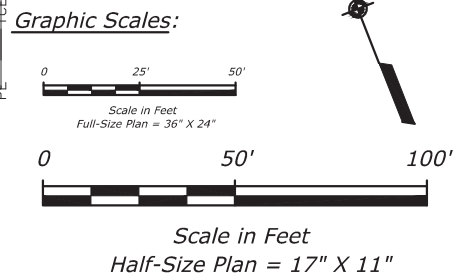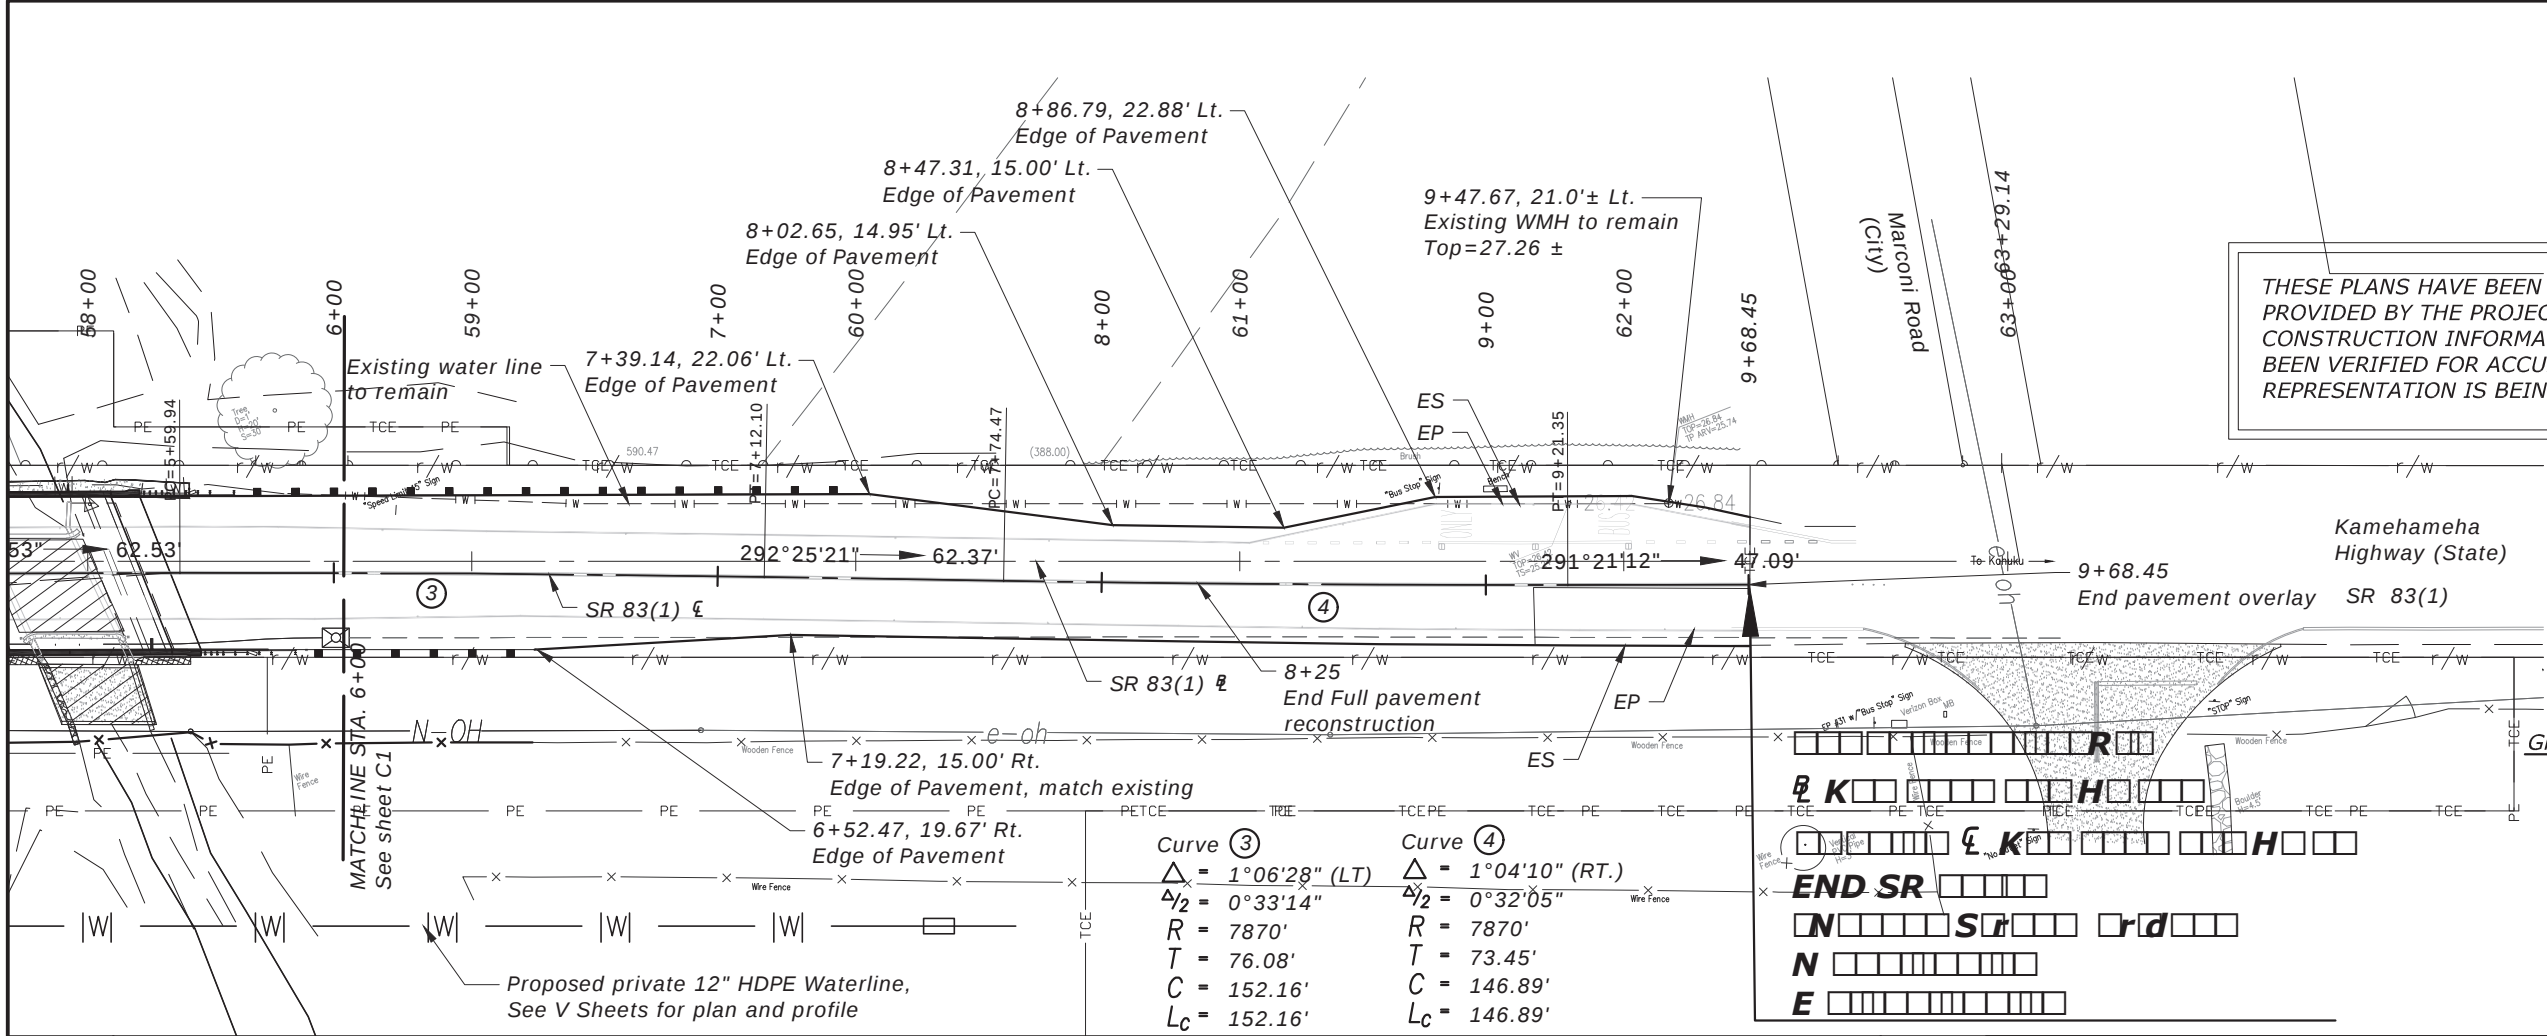

NOTES:

- Contractor to permanently stabilize disturbed areas using vegetative coverings.
- See U Series for permanent signage and striping information.
- See S Series for bridge plan, profile, and details and reinforced soil slope details.
- See T Series for Guardrail Plan
- See W Series for utility pole relocation.
- See E Series for Erosion and Sediment Control Plan and details.

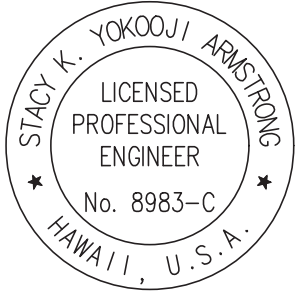


EXPIRATION DATE 04/30/2020

THIS WORK WAS PREPARED BY ME OR UNDER MY SUPERVISION AND CONSTRUCTION OF THIS PROJECT WILL BE UNDER MY OBSERVATION.

12:55:50 PM K:\civil\123256 DB Kawela_Nanahu Bridges\Drawings\Base Dwgs


AS-BUILT DRAWINGS

STATE	PROJECT	SHEET NO.
HI	HI STP SR 83(1) & (2)	C3

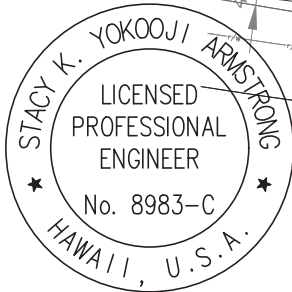

EXPIRATION DATE 04/30/2020

THIS WORK WAS PREPARED BY ME OR UNDER MY SUPERVISION AND CONSTRUCTION OF THIS PROJECT WILL BE UNDER MY OBSERVATION.

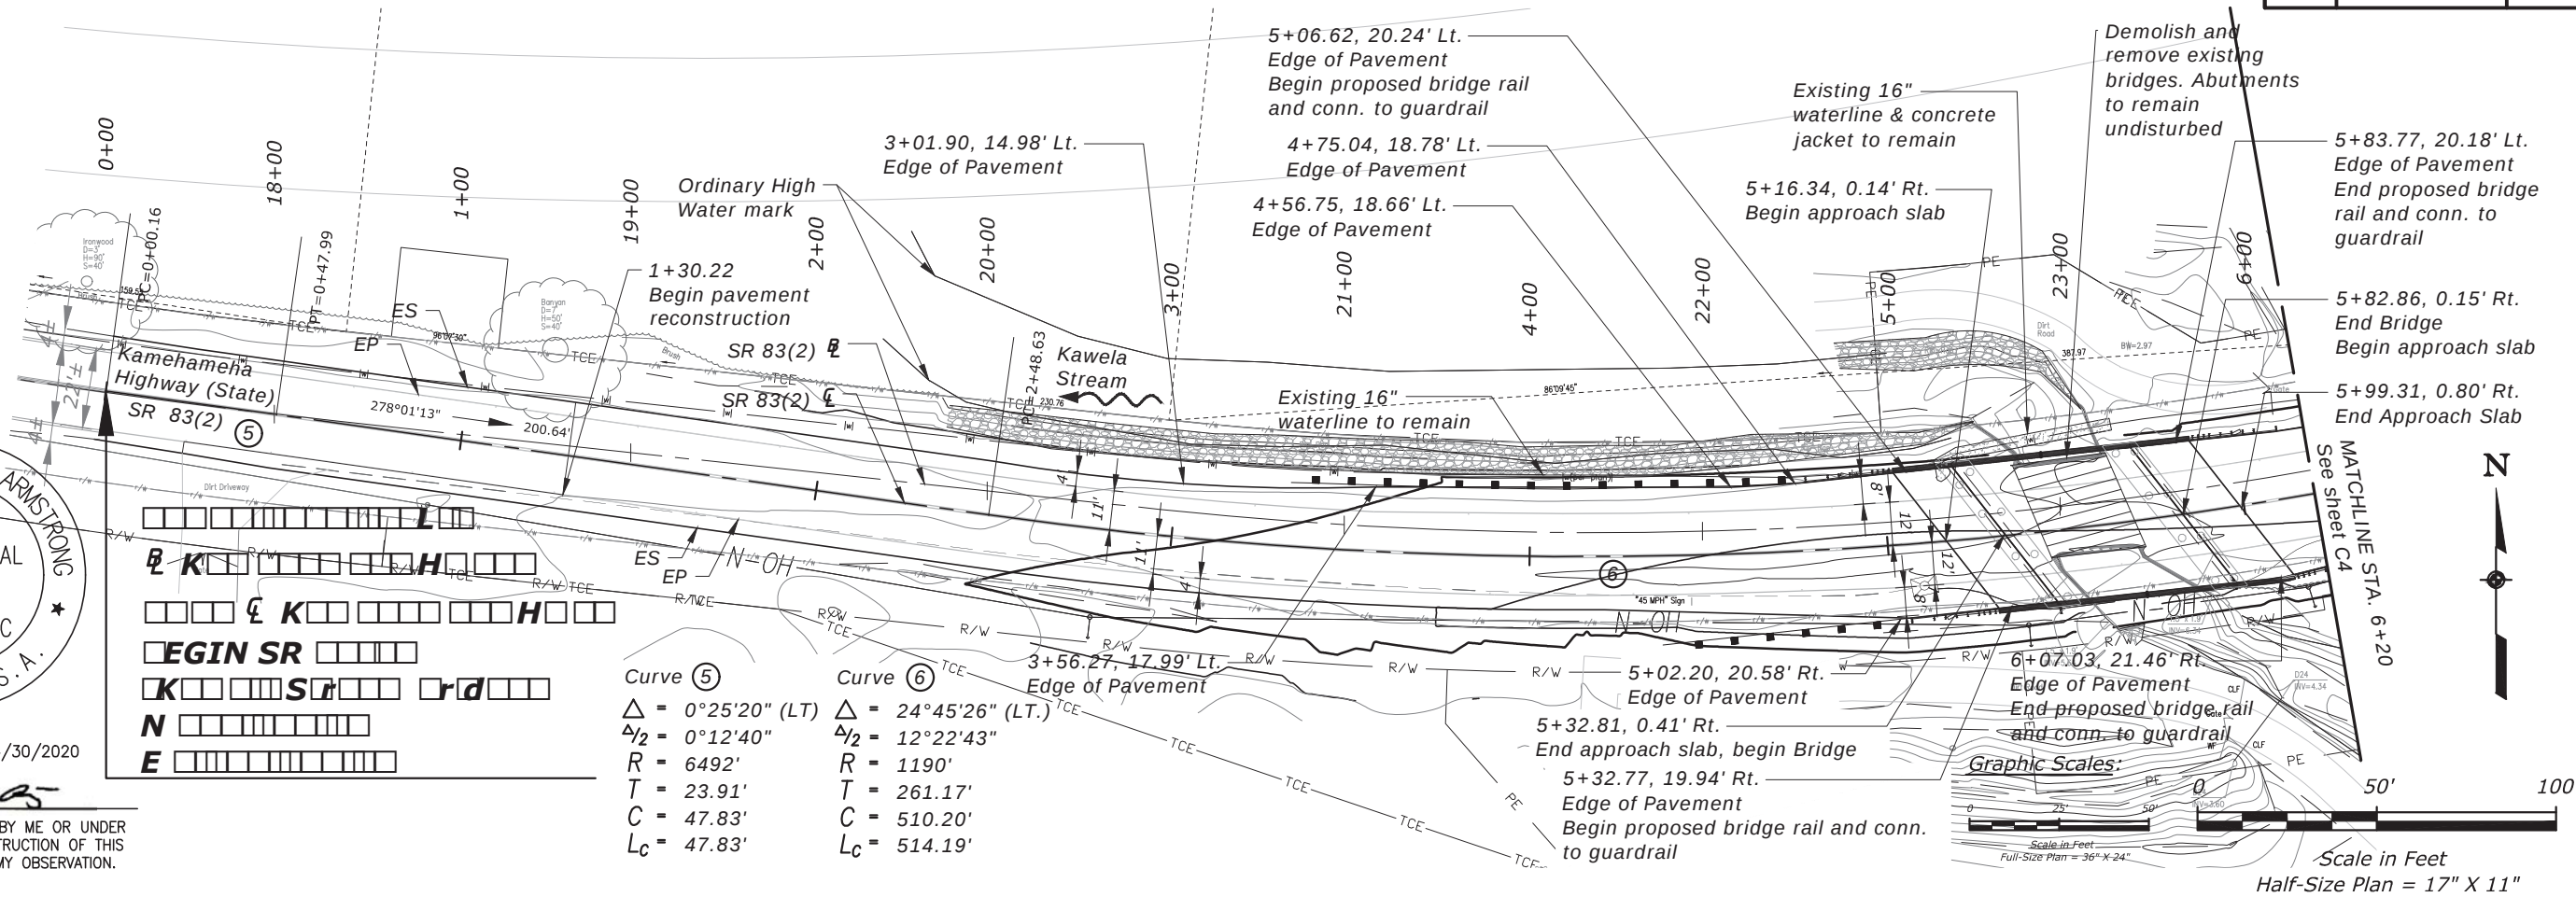


Curve ⑤	Curve ⑥
$\Delta = 0^\circ 25' 20''$ (LT)	$\Delta = 24^\circ 45' 26''$ (LT.)
$\Delta/2 = 0^\circ 12' 40''$	$\Delta/2 = 12^\circ 22' 43''$
$R = 6492'$	$R = 1190'$
$T = 23.91'$	$T = 261.17'$
$C = 47.83'$	$C = 510.20'$
$L_c = 47.83'$	$L_c = 514.19'$

LEGEND:
K = Kawela Stream
SR = State Road
N = North
E = Erosion and Sediment Control

THESE PLANS HAVE BEEN PREPARED UTILIZING INFORMATION PROVIDED BY THE PROJECT CONTRACTOR. THE UPDATED CONSTRUCTION INFORMATION DEPICTED HEREIN HAS NOT BEEN VERIFIED FOR ACCURACY AND COMPLETENESS. NO REPRESENTATION IS BEING MADE TO ITS VALIDITY.

NOTES:

- Contractor to permanently stabilize disturbed areas using vegetative coverings.
- See U Series for permanent signage and striping information.
- See S Series for bridge plan, profile, and details and reinforced soil slope details.
- See T Series for Guardrail Plan
- See W Series for utility pole relocation.
- See E Series for Erosion and Sediment Control Plan and details.

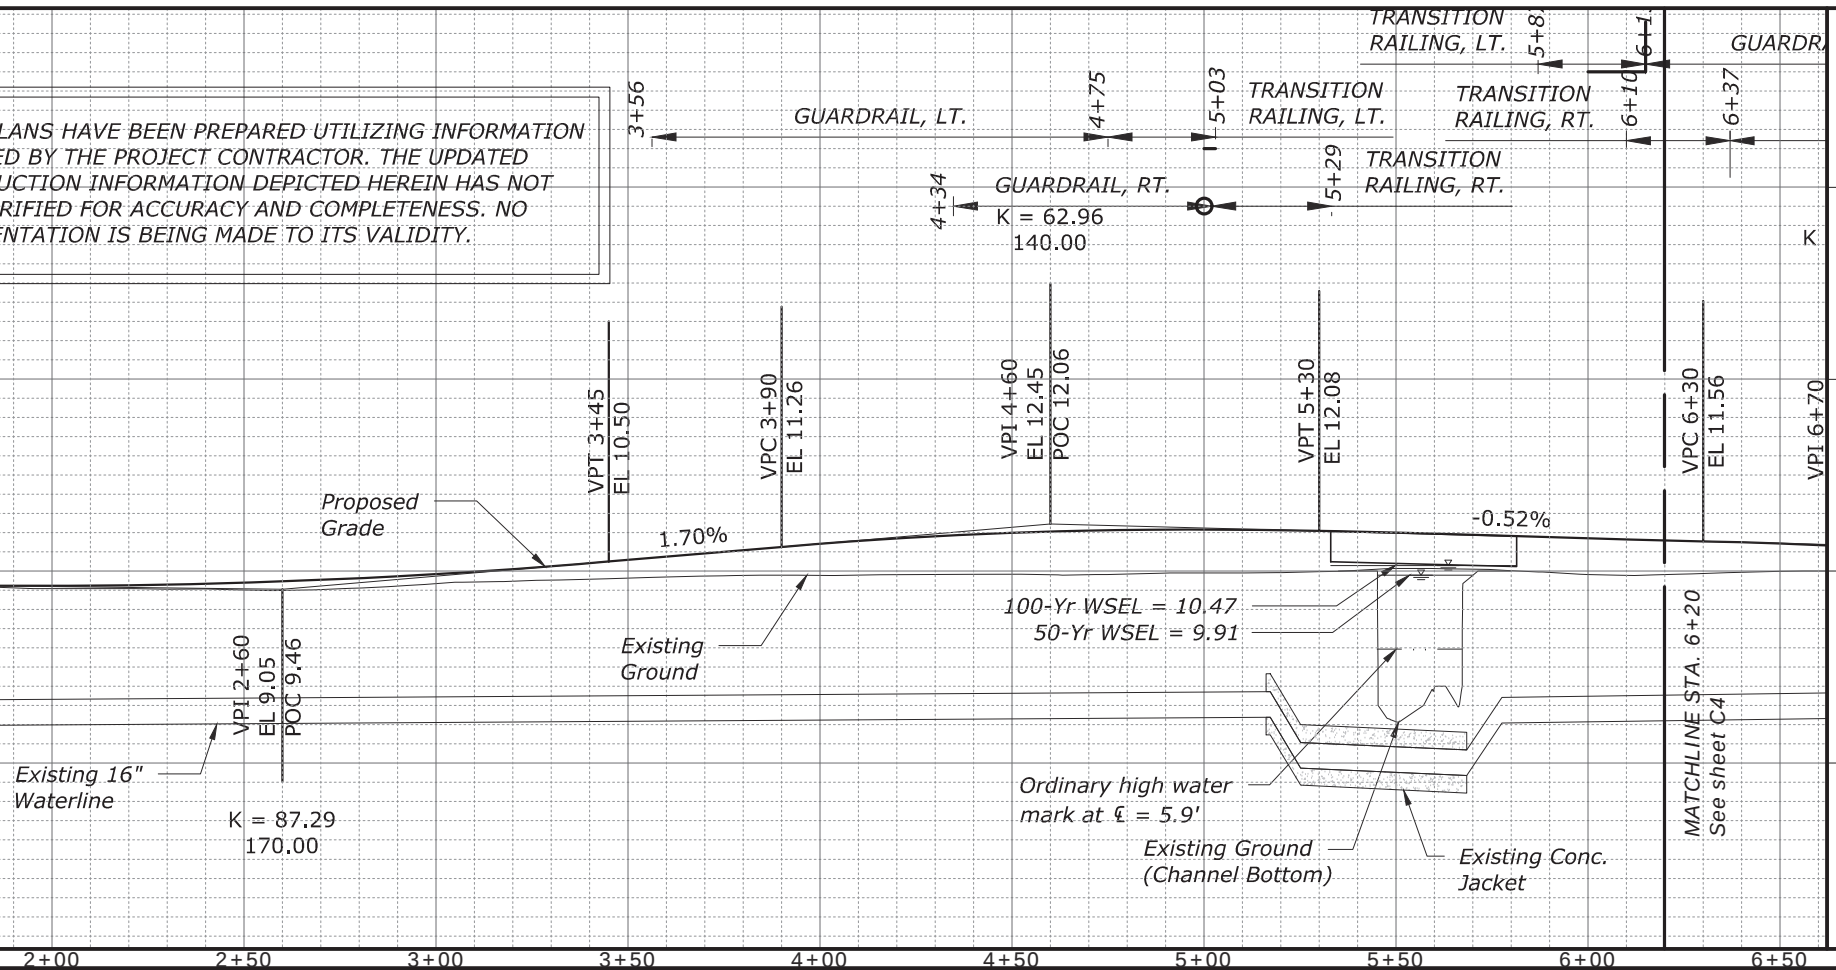

5:16:43 PM K:\civil\123256 DB Kawela_Nanahu Bridges\Drawings\Base Dwg

AS-BUILT DRAWINGS

