
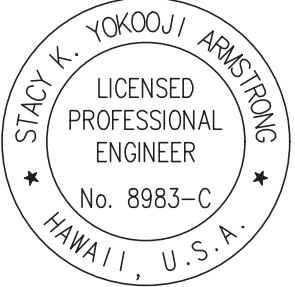
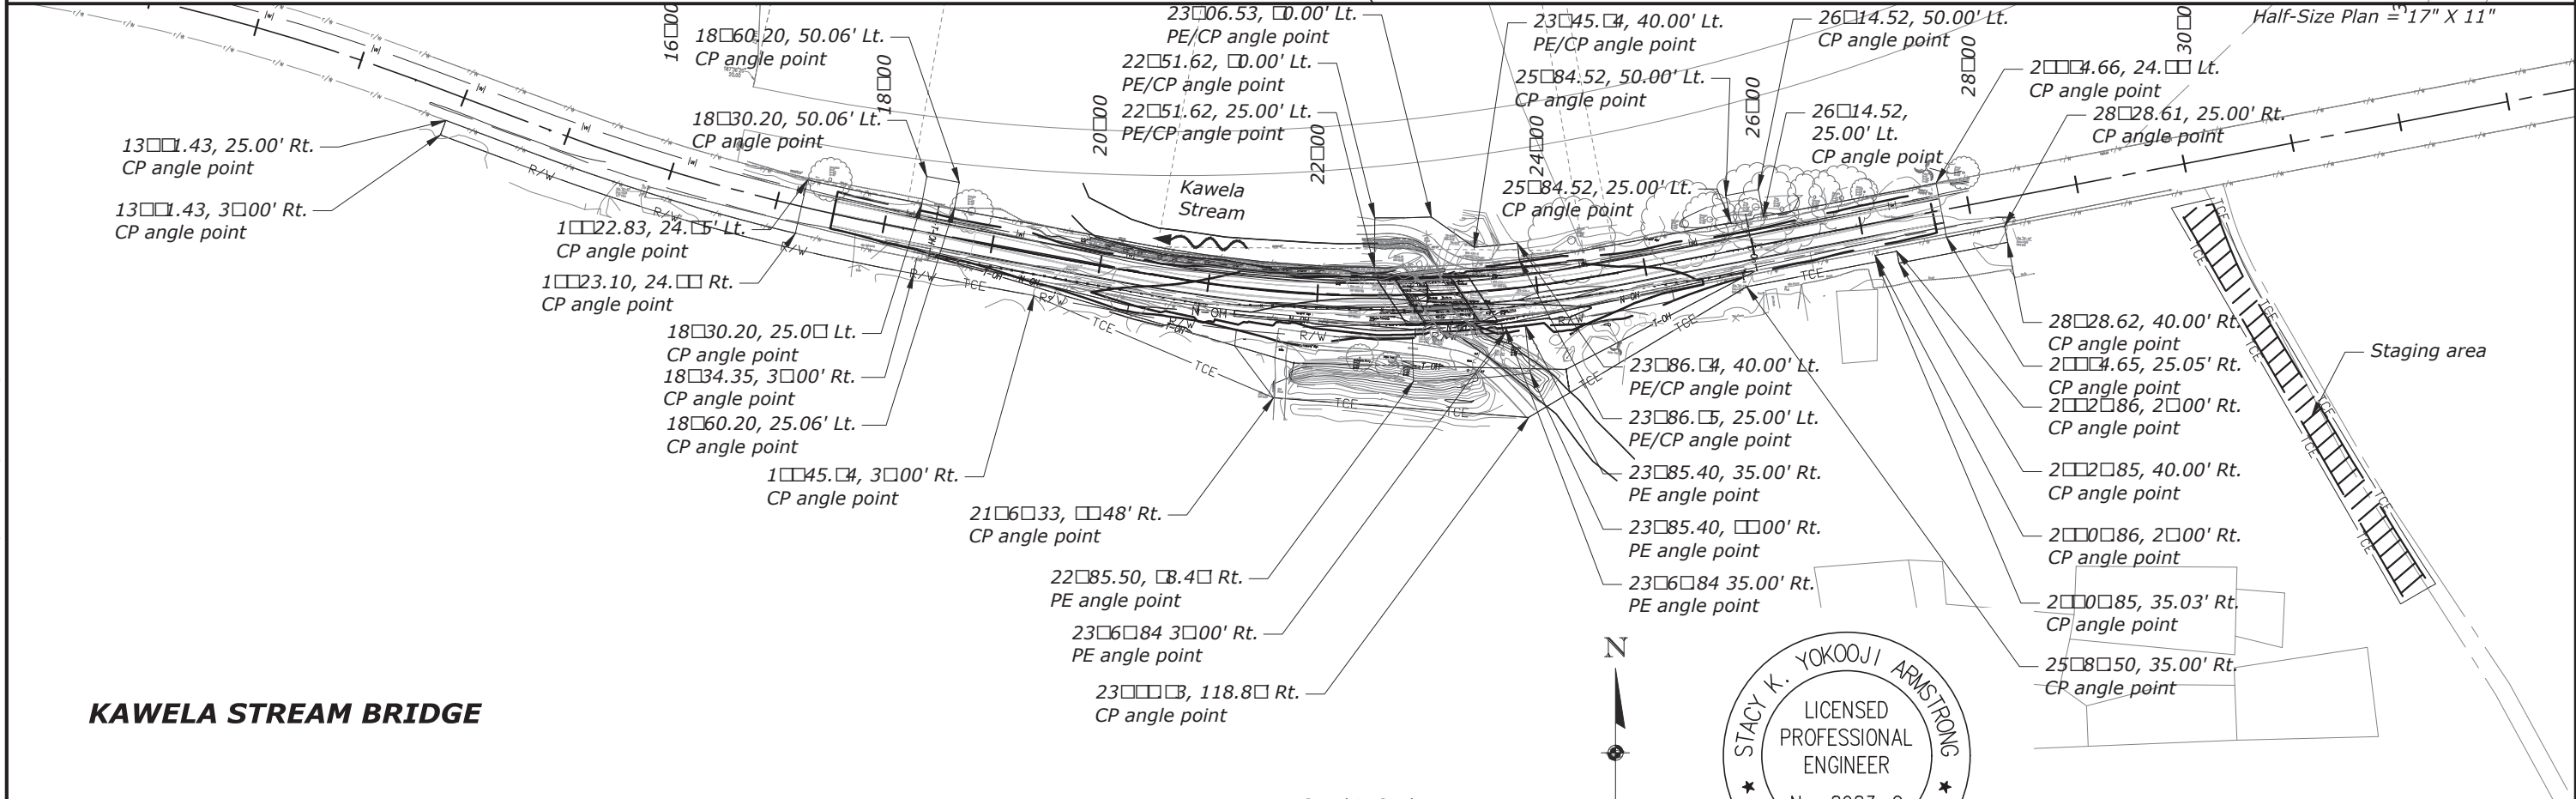



STATE	PROJECT	SHEET NO.
HI	HI STP SR 83(1) & (2)	D1

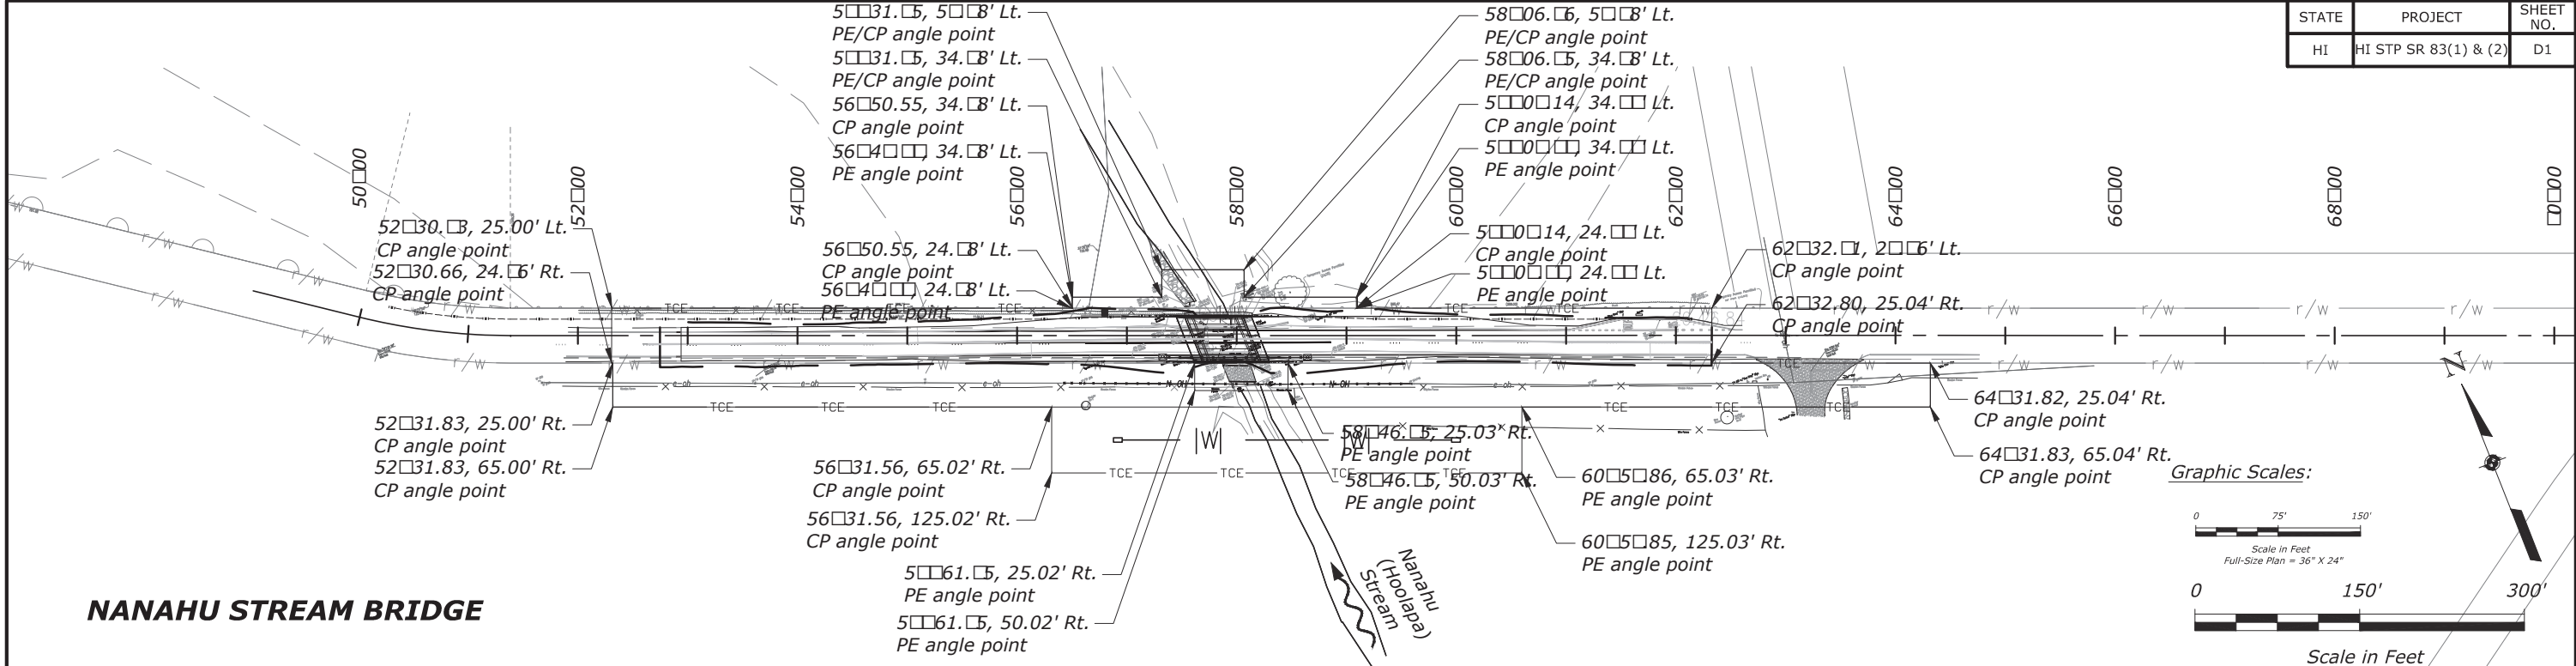

EXPIRATION DATE 04/30/2020

THIS WORK WAS PREPARED BY ME OR UNDER MY SUPERVISION AND CONSTRUCTION OF THIS PROJECT WILL BE UNDER MY OBSERVATION.

THESE PLANS HAVE BEEN PREPARED UTILIZING INFORMATION PROVIDED BY THE PROJECT CONTRACTOR. THE UPDATED CONSTRUCTION INFORMATION DEPICTED HEREIN HAS NOT BEEN VERIFIED FOR ACCURACY AND COMPLETENESS. NO REPRESENTATION IS BEING MADE TO ITS VALIDITY.

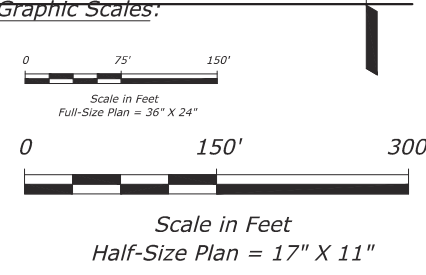

U.S. DEPARTMENT OF TRANSPORTATION
FEDERAL HIGHWAY ADMINISTRATION
CENTRAL FEDERAL LANDS HIGHWAY DIVISION

U.S. CUSTOMARY

RIGHT OF WAY AND STAGING AREA PLAN
NANAHU AND KAWELA STREAM BRIDGE

6:03:13 PM K:\civil\123256 DB Kawela_Nanahu Bridges\Drawings\Base Dwgs

AS-BUILT DRAWINGS