


1:51:40 PM K:\civil\123256 DB Kawela_Nanahu Bridges\Drawings\Base Dwg.s

STATE	PROJECT	SHEET NO.
HI	HI STP SR 83(1) & (2)	B1

ITEM NO.	ITEM DESCRIPTION	Unit	SHEET NUMBER AND DESCRIPTION							Estimated Quantities	REMARKS AND/OR DETERMINATION OF ESTIMATED QUANTITY
			B2	B3	B4	B4	S0.3	B5	S2		
			EARTHWORK, REMOVAL, & SURFACING SUMMARIES	DRAINAGE EROSION CONTROL, AND MISC. SUMMARIES	PERMANENT SIGNAGE AND STRIPING SUMMARIES	TEMPORARY SIGNAGE AND STRIPING SUMMARIES	QUANTITY SCHEDULE	MISC. SUMMARIES	BRIDGE SUMMARY	PLAN	
15705-1500	SOIL EROSION CONTROL, COMPOST SOCK	LNFT		3,129						3,129	
15706-1600	SOIL EROSION CONTROL, STABILIZED CONSTRUCTION EXIT	EACH		4						4	
15802-0000	WATERING FOR DUST CONTROL	LPSM								ALL	
20101-0000	CLEARING AND GRUBBING	ACRE	1							1	
20401-0000	ROADWAY EXCAVATION	CUYD	4,996							4,996	
20301-2400	REMOVAL OF SIGN	EACH	9							9	
20301-2800	REMOVAL OF STRUCTURES AND OBSTRUCTIONS	EACH	3							3	
20301-3100	REMOVAL OF UTILITY POLE	EACH	5							5	
20302-0200	REMOVAL OF CURB	LNFT	100							100	
20302-0700	REMOVAL OF FENCE	LNFT	347							347	
20302-1200	REMOVAL OF GUARDRAIL	LNFT	470							470	
20303-1600	REMOVAL OF PAVEMENT, ASPHALT	SQYD	35,227							35,227	
30201-2000	ROADWAY AGGREGATE	CUYD	1,628							1,628	
40301-0000	ASPHALT CONCRETE PAVEMENT	TON	4,224							4,224	
61701-4950	GUARDRAIL SYSTEM MGS	LNFT		603						603	
61702-0000	TERMINAL SECTION	EACH		4						4	
61703-0000	TERMINAL END	EACH		4						4	
61707-0000	STRUCTURE TRANSITIONS RAILING	LNFT		200						200	
61901-0000	FENCE	LNFT		347						347	
FIO	CONDUIT 4-INCH	LPSM		ALL						0	
63620-0000	POLE	EACH		6						6	
FIO	NETCOM MANHOLE	LPSM		ALL						0	
61102-3545	12-INCH WATERLINE	LNFT		320						320	
20304-1000	REMOVAL OF STRUCTURES AND OBSTRUCTIONS	LPSM					LPSM	LPSM		0	
20435-2000	BACKFILL, GRANULAR	CUYD					12	25		37	
20720-0400	REINFORCEMENT GEOSYNTHETIC, TYPE 4	SQYD					2,320			2,320	
20801-0000	STRUCTURE EXCAVATION	CUYD					148	214		362	
20803-0000	STRUCTURE BACKFILL	CY					42	18		60	
55201-1500	STRUCTURE CONCRETE	CY					136	281		417	
55302-3500	PRECASE, PRESTRESSED COCNRETE SLAB, 14" SOLID	LNFT					500	460		960	
55401-1000	REINFORCING STEEL	LB					45,400	94,400		139,800	
55601-0500	BRIDGE RAILING, CONCRETE	LNFT					137	164		301	
61707-0000	STRUCTURE TRANSITIONS RAILING	LNFT					100	100		200	
55101-0300	PRECASE, PRESTRESSED CONCRETE PILE	LNFT						864		864	
63502-2100	TEMPORARY TRAFFIC CONTROL, CRASH CUSHION	EACH				2				2	
63503-0400	TEMPORARY TRAFFIC CONTROL, CONCRETE BARRIER	LNFT				240				240	

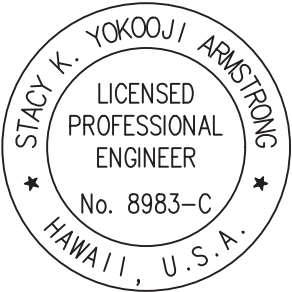

EXPIRATION DATE 04/30/2020

Stacy K. Yokooji
THIS WORK WAS PREPARED BY ME OR UNDER MY SUPERVISION AND CONSTRUCTION OF THIS PROJECT WILL BE UNDER MY OBSERVATION.

THESE PLANS HAVE BEEN PREPARED UTILIZING INFORMATION PROVIDED BY THE PROJECT CONTRACTOR. THE UPDATED CONSTRUCTION INFORMATION DEPICTED HEREIN HAS NOT BEEN VERIFIED FOR ACCURACY AND COMPLETENESS. NO REPRESENTATION IS BEING MADE TO ITS VALIDITY.

U.S. DEPARTMENT OF TRANSPORTATION
FEDERAL HIGHWAY ADMINISTRATION
CENTRAL FEDERAL LANDS HIGHWAY DIVISION

U.S. CUSTOMARY

SUMMARY OF QUANTITIES

AS-BUILT DRAWINGS