

TEMPORARY PAVEMENT MARKINGS SUMMARY										
Item Number										Remarks
Location	LEFT		RIGHT							
	Edge Solid White 4 inches w/ Type "C" RPM @ 40' O.C.	Centerline Solid Yellow 4 inches w/ Type "D" RPM @ 20' O.C.	Edge Solid White 4 inches w/ Type "C" RPM @ 40' O.C.	Centerline Solid Yellow 4 inches w/ Type "D" RPM @ 20' O.C.	White Word Marking "BUS"	White Word Marking "Only"	4" White (Extension Lines for Bus Bay)	Edge Solid White 4 inches (for Bus Bay)	Type C RPM (for Bus Bay)	
	LNFT	LNFT	LNFT	LNFT	EA	EA	LNFT	LNFT	EA	
Nanahu	961.4	944.0	959.2	944.0	1.0	1.0	100.0	50.0	3.0	
Kawela	983.3	987.4	991.0	987.6	---	---	---	---	---	


Note(s):										
1. Items and quantities are shown for estimate purposes only.										
2. See T and V Series for temporary signage and striping plans and details.										

TEMPORARY TRAFFIC CONTROL					
Item Number		63502-2100	63503-0400		
Location		Side	TEMPORARY TRAFFIC CONTROL, CRASH CUSHION	TEMPORARY TRAFFIC CONTROL, CONCRETE BARRIER	Remarks
			EACH	LNFT	
Nanahu	West Approach	LT			
		RT		80	
	Bridge				
	East Approach	LT	1	60	
Kawela		RT			
	West Approach	LT			
		RT		40	
	Bridge				
	East Approach	LT		60	
		RT			
TOTAL			1	240	

Note(s):					
1. Items and quantities are shown for estimate purposes only.					
2. See T and V Series for temporary signage and striping plans and details.					

TEMPORARY SIGNAGE SUMMARY						
Item Number						
Location	Side	MUTCD Reference	Description	Sign Panel	Number of Signs	Remarks
				in x in		
Nanahu	LT/RT	W24-1	Double Reverse Curve (1 lane)	36 x 36	2	
	LT/RT	W13-1P	Advisory Speed (plaque)	18 x 18	2	
	LT	W1-6L	One Direction Large Arrow Left	48 x 24	1	
	LT	W1-6R	One Direction Large Arrow Right	48 x 24	1	
Kawela	LT/RT	W24-1	Double Reverse Curve (1 lane)	36 x 36	2	
	LT/RT	W13-1P	Advisory Speed (plaque)	18 x 18	2	
	LT	W1-6L	One Direction Large Arrow Left	48 x 24	1	
	LT	W1-6R	One Direction Large Arrow Right	48 x 24	1	
Note(s):						
1. Items and quantities are shown for estimate purposes only.						
2. See T and V Series for temporary signage and striping plans and details.						

THESE PLANS HAVE BEEN PREPARED UTILIZING INFORMATION PROVIDED BY THE PROJECT CONTRACTOR. THE UPDATED CONSTRUCTION INFORMATION DEPICTED HEREIN HAS NOT BEEN VERIFIED FOR ACCURACY AND COMPLETENESS. NO REPRESENTATION IS BEING MADE TO ITS VALIDITY.

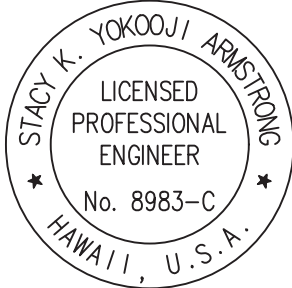

EXPIRATION DATE 04/30/2020

THIS WORK WAS PREPARED BY ME OR UNDER MY SUPERVISION AND CONSTRUCTION OF THIS PROJECT WILL BE UNDER MY OBSERVATION.

U.S. DEPARTMENT OF TRANSPORTATION
FEDERAL HIGHWAY ADMINISTRATION
CENTRAL FEDERAL LANDS HIGHWAY DIVISION

U.S. CUSTOMARY

TEMPORARY SIGNAGE
AND STRIPING
SUMMARIES