




| FED. ROAD DIST. NO. | STATE | FED. AID PROJ. NO. | FISCAL YEAR | SHEET NO. | TOTAL SHEETS |
|---------------------|-------|--------------------|-------------|-----------|--------------|
| HAWAII              | HAW.  | NH-083-1(60)       | 2007        | 19        | 90           |

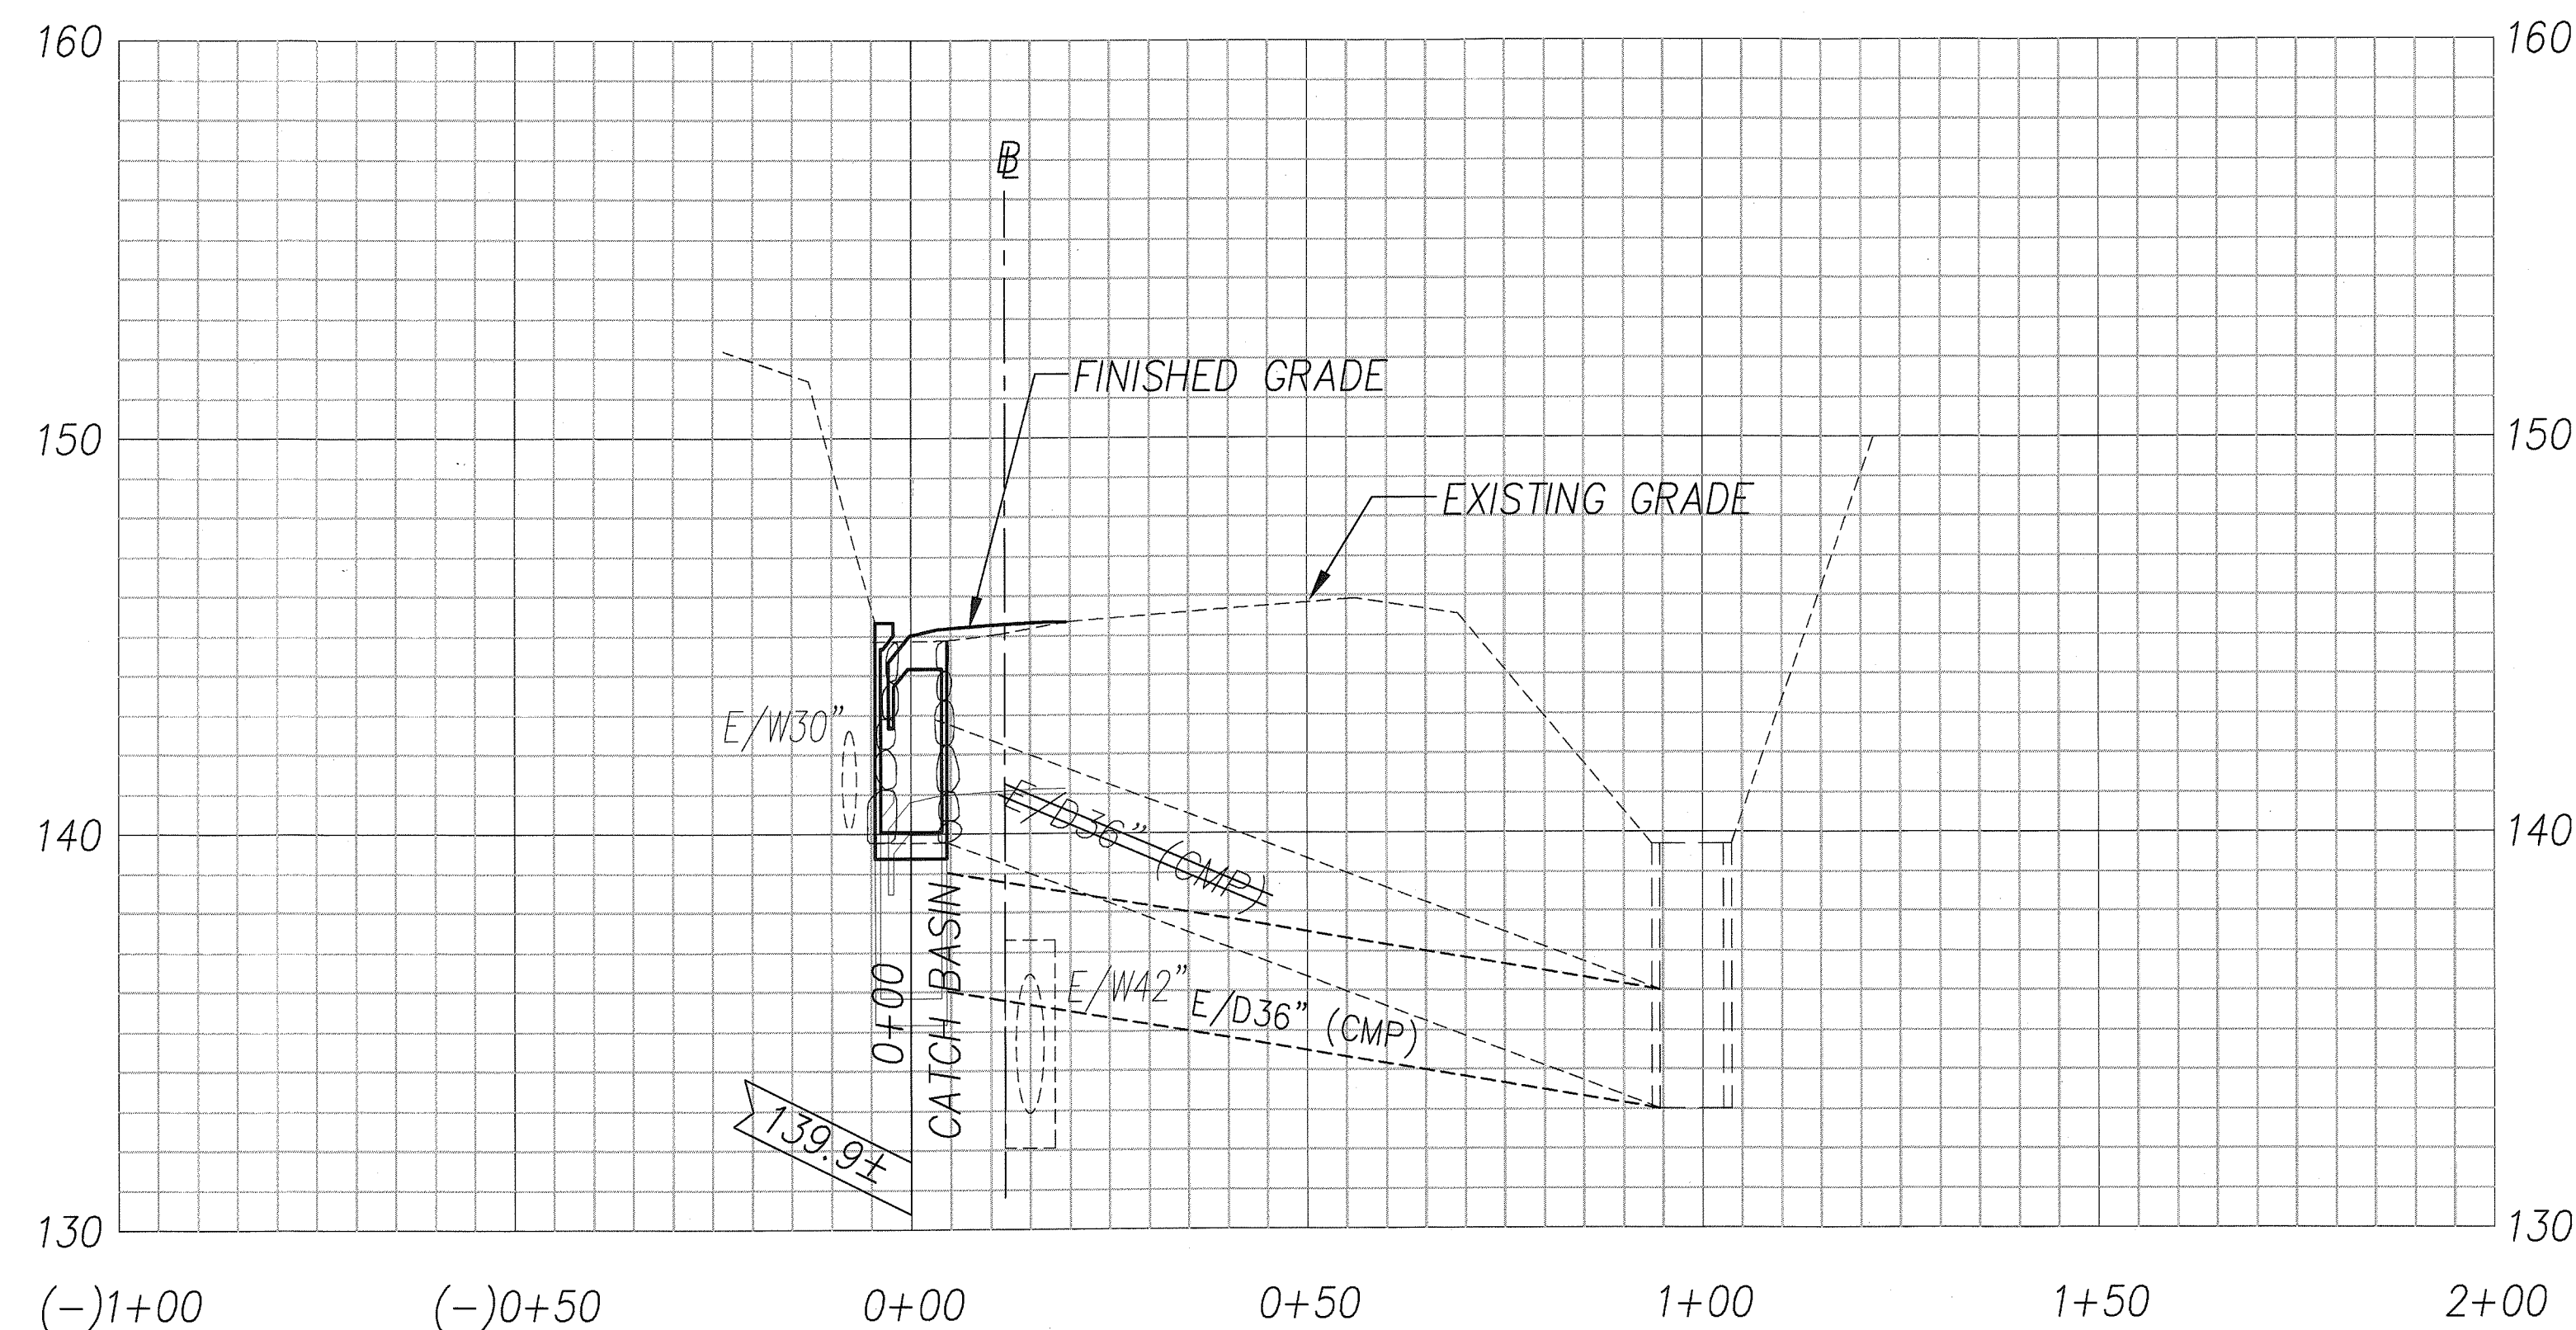

DRAINLINE PROFILE @ STA 136+25.21 TO 136+94  
HORIZ: 1"=20'; VERT: 1"=4'

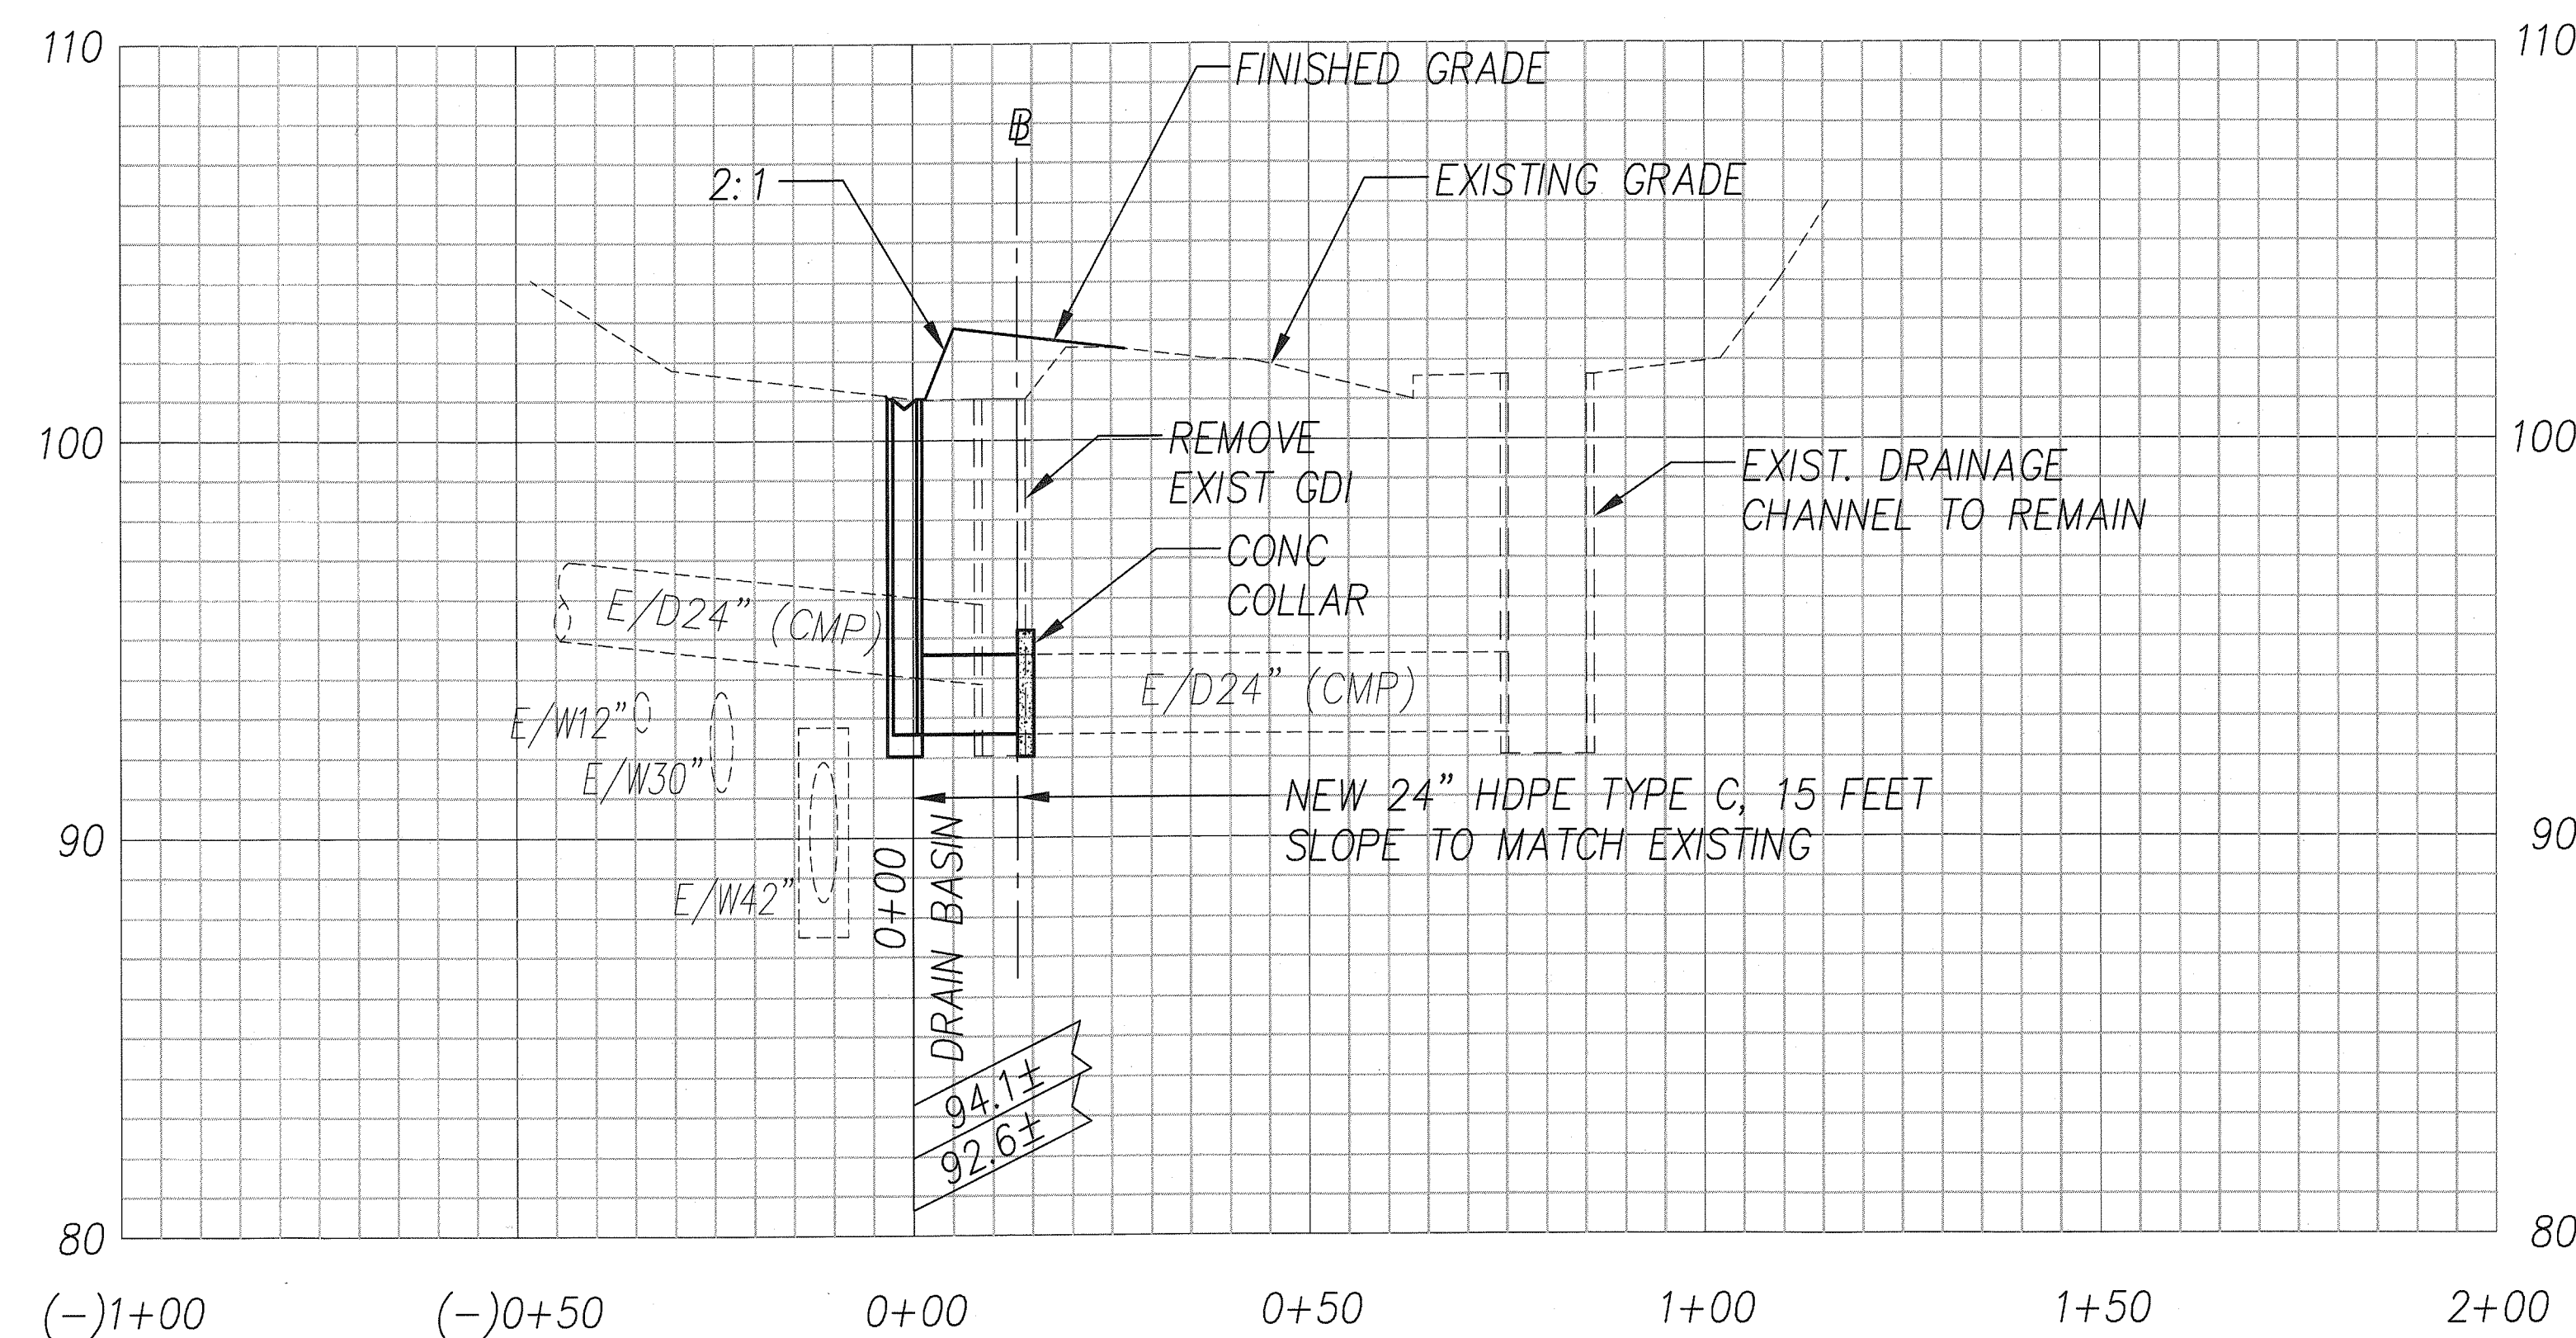

DRAINLINE PROFILE @ STA. 148+90.23  
HORIZ: 1"=20'; VERT: 1"=4'

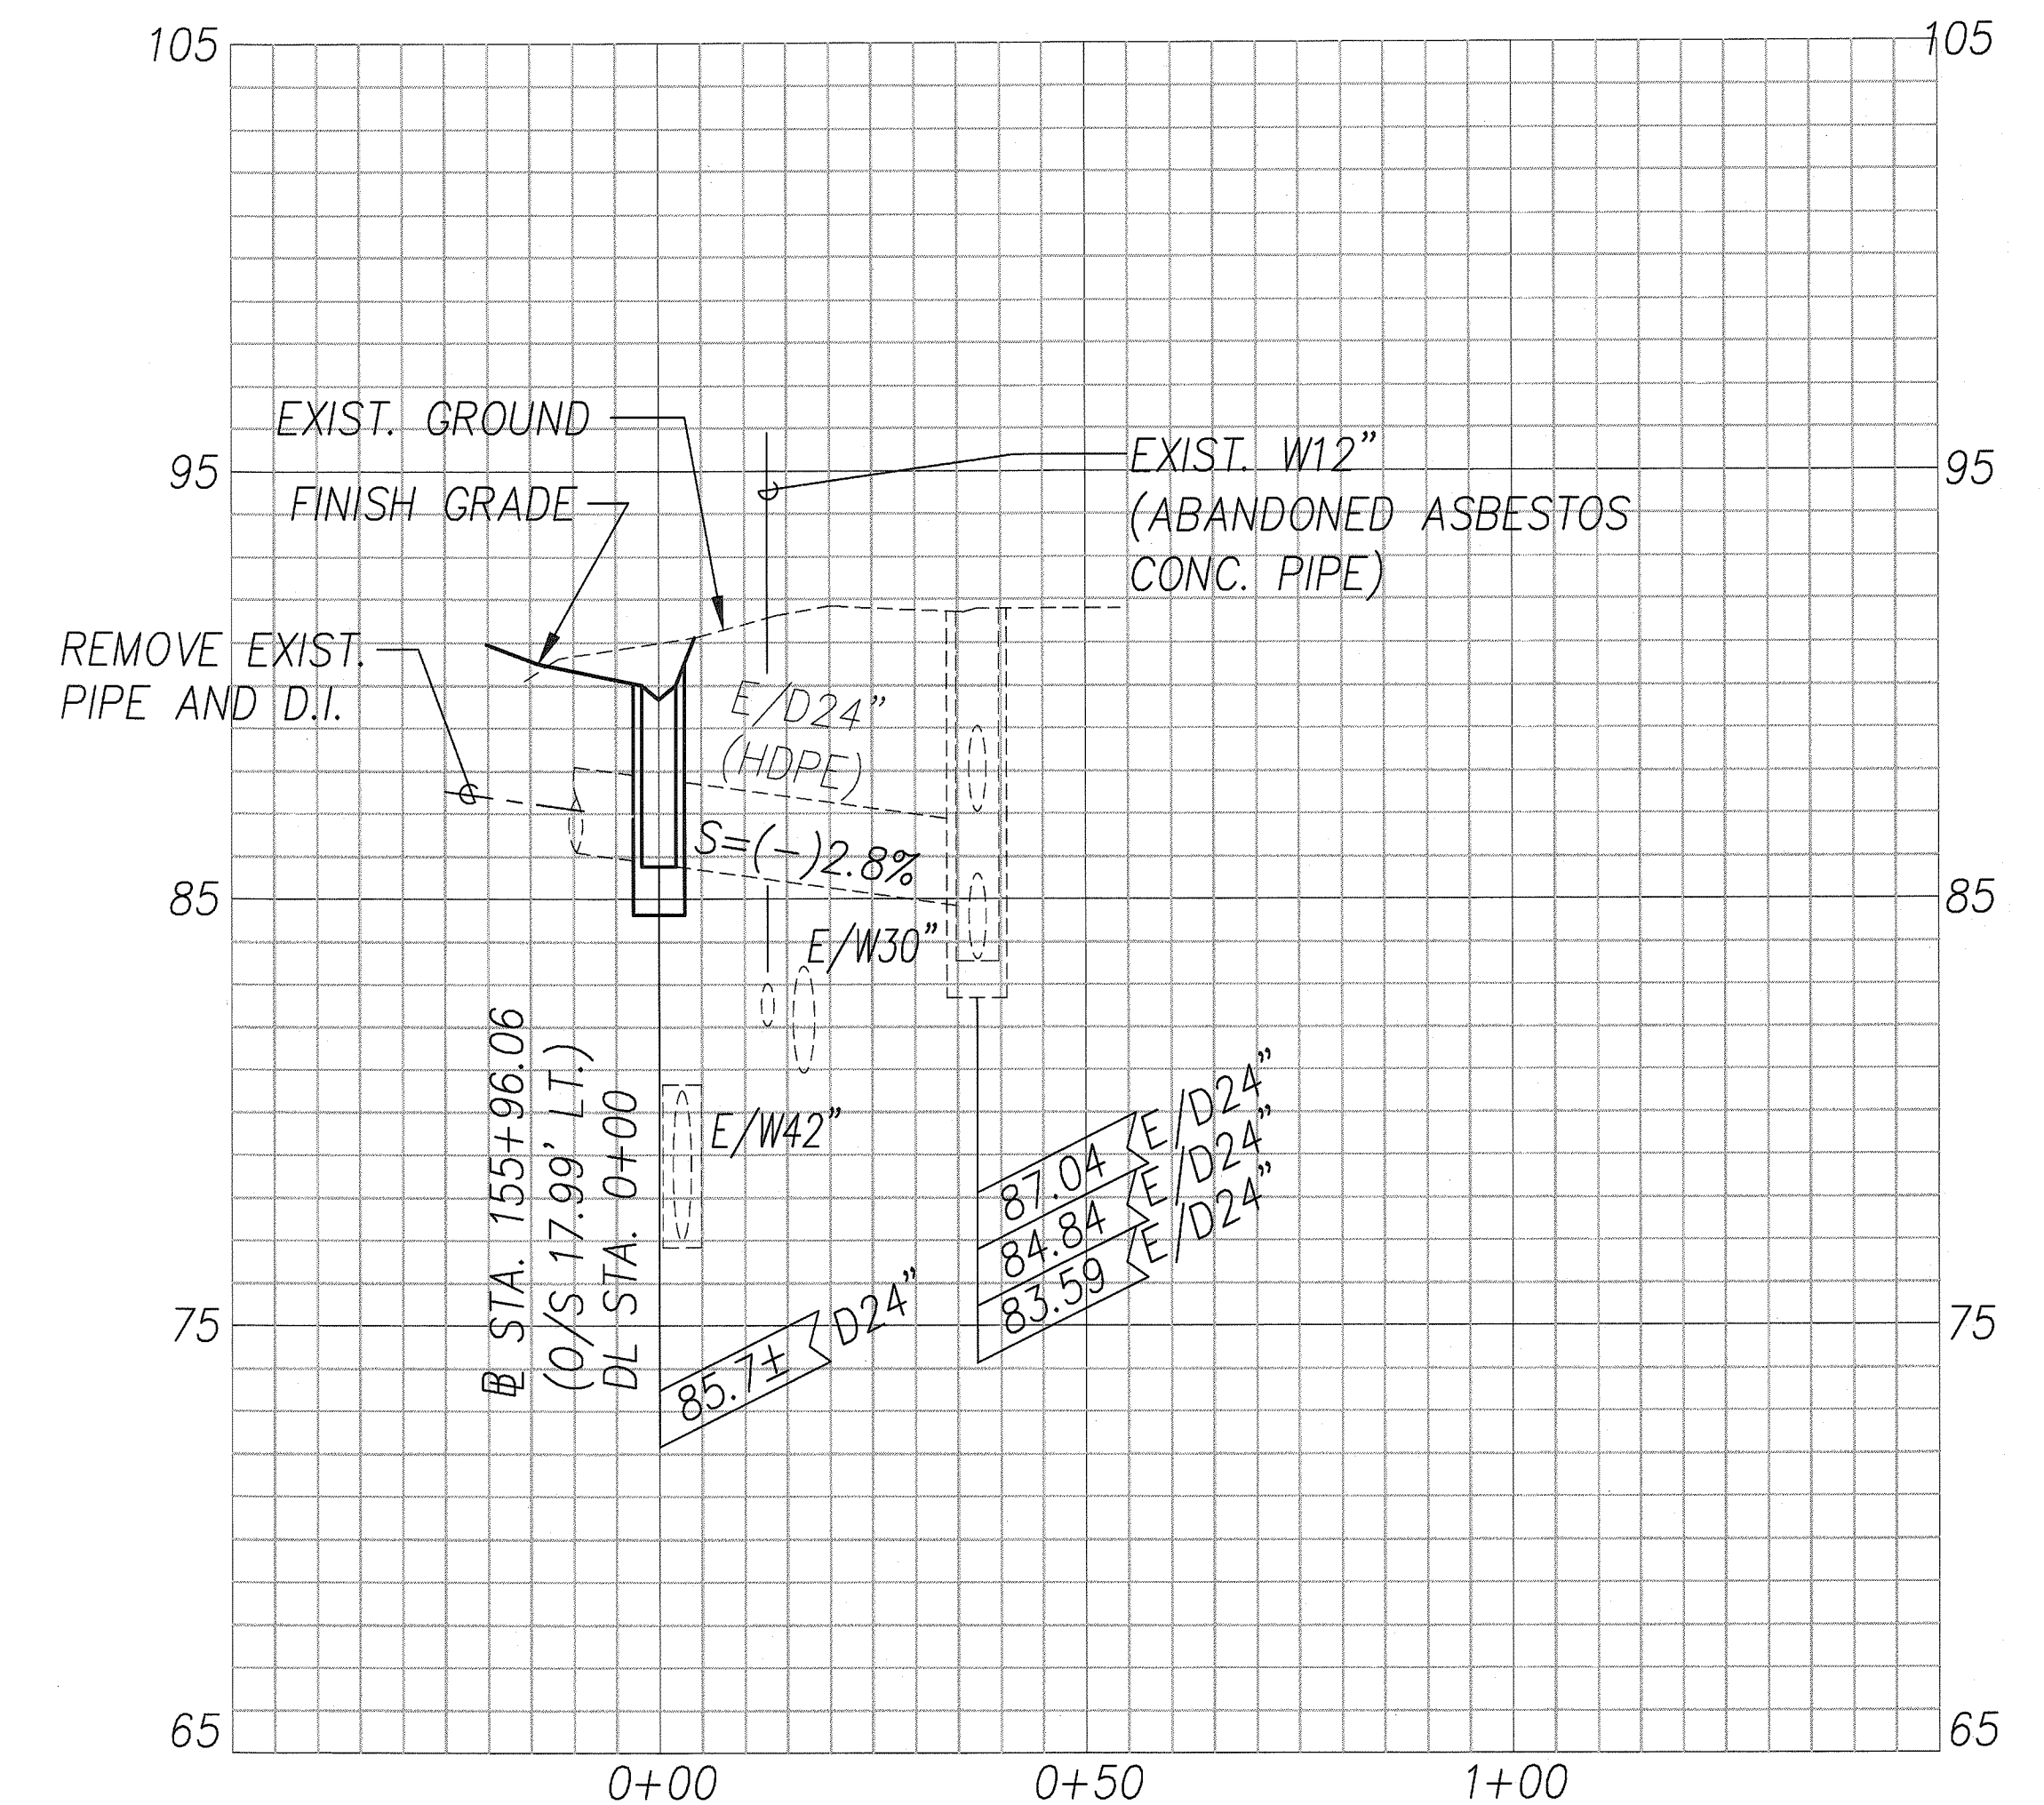

DRAINLINE PROFILE @ STA. 155+96.06  
HORIZ: 1"=20'; VERT: 1"=4'

| LEGEND FOR AS-BUILT POSTING |                                     |
|-----------------------------|-------------------------------------|
|                             | Squiggly line for as-built deletion |
|                             | Double line for as-built deletion   |
|                             | Text for as-built posting           |

KENNETH O. JAGAL  
LICENSED PROFESSIONAL ENGINEER  
No. 3265-C  
HAWAII, U.S.A.  
APRIL 30, 2008  
EXPIRATION DATE OF LICENSE  
THIS WORK WAS PREPARED BY ME OR UNDER MY SUPERVISION

STATE OF HAWAII  
DEPARTMENT OF TRANSPORTATION  
HIGHWAYS DIVISION

**DRAIN LINE PROFILES**  
**KAHEKILI HIGHWAY**  
**KAHEKILI HIGHWAY INTERSECTION IMPROVEMENTS**  
**VICINITY OF HUI IWA STREET**  
**FEDERAL-AID PROJECT NO. NH-083-1(60)**

SCALE: (H)1"=20', (V)1"=4' DATE: April 2007  
SHEET No. C-17 OF 90 SHEETS

|                   |      |
|-------------------|------|
| ORIGINAL PLAN     | DATE |
| SURVEY PLOTTED BY |      |
| TRACED BY         |      |
| DESIGNED BY       |      |
| QUANTITIES BY     |      |
| CHECKED BY        |      |

"AS-BUILT"