
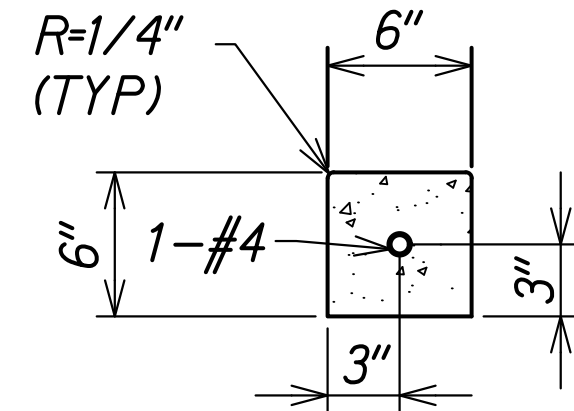


FED. ROAD DIST. NO.	STATE	PROJ. NO.	FISCAL YEAR	SHEET NO.	TOTAL SHEETS
HAWAII	HAW.	HWY-O-05-18	2018	16	25

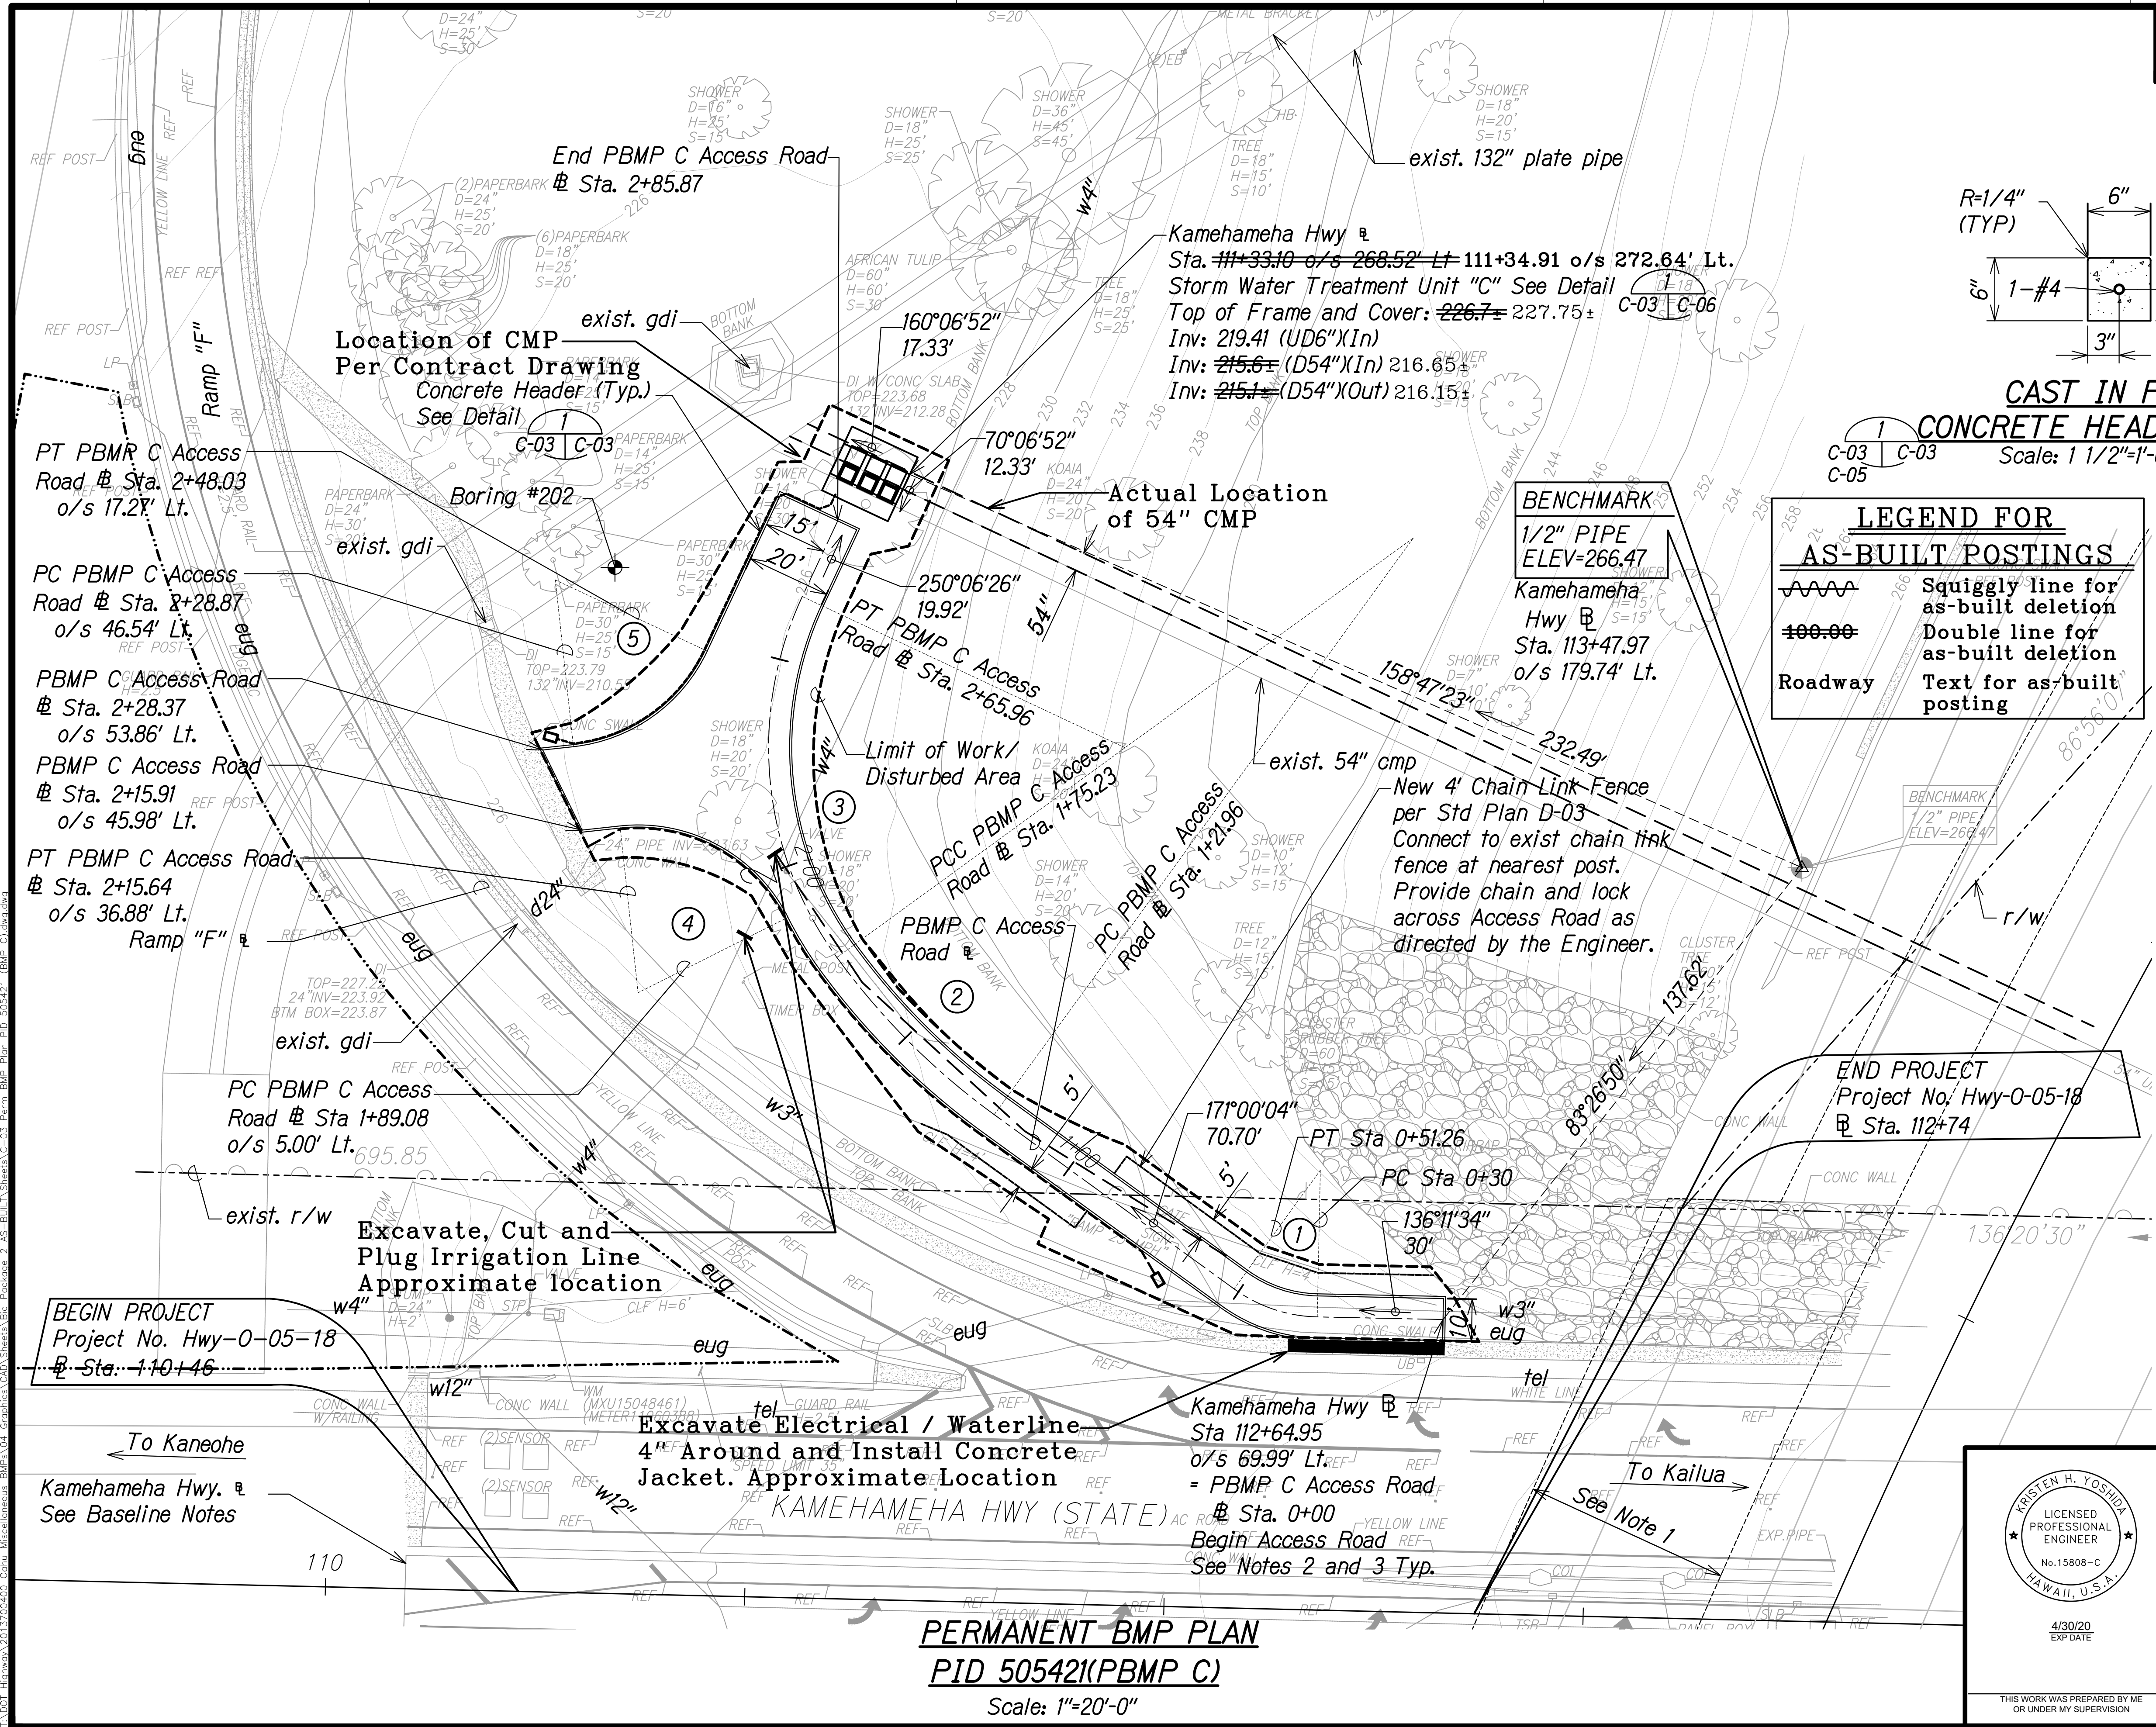

**CAST IN PLACE
CONCRETE HEADER DETAIL**
Scale: 1 1/2"=1'-0"

LEGEND FOR AS-BUILT POSTINGS	
	Squiggly line for as-built deletion
	Double line for as-built deletion
	Text for as-built posting

Curve Data Access Road					
No.	Delta	Tan	R	Ch	Lc
①	34°48'30"	10.97'	35'	20.94'	21.26'
②	17°57'16"	26.86'	170'	53.05'	53.27'
③	61°09'06"	50.22'	85'	86.48'	90.72'

Curve Data Access Road Edge of Permeable Paving System					
No.	Delta	Tan	R	Ch	Lc
④	69°28'60"	27.74'	40'	45.59'	48.51'
⑤	58°41'59"	22.49'	40'	39.21'	40.98'

- Notes:**
- Approximate limits of H-3 deck above.
 - For PBMP C Grading Plan, see Sheet C-04.
 - For PBMP C Access Road Profile and Section, see Sheet C-05.
 - Existing drainage system shall remain functional at all times. Install, operate, and maintain bypass as required.

Baseline Notes:
Kamehameha Hwy information taken from "Construction Plans for a Portion of Interstate Route H-3 Halekou Interchange", Project No. I-IR-H3-1(24)II, 1982.

4/30/20
EXP DATE

THIS WORK WAS PREPARED BY ME
OR UNDER MY SUPERVISION

STATE OF HAWAII
DEPARTMENT OF TRANSPORTATION
HIGHWAYS DIVISION

PERMANENT BMP PLAN
PID 505421 (PBMP C)

MISCELLANEOUS PERMANENT
BEST MANAGEMENT PRACTICES, PHASE 2B

Project No. HWY-0-05-18
Scale: 1"=20' **Date: April 2018**

SHEET No. **C-03** OF **7** SHEETS

DATE	_____
SURVEY PLOTTED BY	_____
DRAWN BY	_____
DESIGNED BY	_____
CHECKED BY	_____
ORIGINAL PLAN	_____
NOTE BOOK	_____
No.	_____

T:\DOT Highway\2013\700400 - Oahu Miscellaneous BMPs\04 - Coastal\CD\Sheet\Sheet C-03 Perms BMP Plan.BMP 505421 (PBMP C) dms.dwg