


GENERAL NOTES:

1. The scope of work for this project consists of extending an existing left turn lane, excavation of a median, curb and roadway construction, resurfacing existing pavement, installing and relocating signs and installing pavement markers and striping.
2. The existence and location of underground utilities, appurtenances and structures as shown on the plans are from the latest available data but is not guaranteed as to the accuracy or the encountering of other obstacles during the course of the work. The contractor shall be responsible and shall pay for all damages to existing utilities resulting from his operations. All damaged portions shall be replaced in accordance with the Standards and Specifications of the State and/or the affected utility company.
3. Sawcutting of the existing asphalt concrete pavement and removing existing curb shall be considered incidental to roadway excavation.
4. The exact limits of constructing the specified items are approximate. The exact locations shall be determined in the field by the Engineer.
5. The Contractor's attention is directed to Subsection 107.13- Public Convenience and Safety; Section 645- Traffic Control of the Special Provisions and Subsection 107.21- Contractor's Responsibility for Utility Property and Service for Hawaiian Electric Co., Hawaiian Telephone Co., Board of Water Supply, GASCO and Wastewater Management (Sewer) Utility Notes.
6. The existing portland cement concrete pavement shall be resurfaced with Asphalt Concrete Pavement, Mix No. V. Minimum depth of resurfacing shall be 1 1/2".
7. As shown on the plans or directed by the Engineer, a smooth transition shall be provided at the beginning and end of resurfacing.

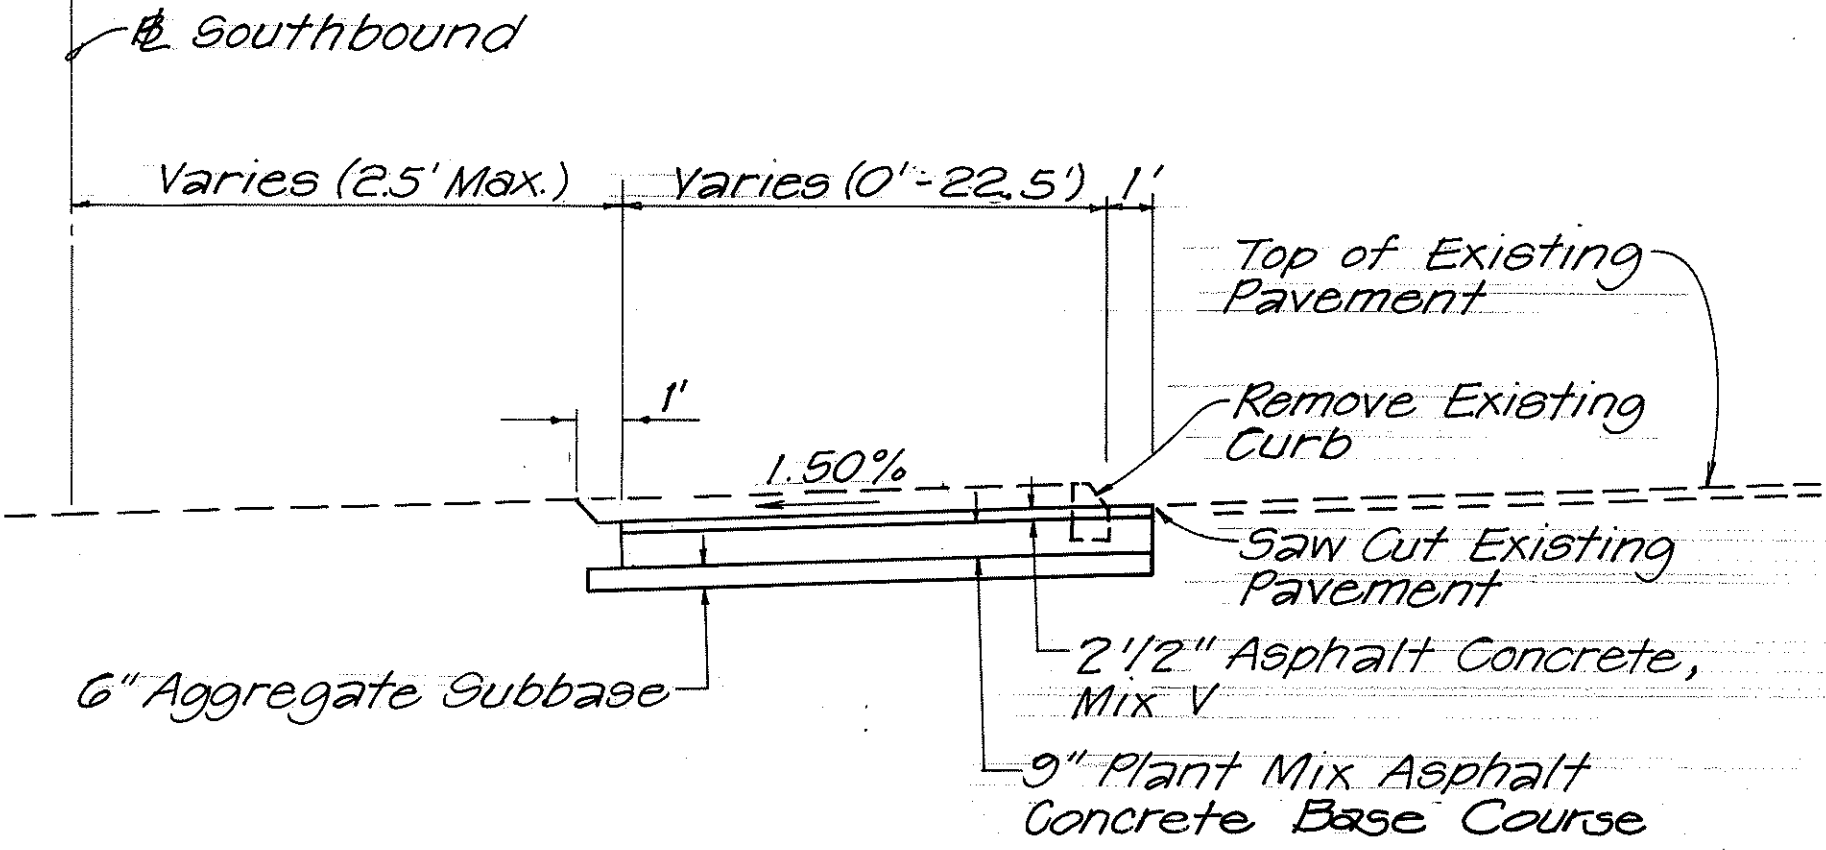


TYPICAL SECTION~ KAMEHAMEHA HWY.

S.B. STA. 35+12± TO S.B. STA. 37+10±

Scale: 1/4" = 1'-0"

OFFSET DISTANCES FROM EDGE OF PAVEMENT TO SOUTHBOUND	
STATION	OFFSET (FT.)
35+20	2.5' Rt.
37+10	12' Lt.

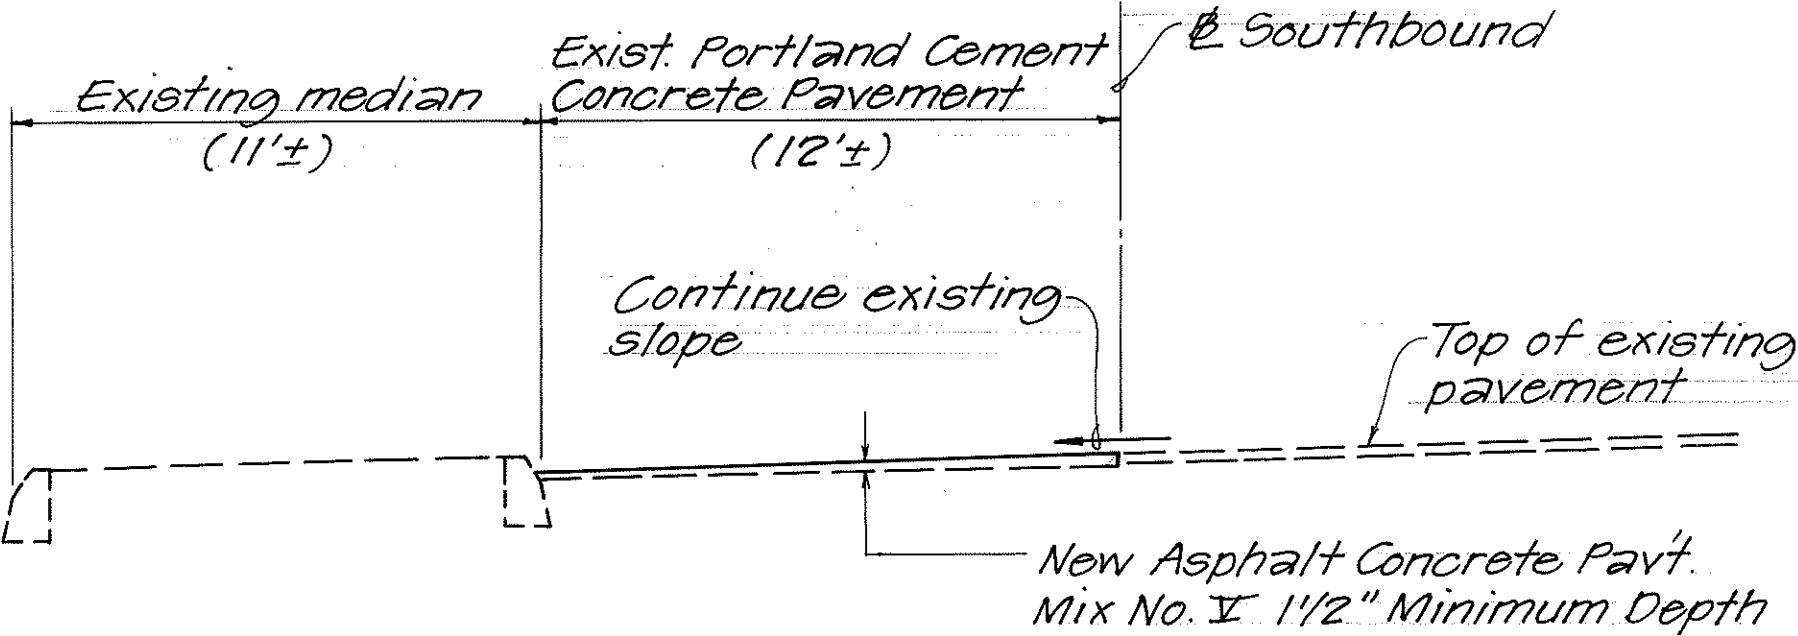

TYPICAL SECTION~ KAMEHAMEHA HWY.

S.B. STA. 36+25± TO S.B. STA. 38+59±

Scale: 1/4" = 1'-0"

FED. ROAD DIST. NO.	STATE	FED-AID PROJ. NO.	FISCAL YEAR	SHEET NO.	TOTAL SHEETS
HAWAII	HAW.	83G-01-87	1988	3	5

LEGEND

- ac-- Existing Signal Corps Line
- t-- Existing Telephone Line
- g-- Existing Gas Line
- w-- Existing Water Line
- o wmh Existing Water Manhole
- o jp Existing Joint Pole
- o ep Existing Electric Pole
- o HJComh Existing Telephone Manhole

2/8/88 Revised Typical & 96 Distance

DATE REVISION

STATE OF HAWAII
DEPARTMENT OF TRANSPORTATION
HIGHWAYS DIVISION

**TYPICAL SECTION, GENERAL
NOTES AND LEGEND**

KAMEHAMEHA HIGHWAY
Intersection Improvements
at Likelike Highway
PROJECT NO. 83G-01-87
Scale: As Noted Date: July, 1987

SHEET No. 1 OF 1 SHEETS