

INDEX TO DRAWINGS	
SHEET NO.	DESCRIPTION
1	Title Sheet
2	Typical Road Sections
3-16	Plan and Profile
17-18	Standard Detail Sheets
19-22	Culvert and Syphon Details
23-24	Retaining Wall Details
25-37	Bridge Details
38-99	Cross Sections

38
61
16
71



TERRITORY OF HAWAII
TERRITORIAL HIGHWAY DEPARTMENT
HONOLULU T.H

PLANS OF
KAMEHAMEHA HIGHWAY
NATIONAL RECOVERY HIGHWAY PROJECT NO. N.R.H. 9A
HAWAII F.A.P. NO. 9A
DISTRICT OF HONOLULU-EWA
ISLAND OF OAHU

CONVENTIONAL SIGNS

Present Road	
Existing Fence	
Boundary Line (not fenced)	
Existing Stone Fence	
Railroad	
Center Line	
Large Tree	
Cement Rubble Retaining Walls	
Bridges	
Culverts	

SCALE	
PLAN	1 INCH = 100 FEET
PROFILE	HOR. 1 INCH = 100 FEET VER. 1 INCH = 10 FEET
CROSS SECTION	1 INCH = 5 FEET

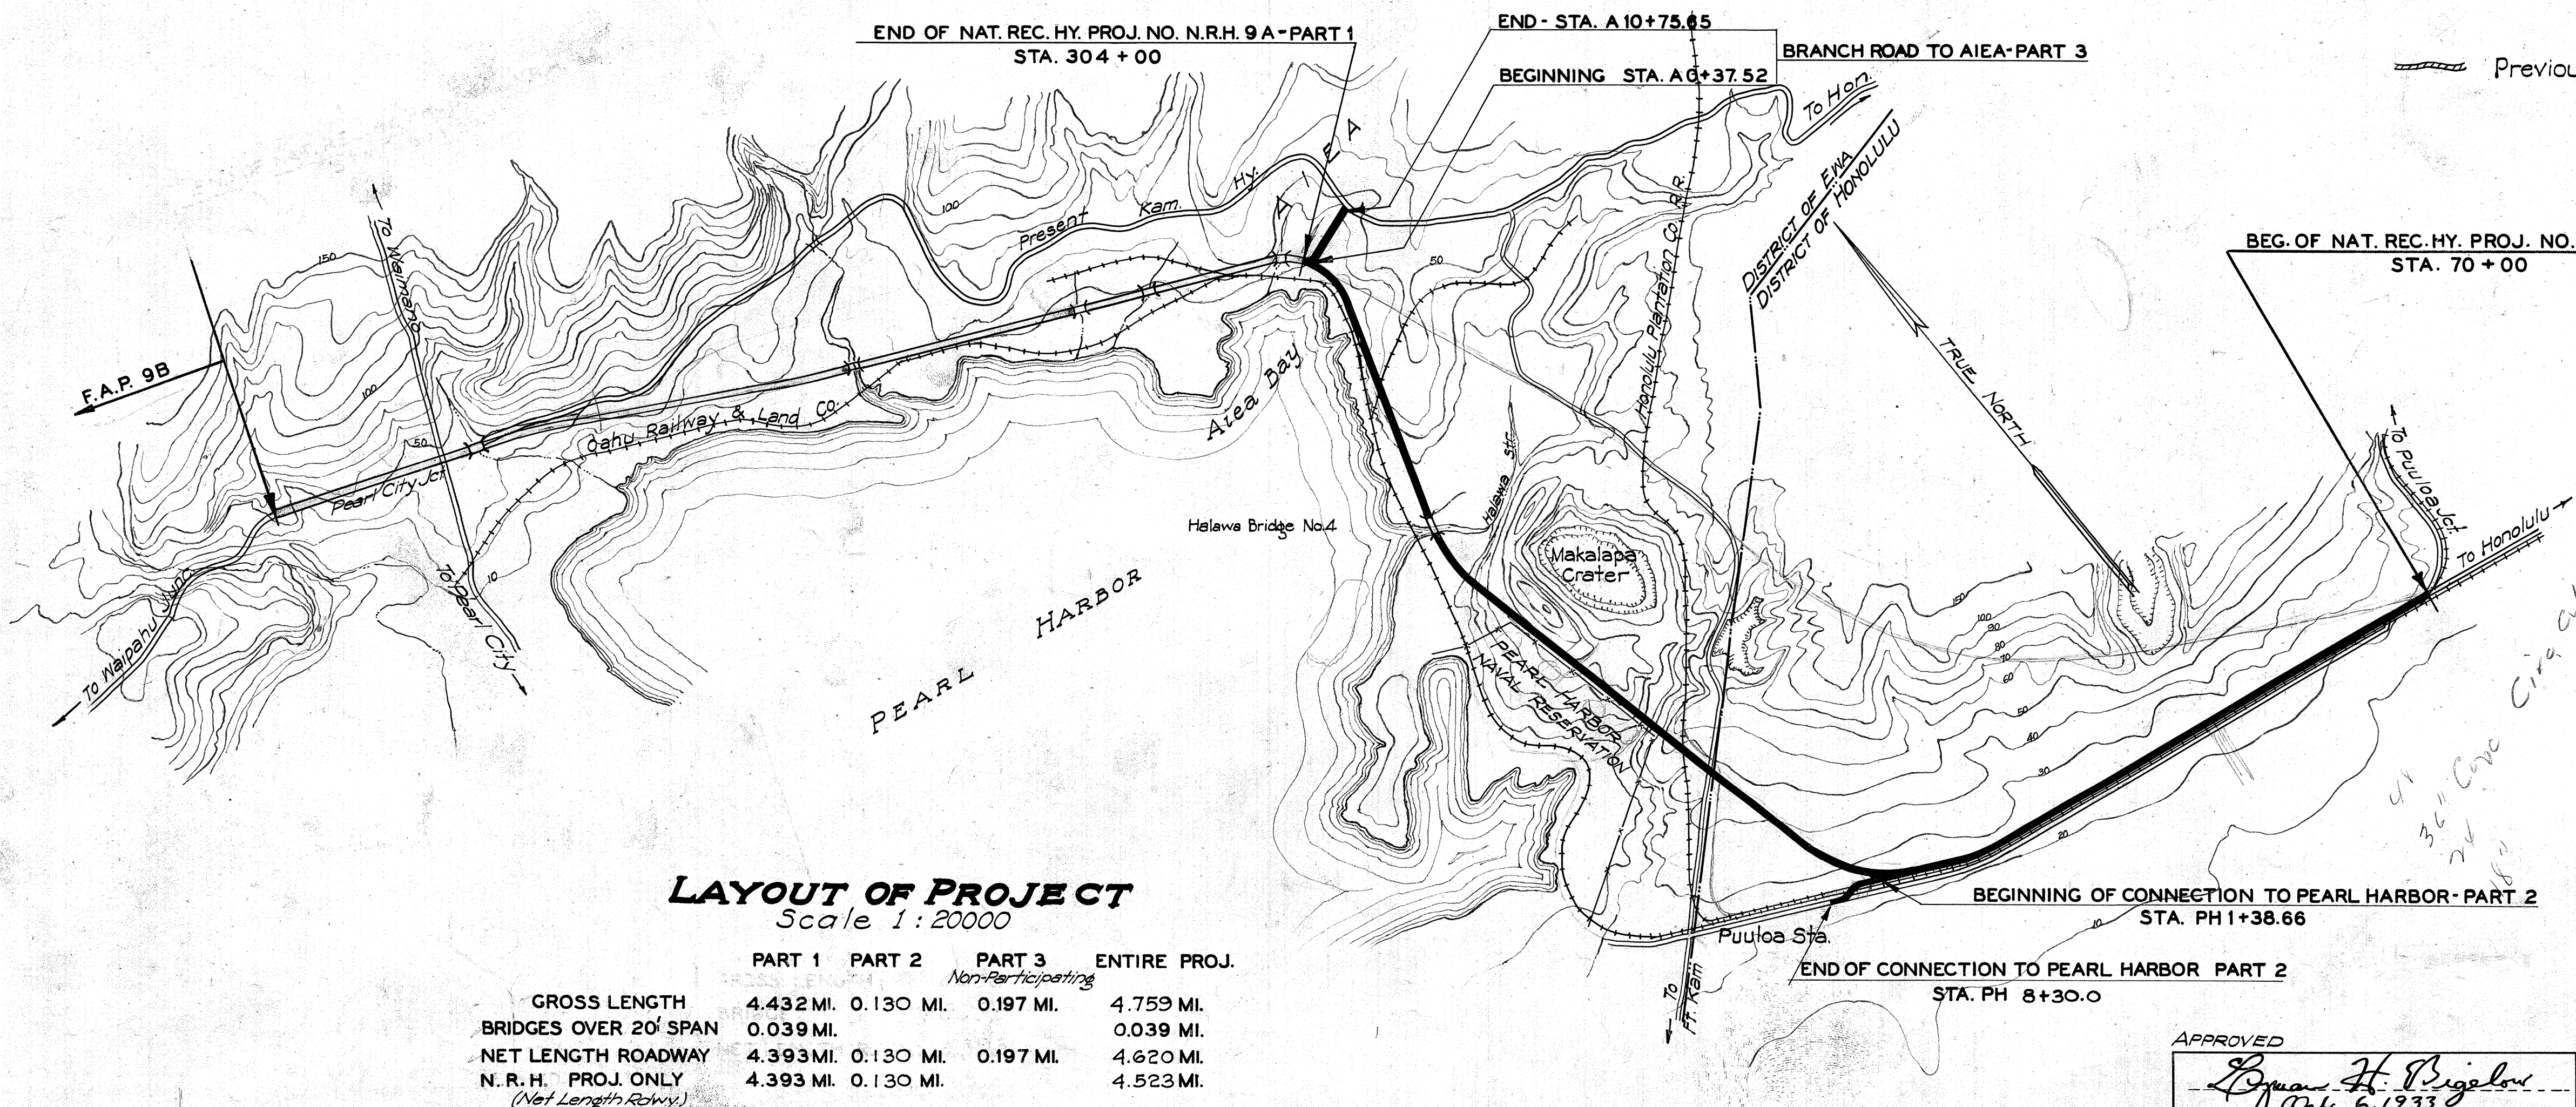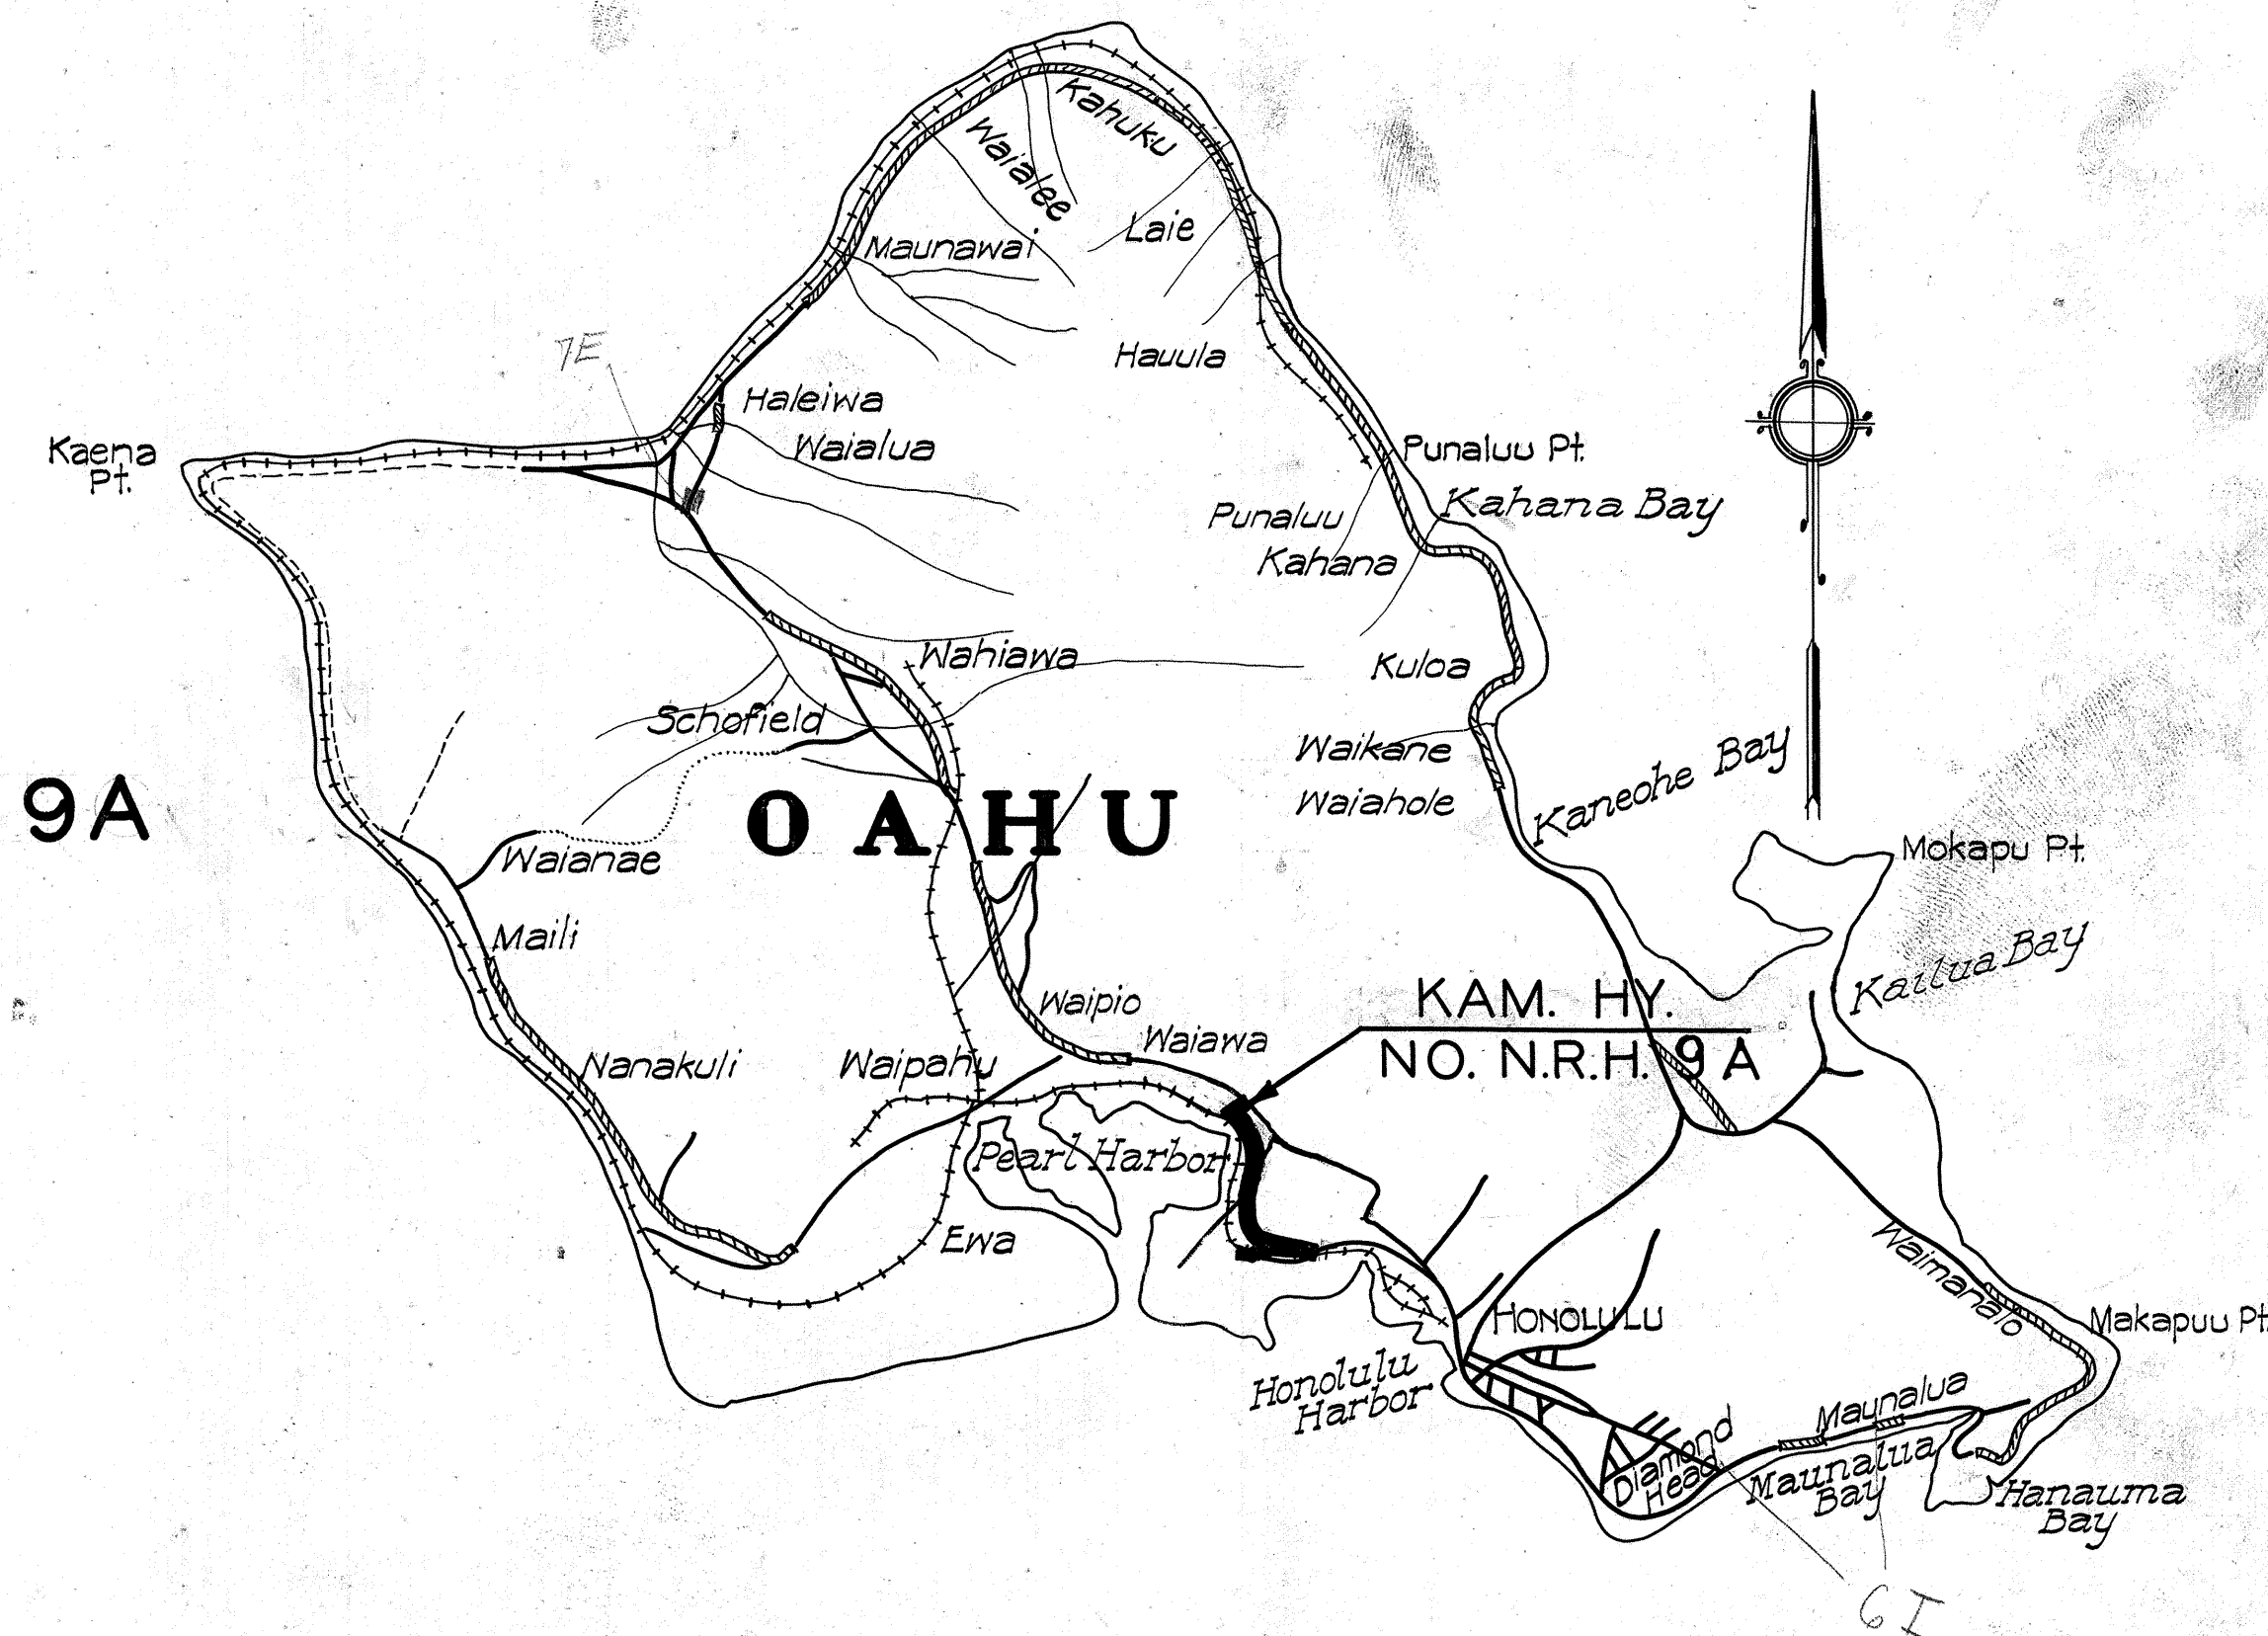

LAYOUT OF PROJECT
Scale 1:20000

	PART 1	PART 2	PART 3	ENTIRE PROJ.
GROSS LENGTH	4.432 MI.	0.130 MI.	0.197 MI.	4.759 MI.
BRIDGES OVER 20' SPAN	0.039 MI.			0.039 MI.
NET LENGTH ROADWAY	4.393 MI.	0.130 MI.	0.197 MI.	4.620 MI.
N. R. H. PROJ. ONLY (Net Length Roadway)	4.393 MI.	0.130 MI.		4.523 MI.

BEG. OF NAT. REC. HY. PROJ. NO. N.R.H. 9A-PART 1
STA. 70+00

Previously constructed Federal Aid Projects

GENERAL NOTE
Irrigation ditches and appurtenances, except syphons and culverts under new roadway, and all fences including gates are not a part of this contract even though shown on the plans. The quantities involved in these items are not included in the proposal.

RECOMMENDED FOR APPROVAL

Robert H. Bigelow 10-7-33

PRINCIPAL HIGHWAY ENGR. (Bureau of Public Roads)

RECOMMENDED FOR APPROVAL

Robert H. Bigelow

CHIEF ENGR. (Bureau of Public Roads)

APPROVED

Robert H. Bigelow

DIRECTOR (Bureau of Public Roads)

APPROVED

Robert H. Bigelow
Oct. 6, 1933

TERRITORIAL HIGHWAY ENGINEER

NOTE: REVISED 8-28-34. LOCATION & LENGTH OF PART 2 CHANGED.

4300.1