



FED. ROAD DIST. NO.	STATE	FED. AID PROJ. NO.	FISCAL YEAR	SHEET NO.	TOTAL SHEETS
HAWAII	HAW	NRH9E	1935	8	10

FINAL SURVEY	DATE
SURVEYED	
PLANNED	
NOTE BOOK	
AREAS	
CHECKED	
NO.	

ORIGINAL SURVEY	DATE
SURVEYED	Dec 35
PLANNED	
NOTE BOOK	
AREAS	
CHECKED	
NO.	

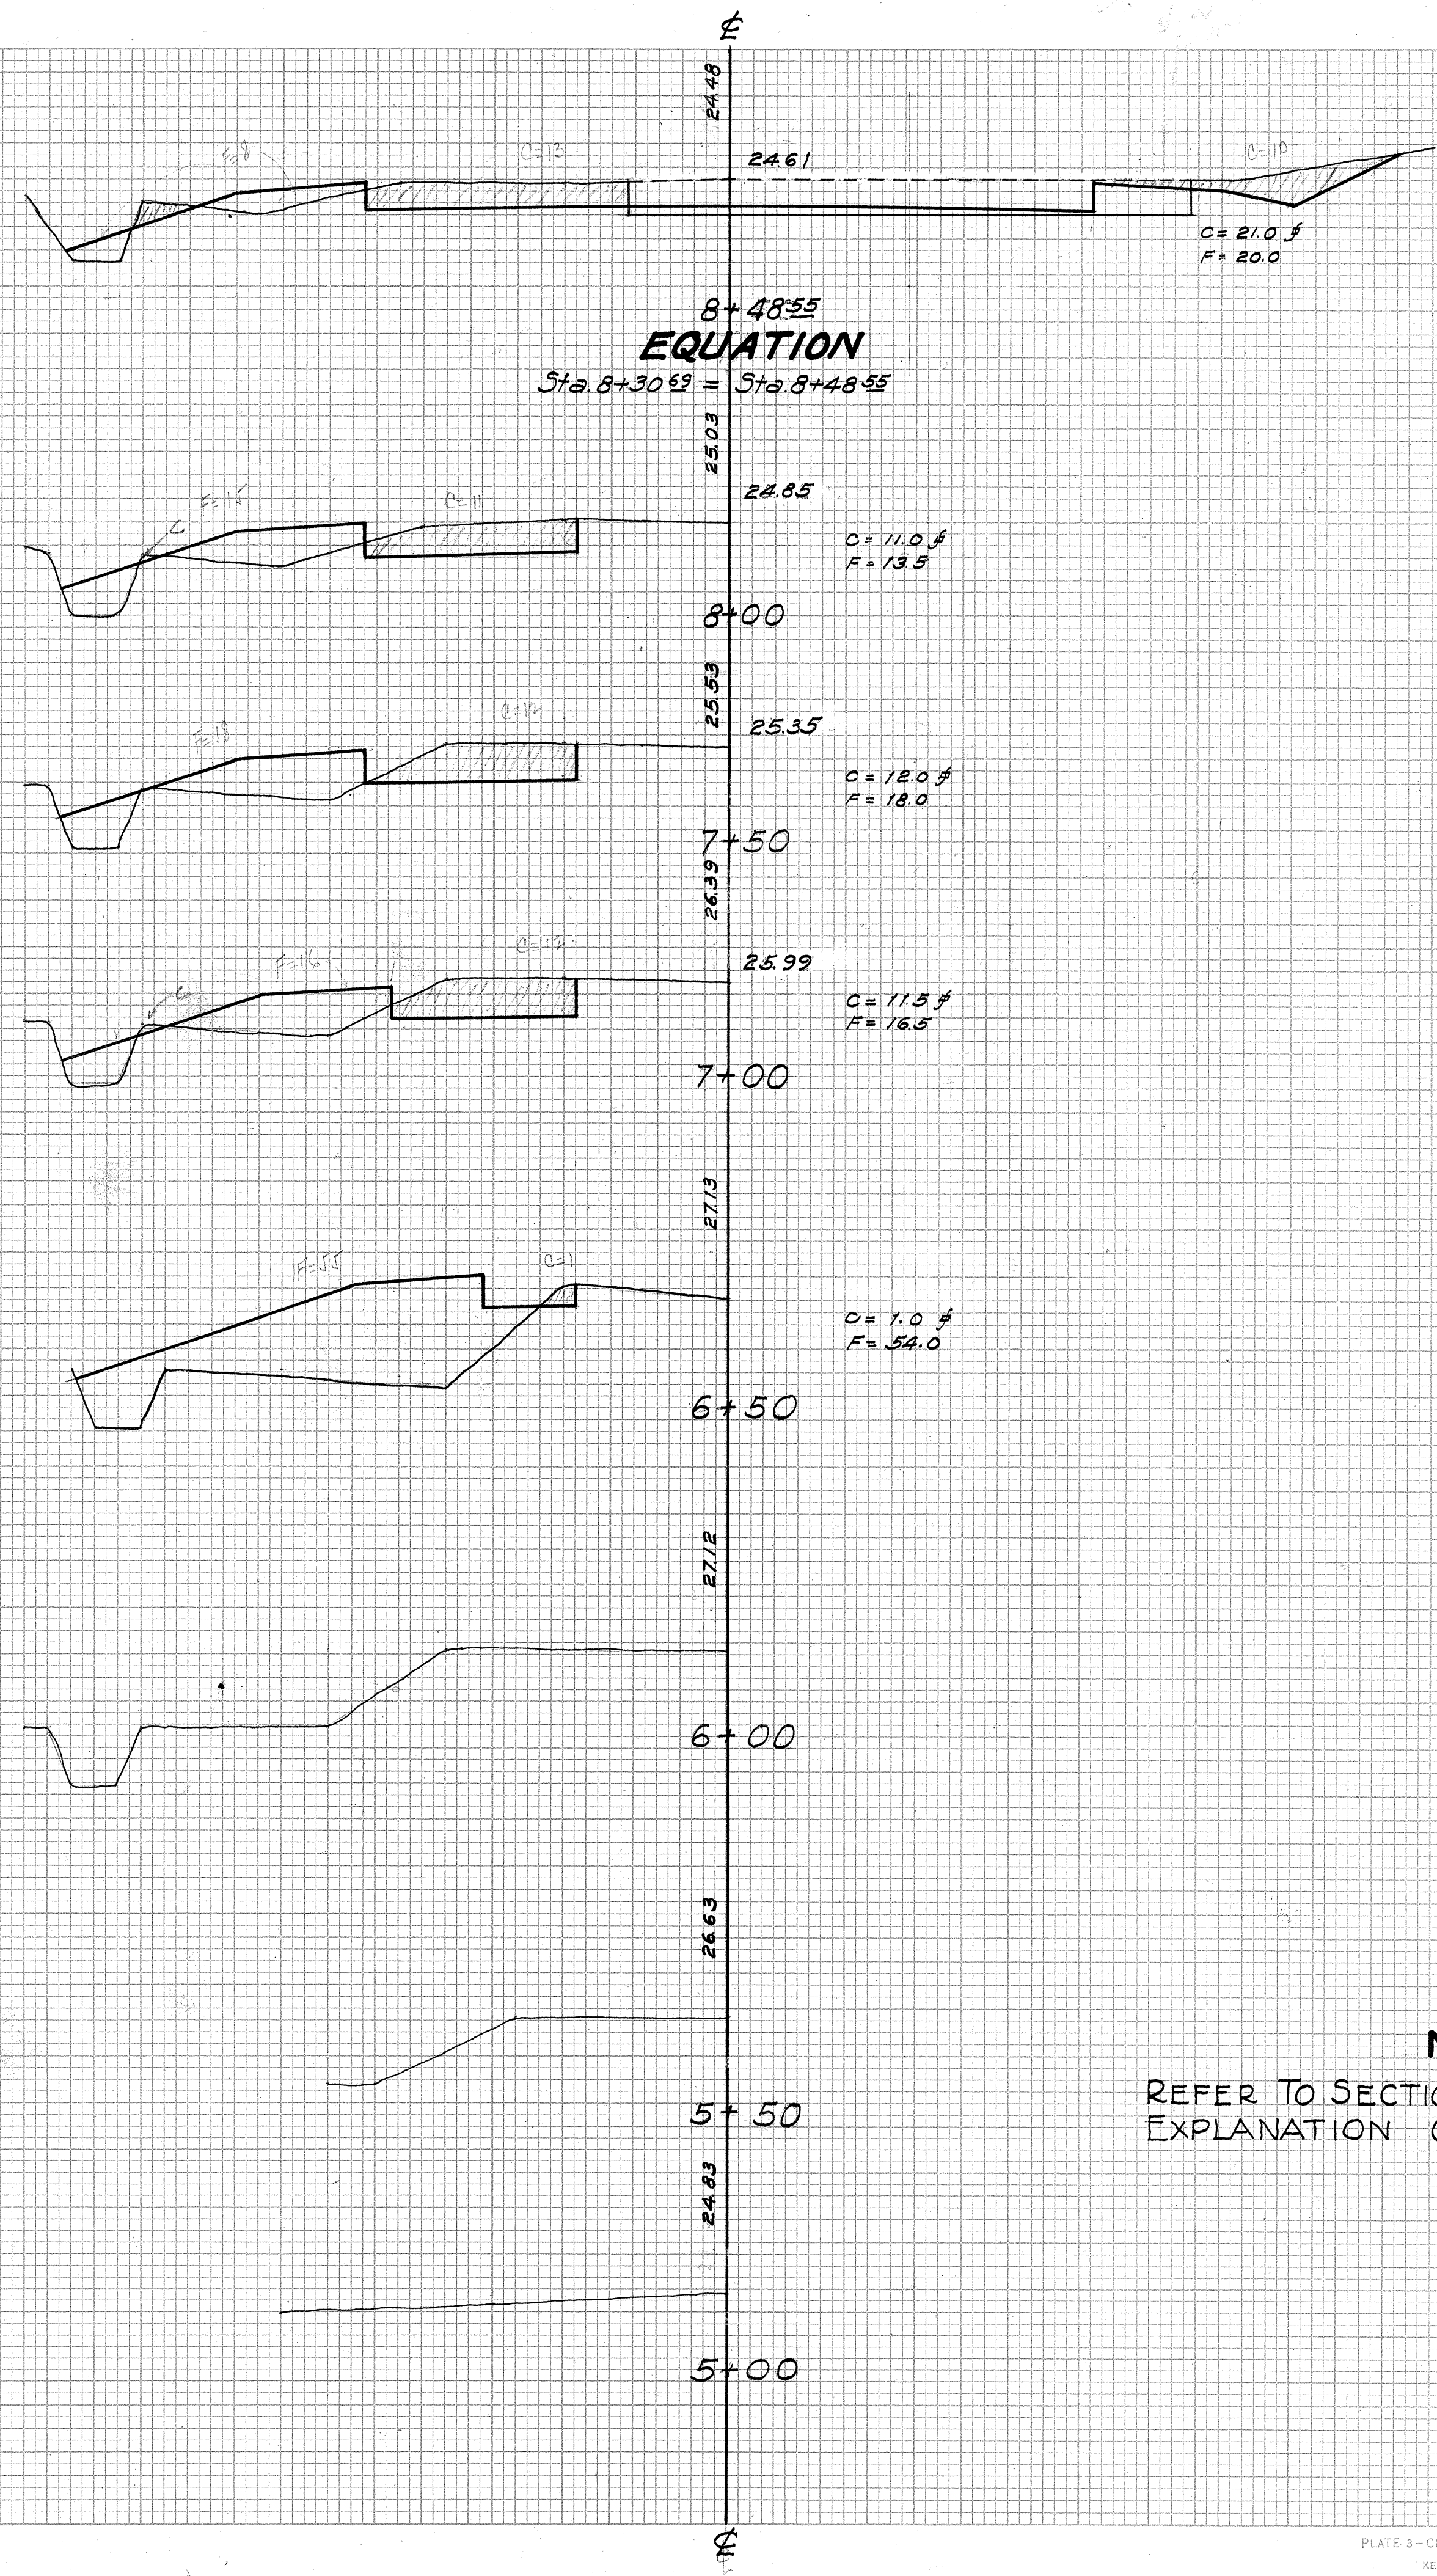

NOTE!
REFER TO SECTION STA. 10+00 FOR
EXPLANATION OF CROSS SECTIONS

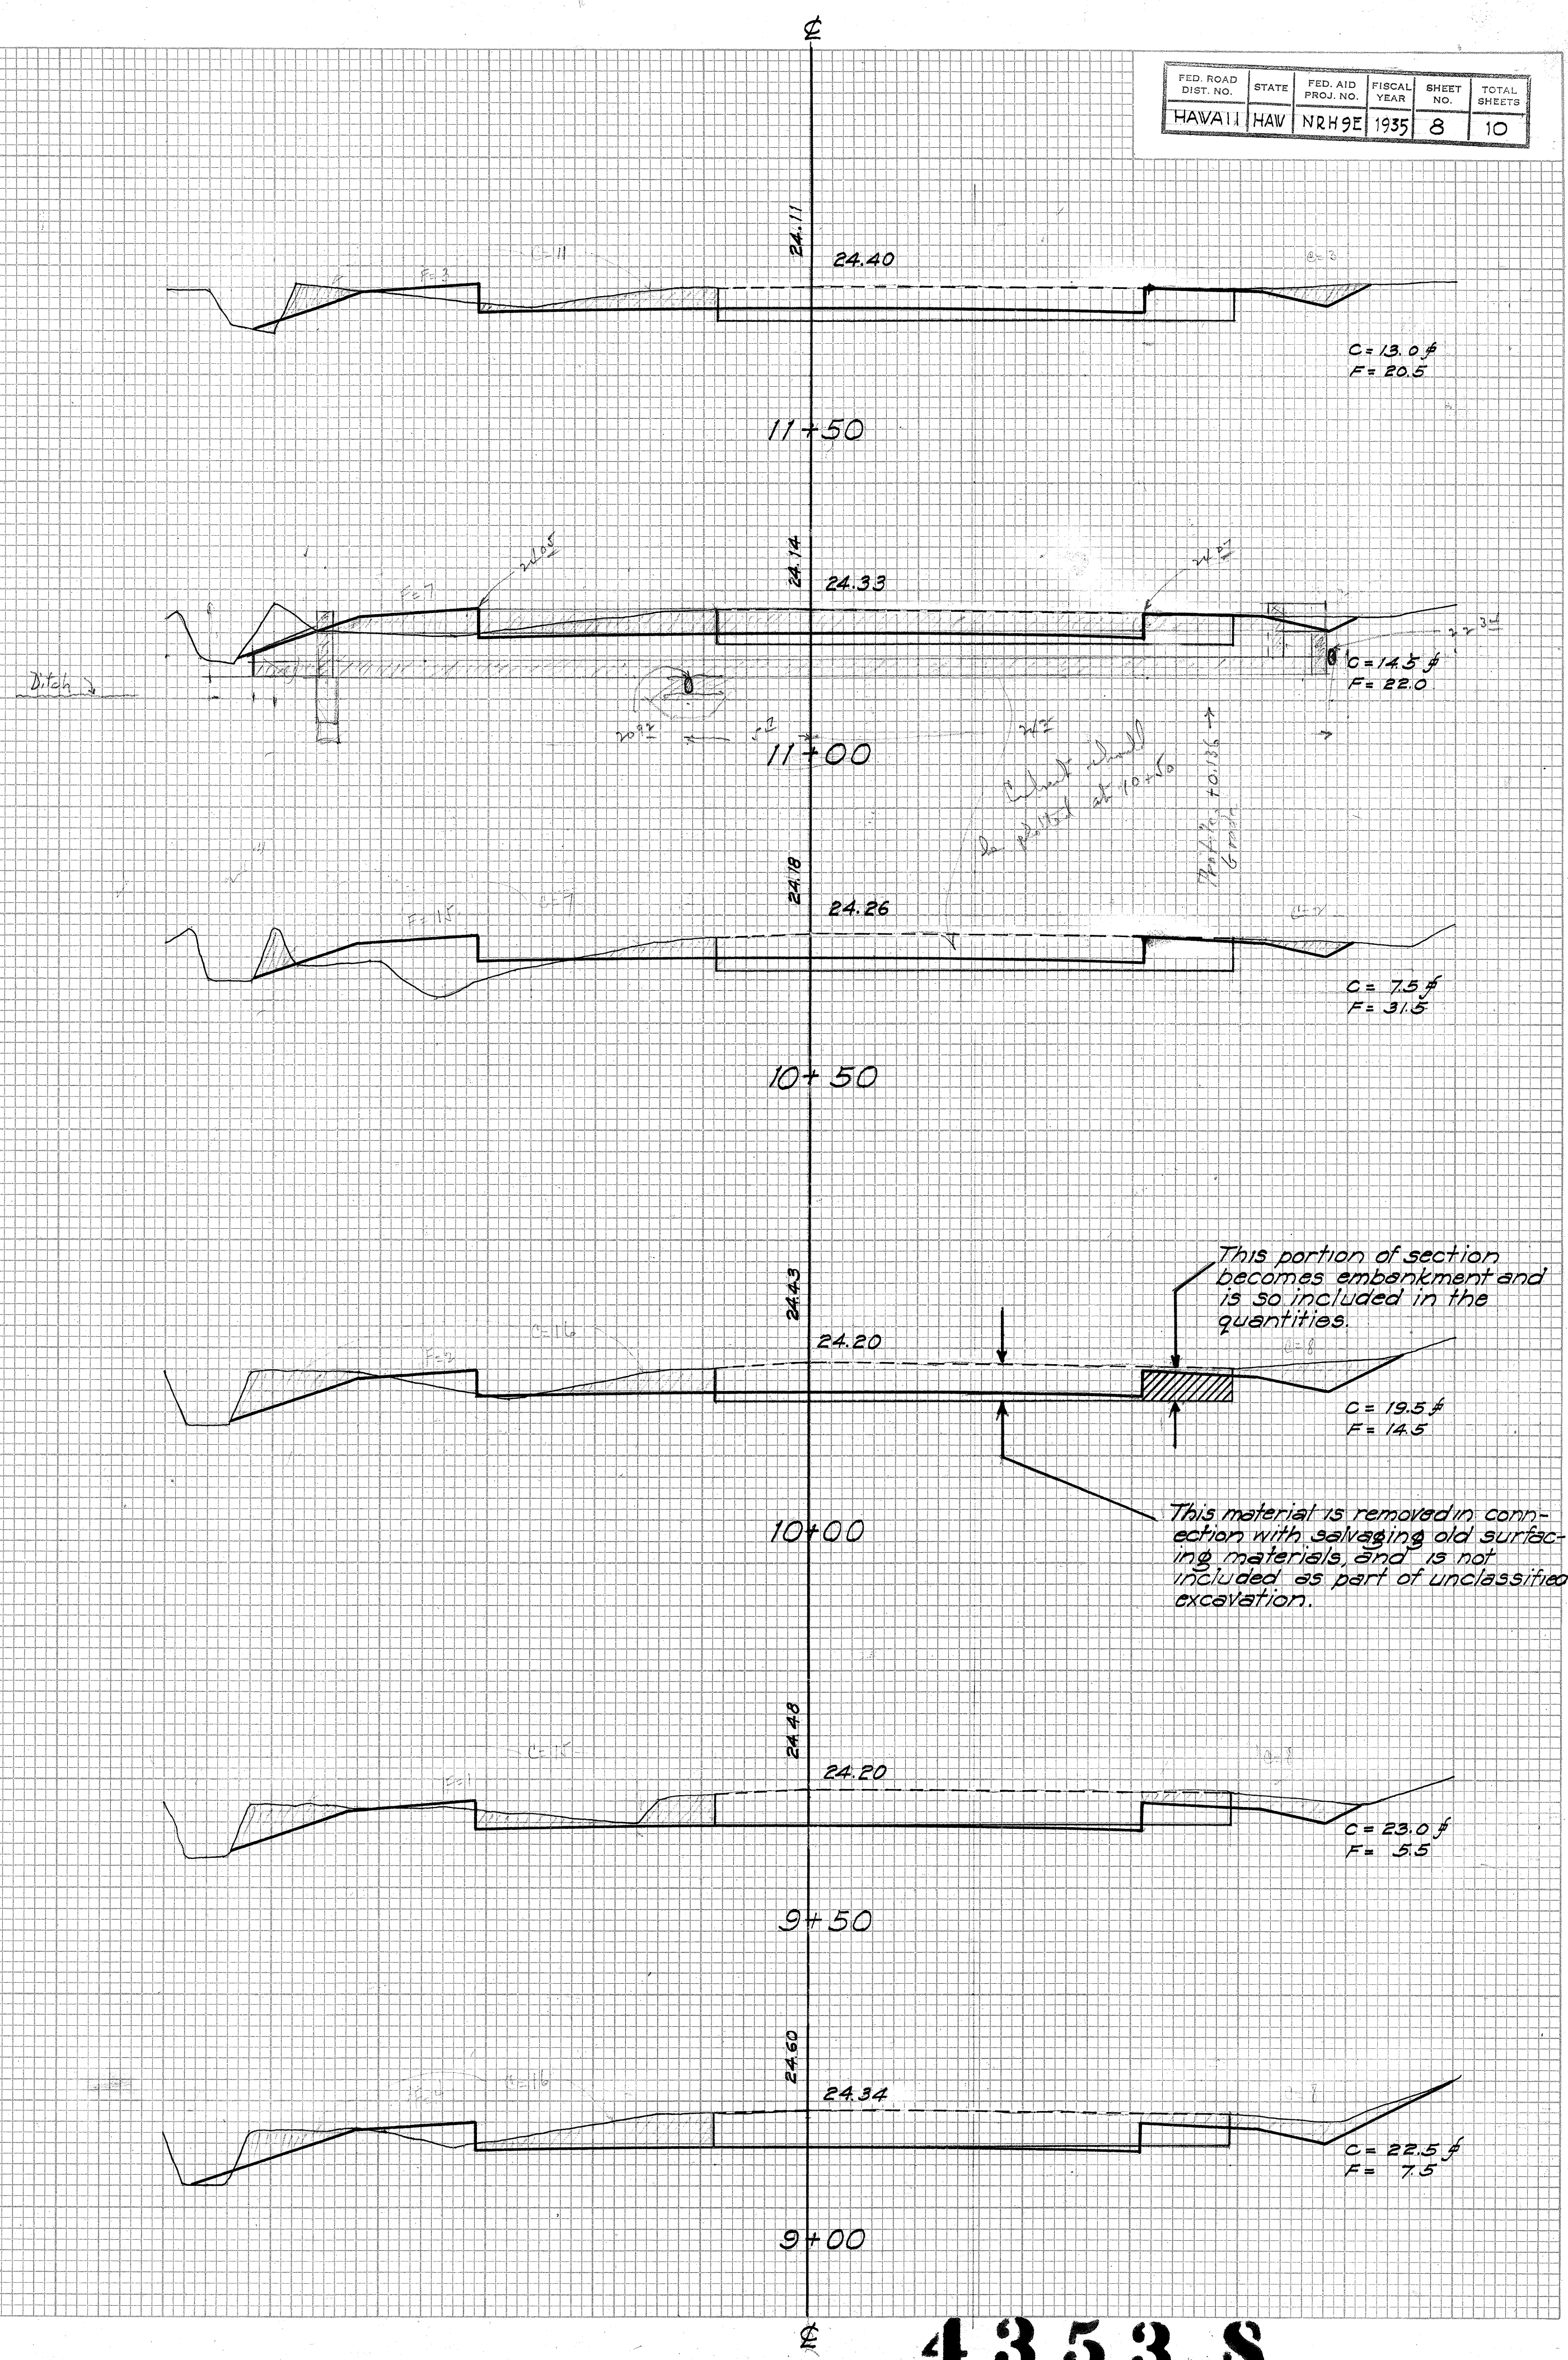

4353.8

FED. ROAD DIST. NO.	STATE	FED. AID PROJ. NO.	FISCAL YEAR	SHEET NO.	TOT. SHEETS
HAWAII	HAW	NRH9E	1935	9	10

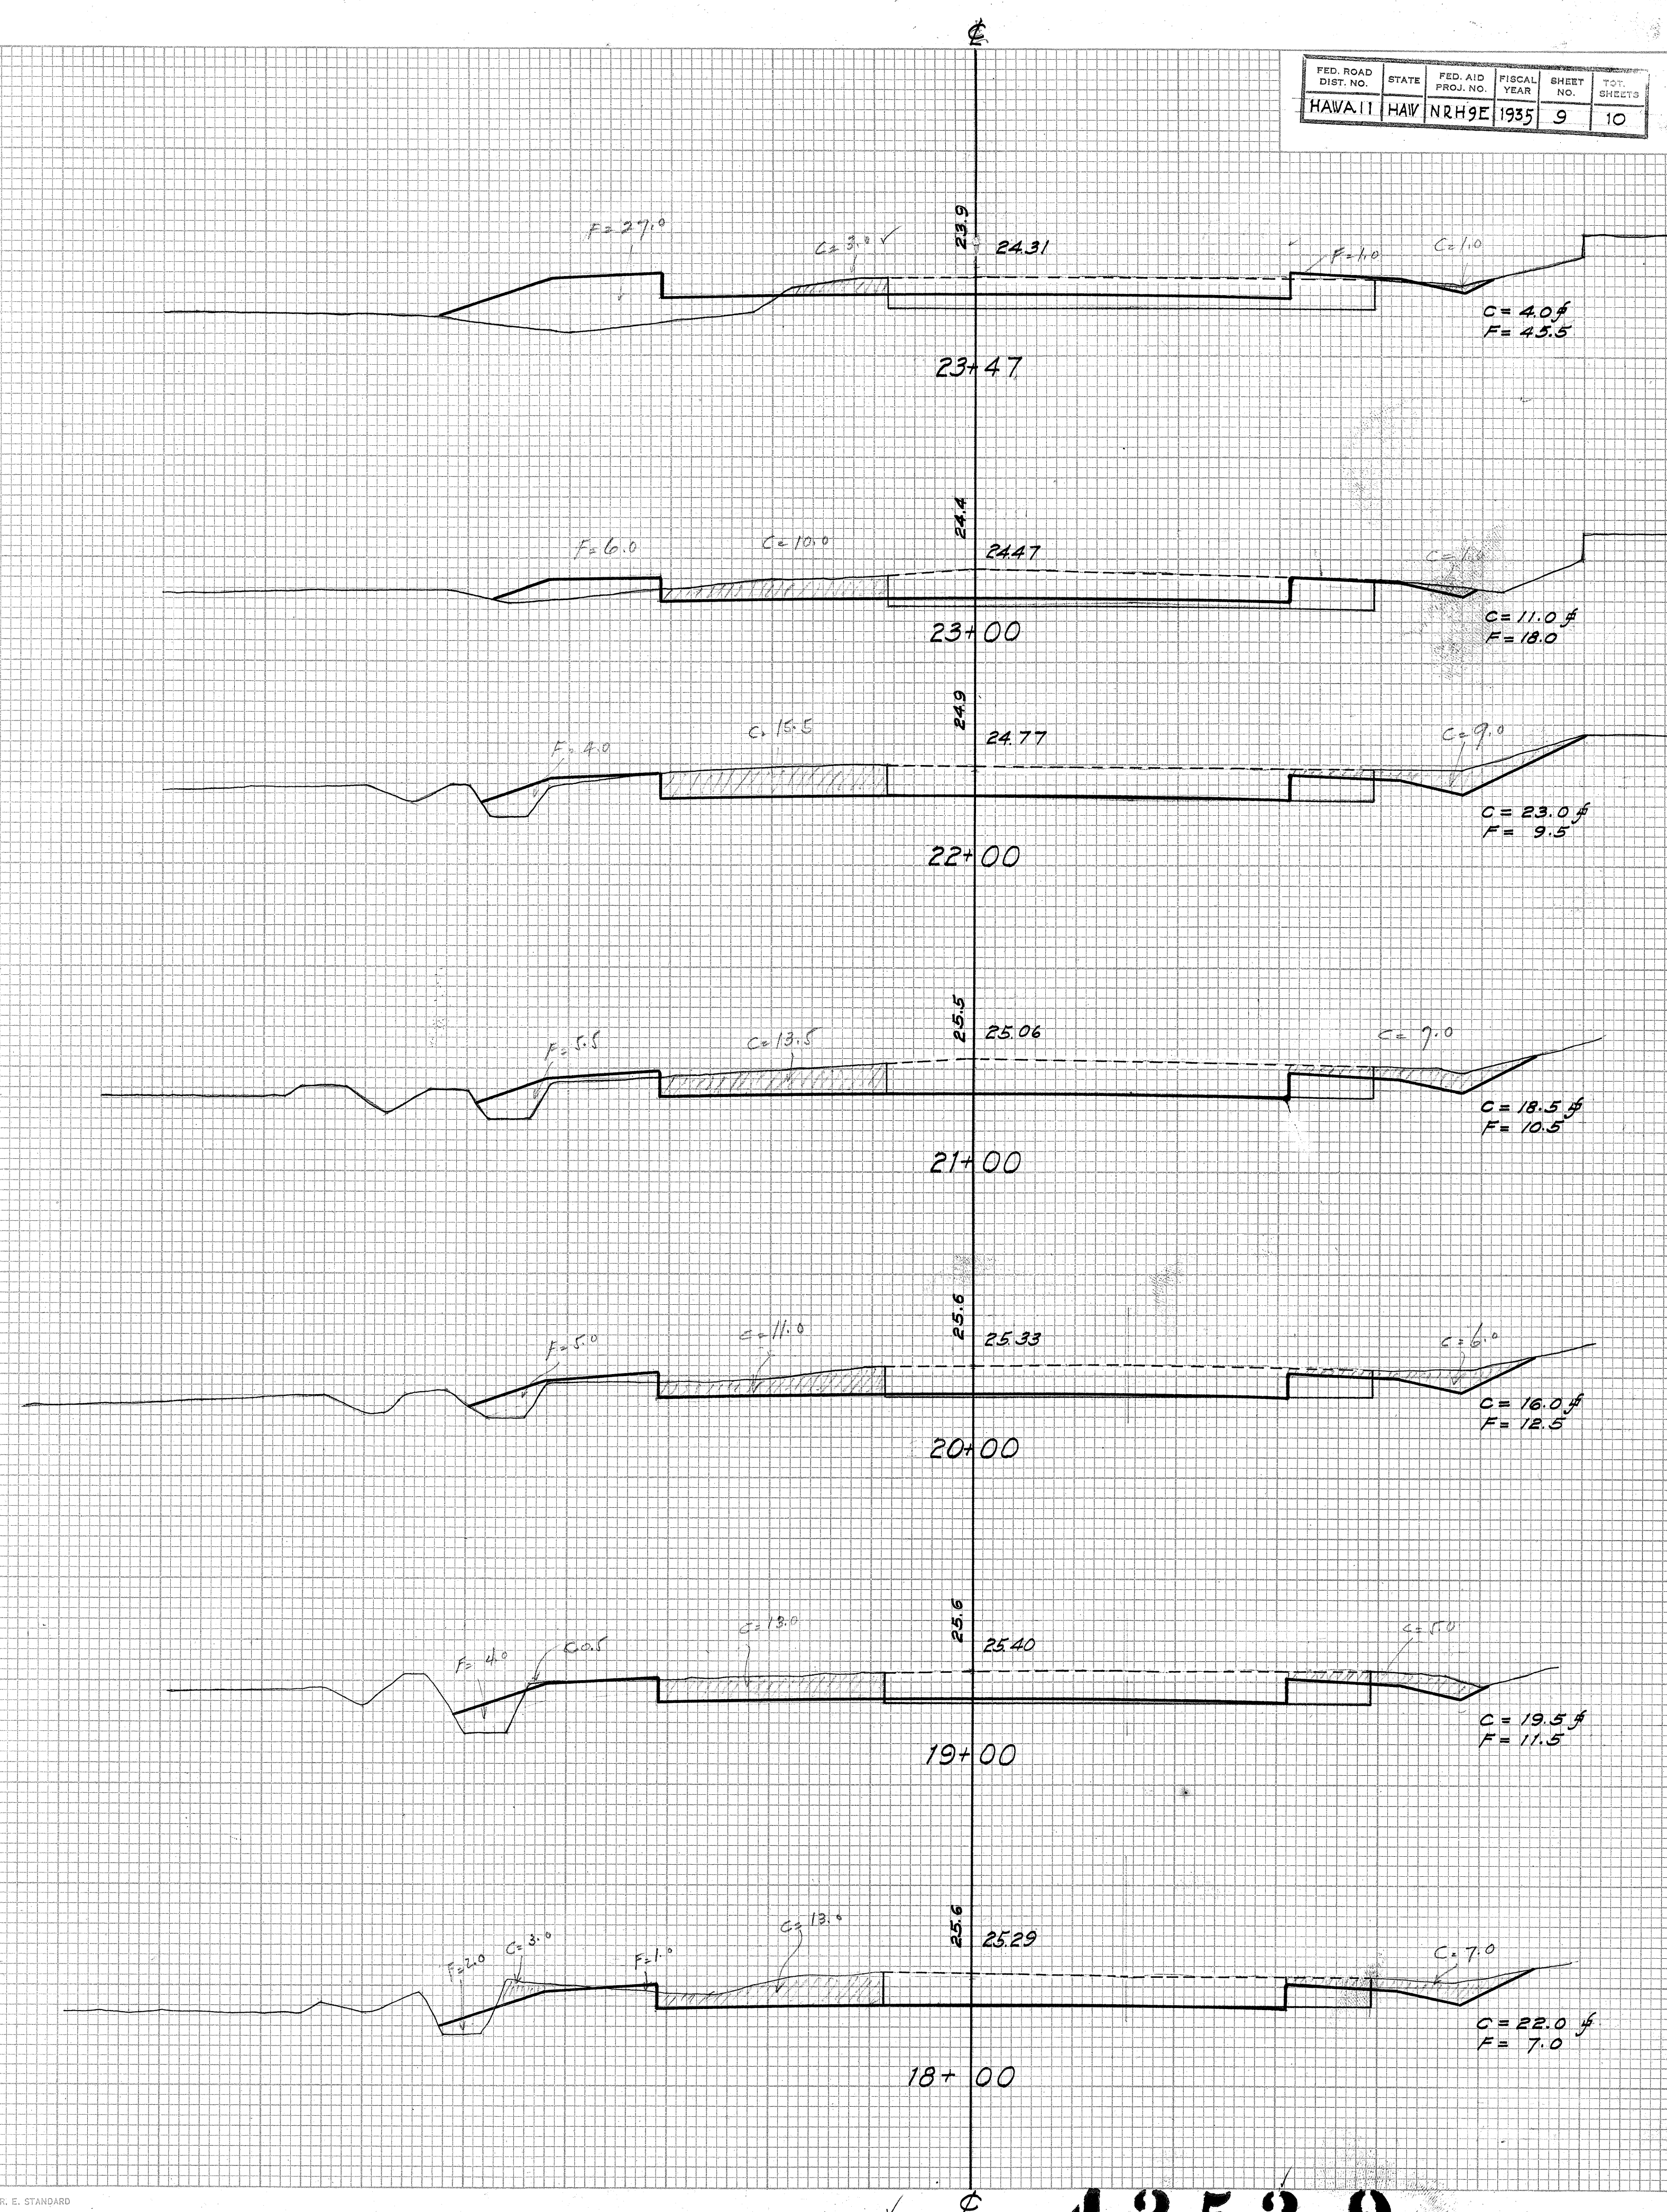
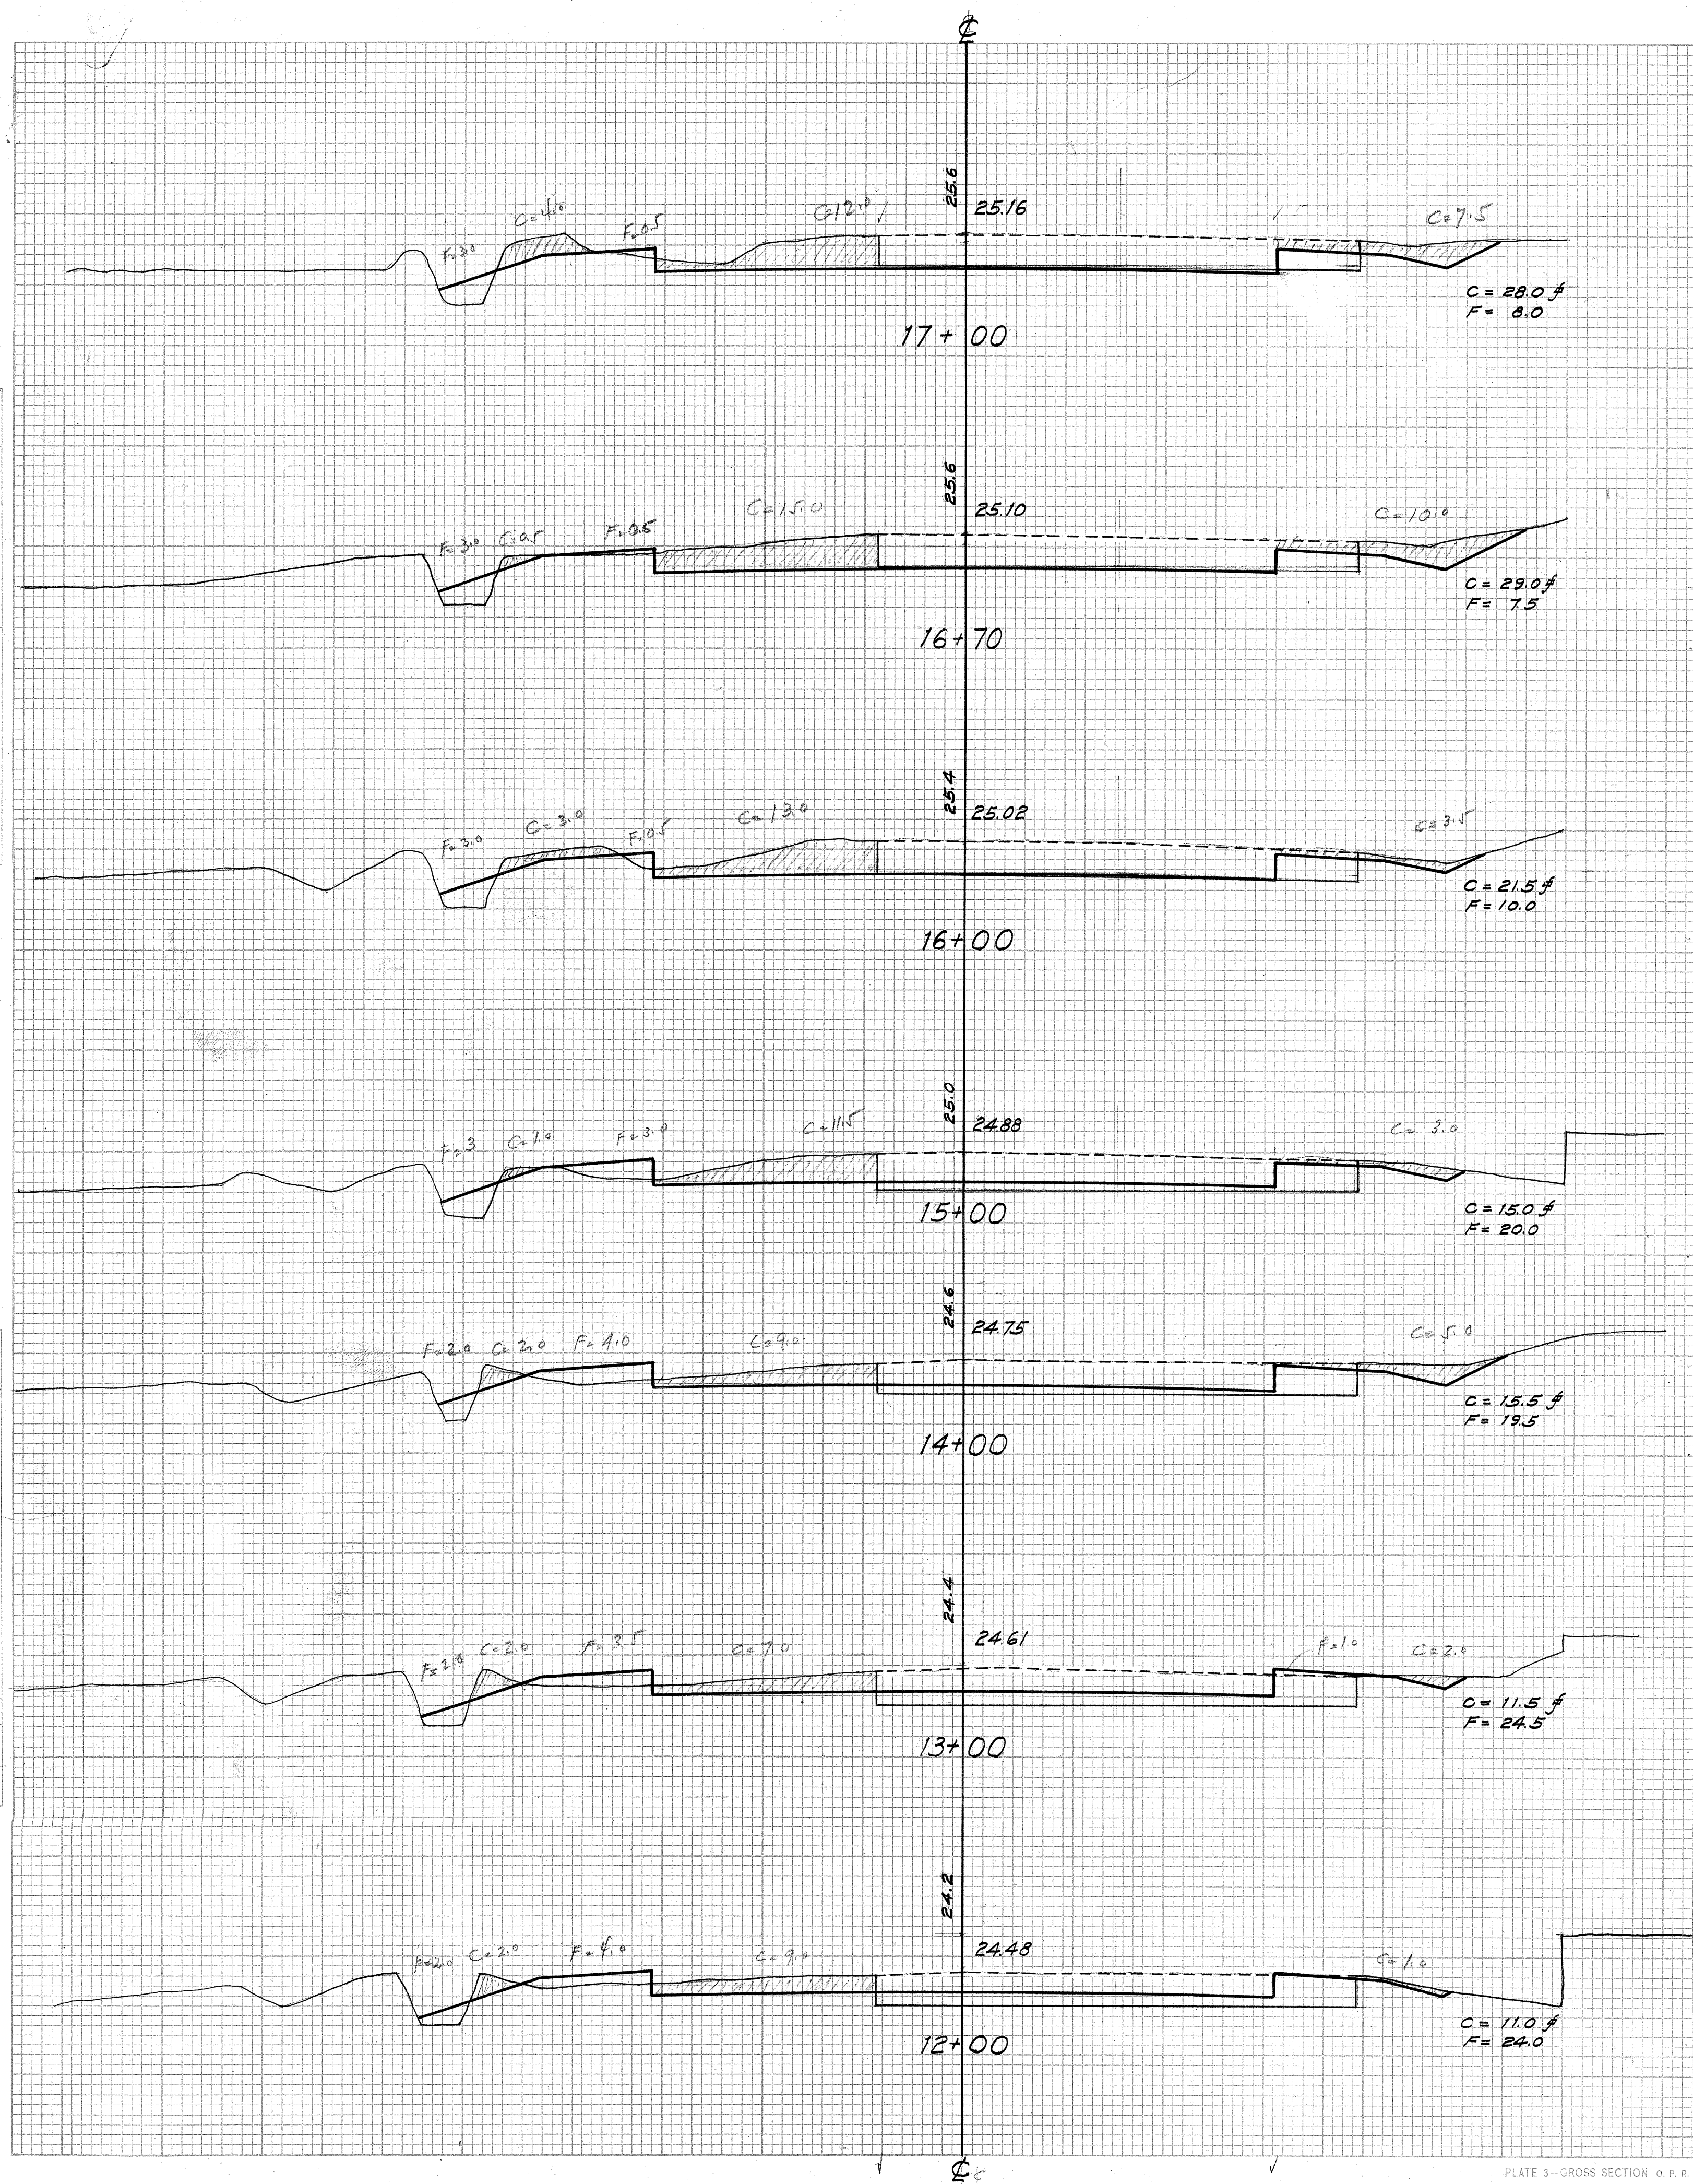
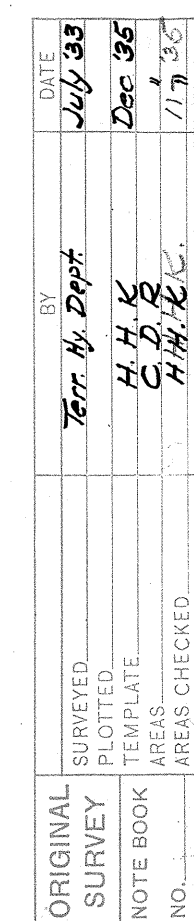
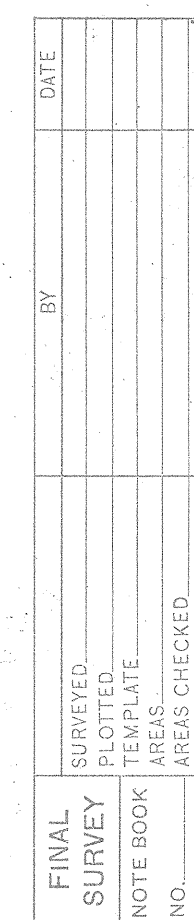


PLATE 3—GROSS SECTION O. P. R. & R. E. STANDARD
KEUFFEL & ESSER CO., NEW YORK.

4353.9

FED. ROAD DIST. NO.	STATE	FED. AID PROJ. NO.	FISCAL YEAR	SHEET NO.	TOTAL SHEETS
HAWAII	HAW	N. 22 H 9 E	1935	10	10

FINAL SURVEY NO.	DATE	BY
1		

ORIGINAL SURVEY NO.	DATE	BY
1	Dec 31 1935	H. H. C.

