



FED. ROAD DIST. NO.	STATE	FED. AID PROJ. NO.	FISCAL YEAR	SHEET NO.	TOTAL SHEETS
HAWAII	HAW	NRH 9E	1935	3	10

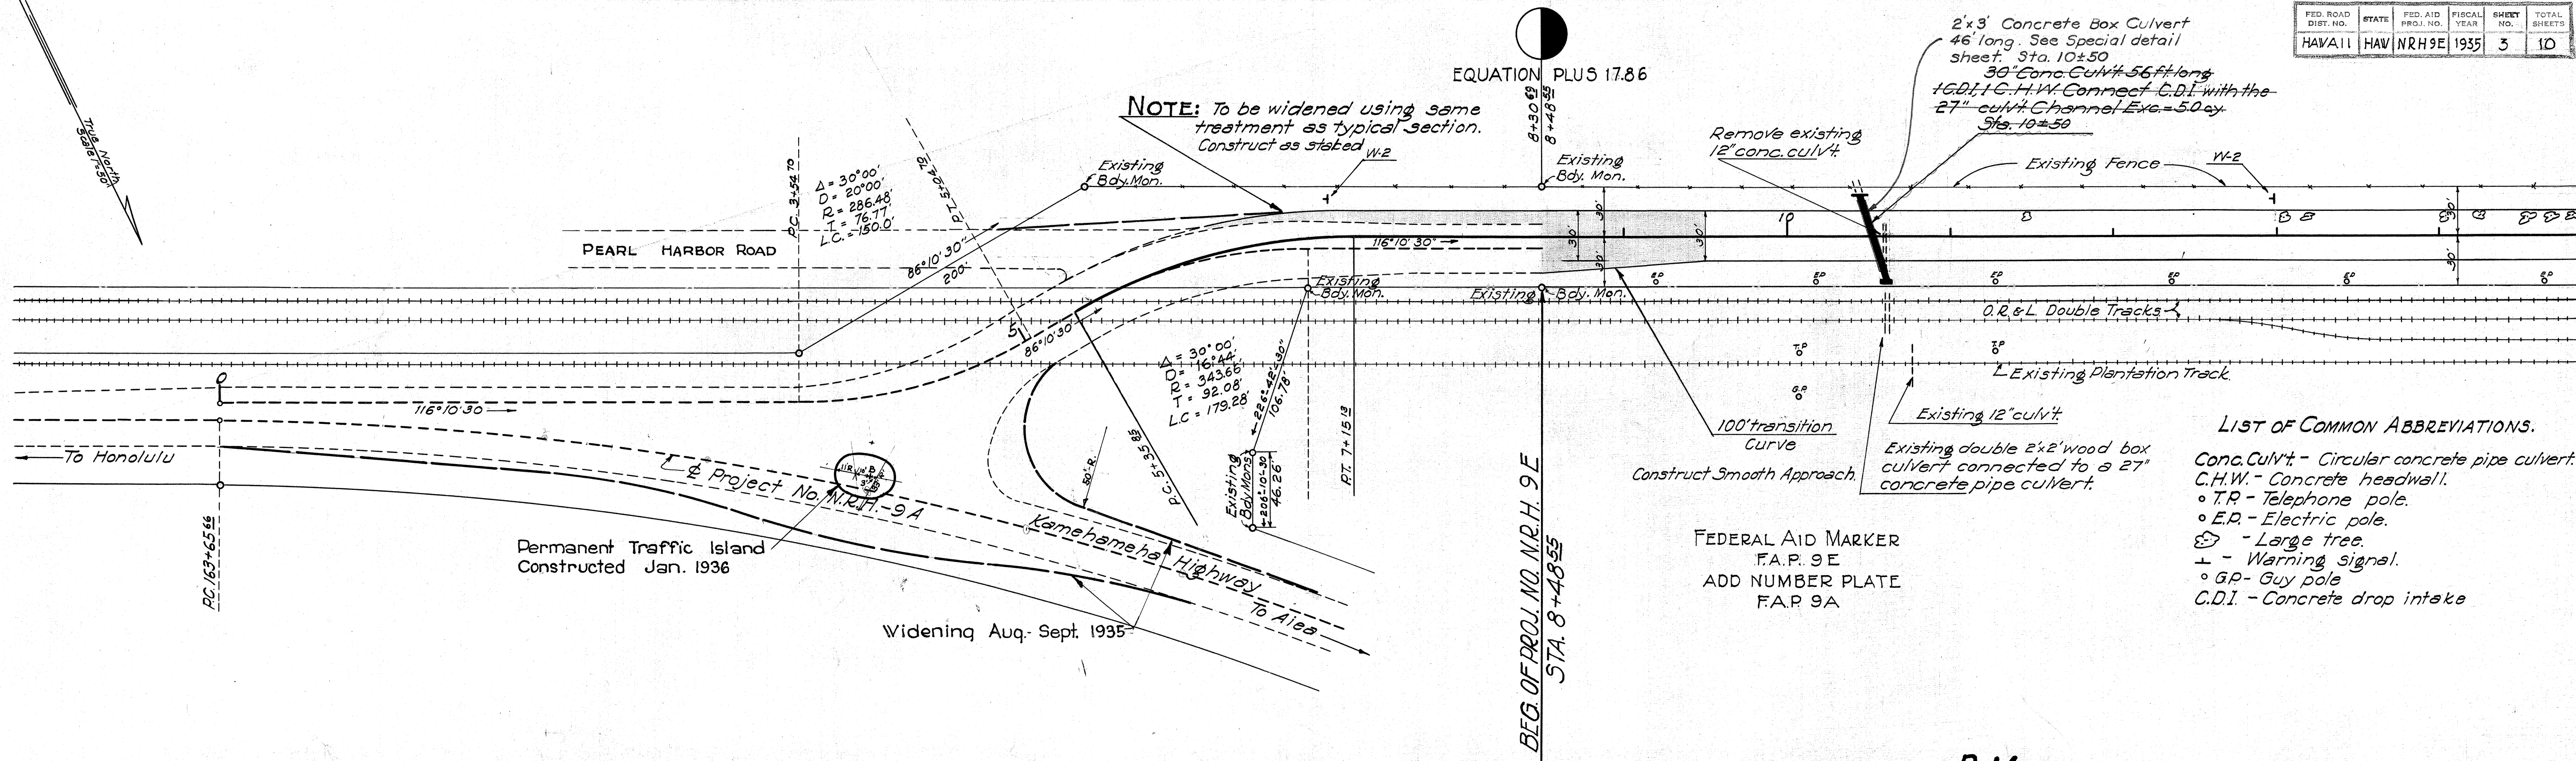

LIST OF COMMON ABBREVIATIONS.


- Conc. Culvert - Circular concrete pipe culvert.
- C.H.W. - Concrete headwall.
- T.P. - Telephone pole.
- E.P. - Electric pole.
- Large tree.
- Warning signal.
- G.P. - Guy pole
- C.D.I. - Concrete drop intake

B.M. Spike in T.P. 70 ft right of Sta. 11+27, marked B.M. @. Elevation = 25.21

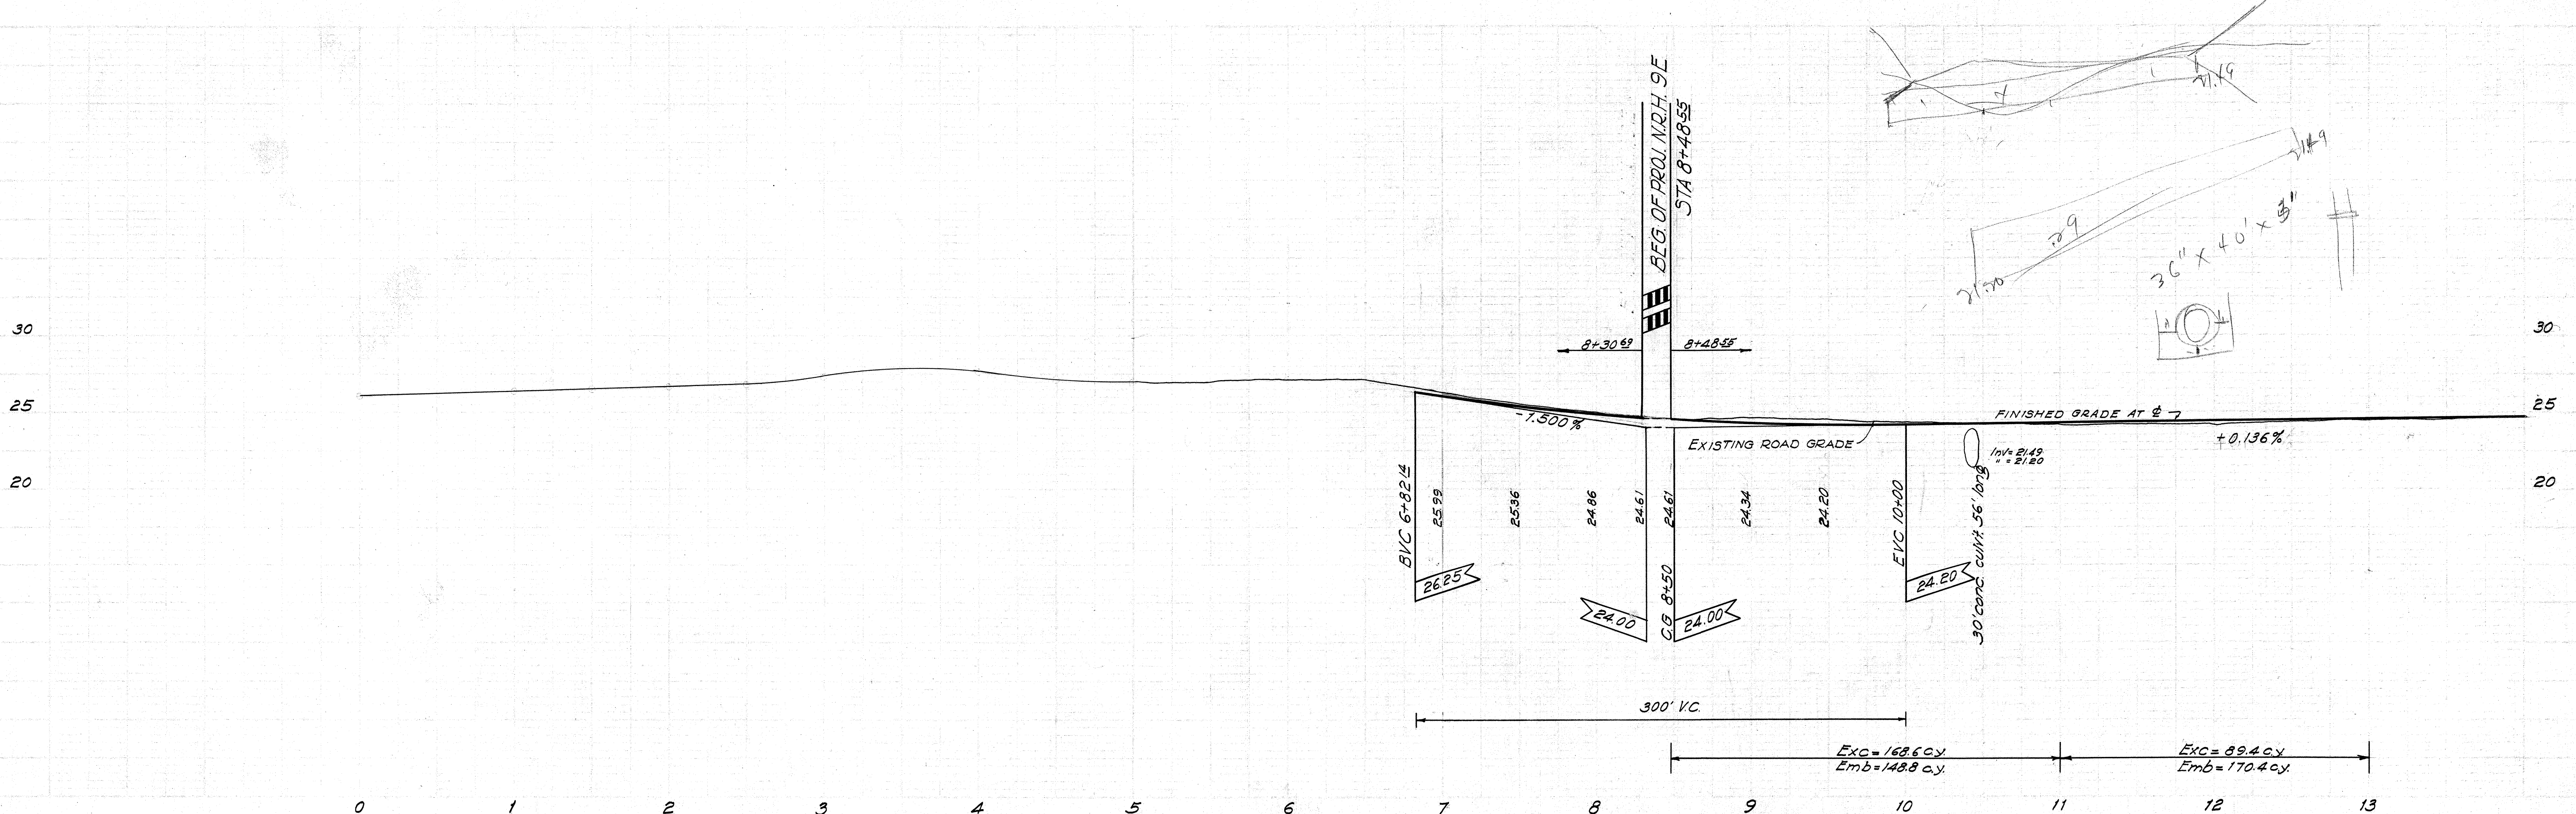


FED. ROAD DIST. NO.	STATE	FED. AID PROJ. NO.	FISCAL YEAR	SHEET NO.	TOTAL SHEETS
HAWAII	HAW	NRH 9A	1935	4	10

PLAN	SECTION
NOTED	NOTED
NOTE BOOK ADDRESS CHECKED	NOTE BOOK ADDRESS CHECKED
NO.	NO.

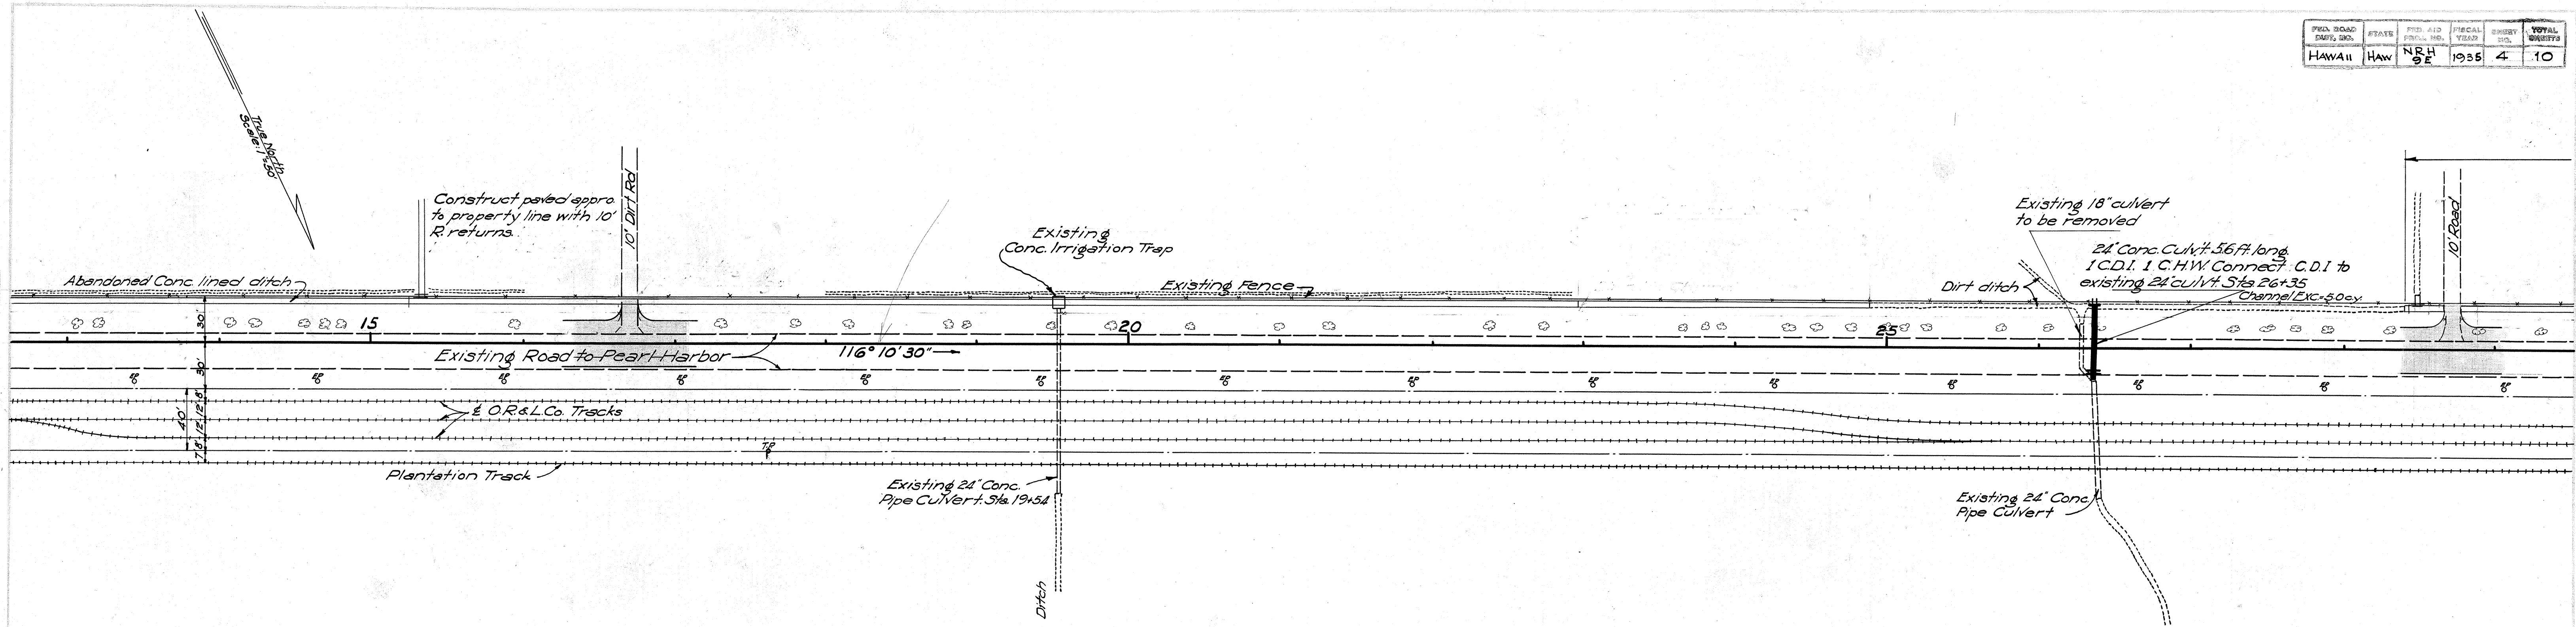

B.M. Spike in T.P. 70 ft
right of Sta. 17+60, marked
B.M. @ Elevation = 26.86

VOID AS TO PROJECT NRH 9A
SEE SHEET 13 THEREOF


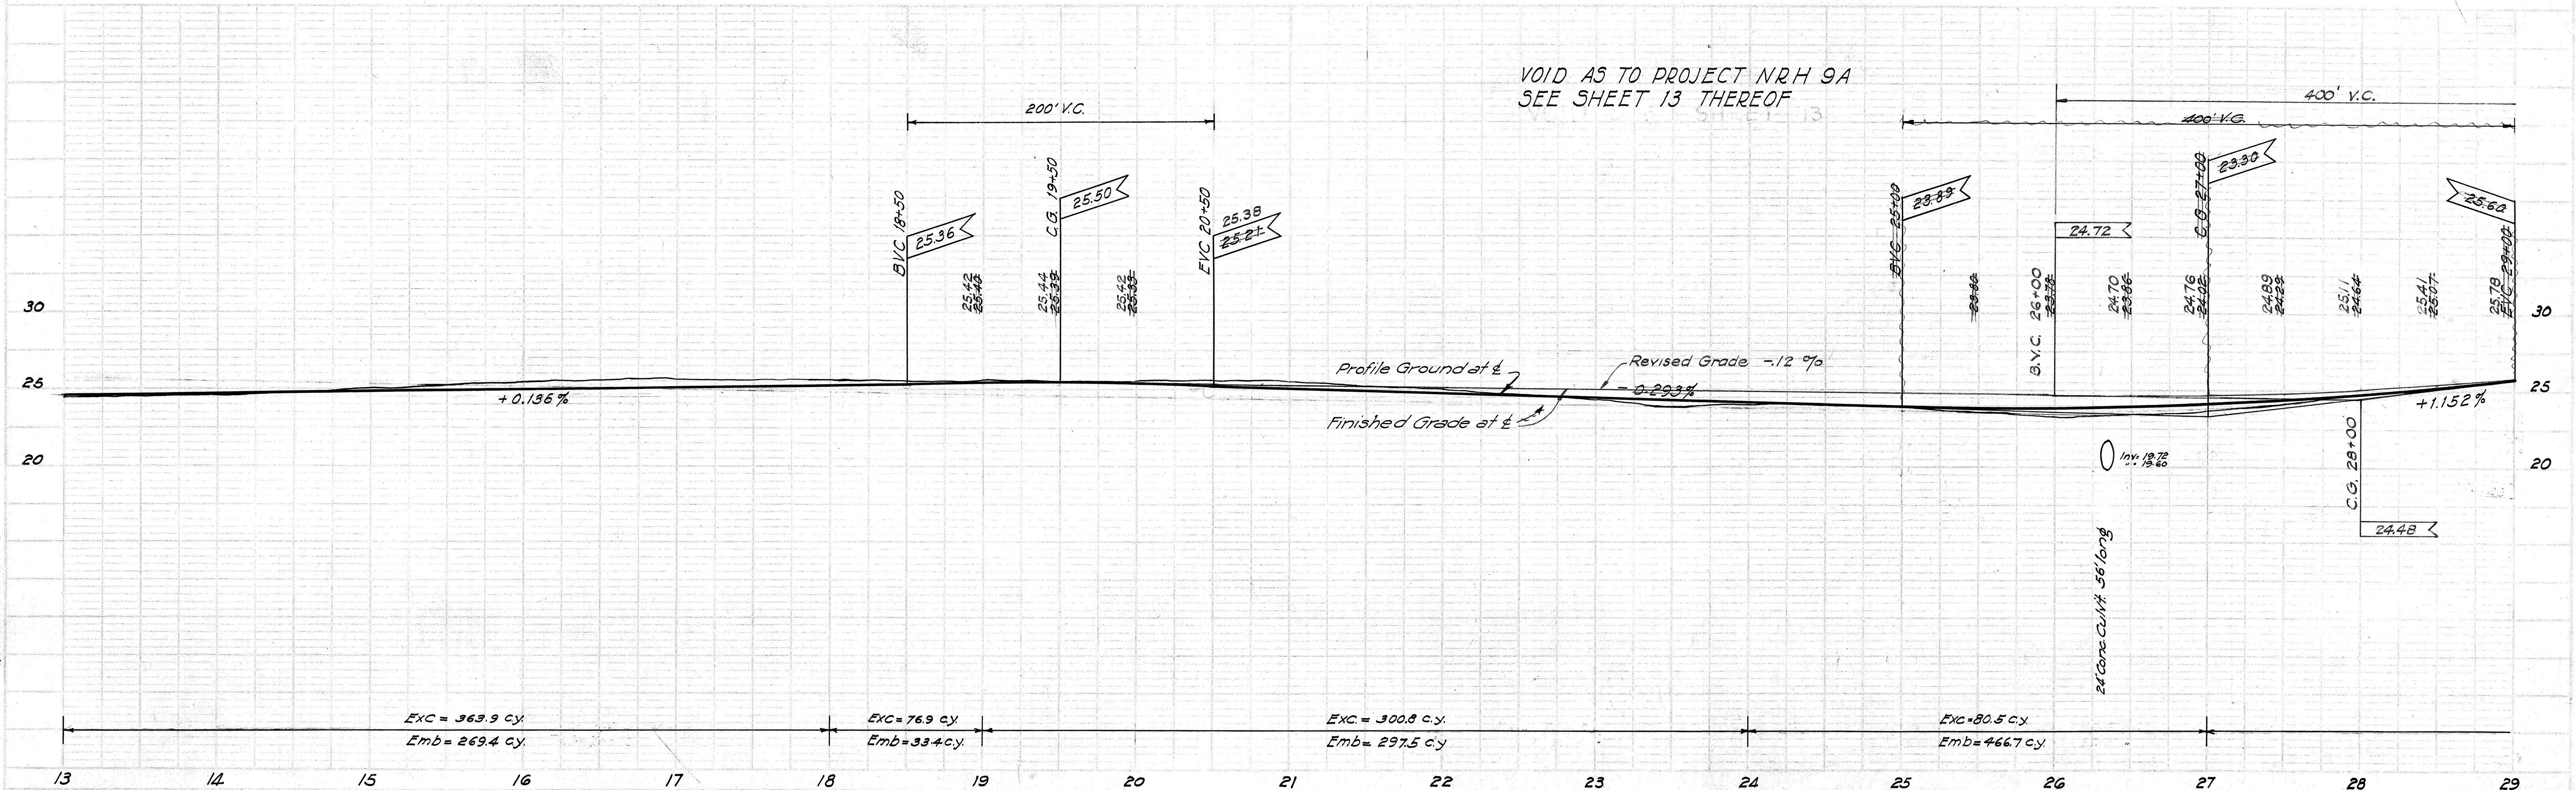


THIS SHEET VOID, AS TO NRH 9A

4353.4


4300.14

FED. ROAD DIST. NO.	STATE	FED. AID FUND NO.	FISCAL YEAR	SHEET NO.	TOTAL SHEETS
HAWAII	HAW	NRH 9E	1935	5	10

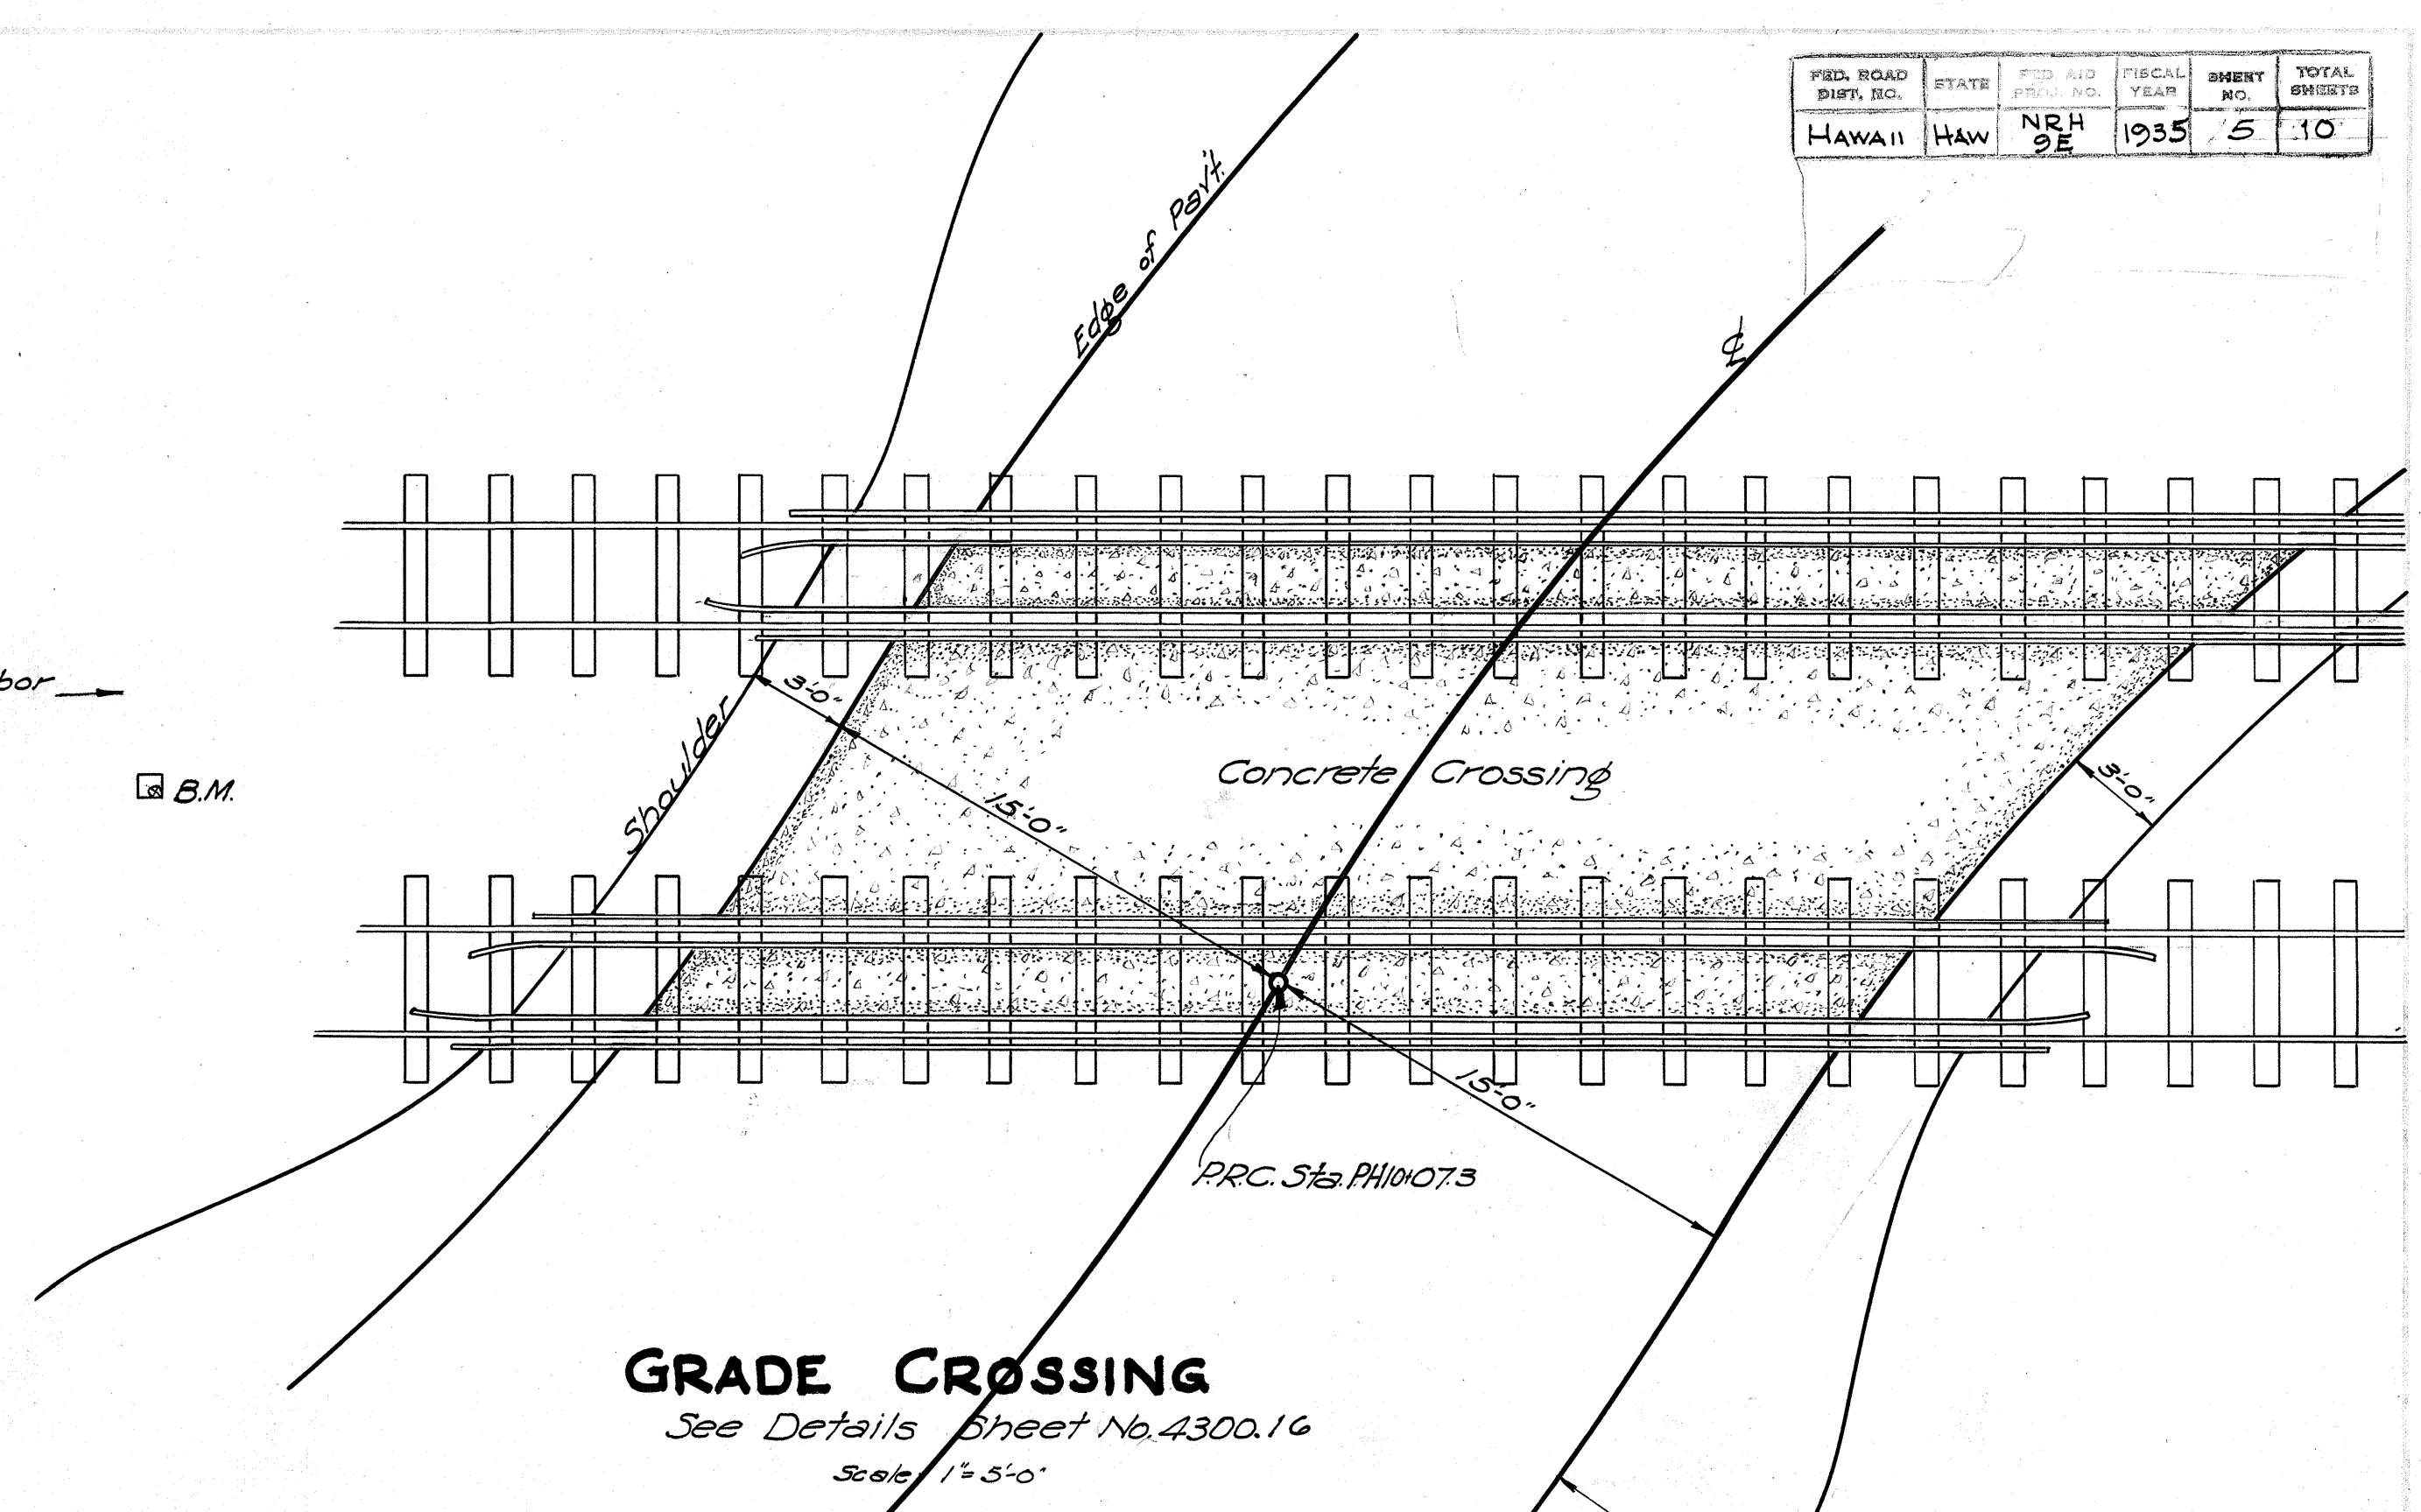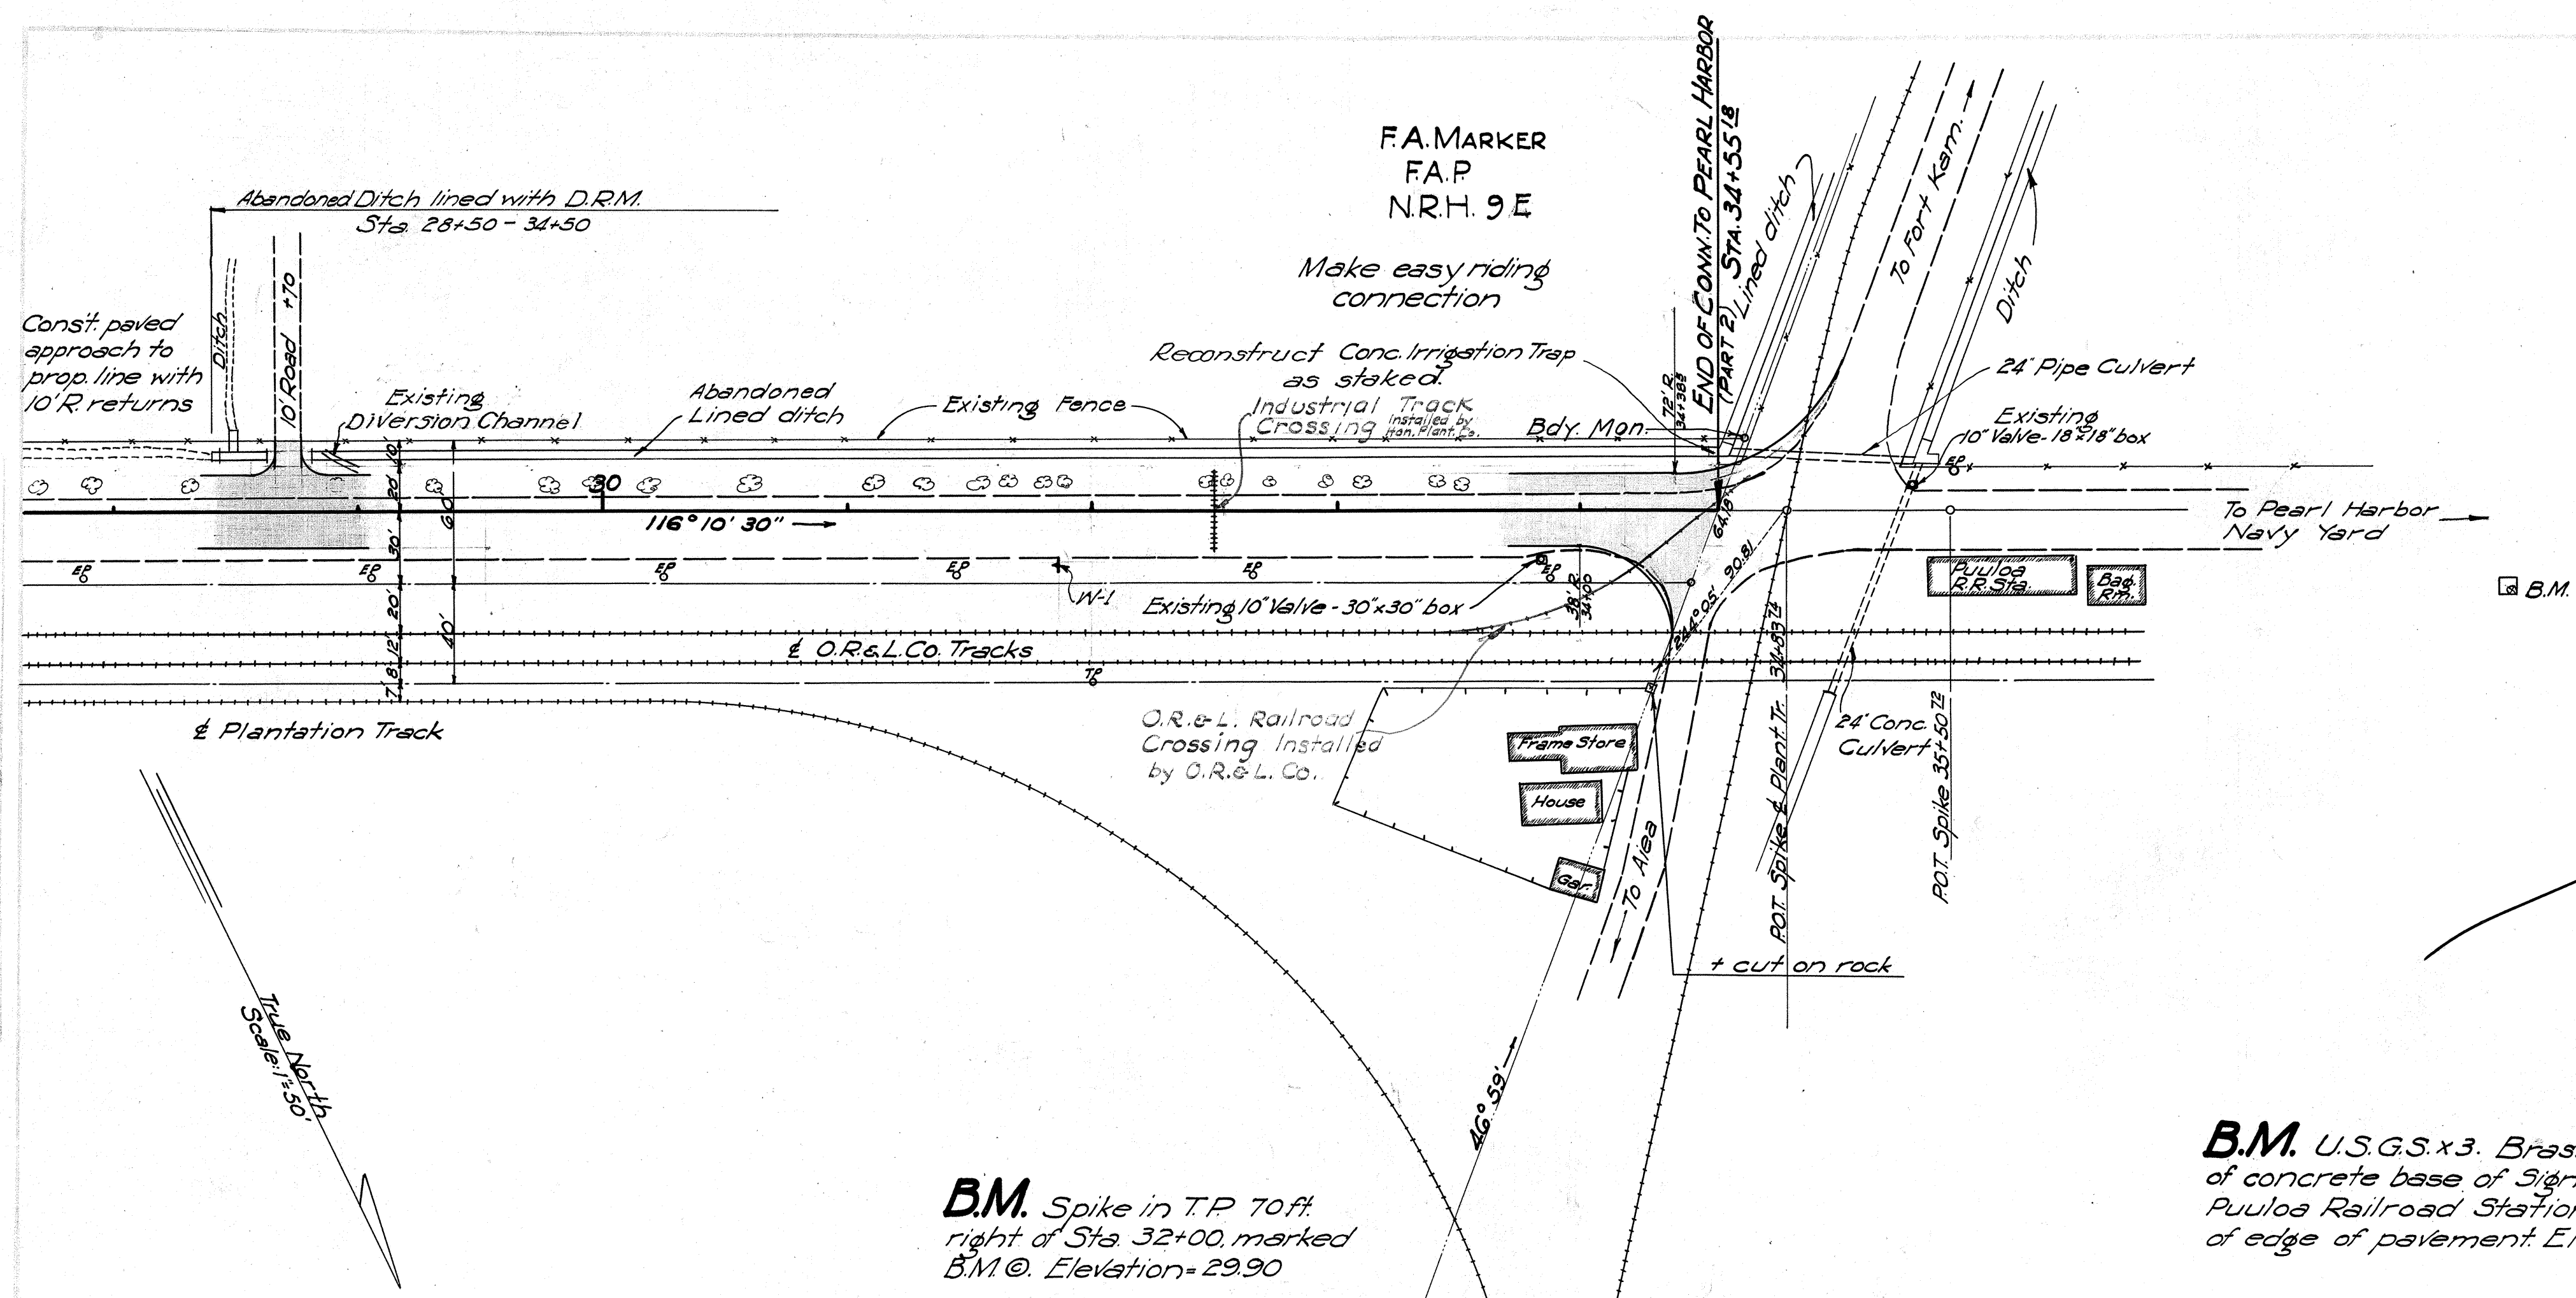

B.M. U.S.G.S. x3. Brass plate in north corner of concrete base of Signal Post 175 feet Ewa of Puuloa Railroad Station and 15 feet mauka of edge of pavement Elevation = 31.65.

NOTE: THIS CROSSING APPLIES TO PROJECT N.R.H. 9A AND DOES NOT APPLY TO PROJECT N.R.H. 9E

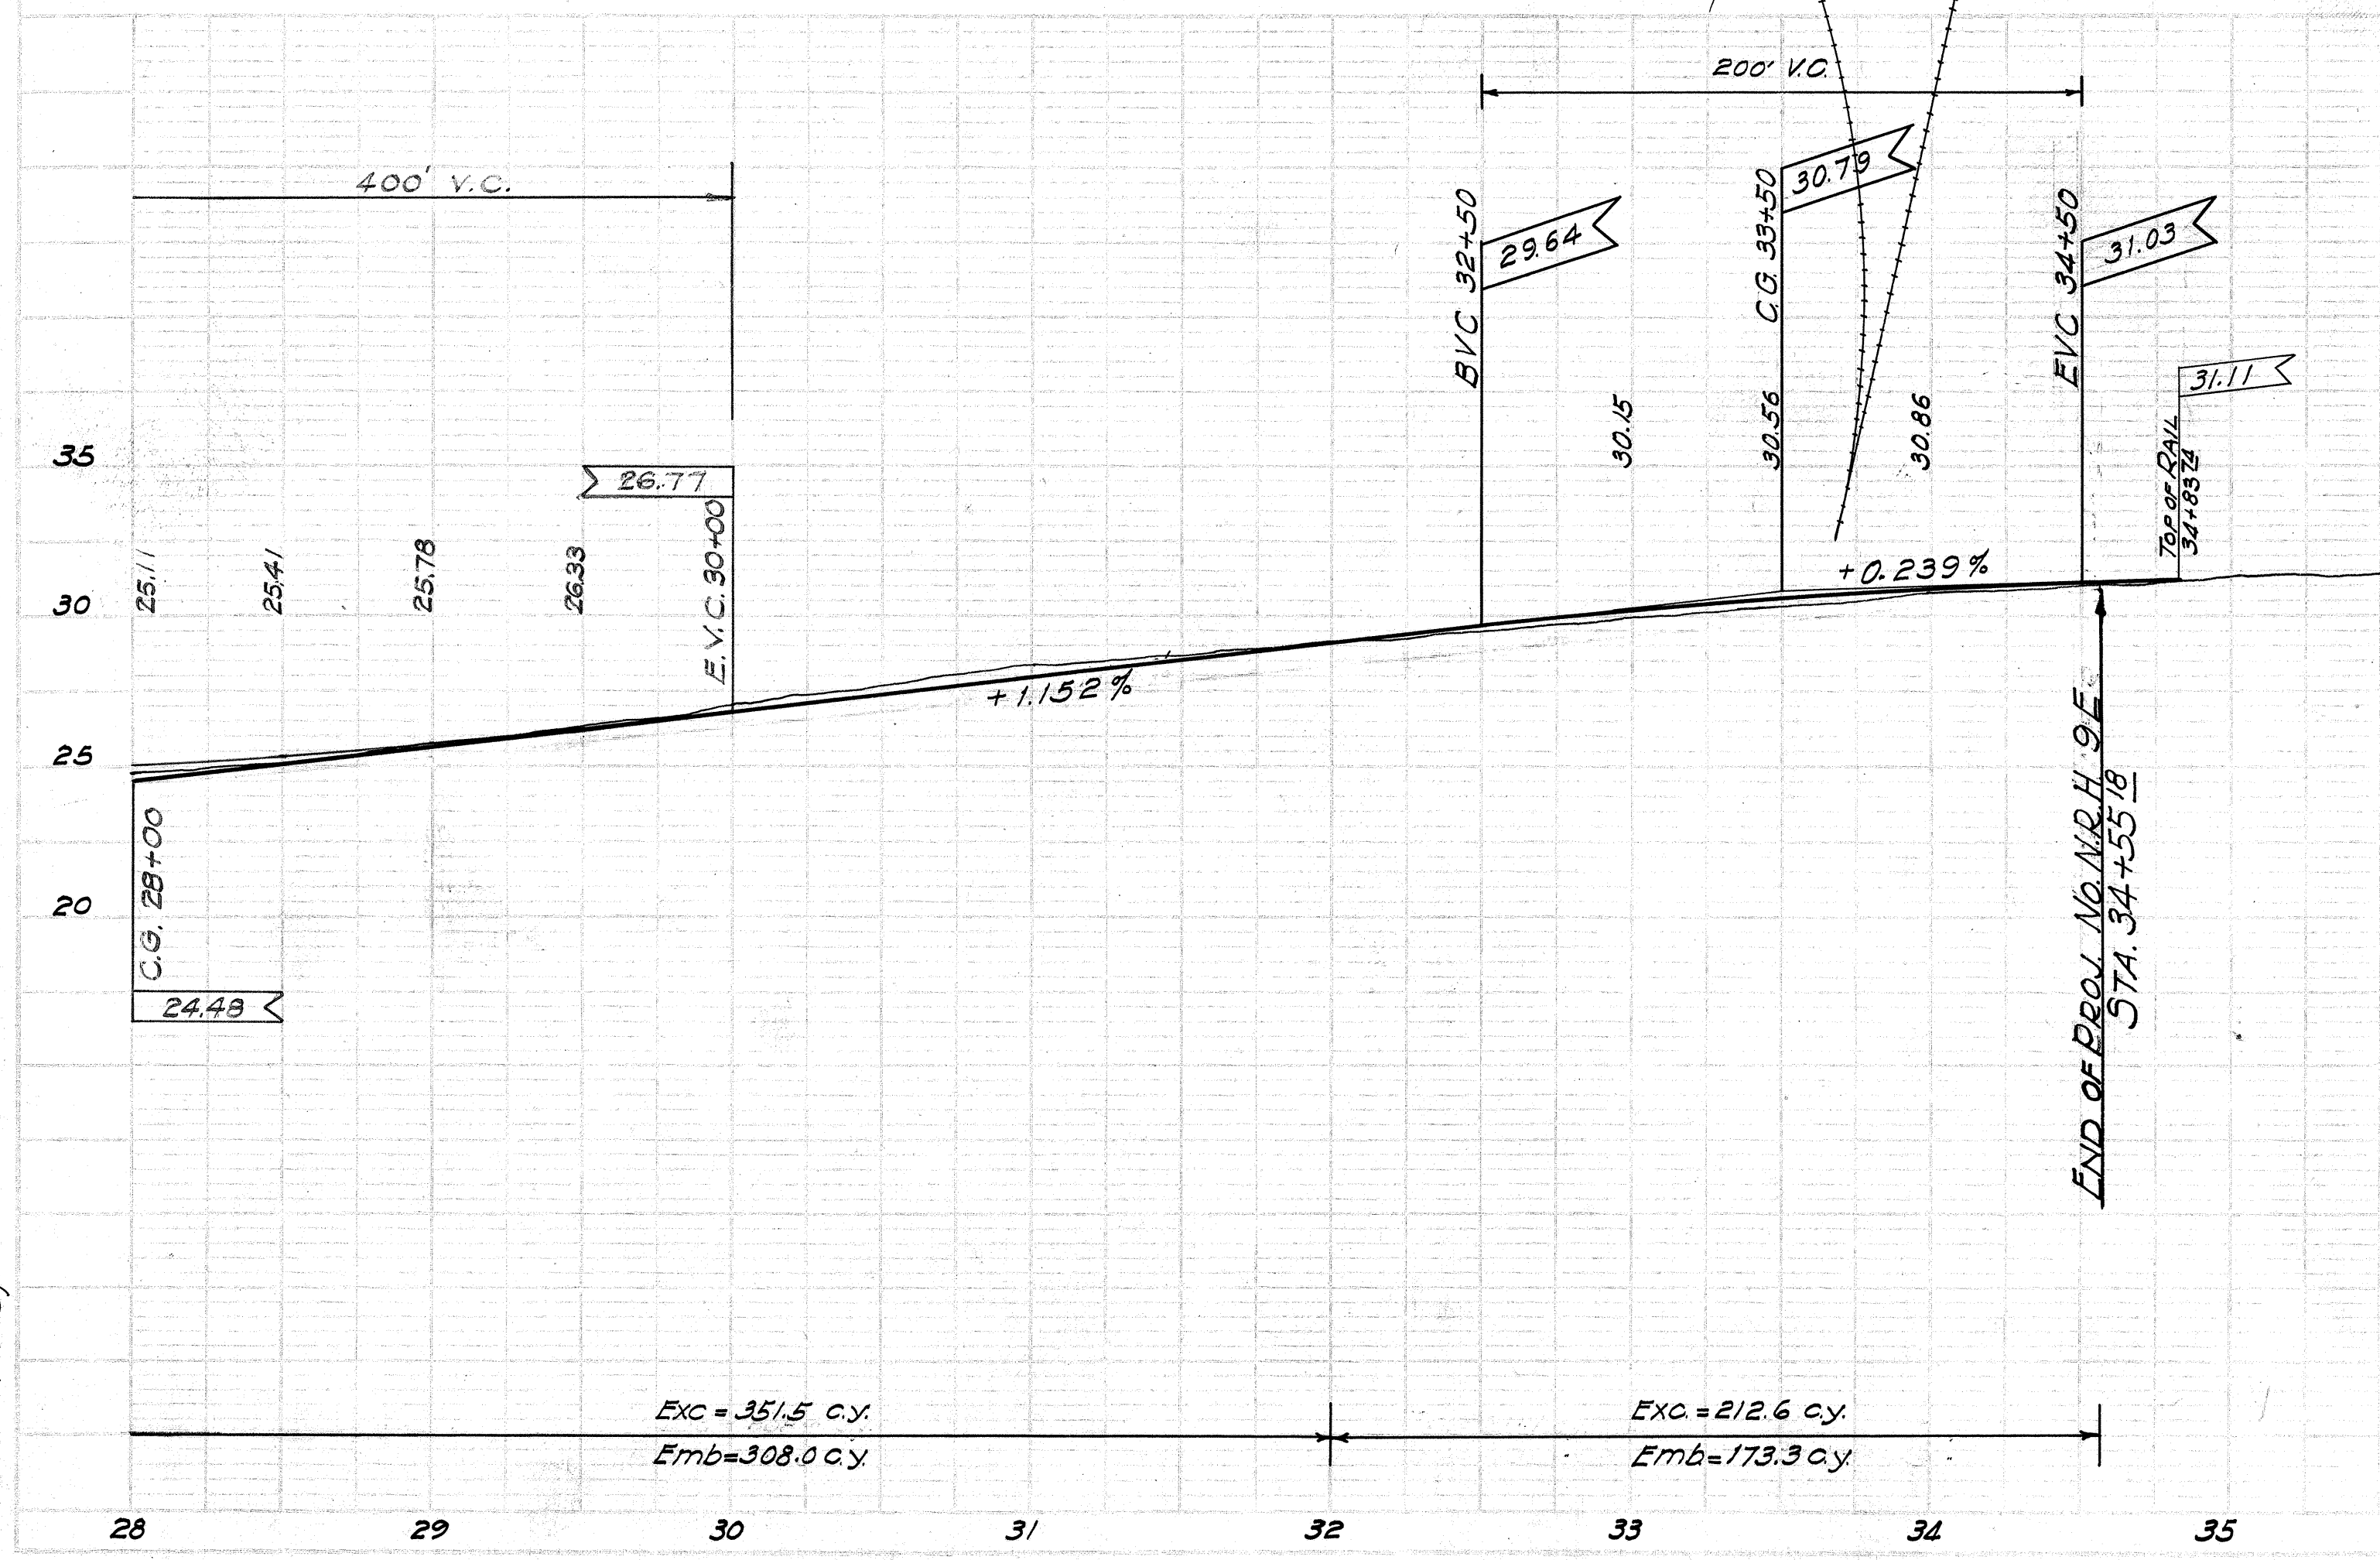

VOID AS TO PROJECT N.R.H. 9A
SEE SHEET NO 15 THEREOF

Deleted E.W.O. 9. A.C.W. 3-9-35

4353.5

4300.15