


FED. ROAD DIST. NO.	STATE	FED. AID PROJ. NO.	FISCAL YEAR	SHEET NO.	TOTAL SHEETS
HAWAII	HAW	VPMH 90	1935	6	12

FINAL SURVEY	BY	DATE
NO. 354	ENC.	10-35
NOTE BOOK	"	"
AREAS CHECKED	H.H.K.	"


ORIGINAL SURVEY	BY	DATE
NO. 354	ENC.	10-35
NOTE BOOK	"	"
AREAS CHECKED	H.H.K.	"

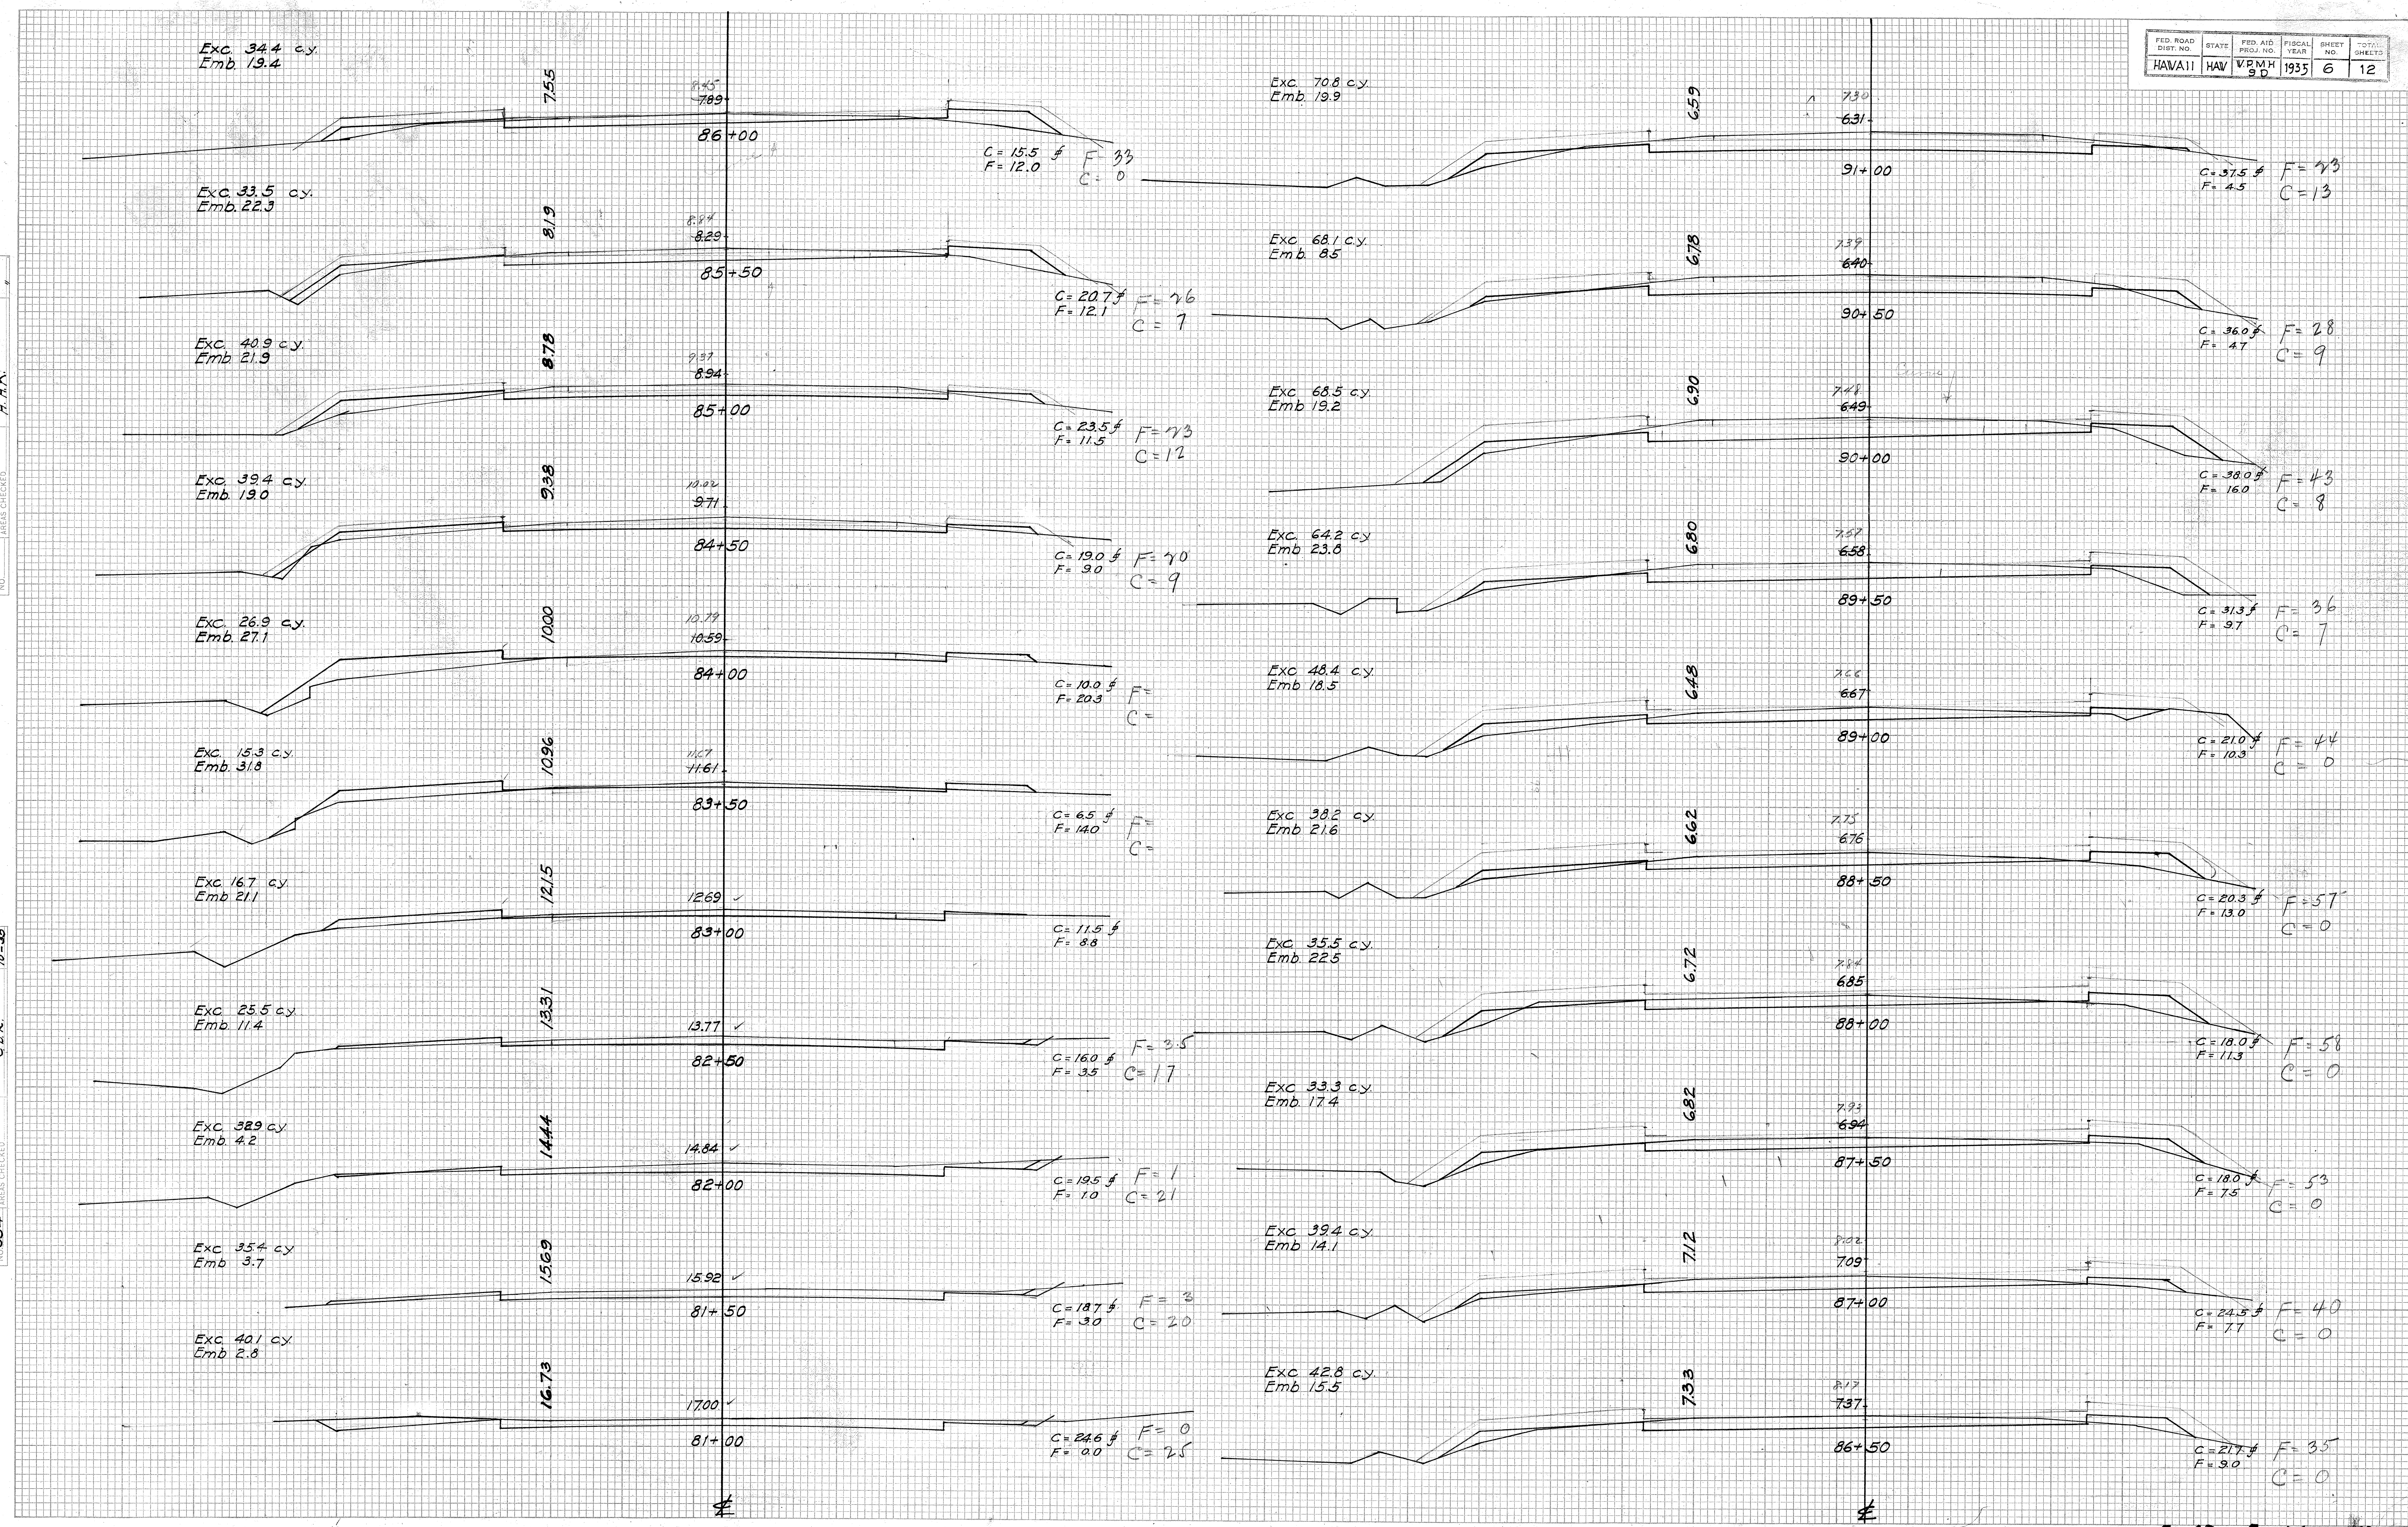

DATE 10-35
BY E.M.C.
SURVEYED
PLOTTER
NOTE BOOK
AREAS CHECKED
H.M.K.

DATE 10-35
BY E.M.C.
SURVEYED
PLOTTER
NOTE BOOK
AREAS CHECKED
H.M.K.



FED. ROAD DIST. NO.	STATE	FED. AID PROJ. NO.	FISCAL YEAR	SHEET NO.	TOTAL SHEETS
HAWAII	HAW	100-100	1935	7	12

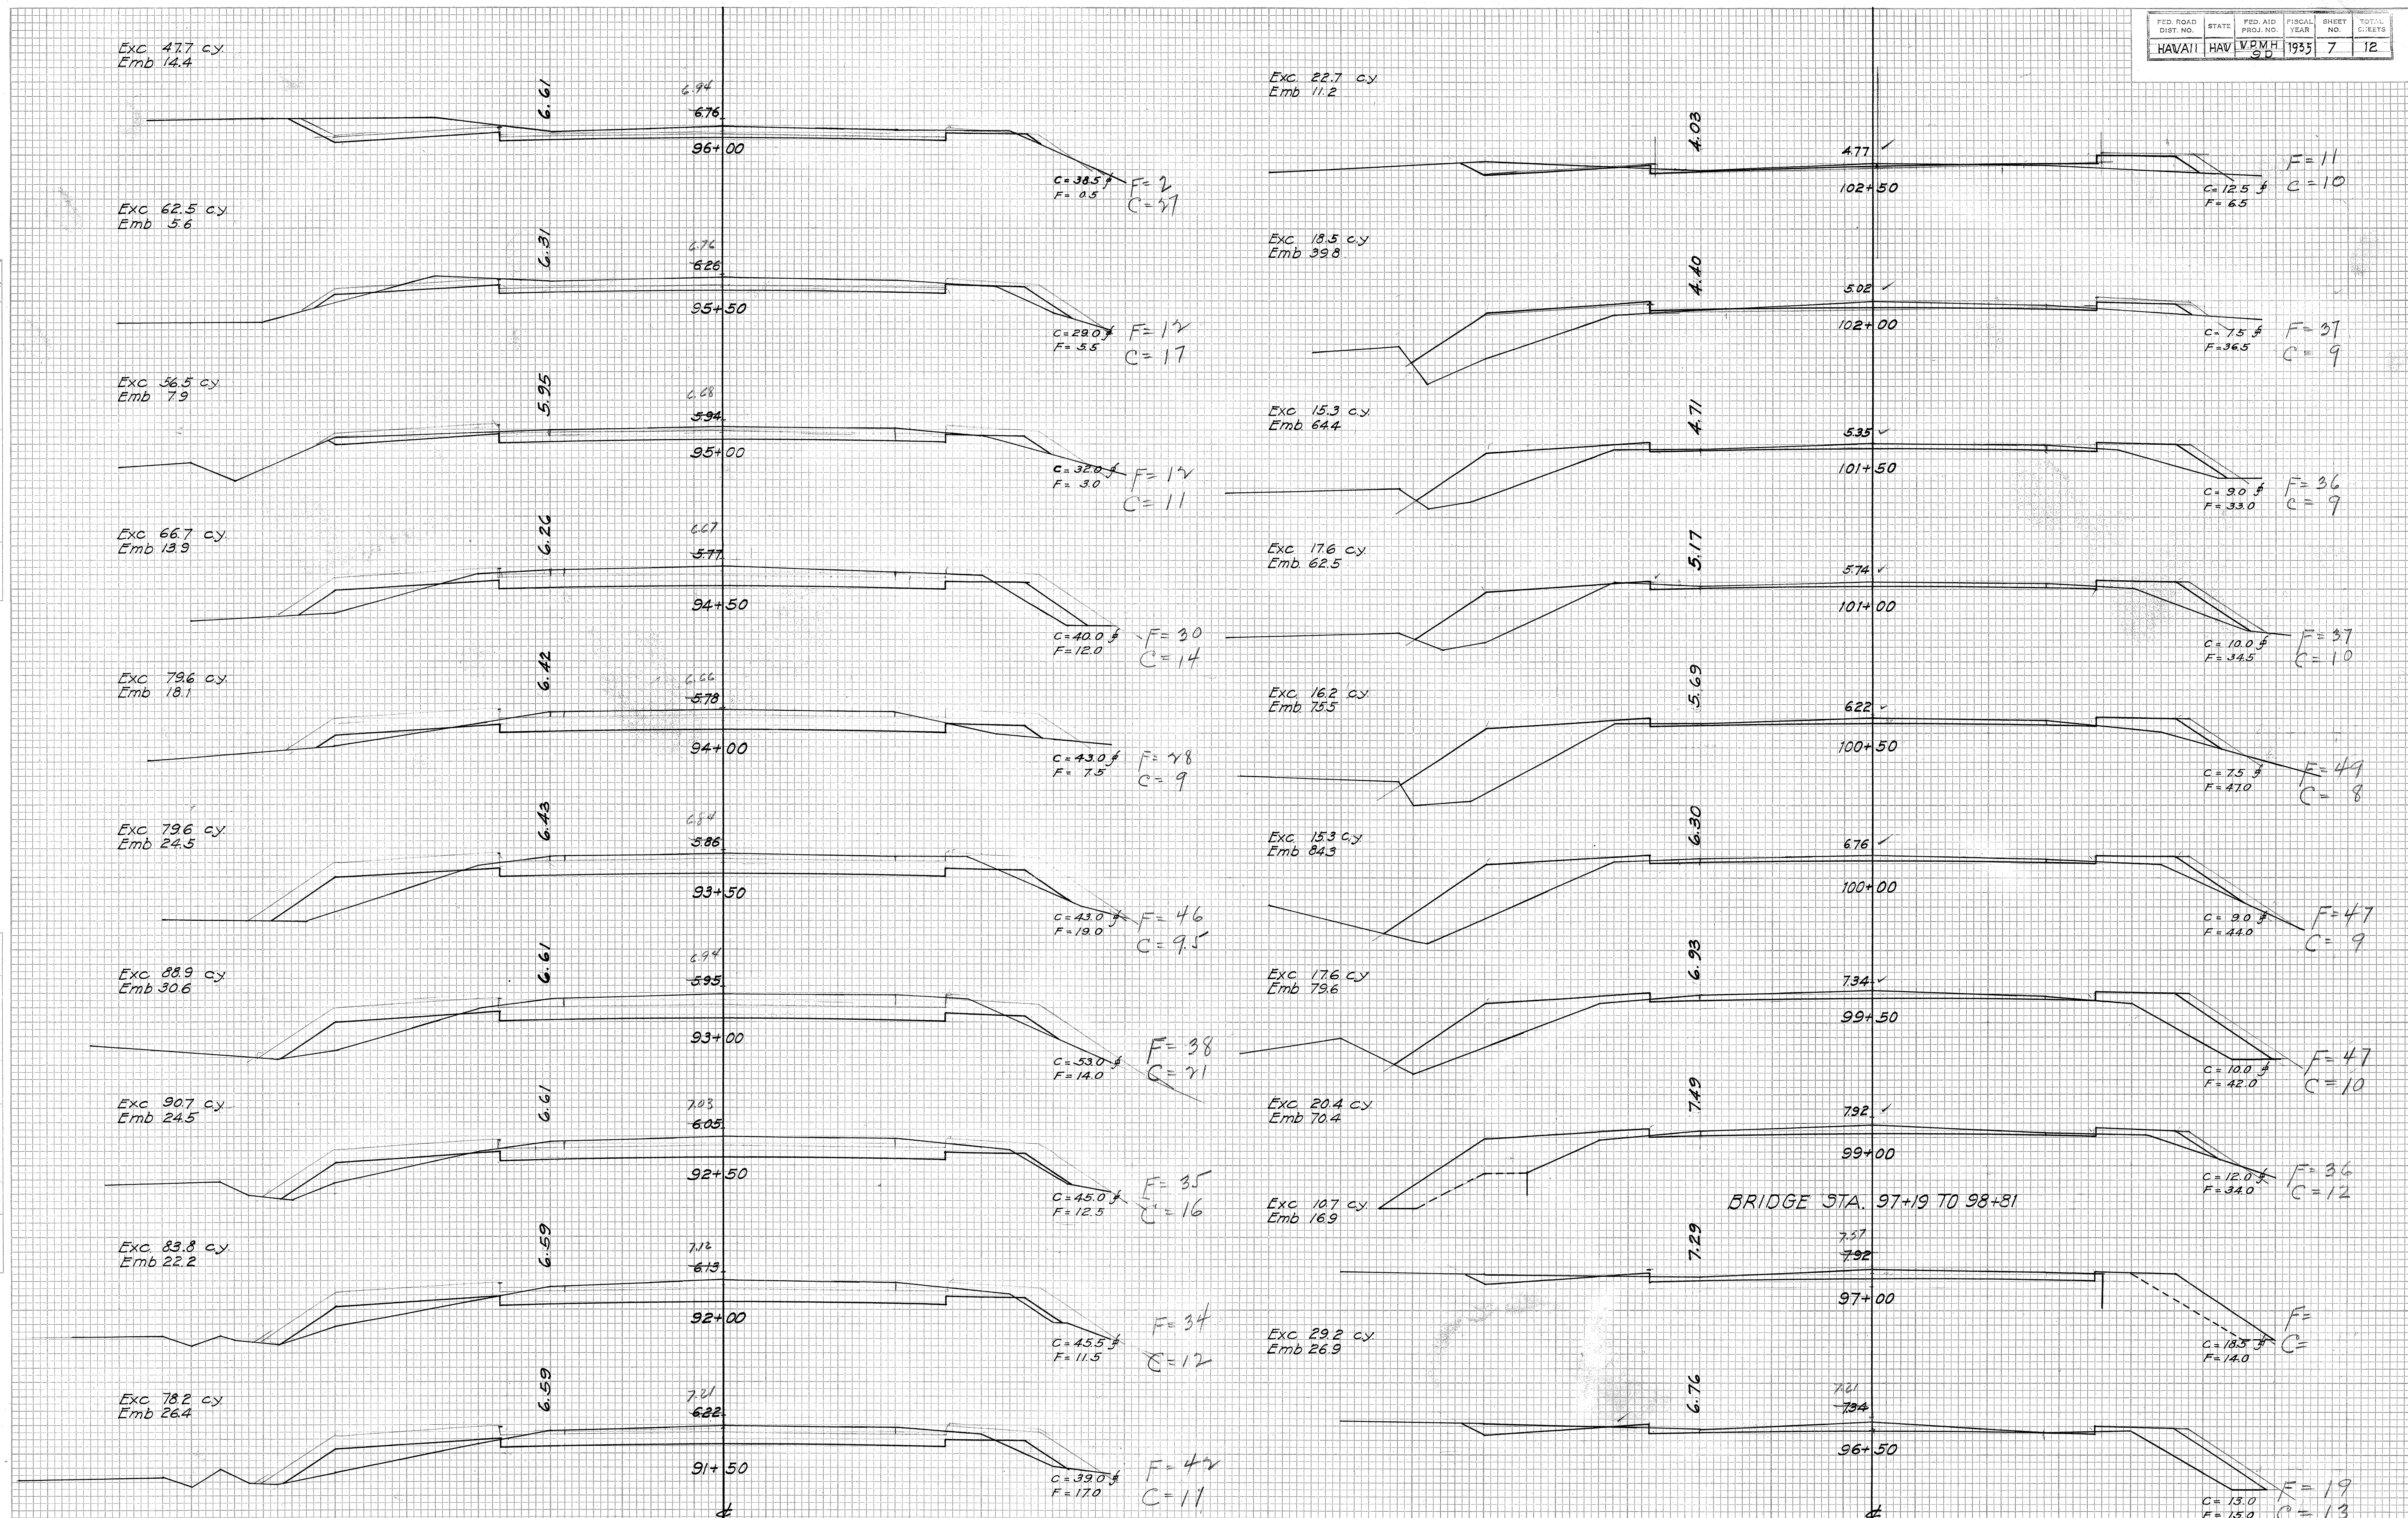

DATE 10-35
BY E.M.C.
SURVEYED PLOTTED
NOTE BOOK AREAS
NO. H.H.K.



DATE 10-35
BY C.M.C.
SURVEYED PLOTTED
NOTE BOOK AREAS
NO. 354

FED. ROAD DIST. NO.	STATE	FED. AID PROJ. NO.	FISCAL YEAR	SHEET NO.	TOTAL SHEETS
HAWAII	HAW	W.R.M.H. 30	1935	8	12

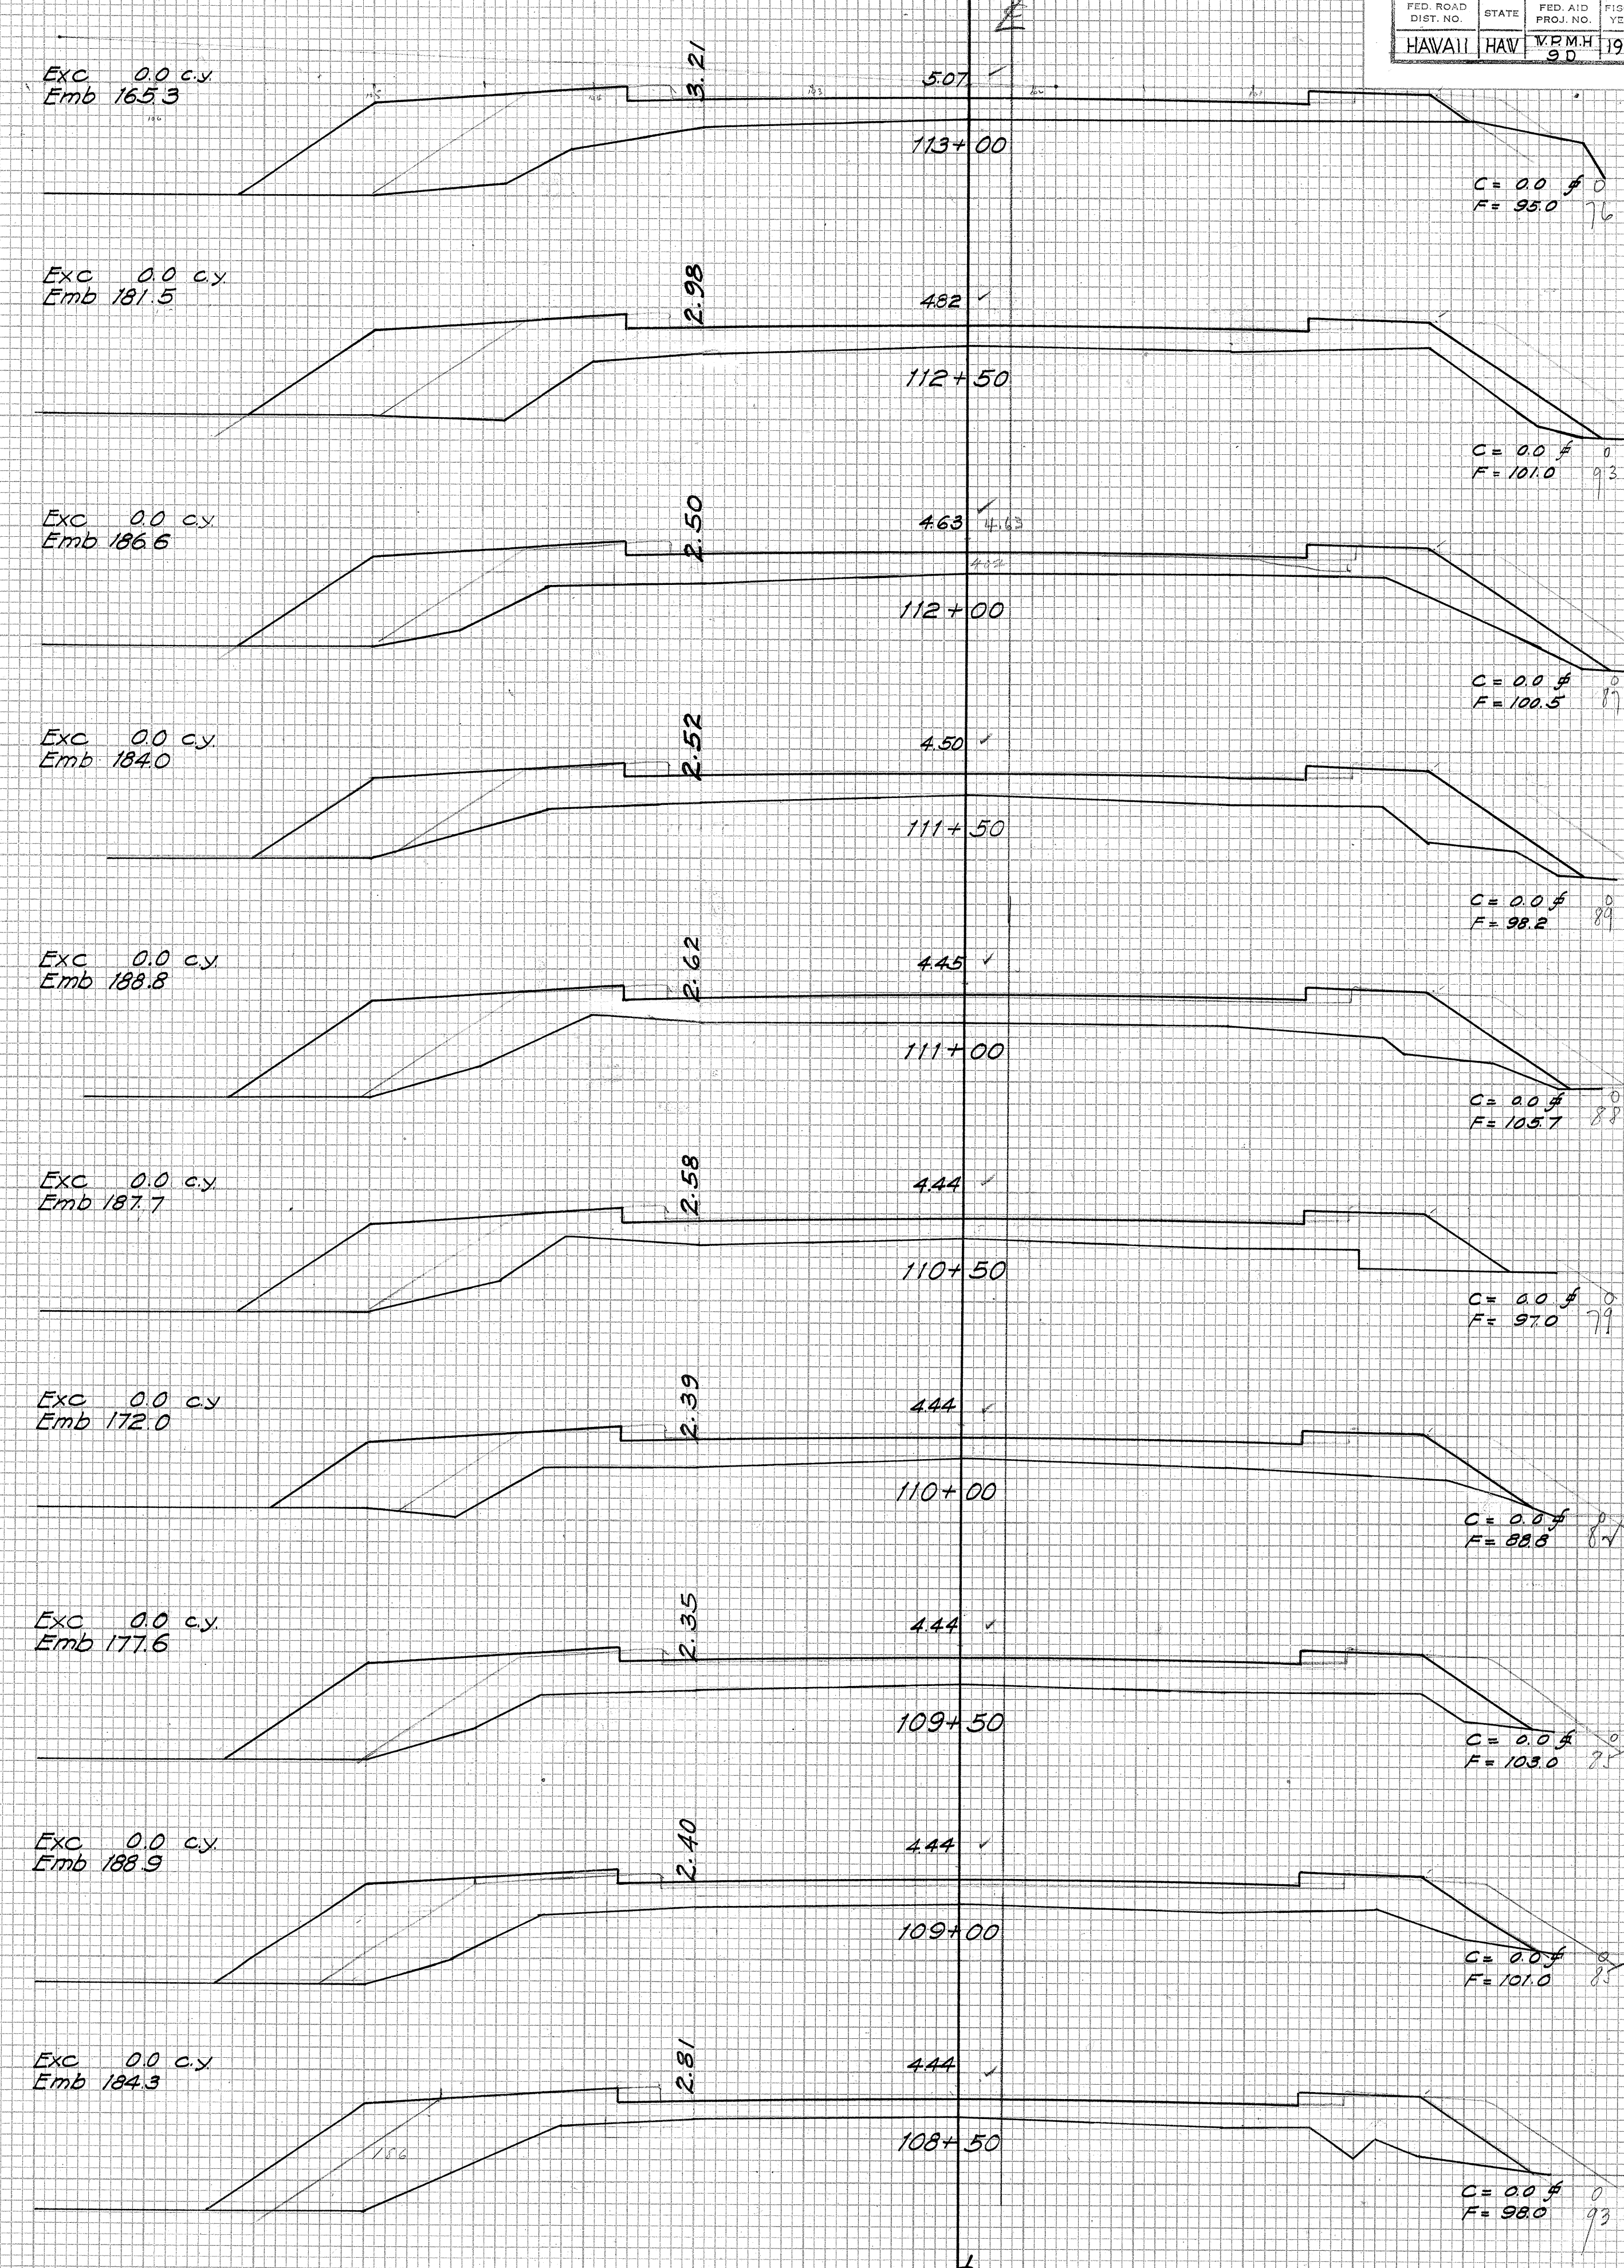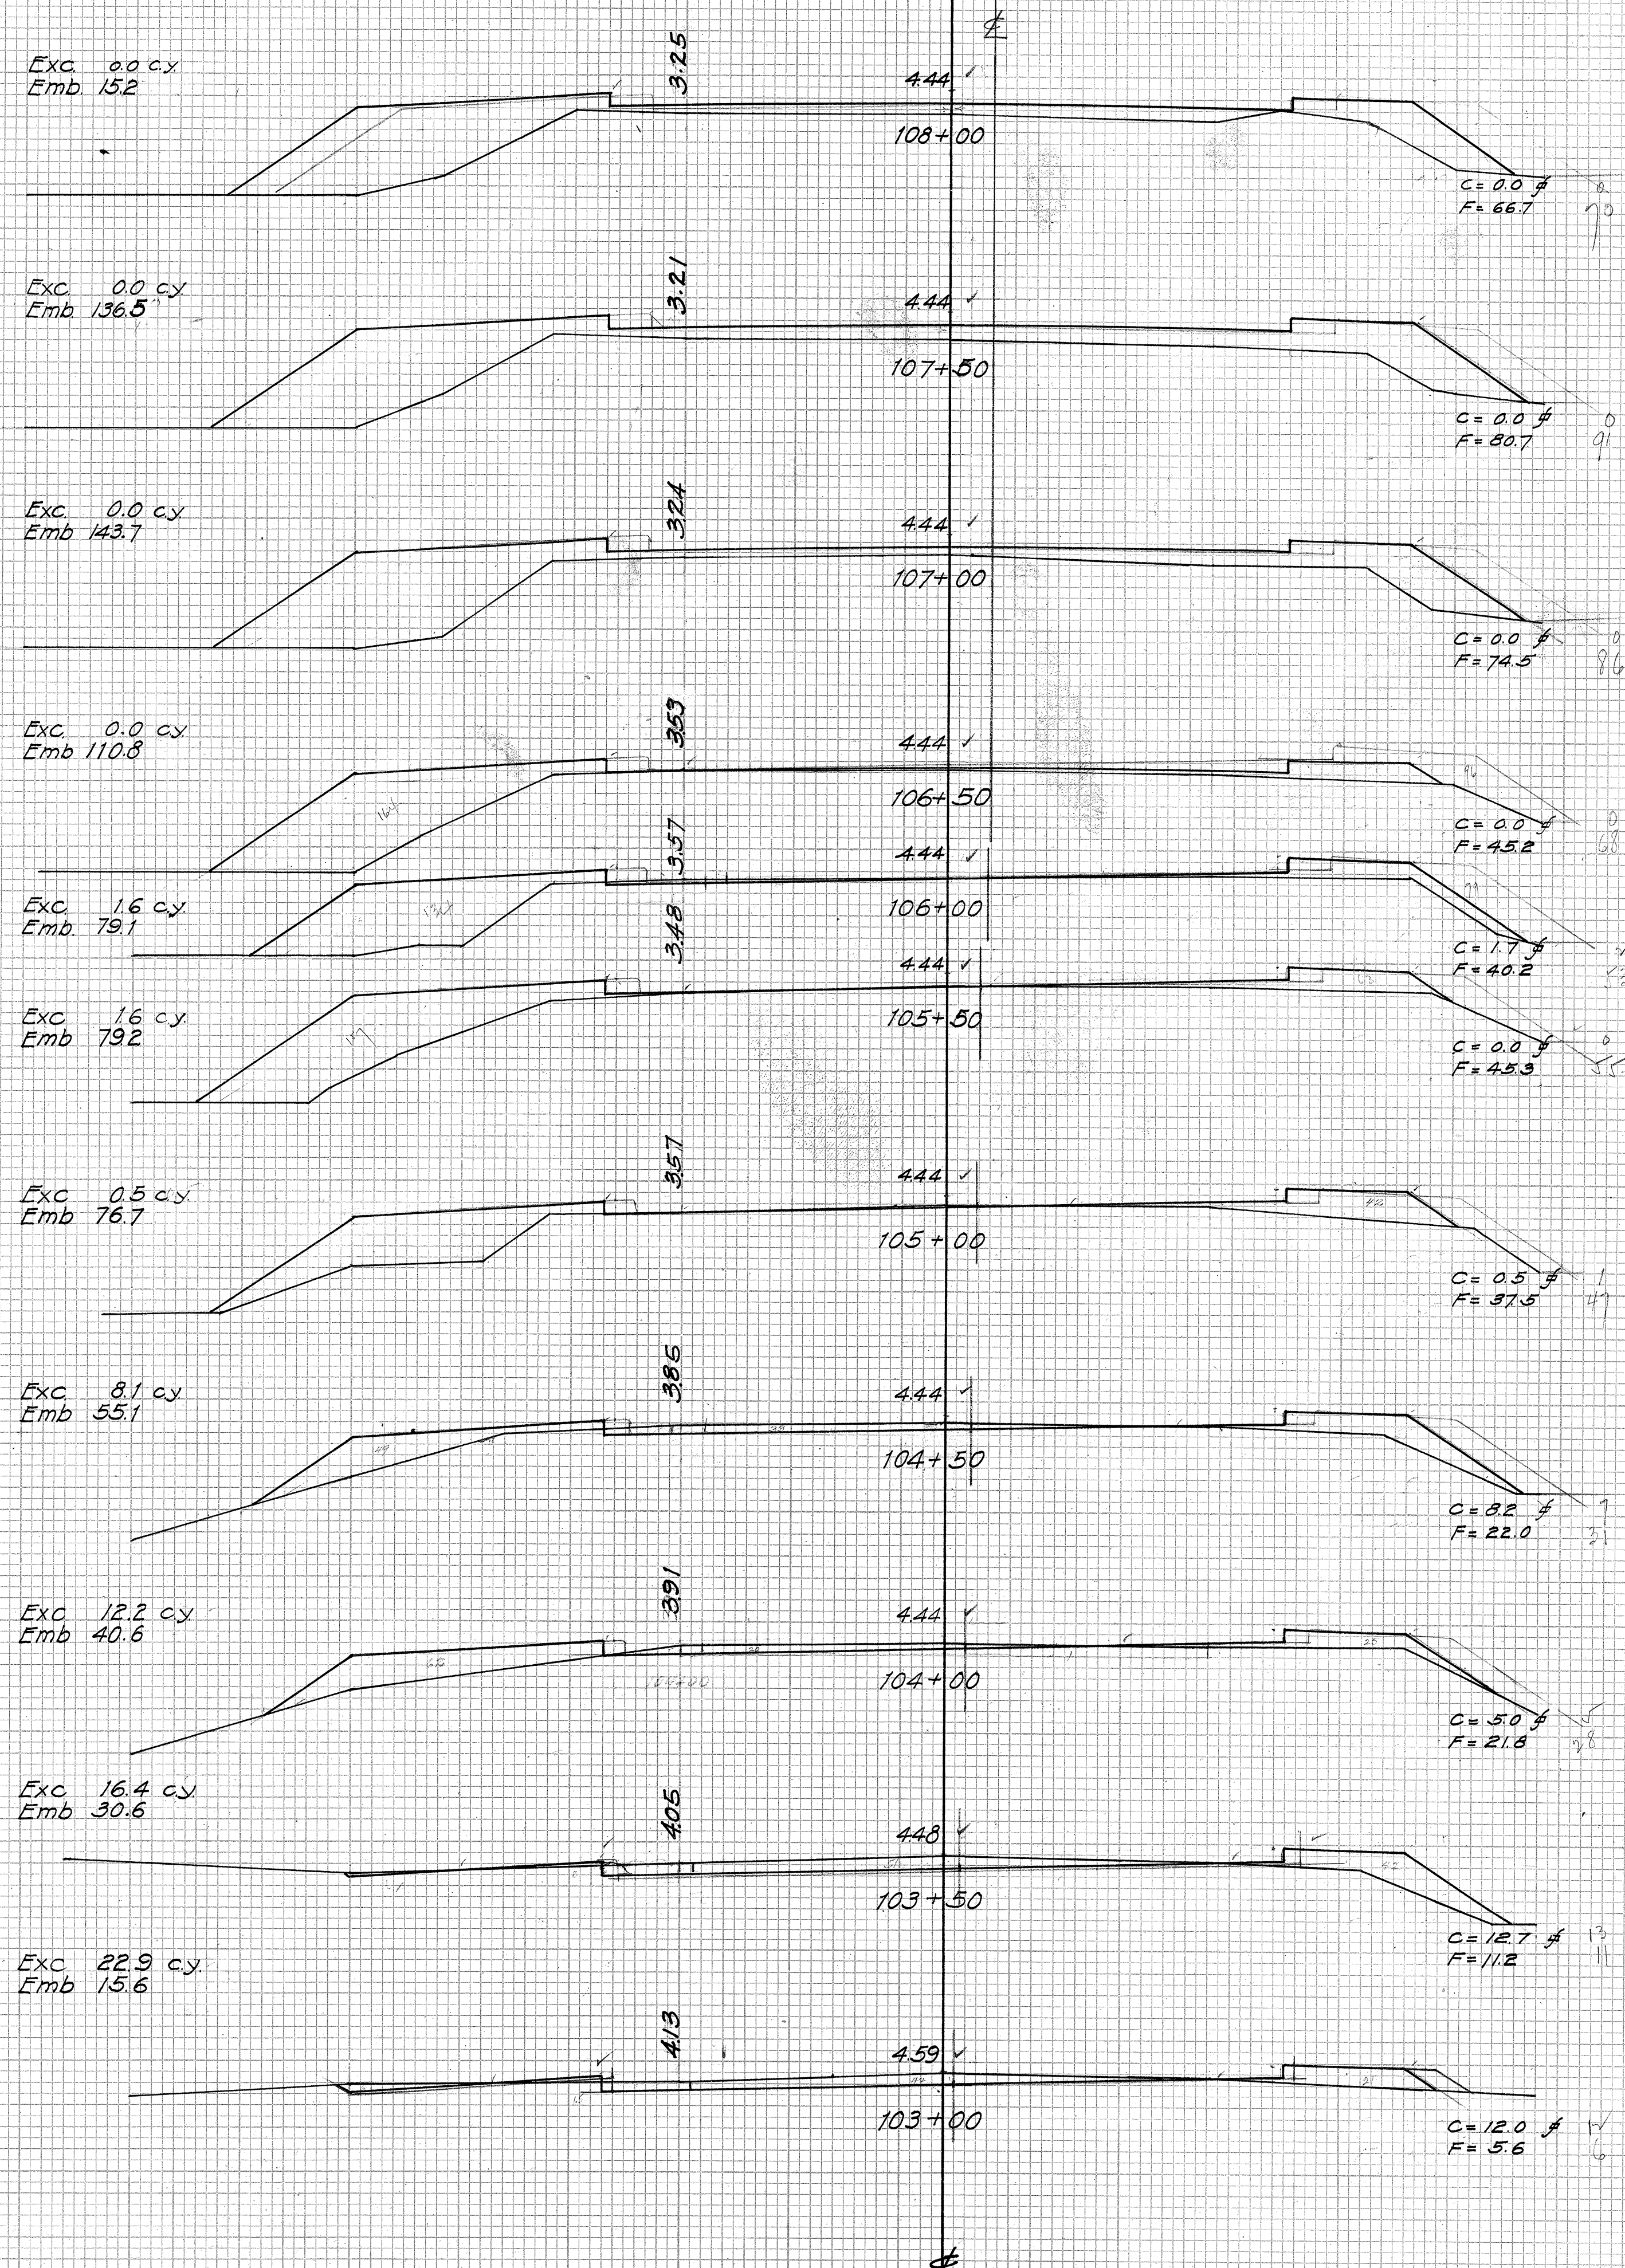

FINAL	BY	10/35
SURVEY	ENC.	
NOTE BOOK	"	
NO.	H.K.	


ORIGINAL	DATE	10/35
SURVEY	ENC.	
NOTE BOOK	"	
NO.	354	

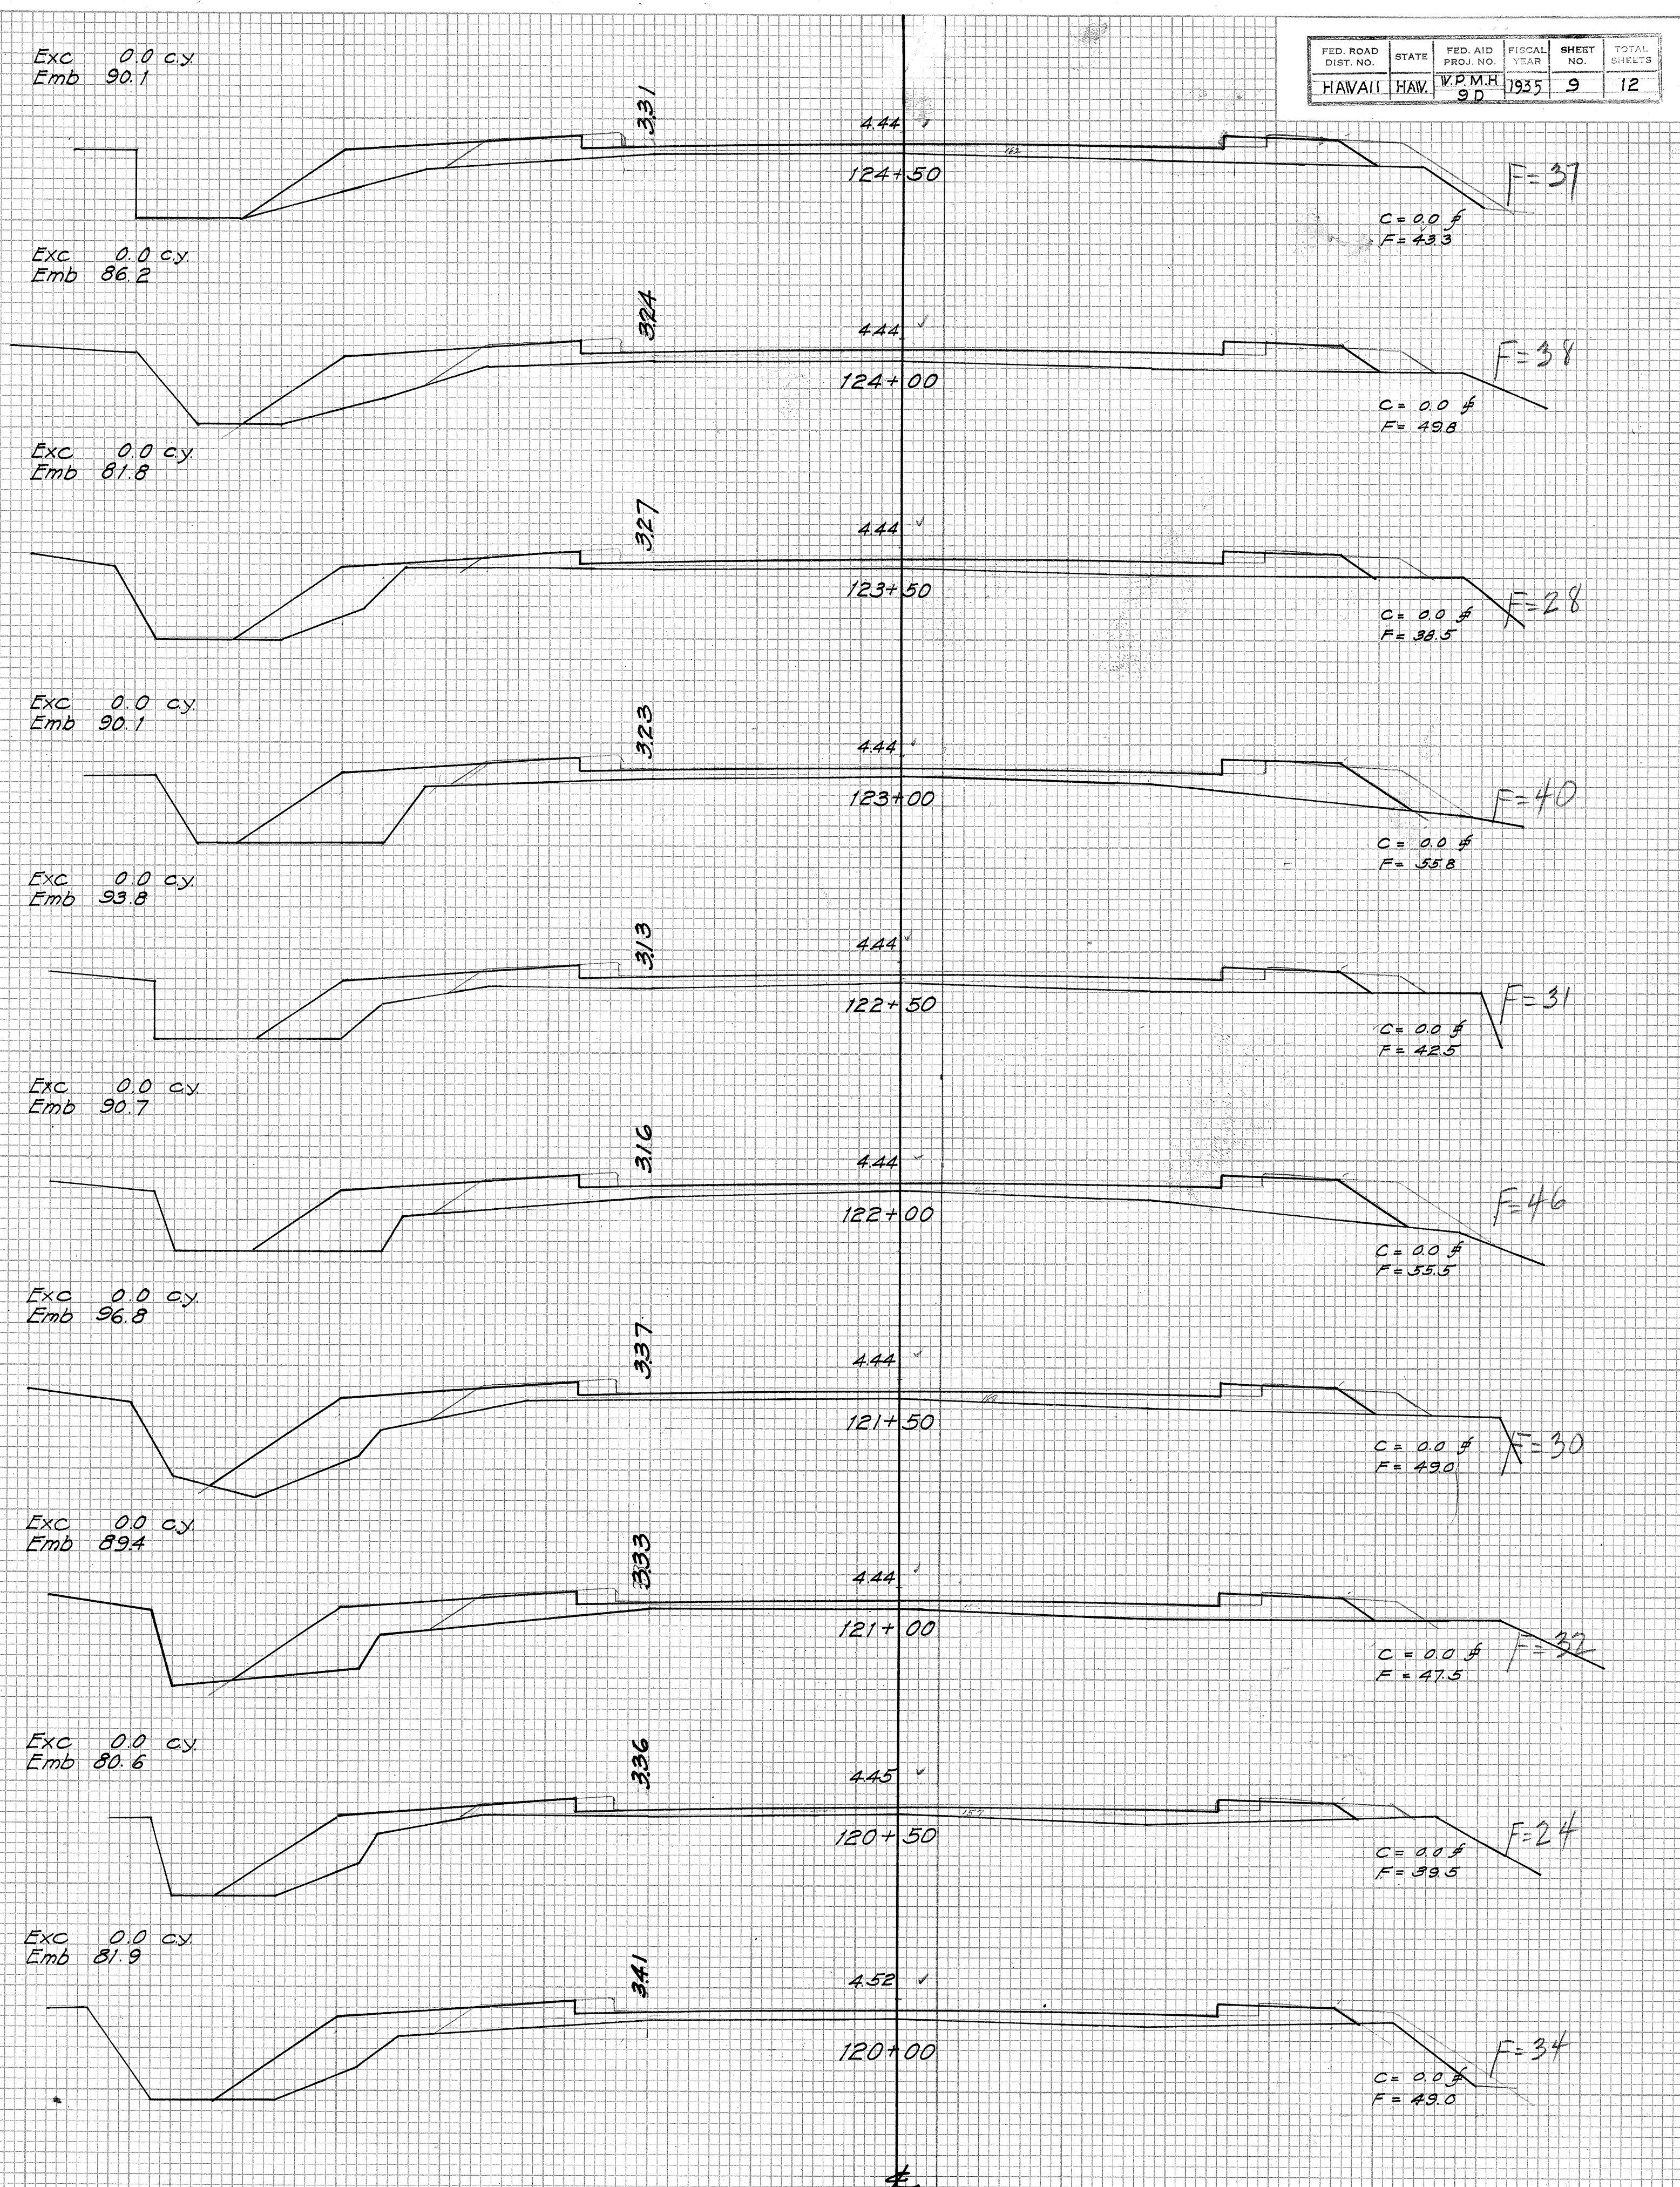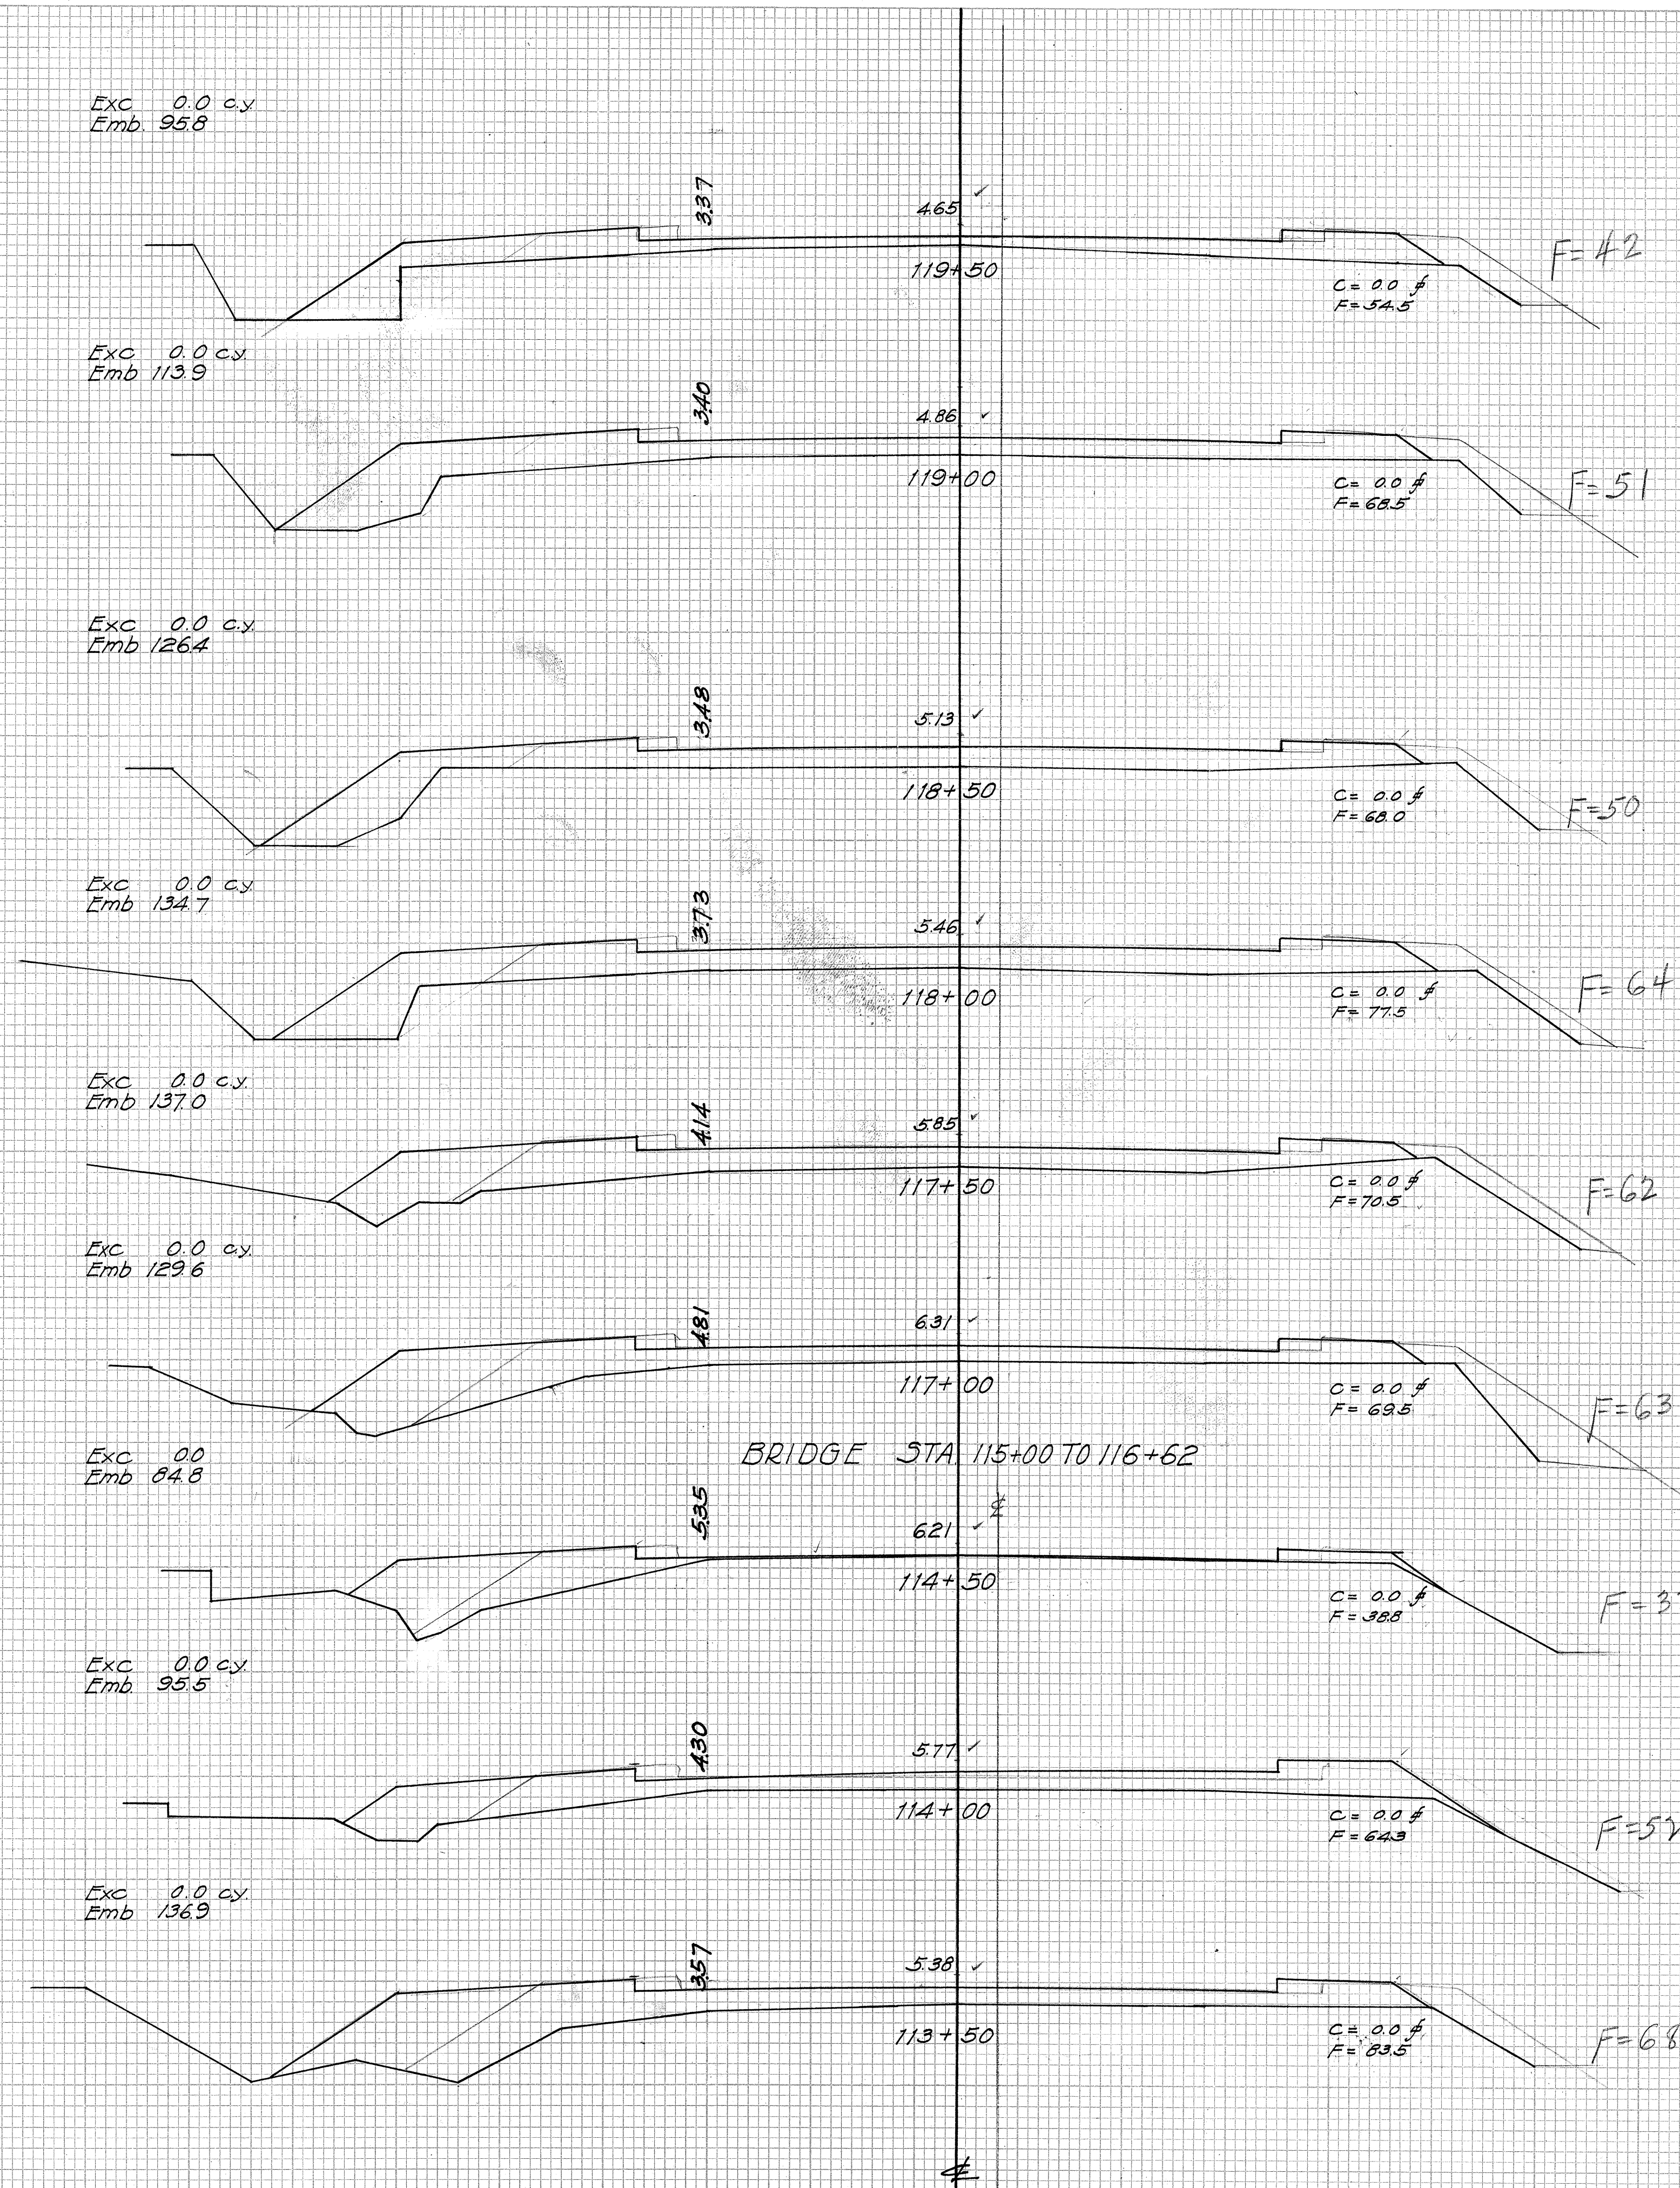

FED. ROAD DIST. NO.	STATE	FED. AID PROJ. NO.	FISCAL YEAR	SHEET NO.	TOTAL SHEETS
HAWAII	HAW.	W.P.M.H.	90	1935	9 12

FINAL SURVEY	SURVEYED	BY	DATE
	PLOTTED	<i>E.N.C.</i>	<i>10 95</i>
	TEMPLATE	<i>"</i>	<i>"</i>
NOTE BOOK	AREAS	<i>"</i>	<i>"</i>
NO.	AREAS CHECKED	<i>H.H.K.</i>	<i>"</i>



ORIGINAL	BY	DATE
SURVEY	CDC	1988
NOTED	FVC	10-35
BOOK	FVC	10-35
NO.	FVC	10-35
354	CQR	10-35
AREAS CHECKED		

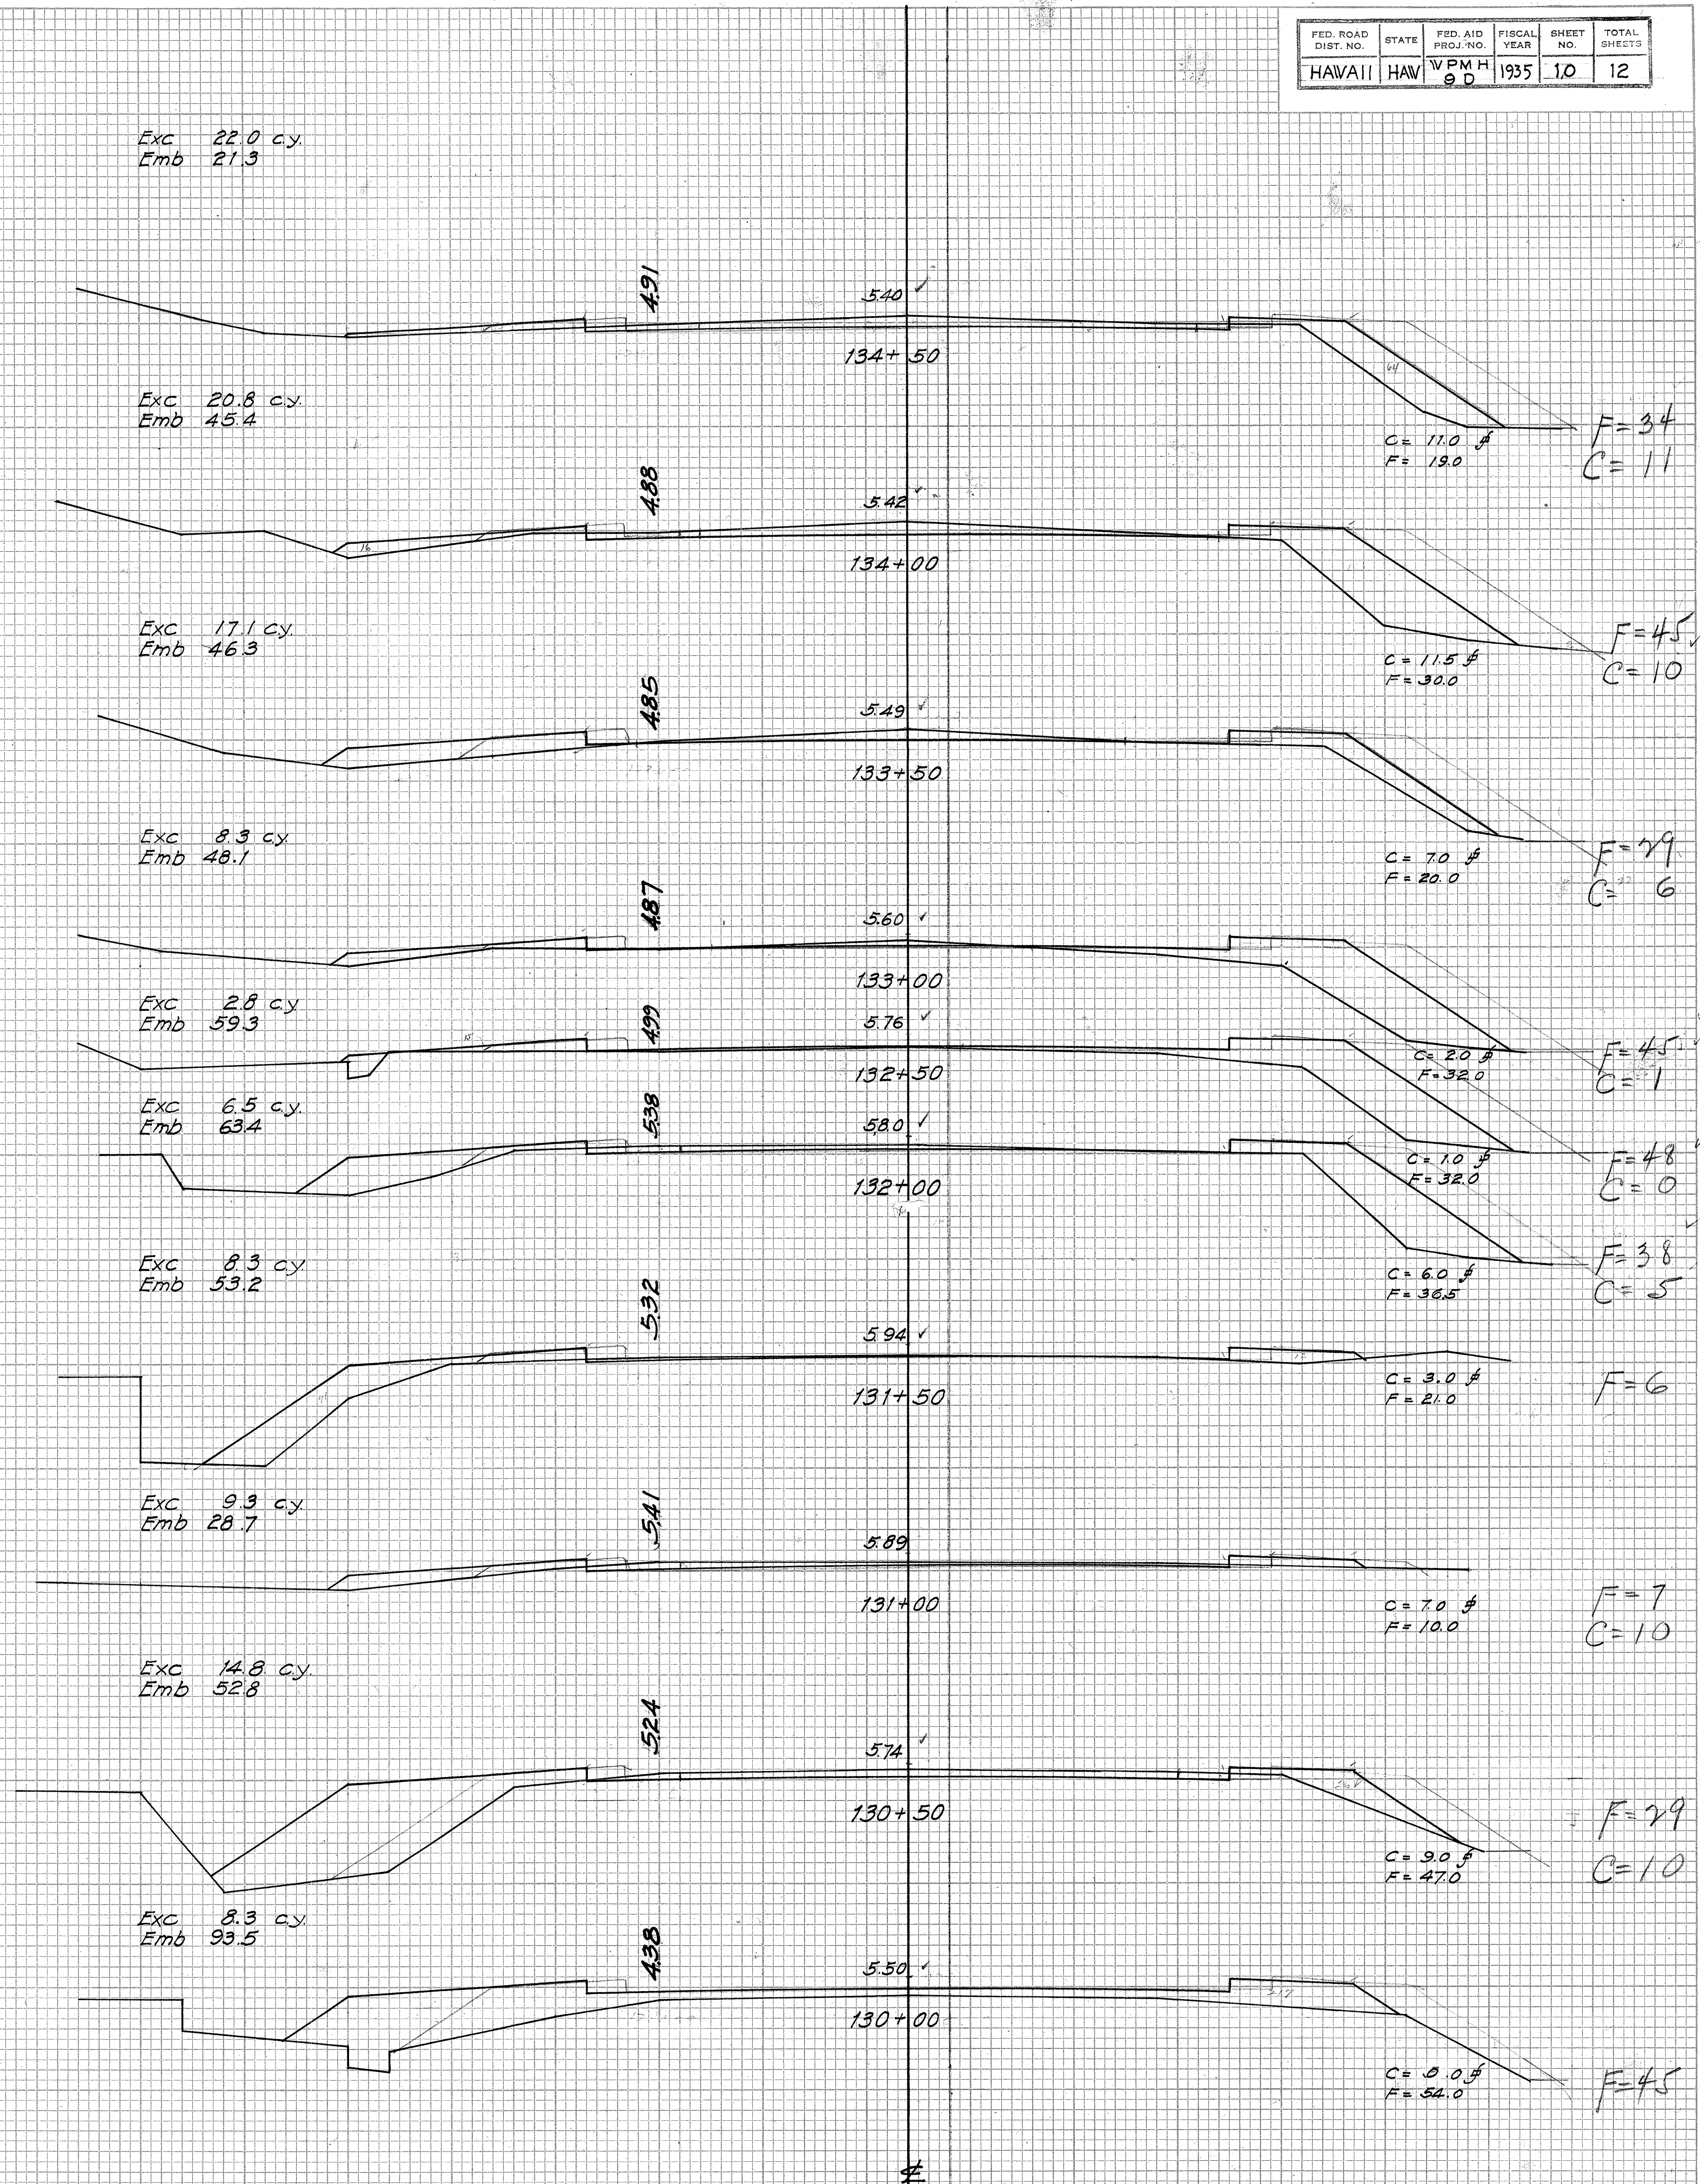

FINAL	BY	DATE
SURVEY	EMC	10-35
NOTED		
BOOK		
PLATE		
NO.	H.H.K.	

ORIGINAL	BY	DATE
SURVEY	EMC	10-35
NOTED		
BOOK		
PLATE		
NO.	H.H.K.	

FED. ROAD DIST. NO.	STATE	FED. AID PROJ. NO.	FISCAL YEAR	SHEET NO.	TOTAL SHEETS
HAWAII	HAW	W.P.M.H. 9D	1935	11	12

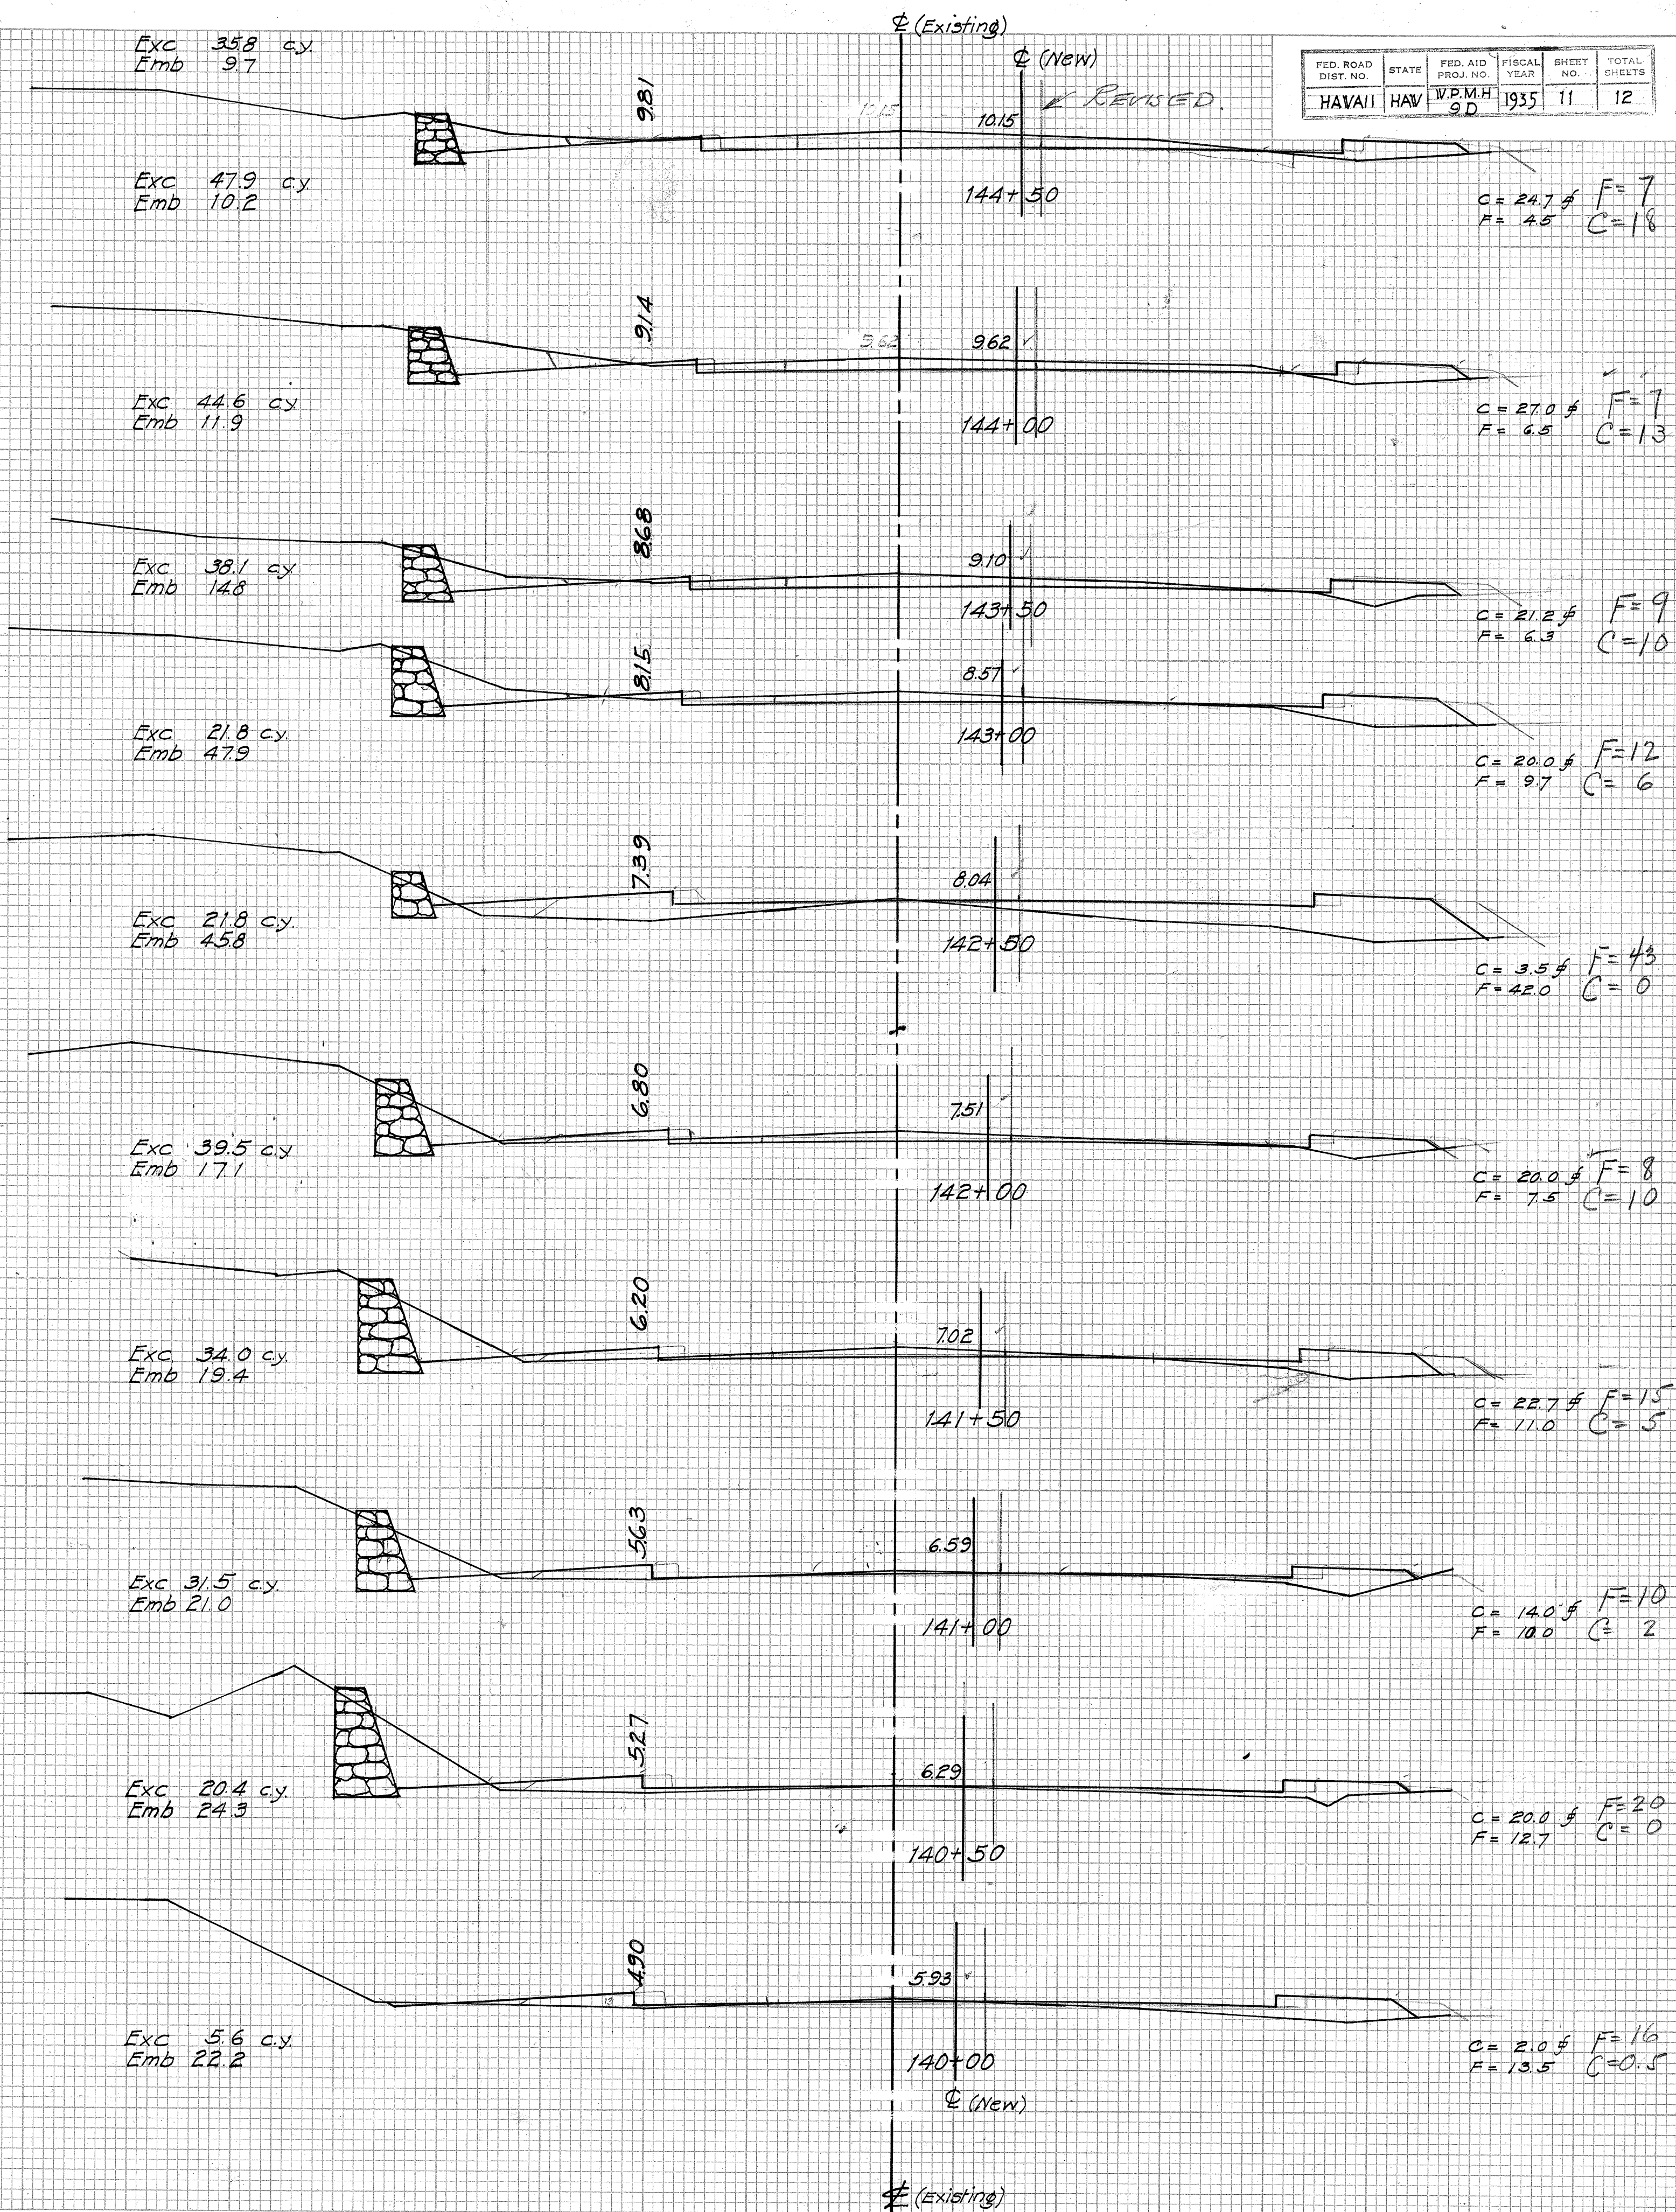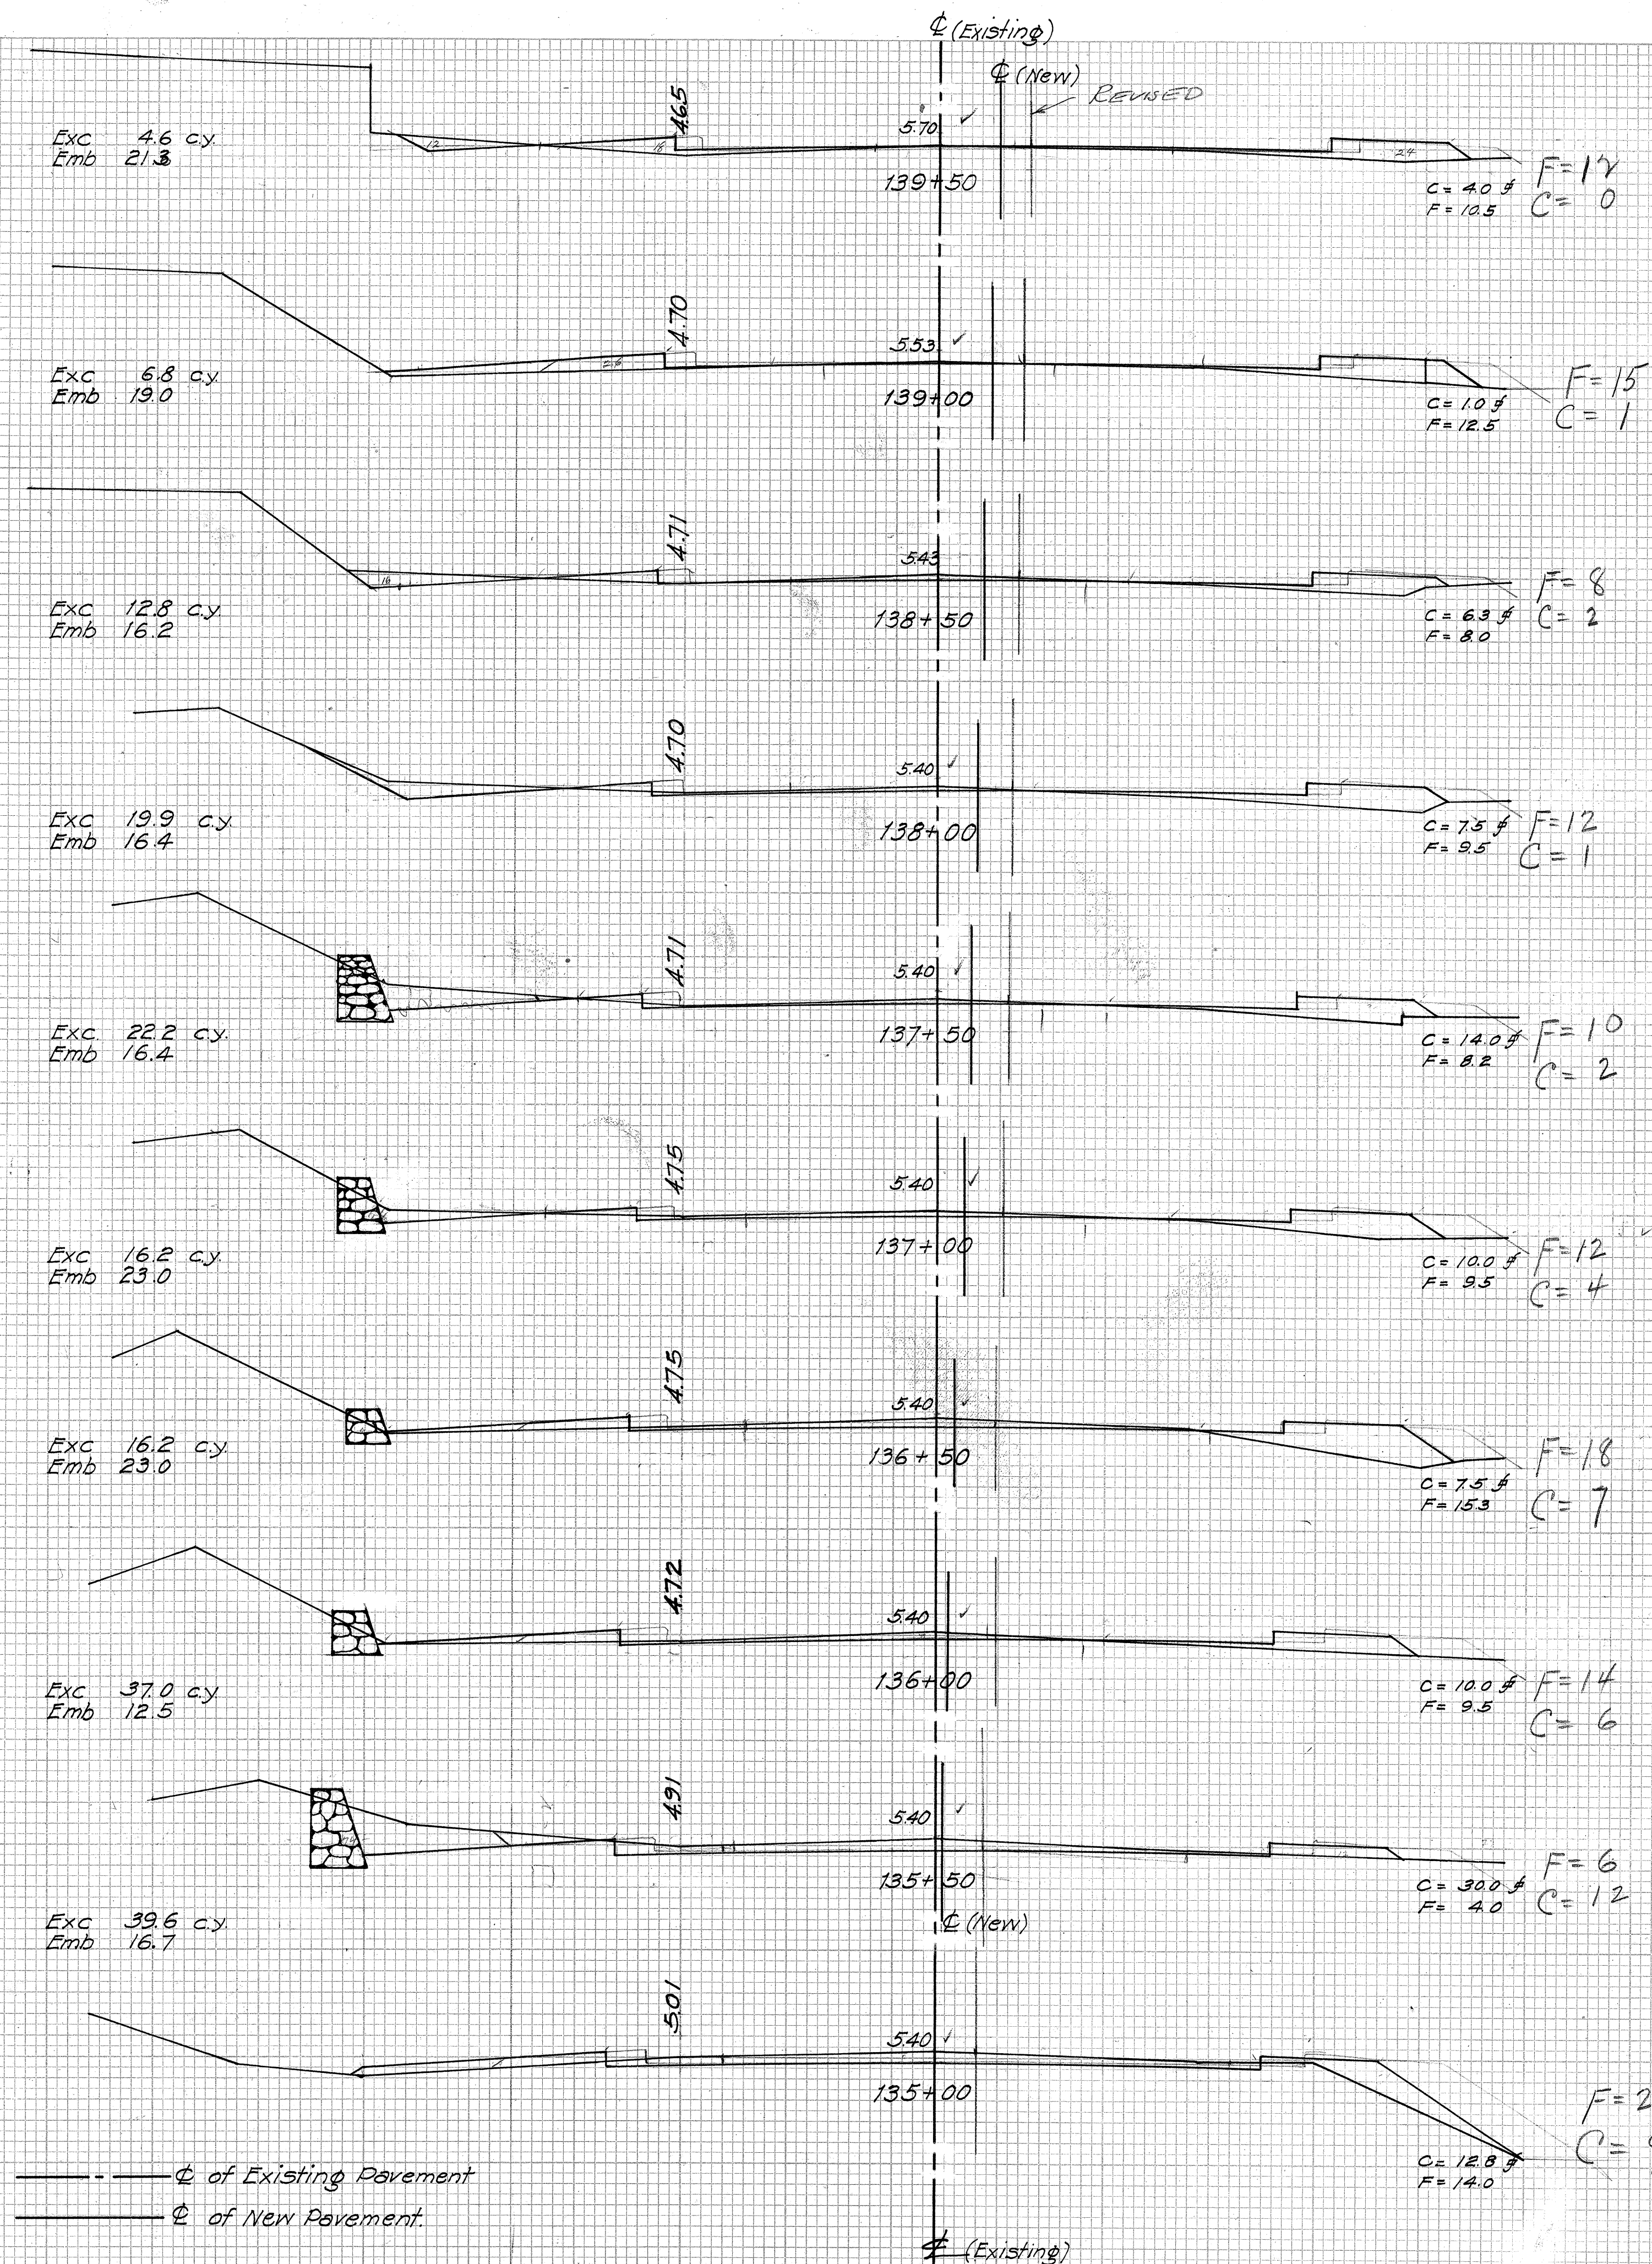

FINAL SURVEY PLOTTED BY DATE
 NOTE BOOK NO. 354
 AREAS CHECKED H.H.K.
 10-35

ORIGINAL SURVEY PLOTTED BY DATE
 NOTE BOOK NO. 354
 AREAS CHECKED H.H.K.
 10-35

