



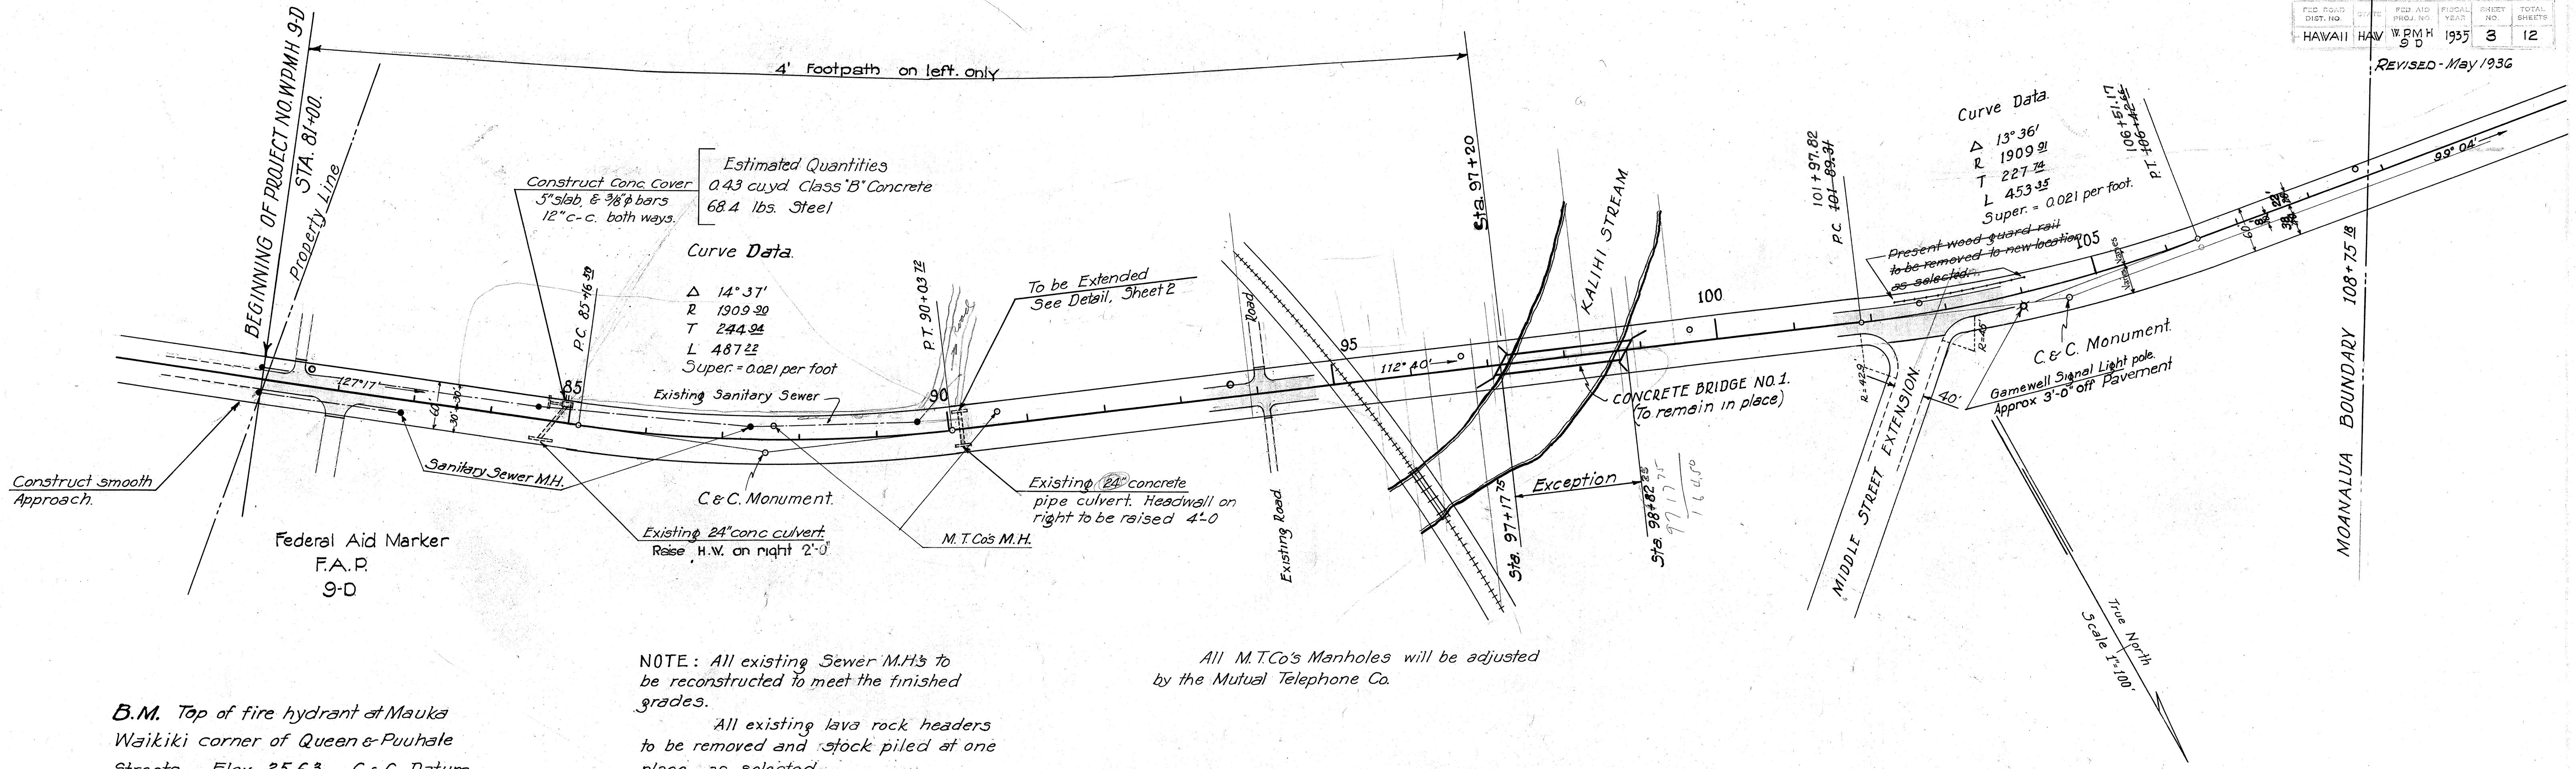


B.M. Top of fire hydrant at Mauka Waikiki corner of Queen & Puuhale Streets. Elev. 25.63 C&C Datum.

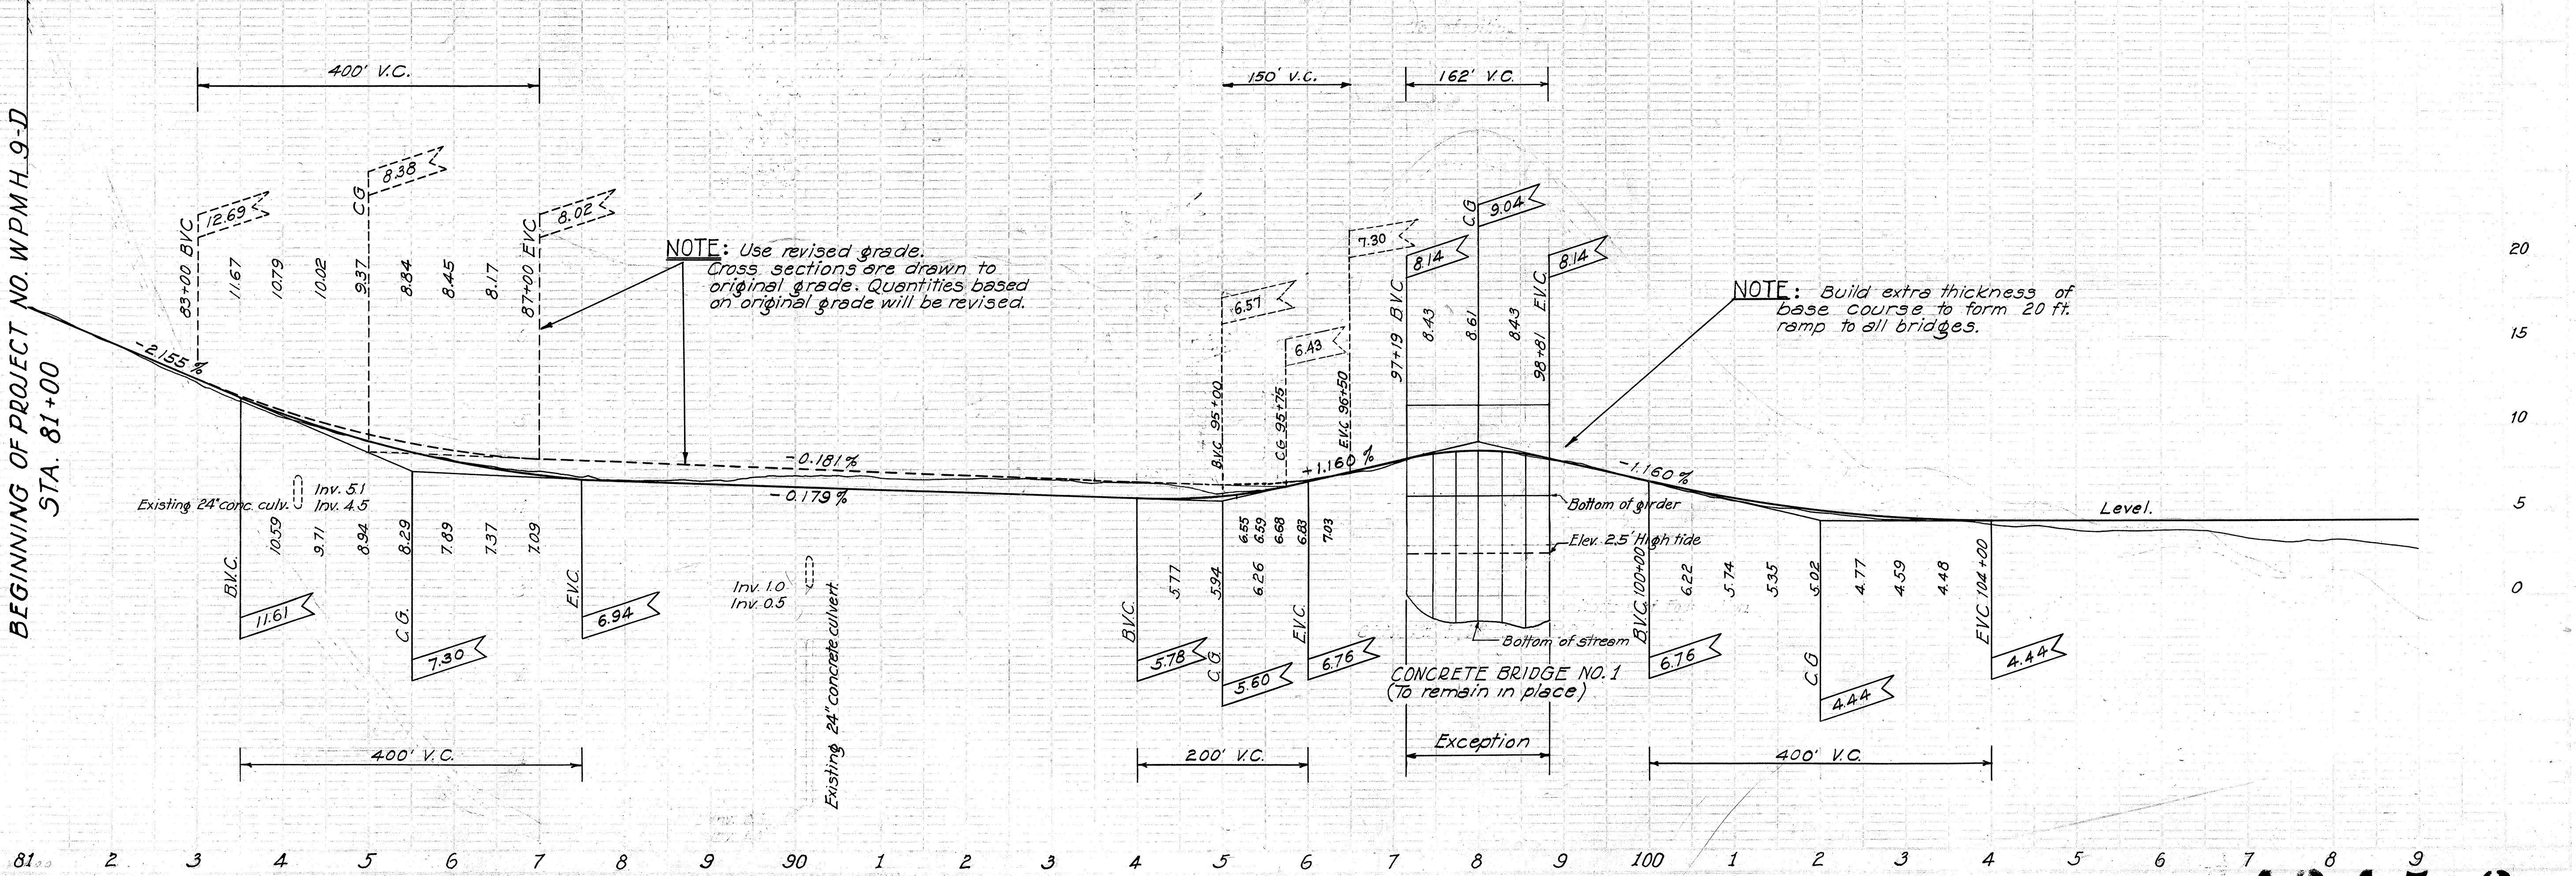

REVISED - May 1936

1935
Oct 35
H.H.K.
C.D.R.

354

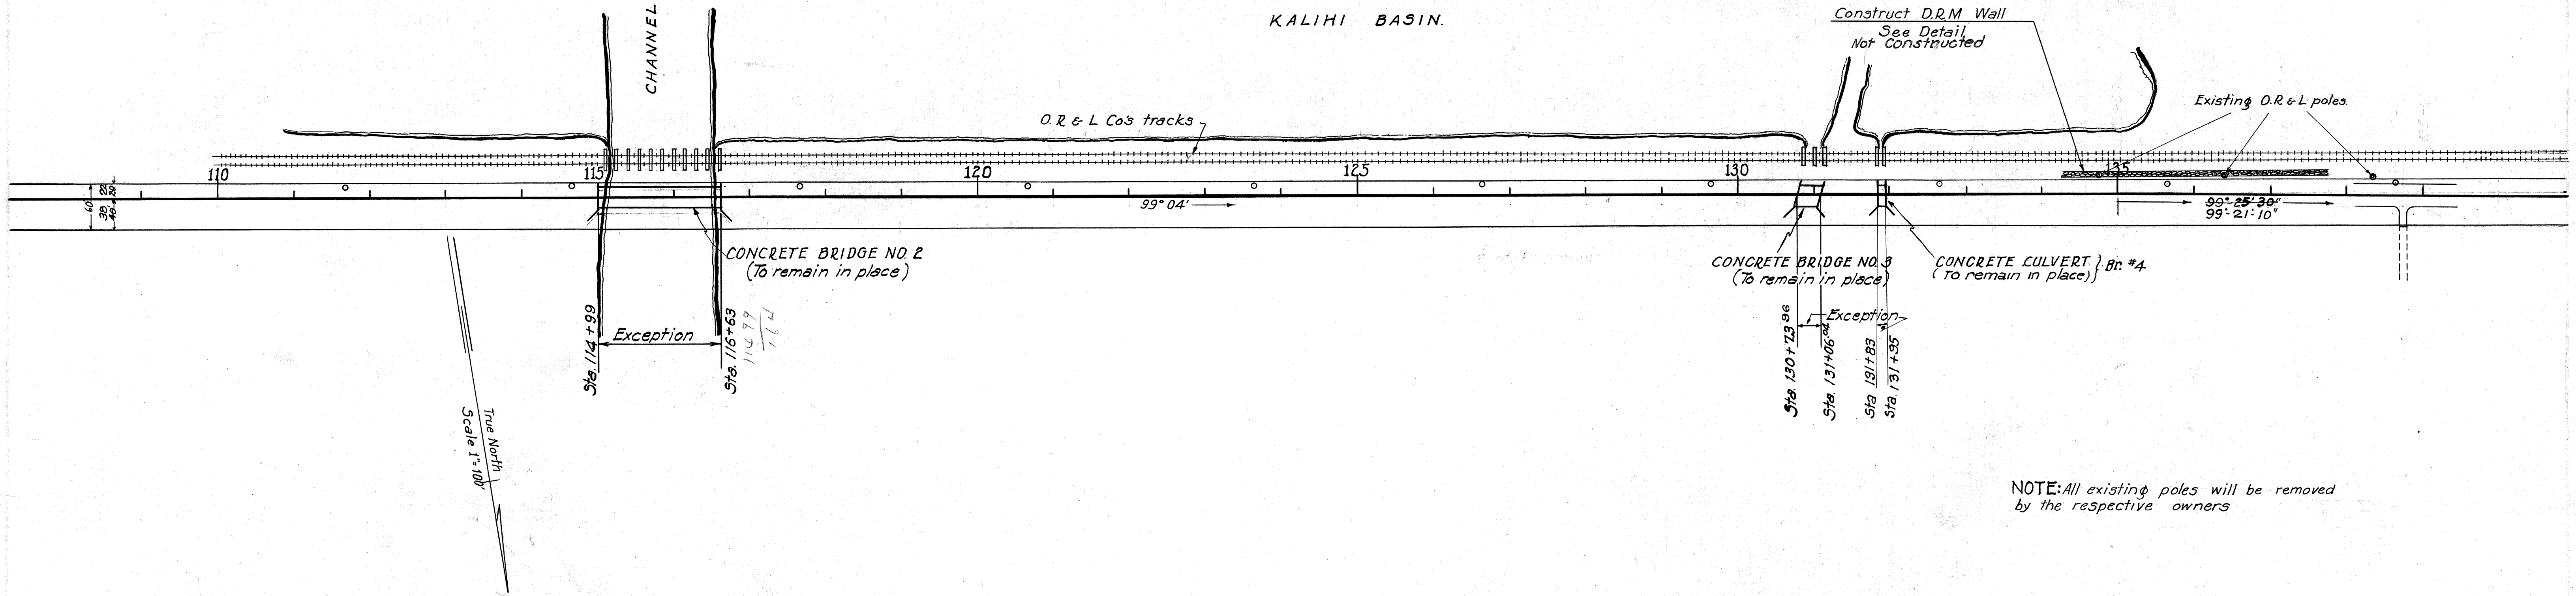


NOTE: All existing poles will be removed by the respective owners

1935
Oct 35
H.H.K.
C.D.R.

354




Revised By J.C.M. & RES. May 7, 1936

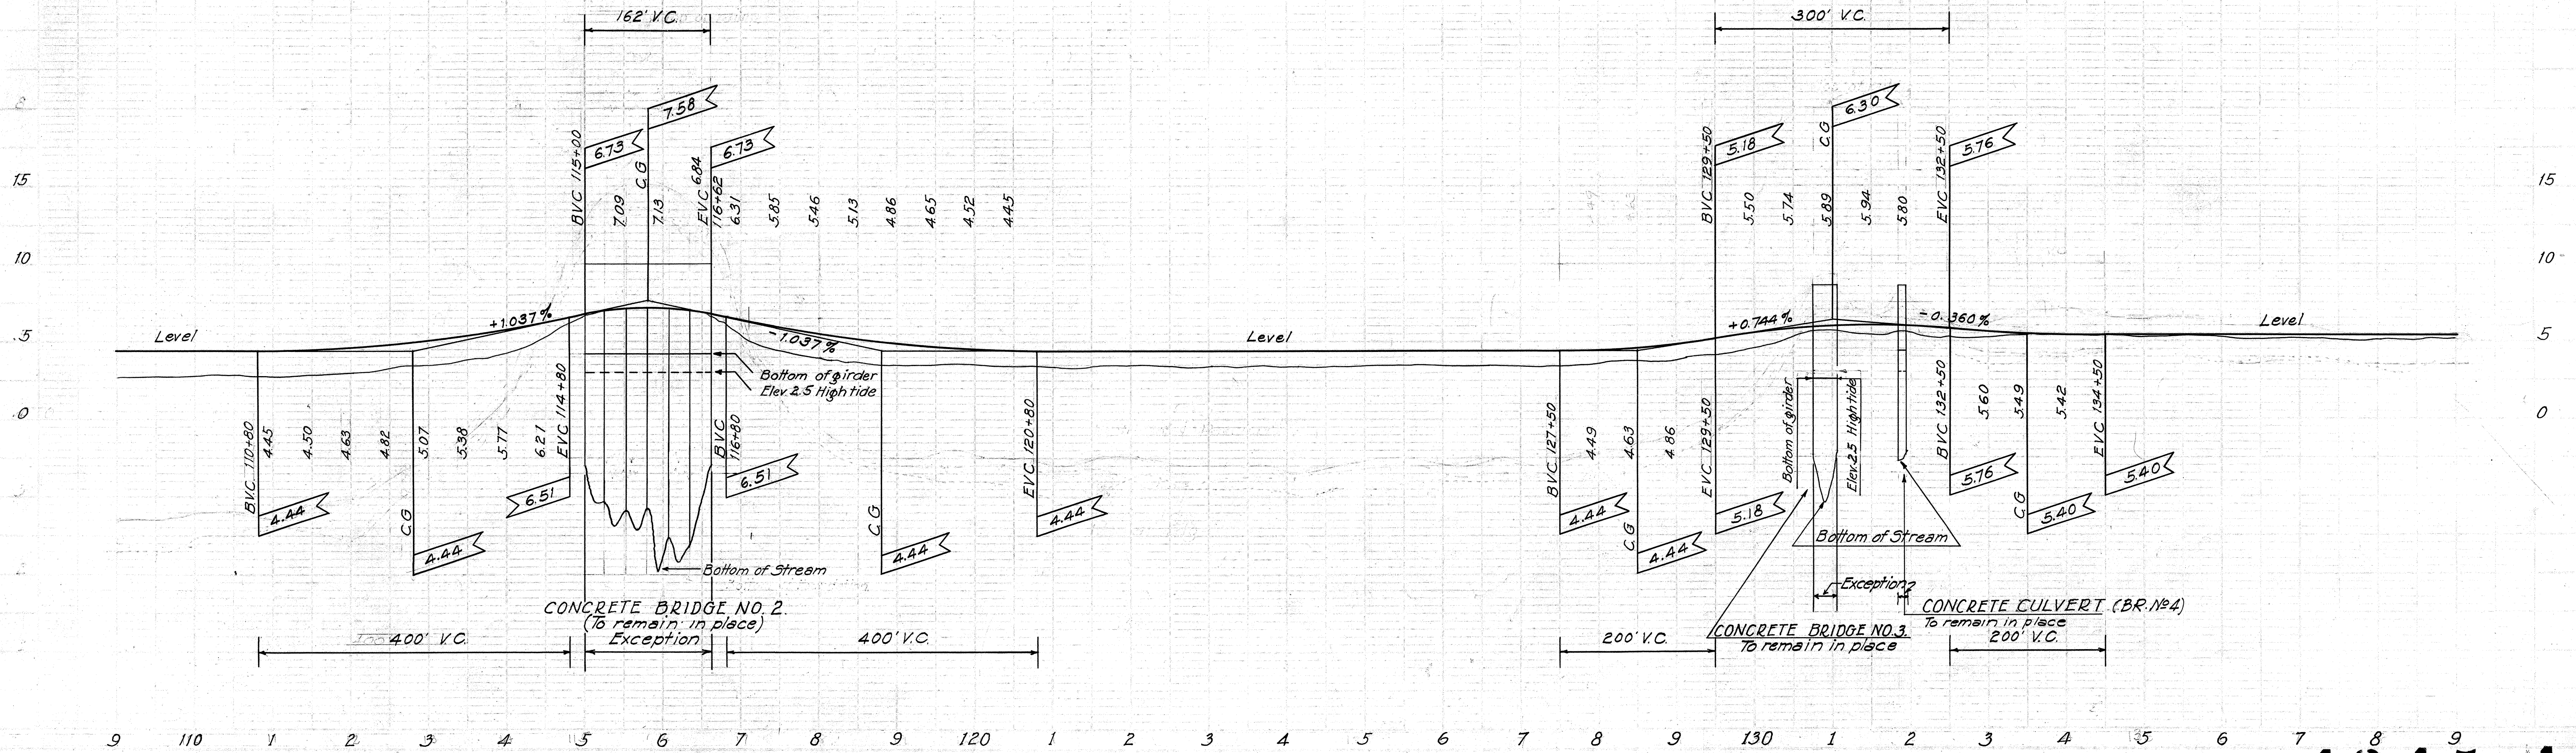

FED. ROAD DIST. NO.	STATE	FED. AID PROJ. NO.	FISCAL YEAR	SHEET NO.	TOTAL SHEETS
HAWAII	HAW	W.B.M.H. 9A	1935	5	12

REVISED - May 1936

PROJ. NO. N.R.H. 9A.

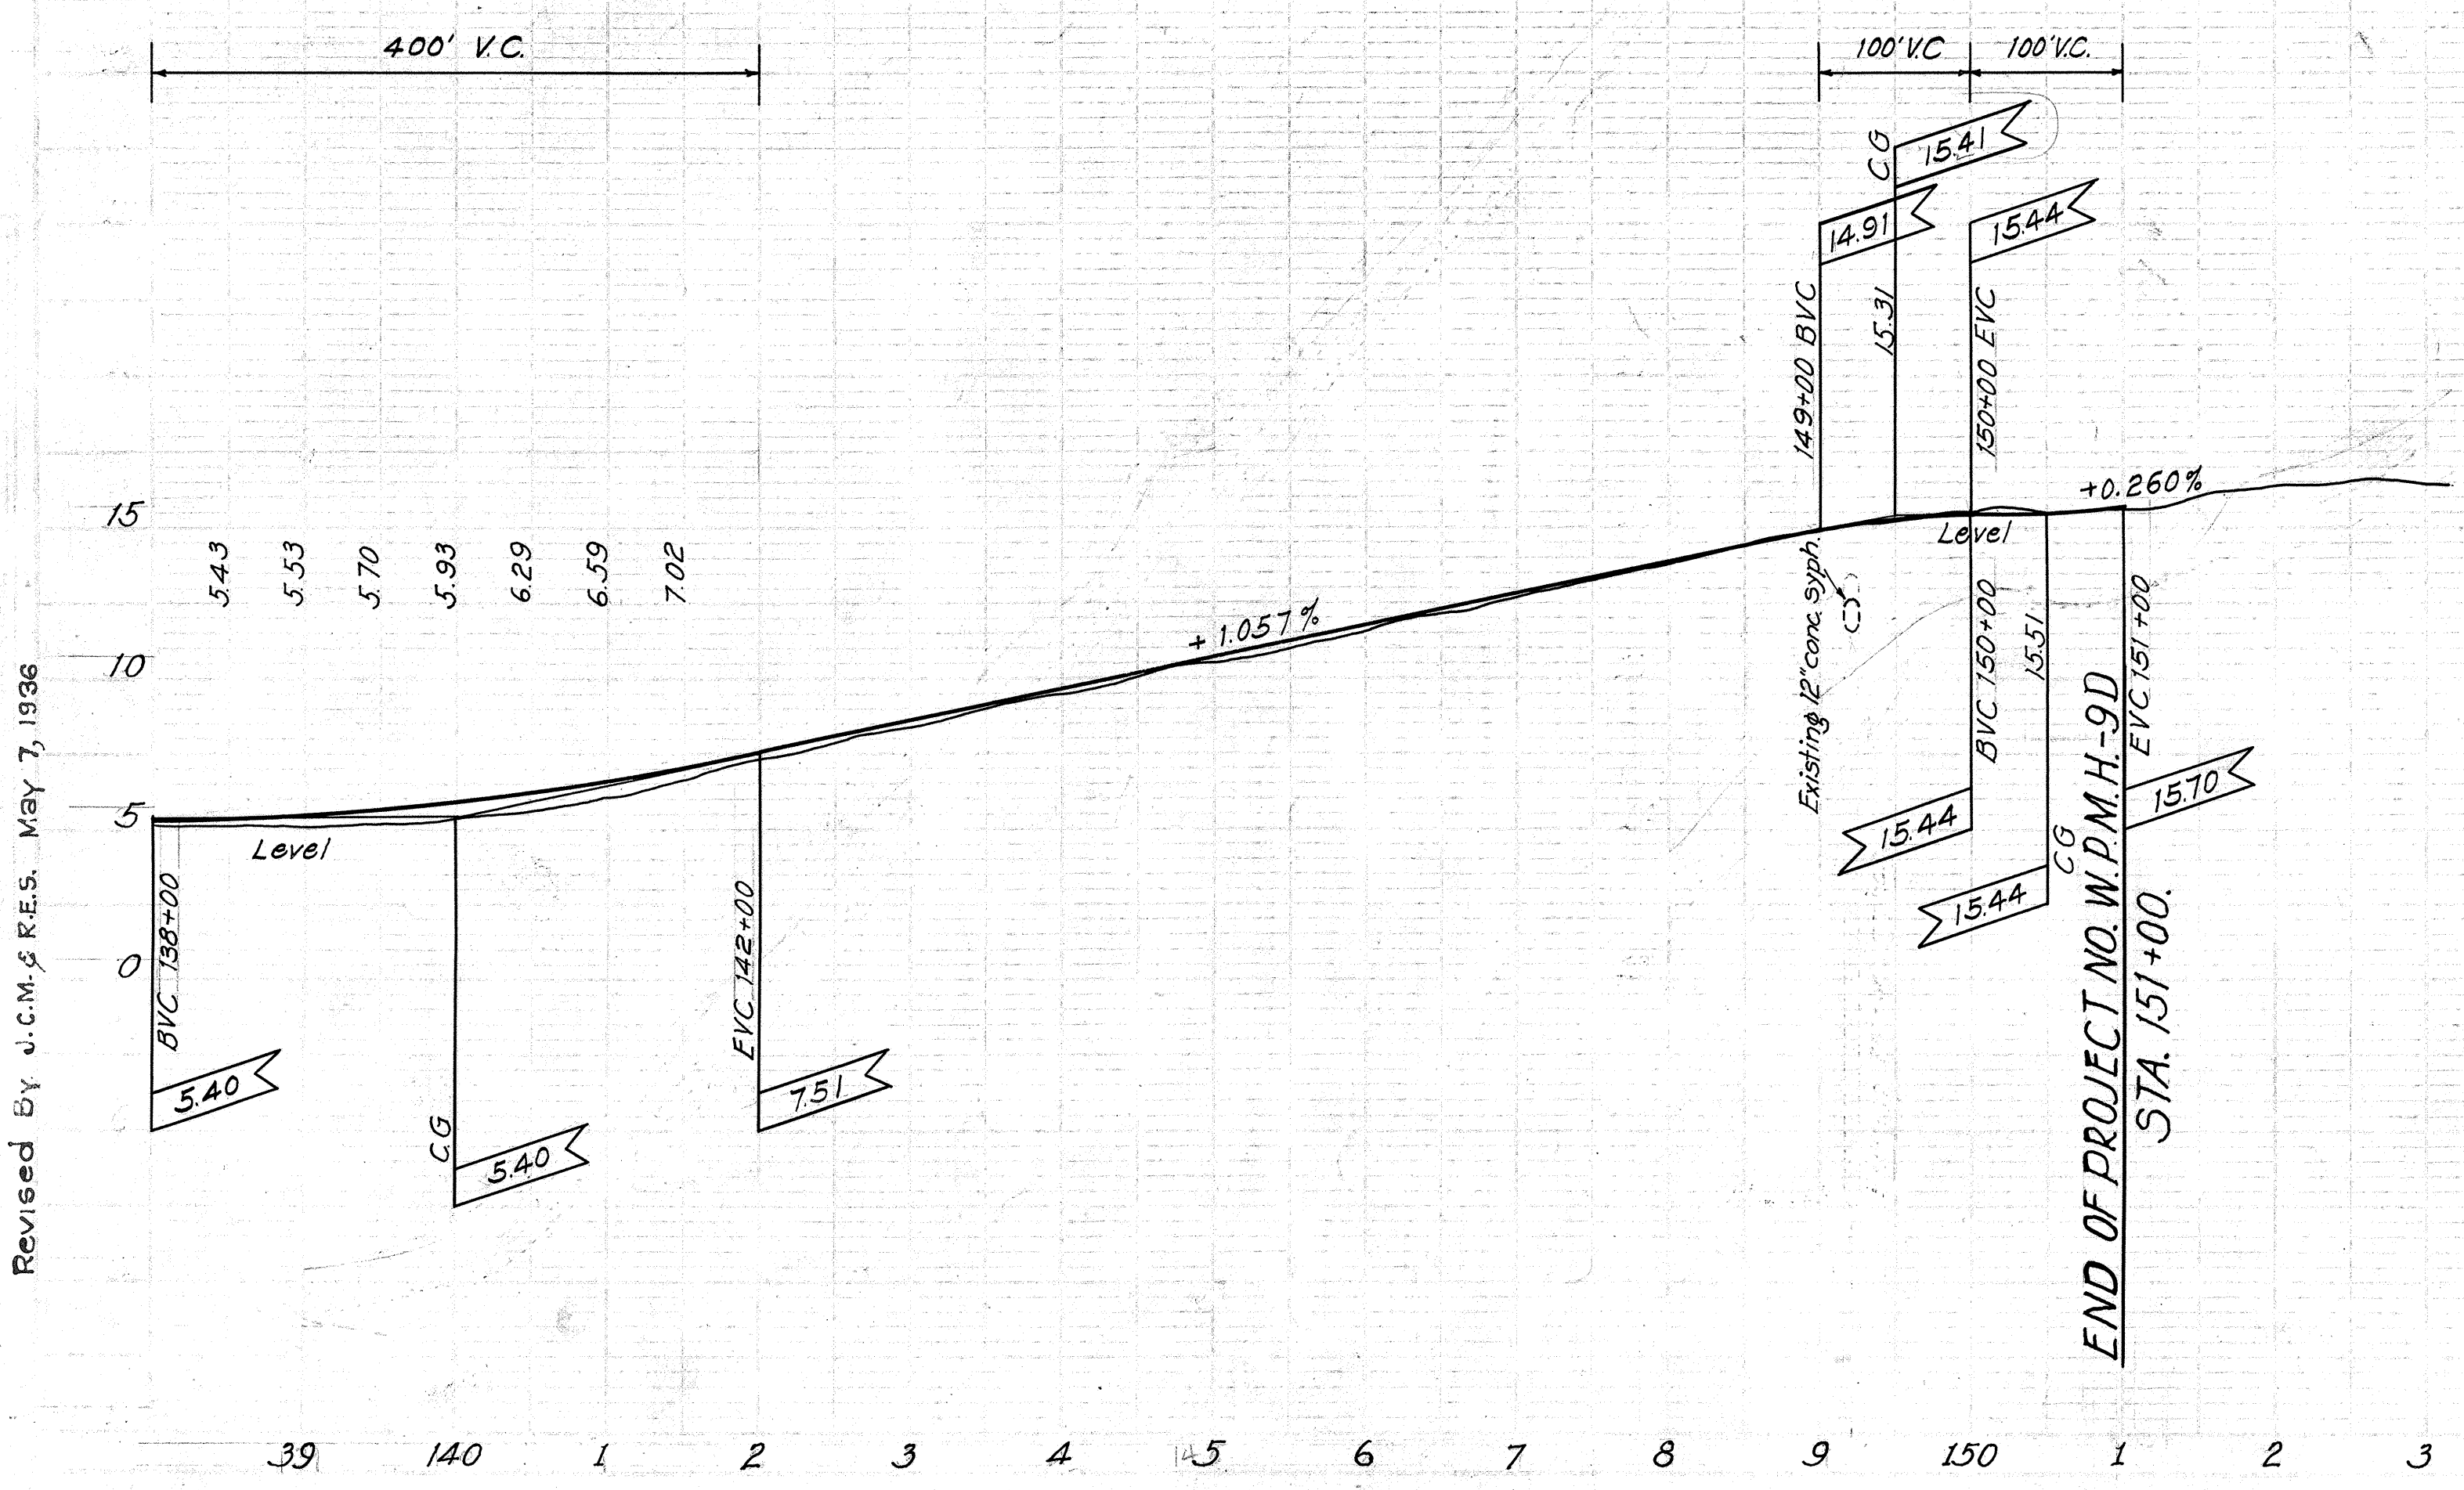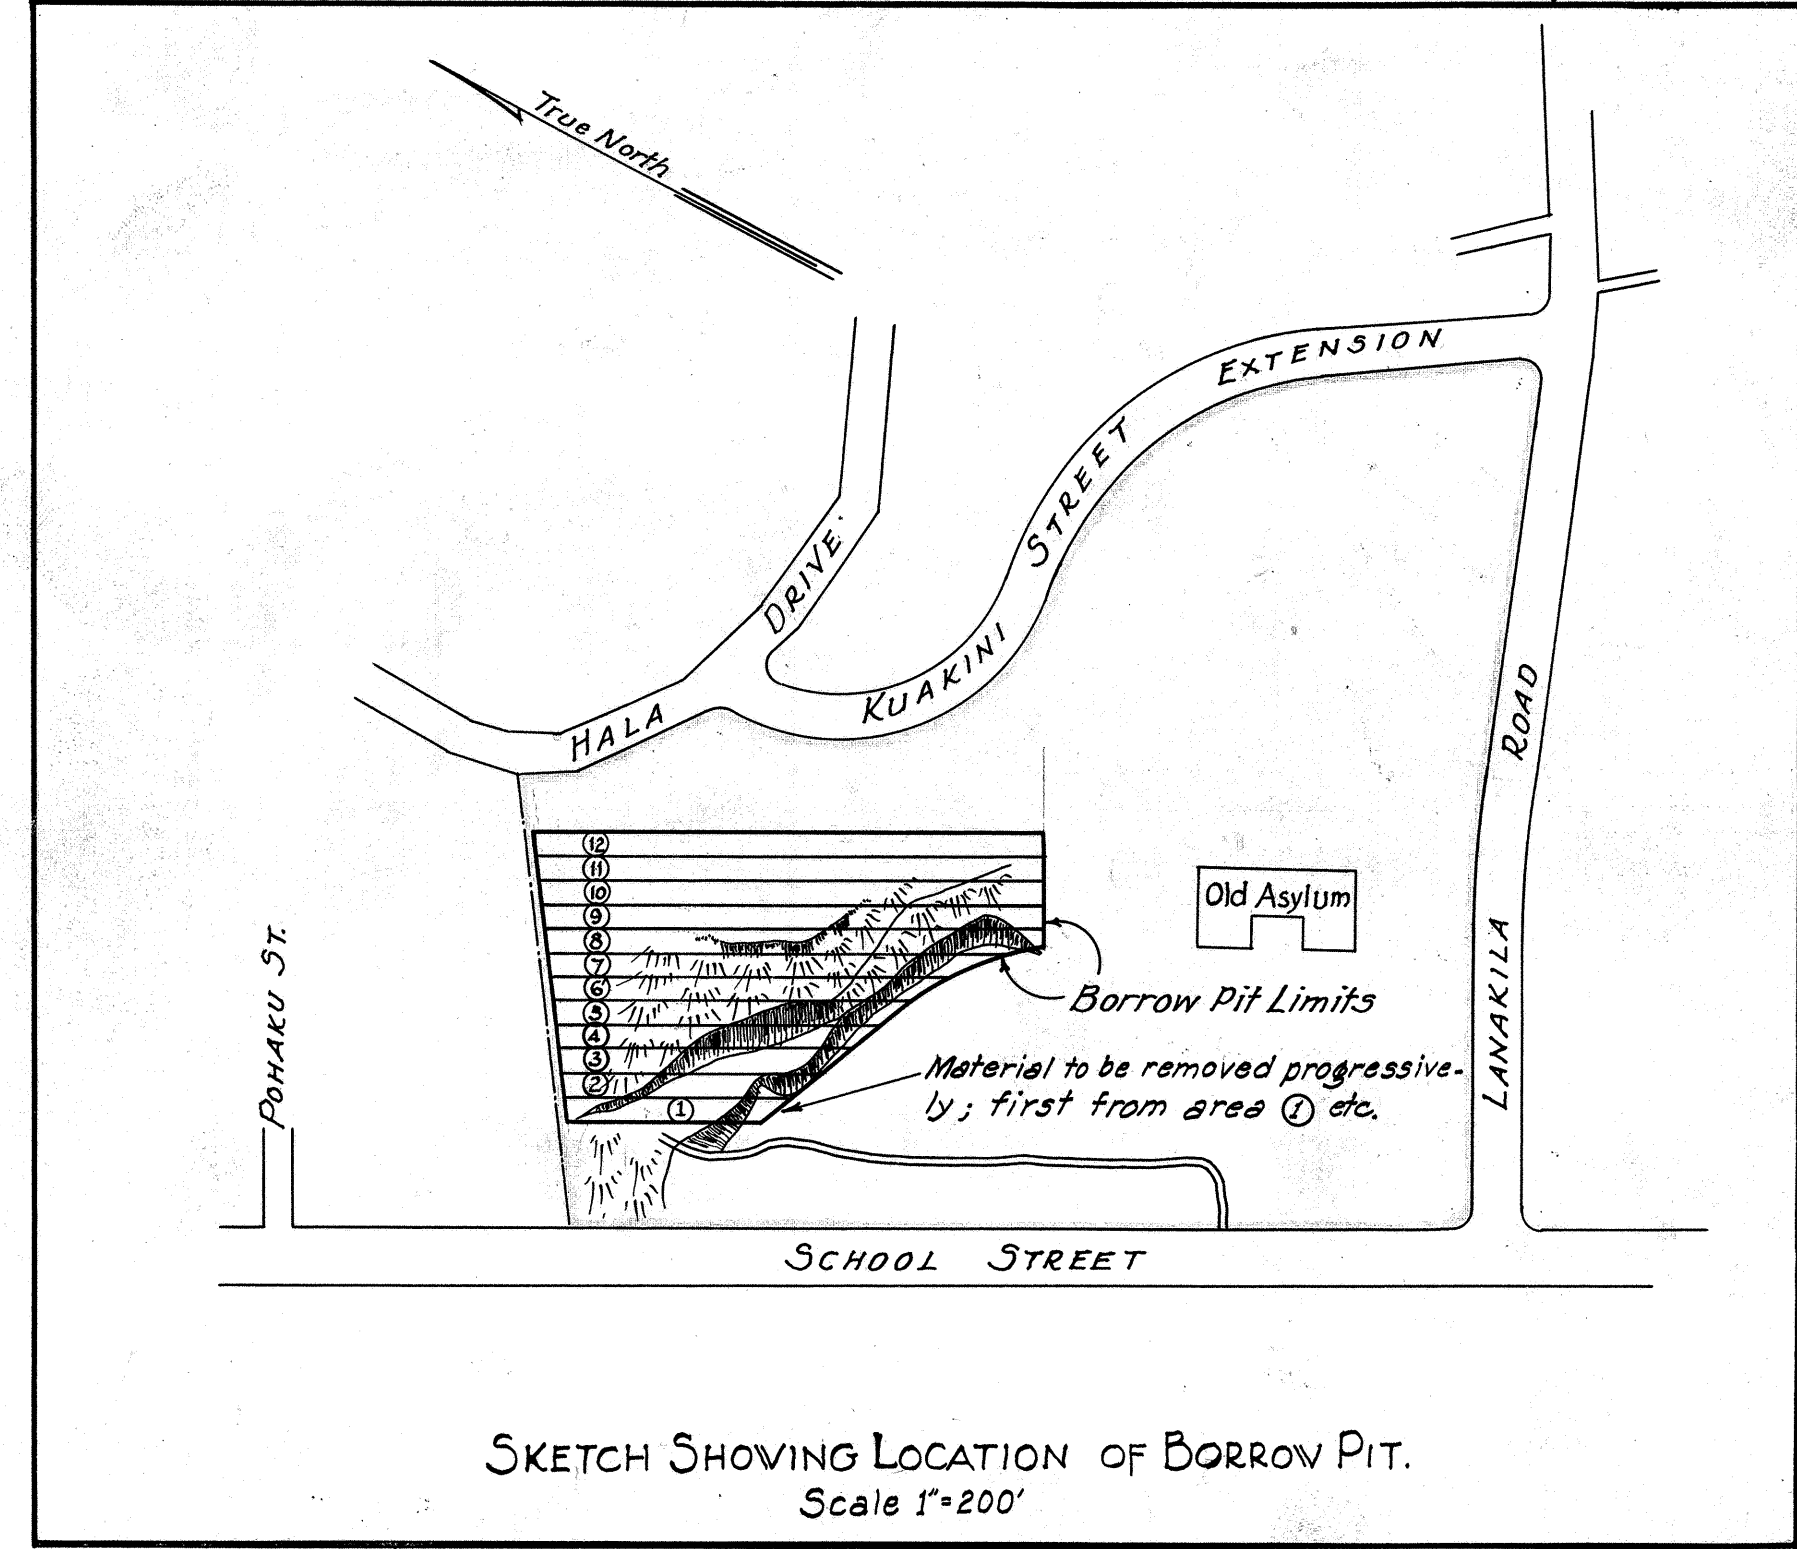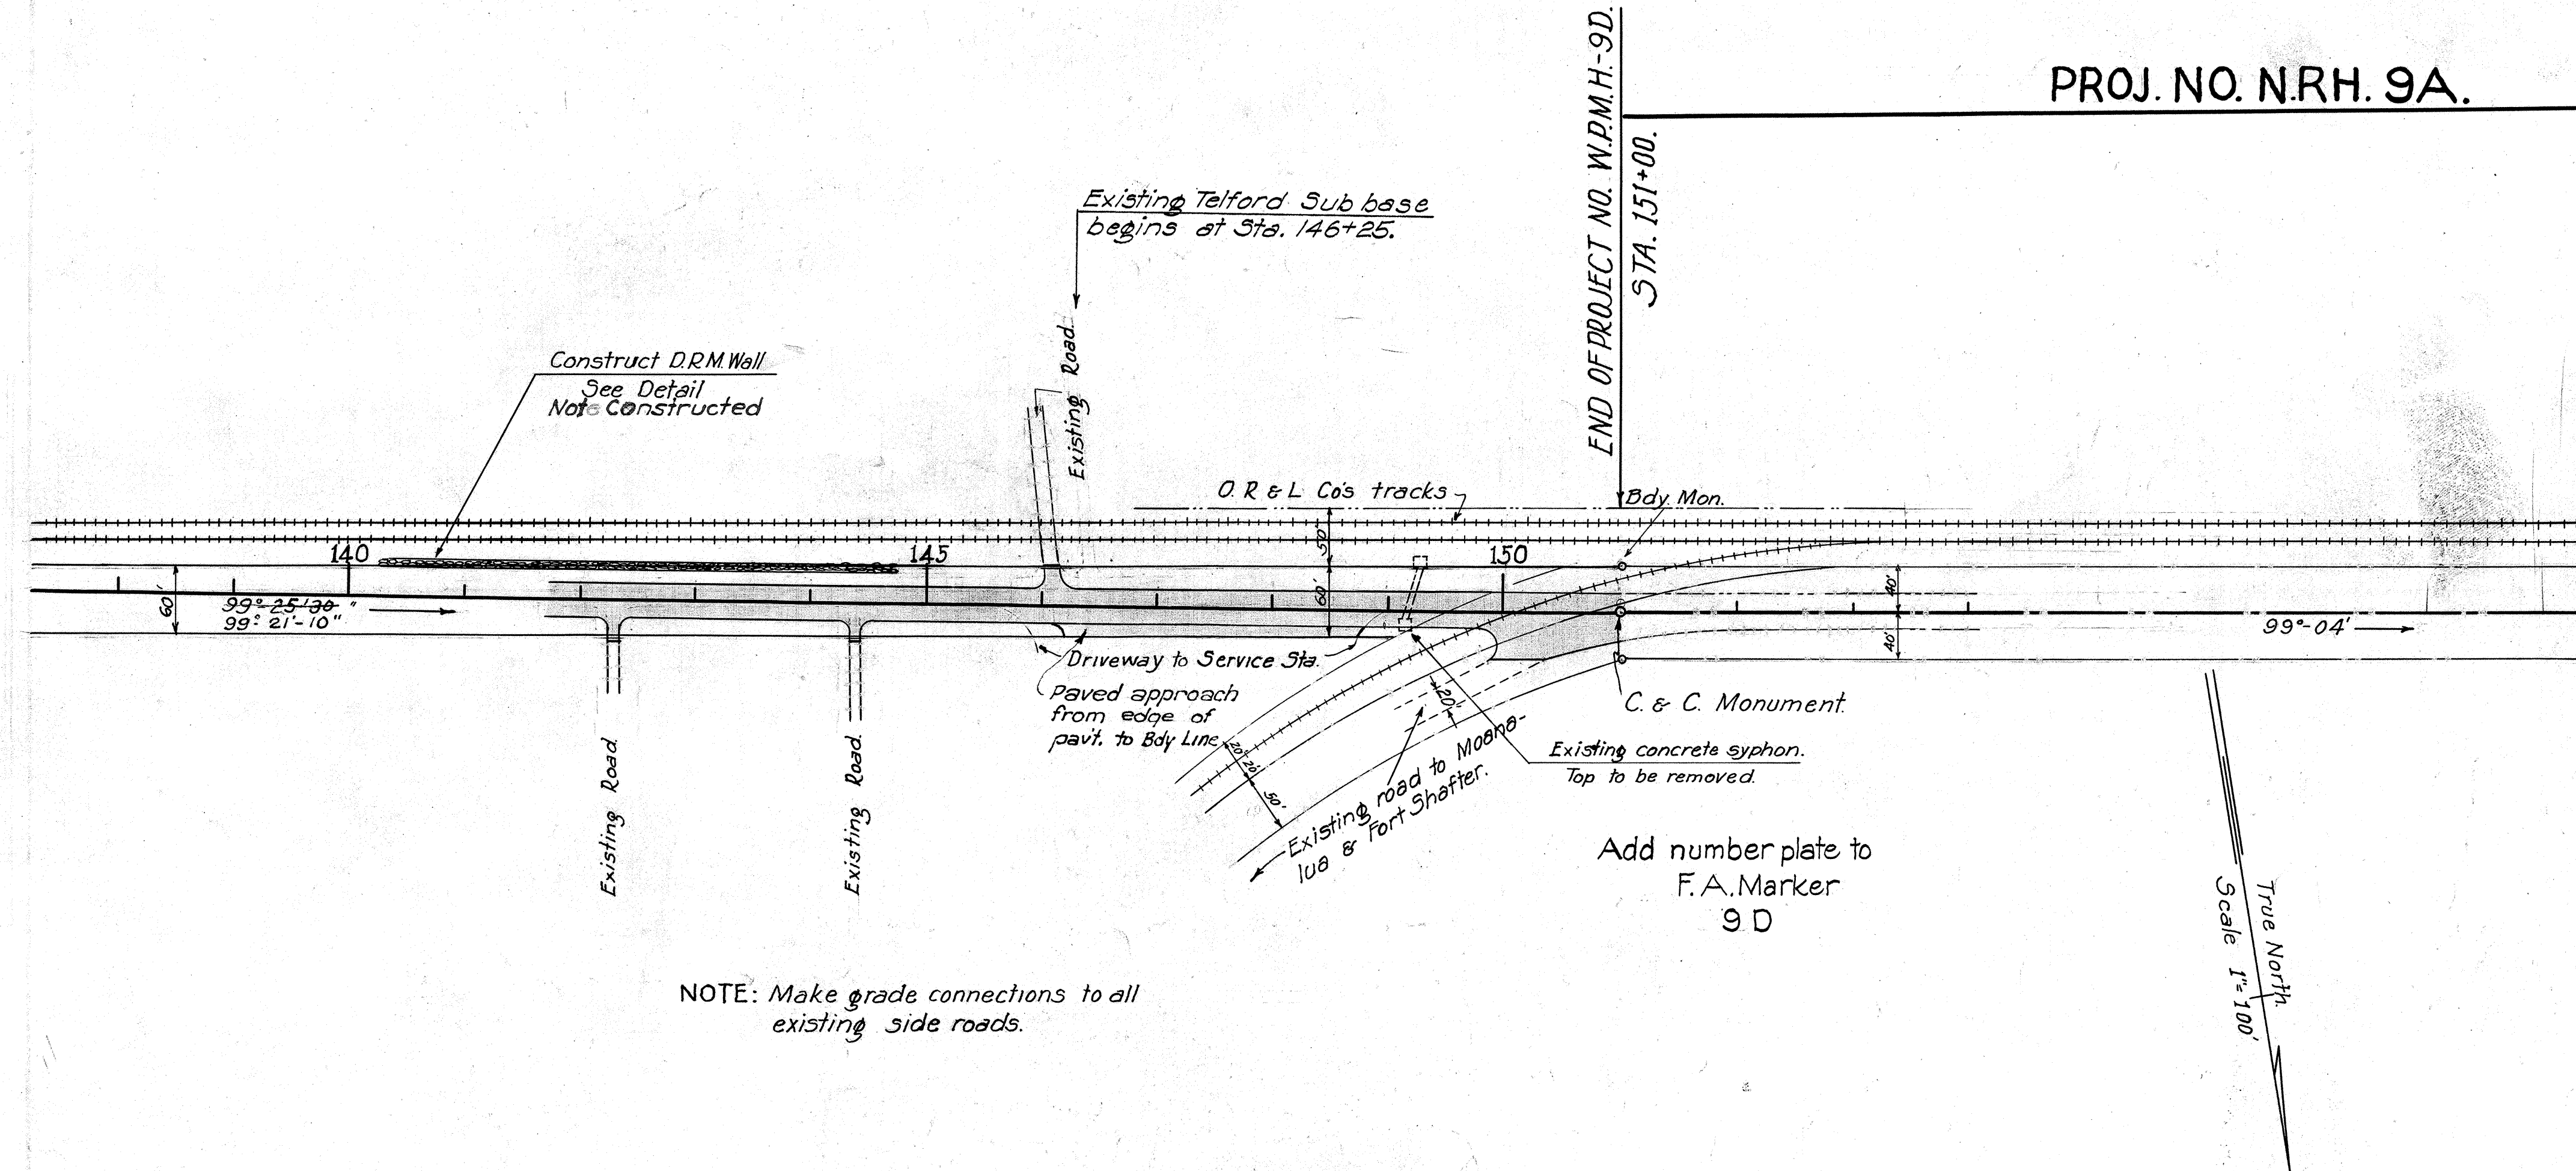

4345.5