


# ALA MOANA BRIDGE

## ACROSS THE

# ALA WAI CANAL

## HONOLULU OAHU, T. H.

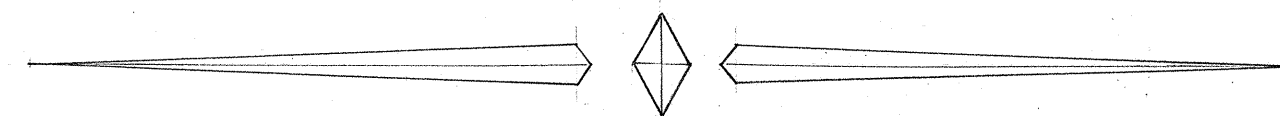

DEPARTMENT OF PUBLIC WORKS  
TERRITORY OF HAWAII

LOUIS S. CAIN  
SUPERINTENDENT OF PUBLIC WORKS

PUBLIC WORKS ADMINISTRATION APPROPRIATION ACT OF 1938

P. W. A. DOCKET NO. T. H. 1039-F  
D. P. W. JOB NO. 4469

APPROVED BY: *Louis S. Cain*  
Superintendent of Public Works

| INDEX     |                                              |
|-----------|----------------------------------------------|
| Sheet No. | Description                                  |
| 1         | Title Sheet                                  |
| 2         | Layout plan, Boring data, General notes      |
| 3         | Abutment & Girder details                    |
| 4         | Pier & Cross beam details                    |
| 5         | Deck plan                                    |
| 6         | Staircase & Approach details                 |
| 7         | Detail of 12" water main, Profile of roadway |
| 8         | Pile details, railing details                |
| 9         | Detail of 2'-0" x 2'-0" x 3'-0" conc. rocker |

SHEET NO. 1 OF 9 SHEETS.

4469.1