
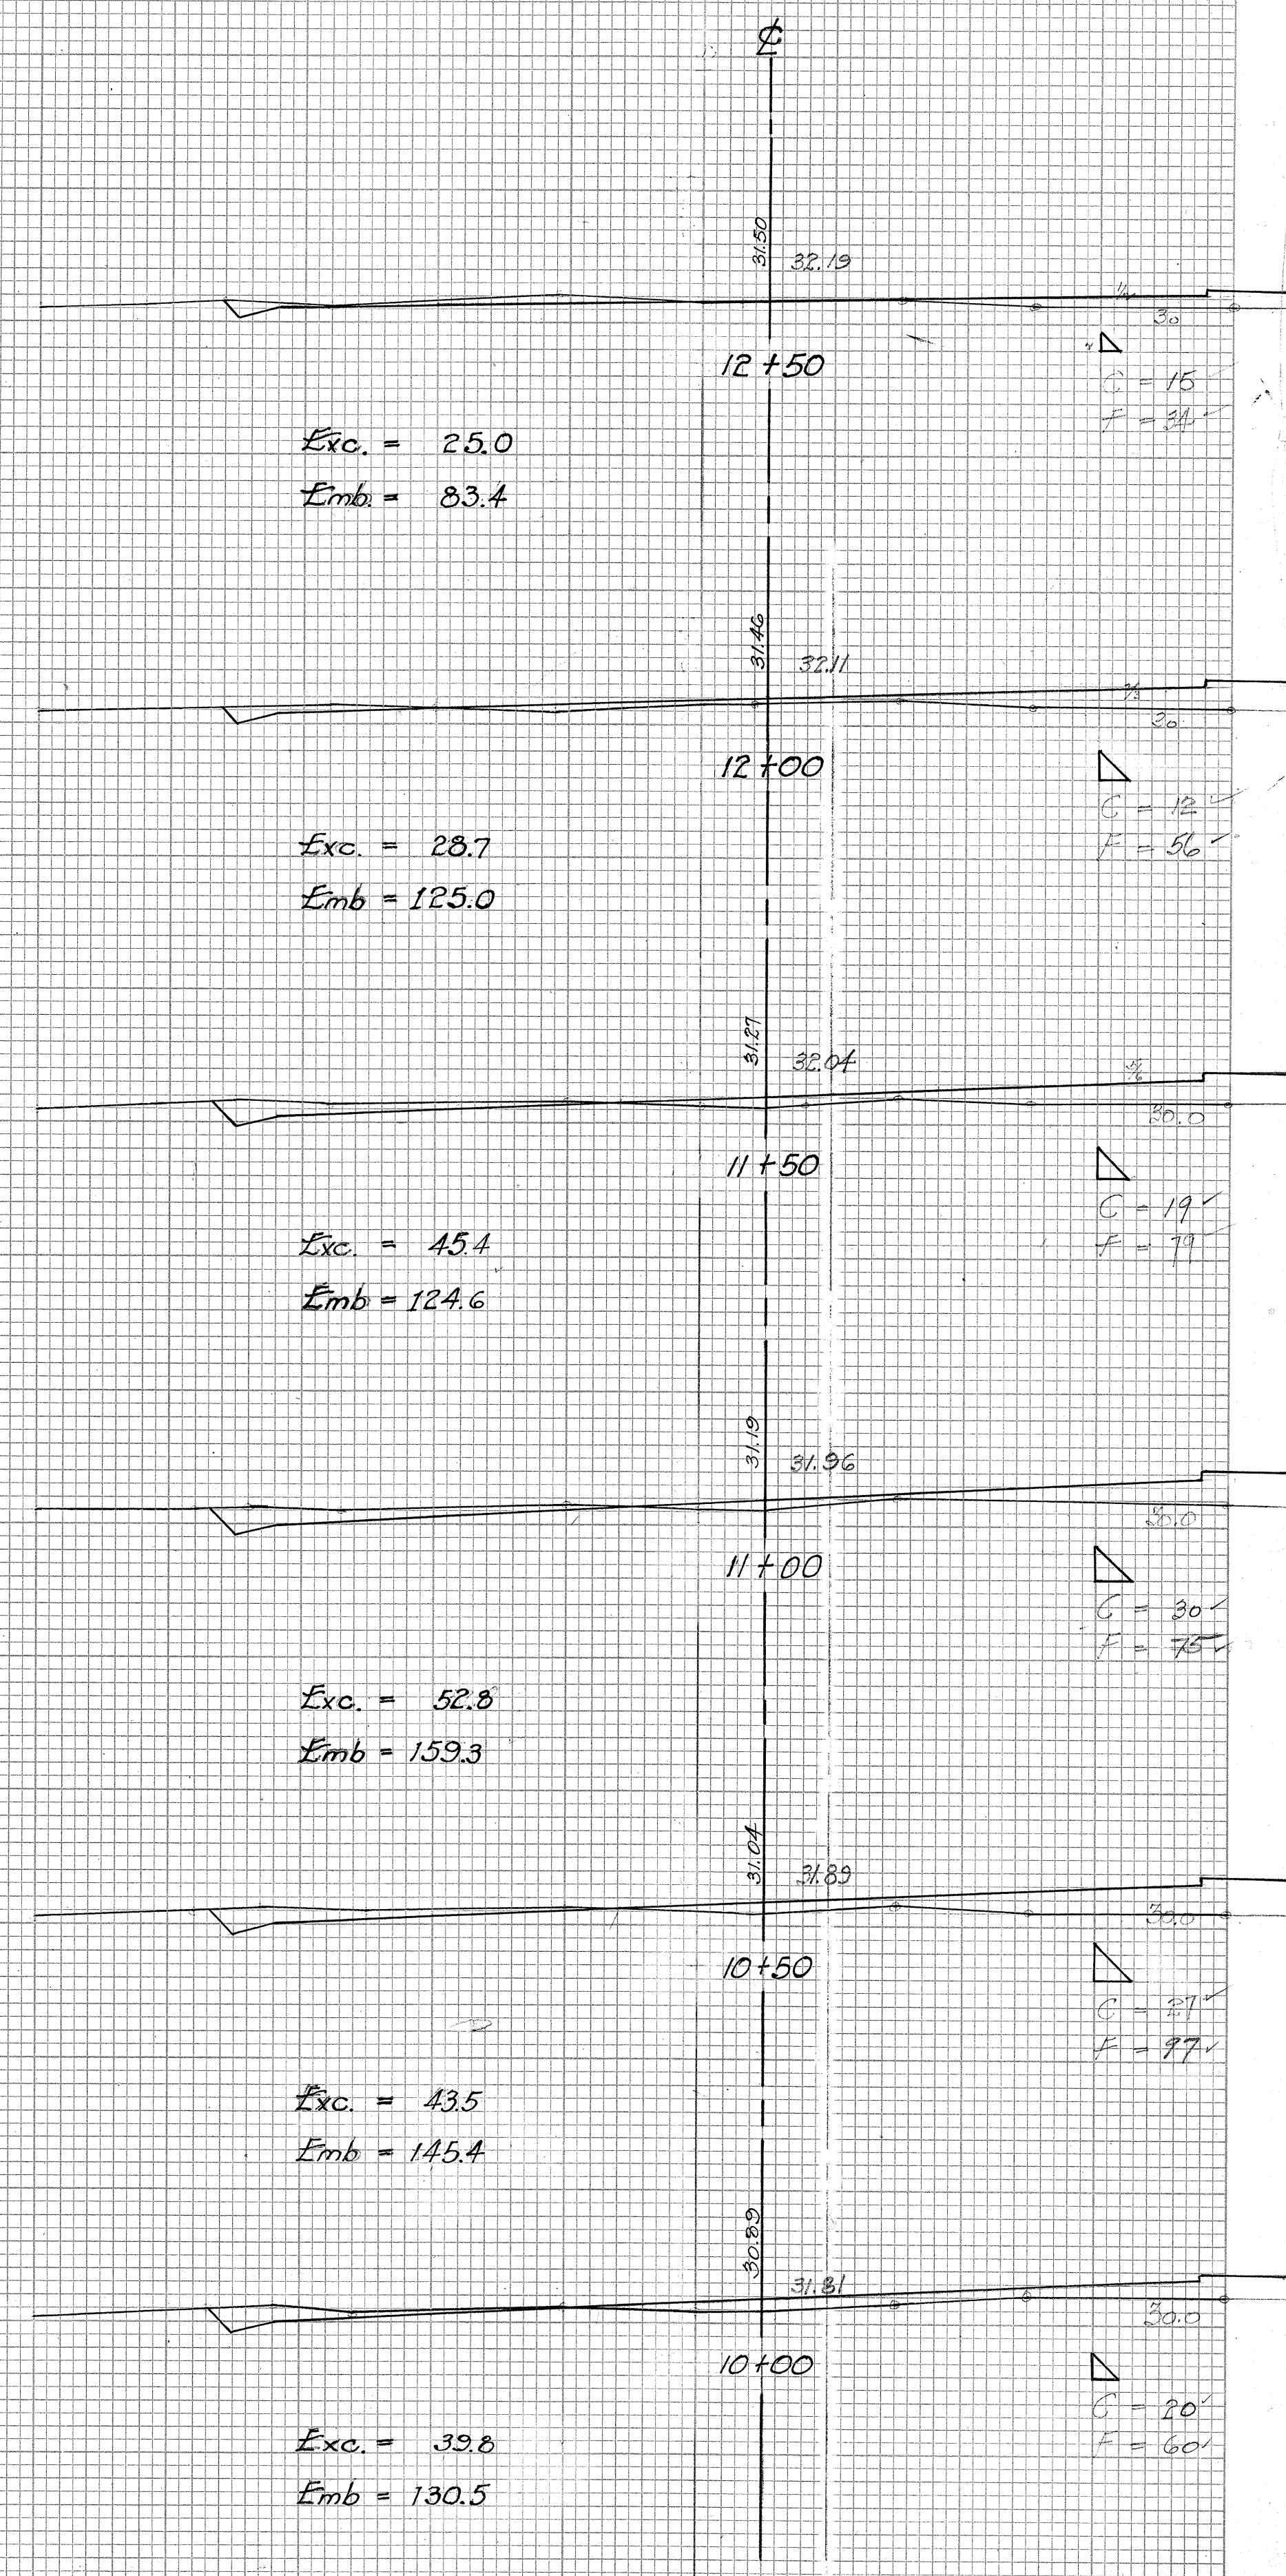
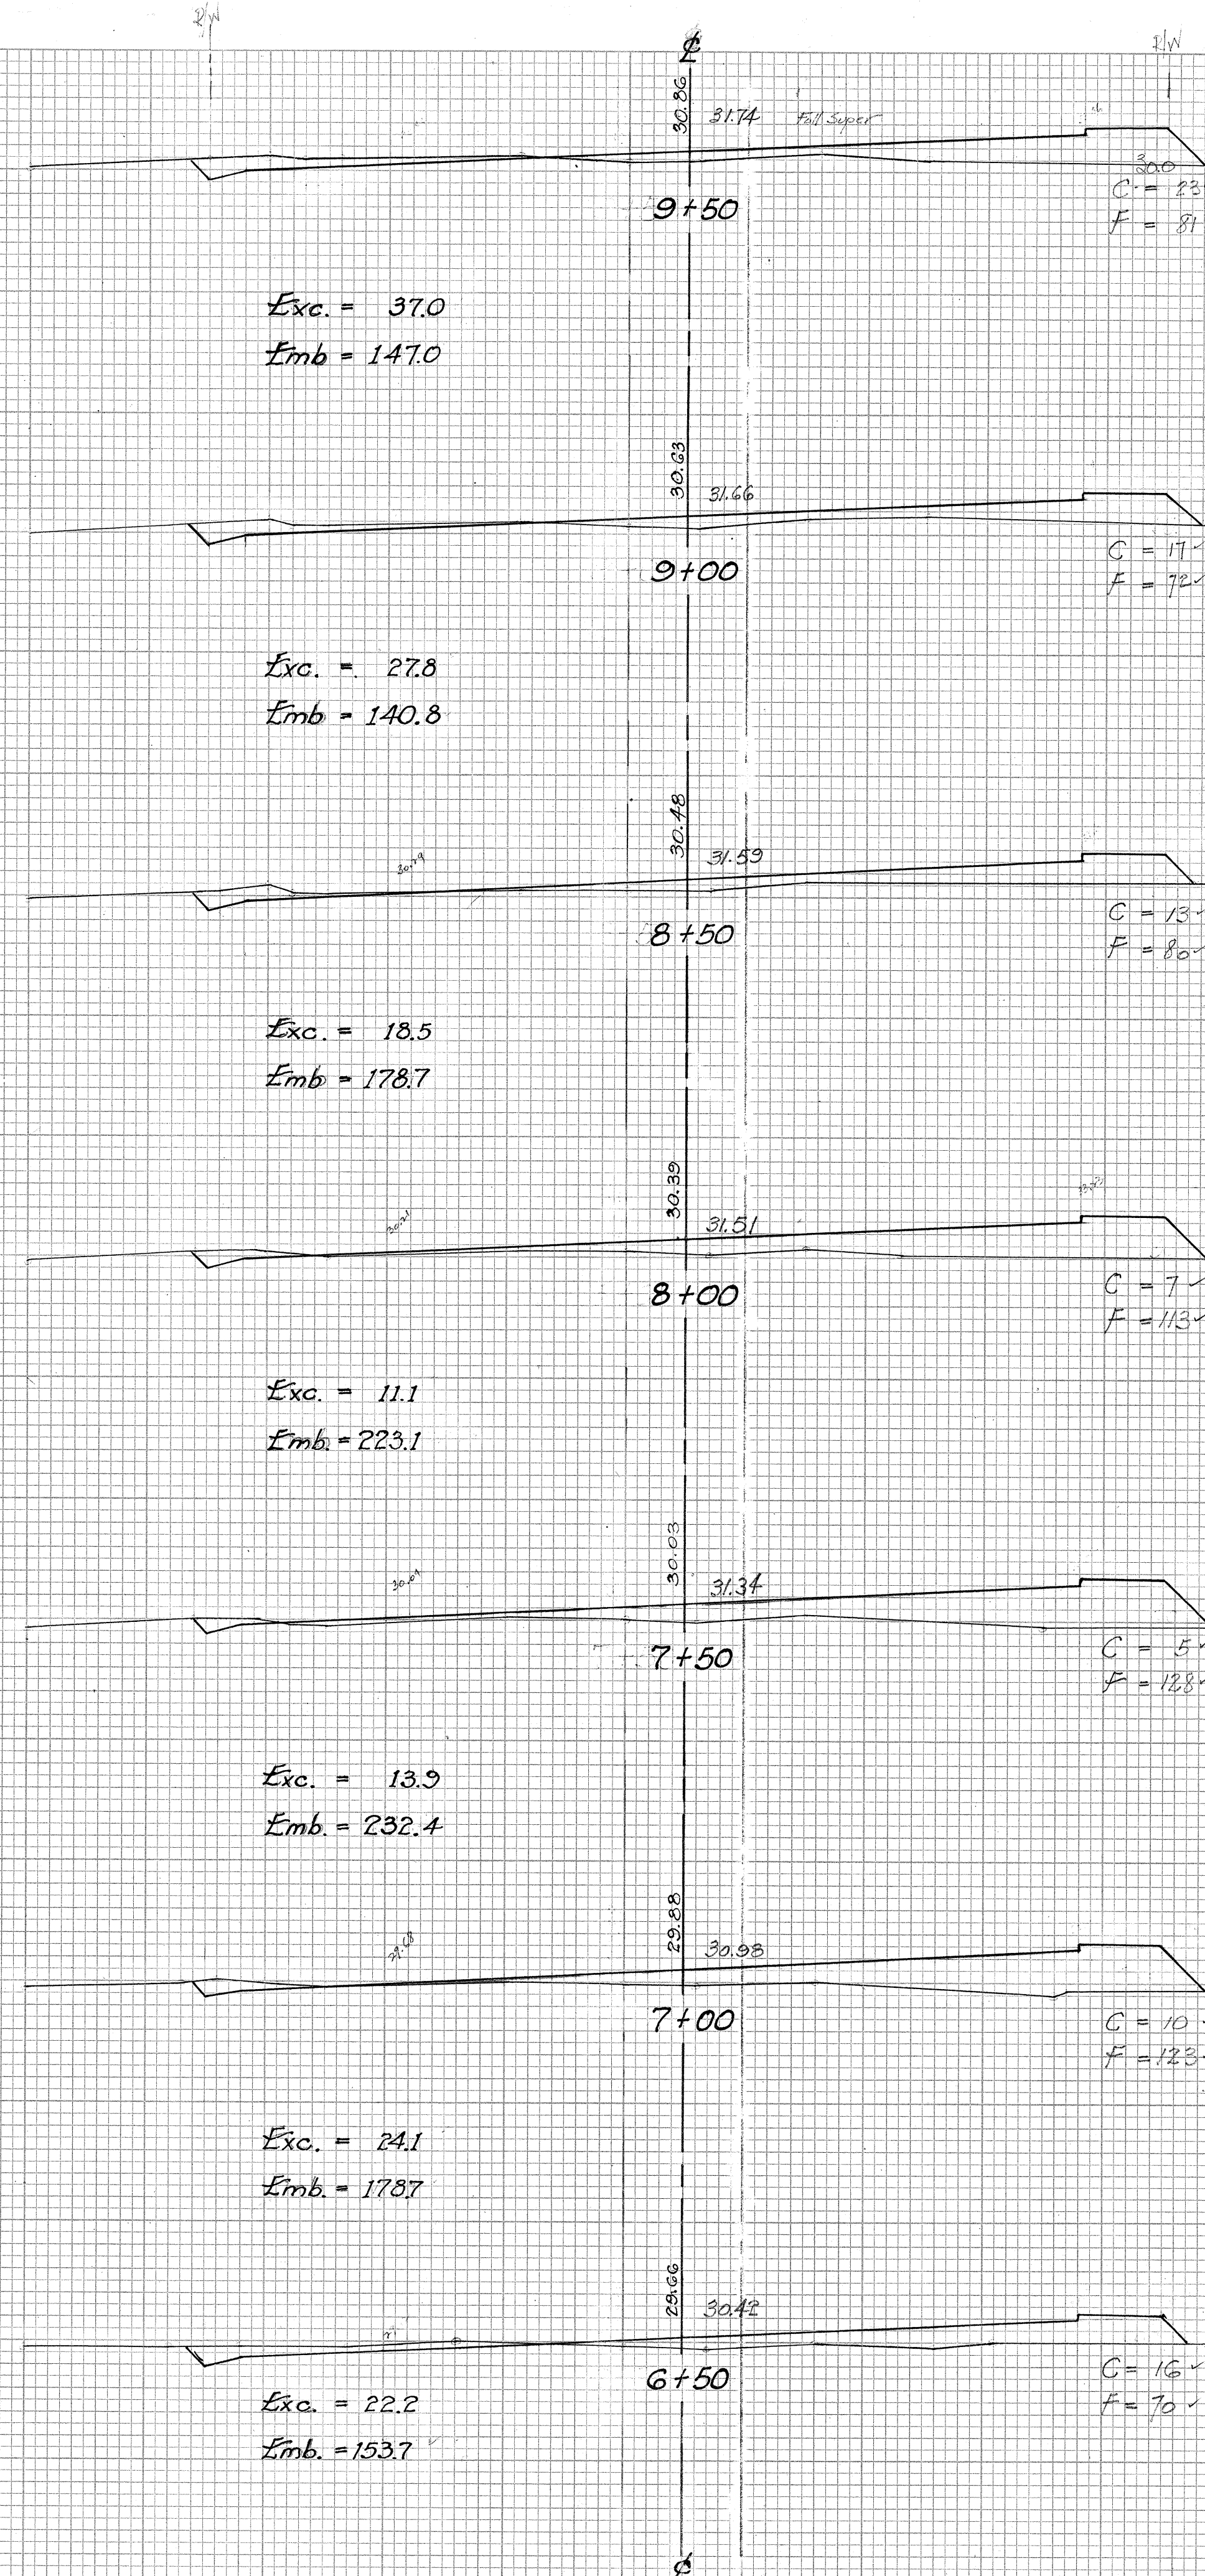


FINAL	SURVEYED	DATE
SURVEY	BY	
NOTE BOOK	PLOTTED	
NO.	TEMPERATURE	
	AREAS CHECKED	

ORIGINAL	SURVEYED	DATE
SURVEY	BY	
NOTE BOOK	PLOTTED	
NO.	TEMPERATURE	
	AREAS CHECKED	




FED. ROAD DIST. NO.	STATE	FED. AID PROJ. NO.	FISCAL YEAR	SHEET NO.	TOTAL SHEETS
HAWAII	HAW.	SNAP'S (8)	1940	10	16

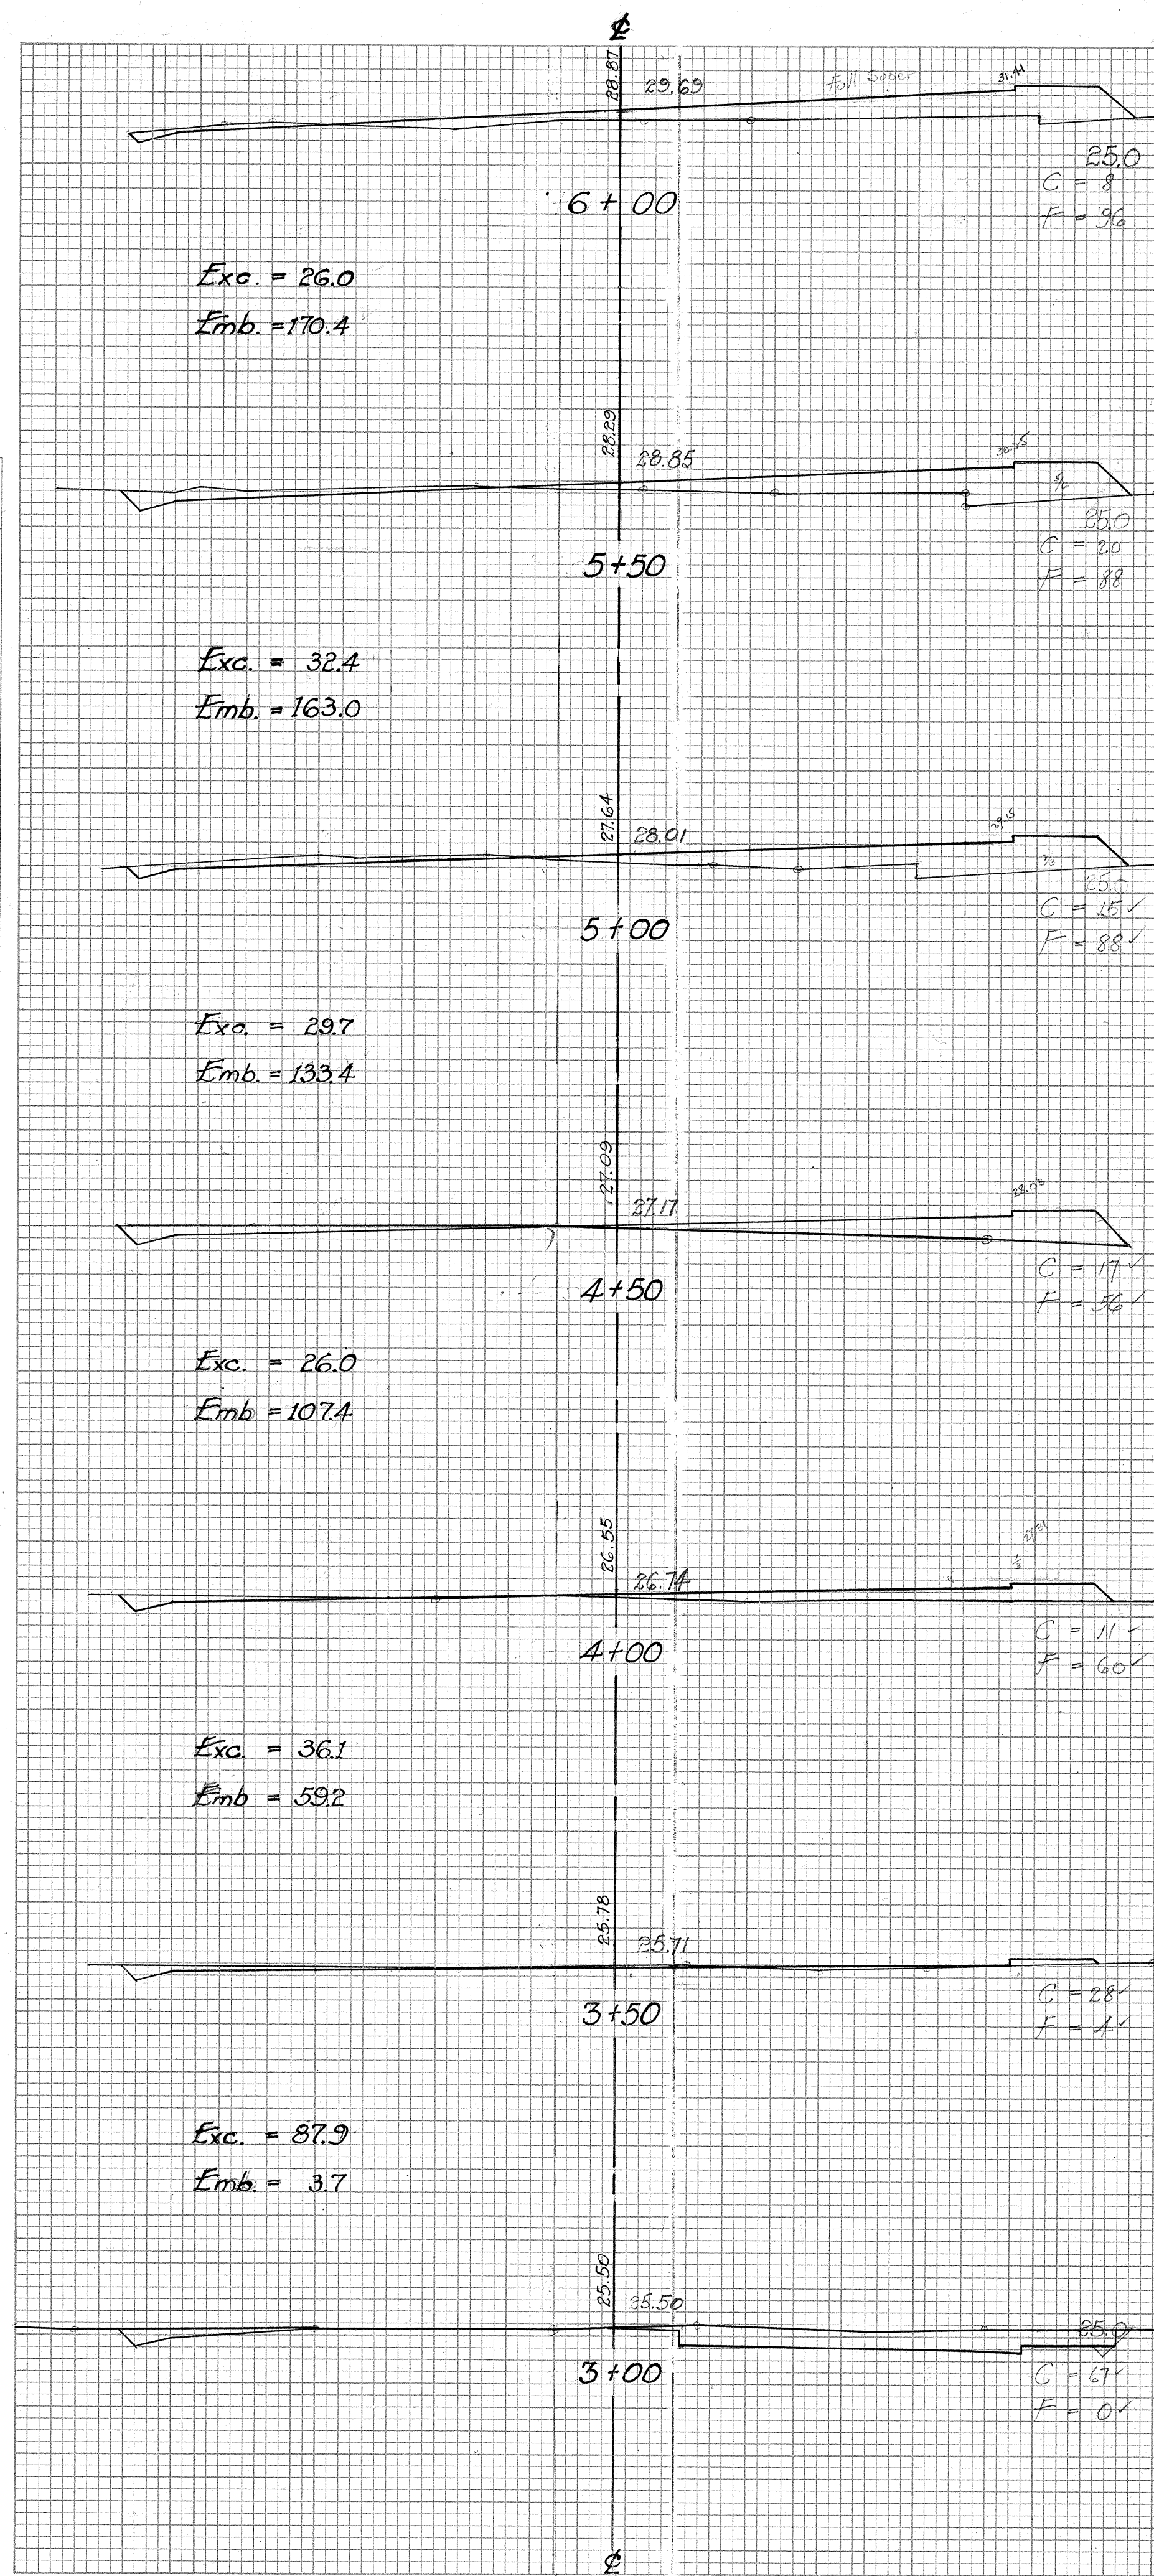

FINAL	SURVEYED	DATE
SURVEY	BY	
NOTE BOOK	PLANNED	
NO.	AREAS CHECKED	


ORIGINAL	SURVEYED	DATE
SURVEY	BY	
NOTE BOOK	PLANNED	
NO.	AREAS CHECKED	

FED. ROAD DIST. NO.	STATE	FED. AID PROJ. NO.	FISCAL YEAR	SHEET NO.	TOTAL SHEETS
HAWAII	HAWAII	5N-TAPS	1940	11	16

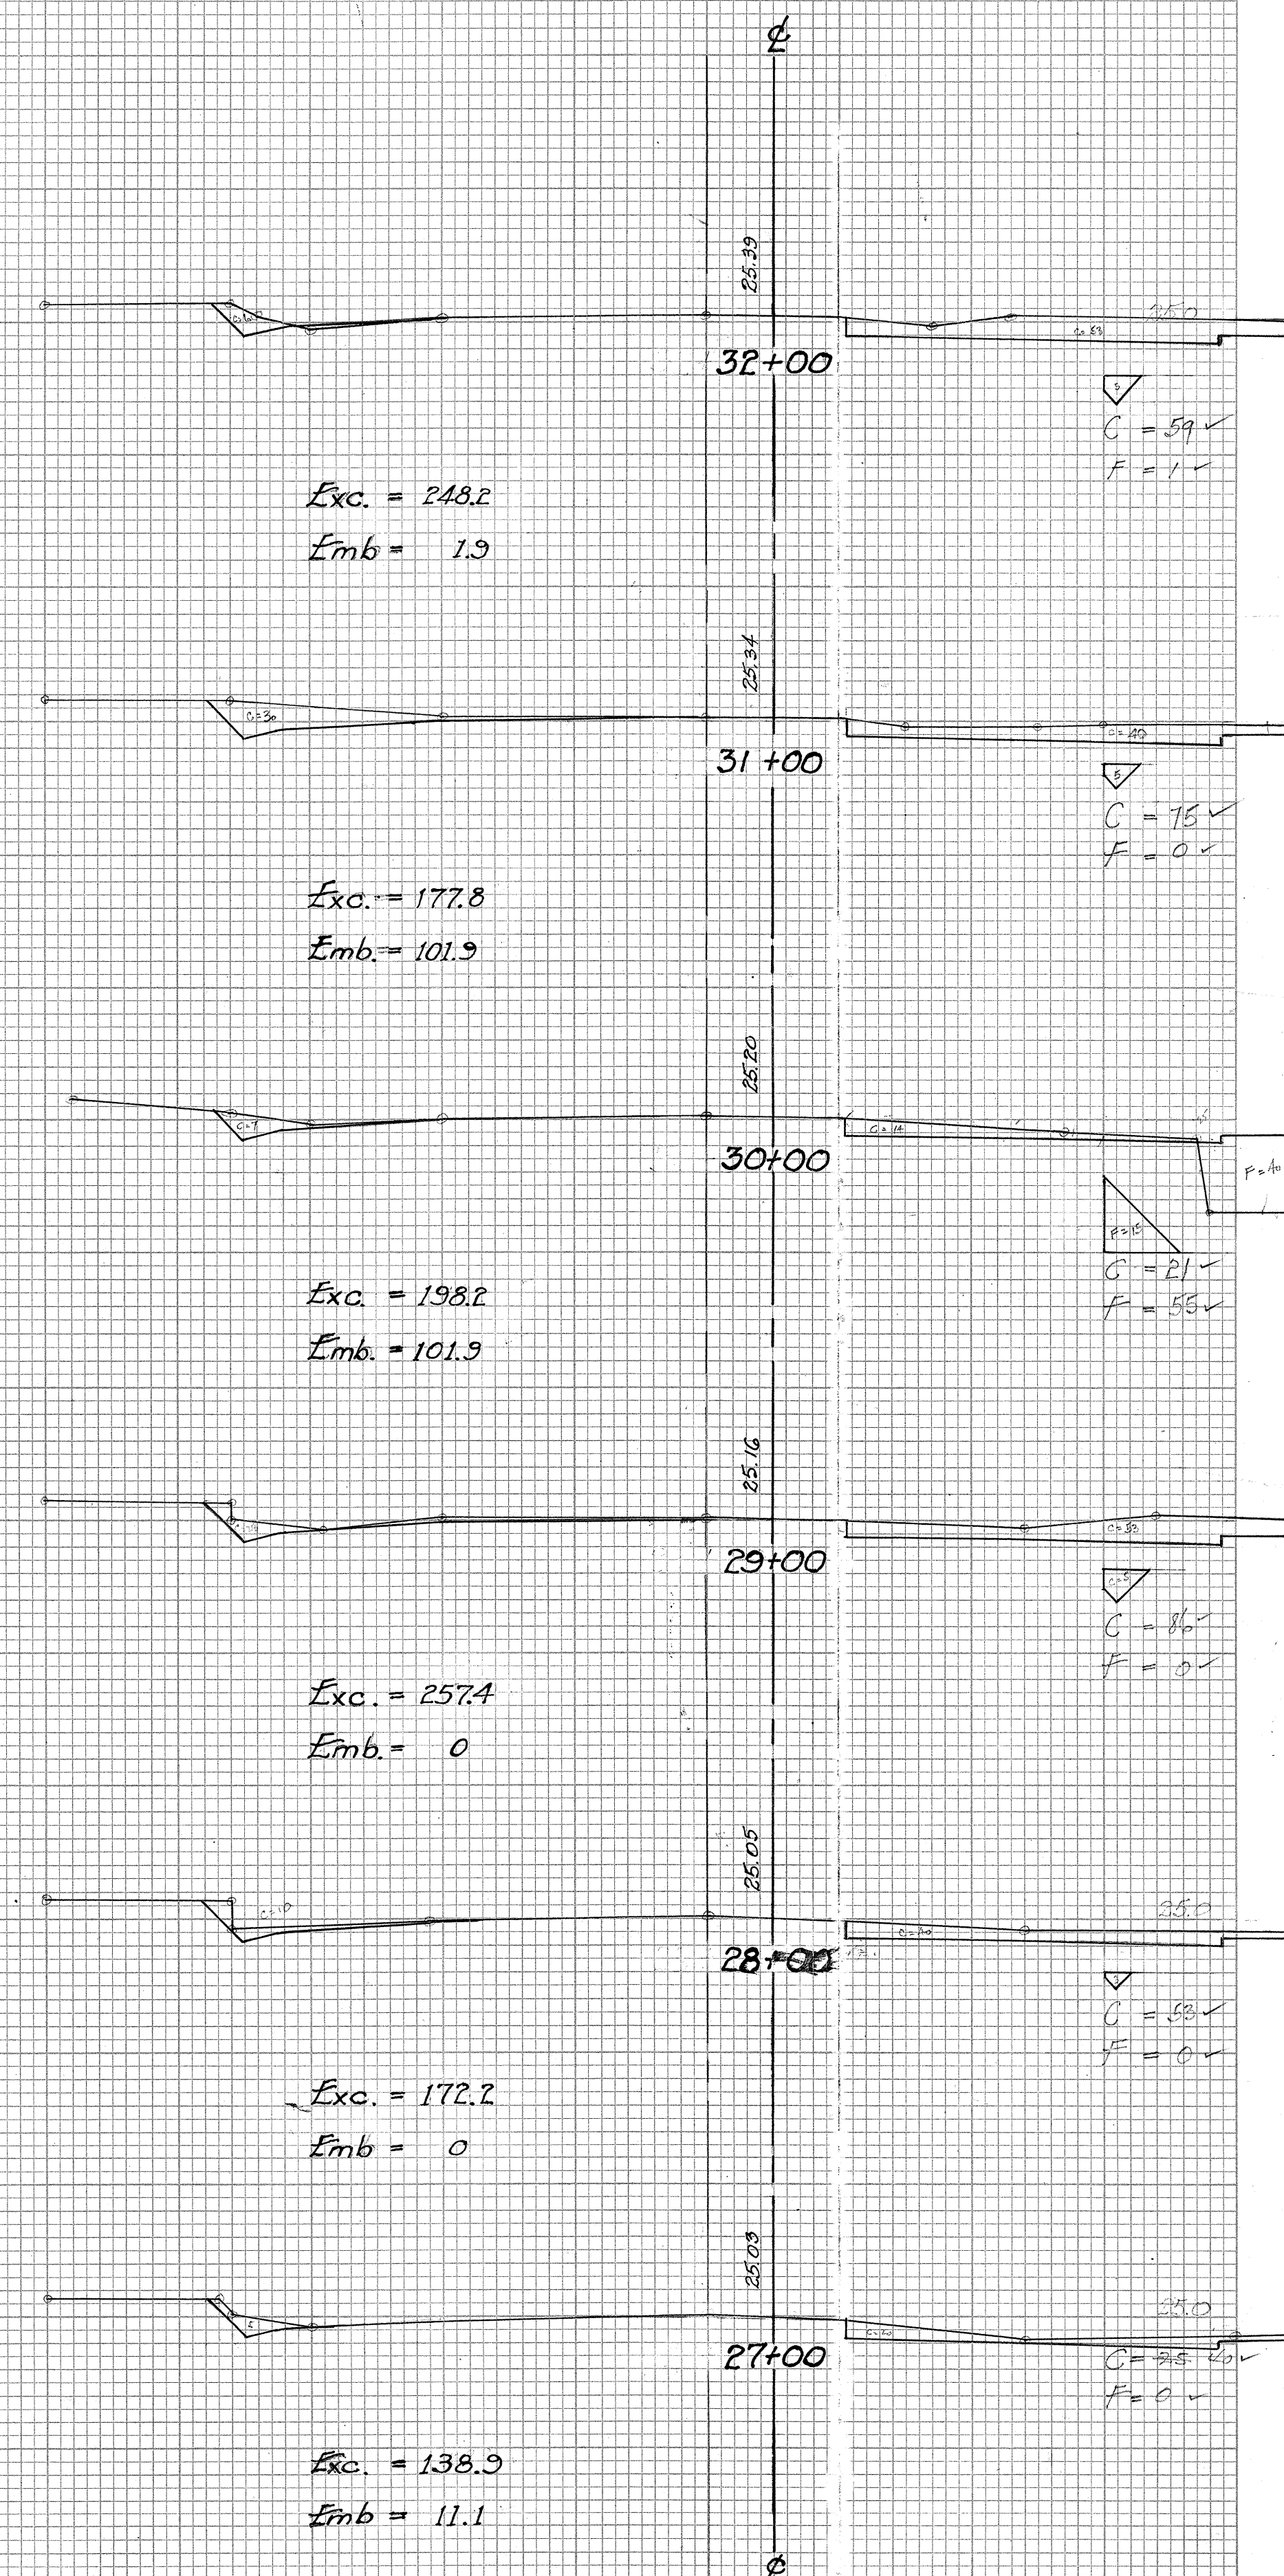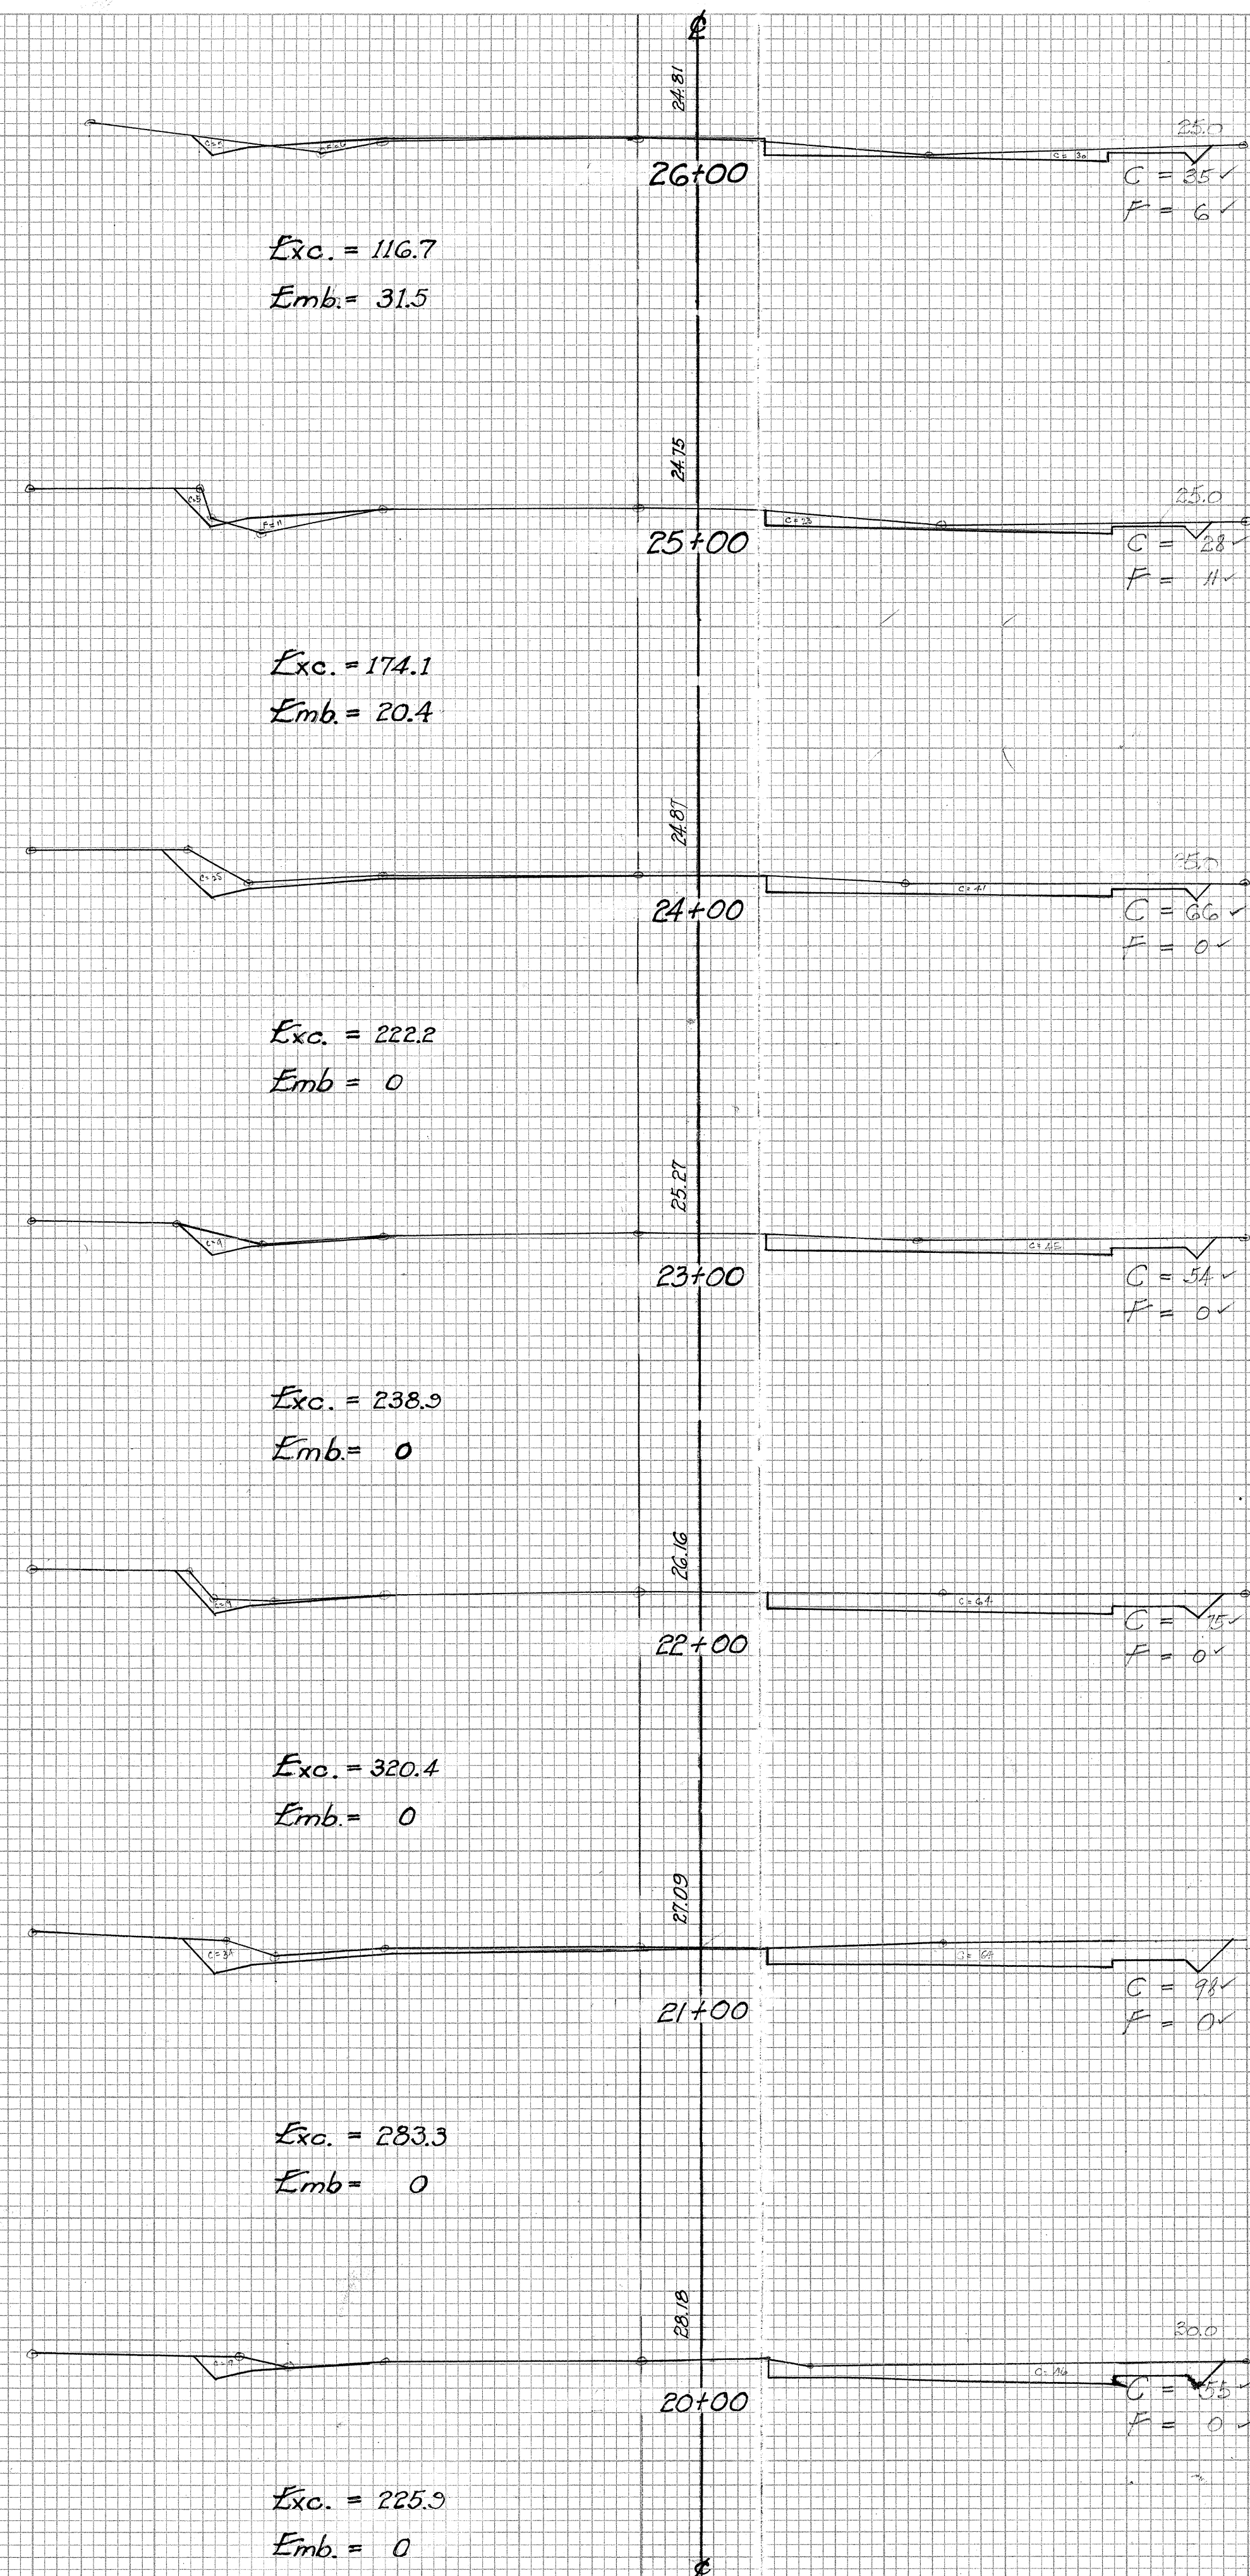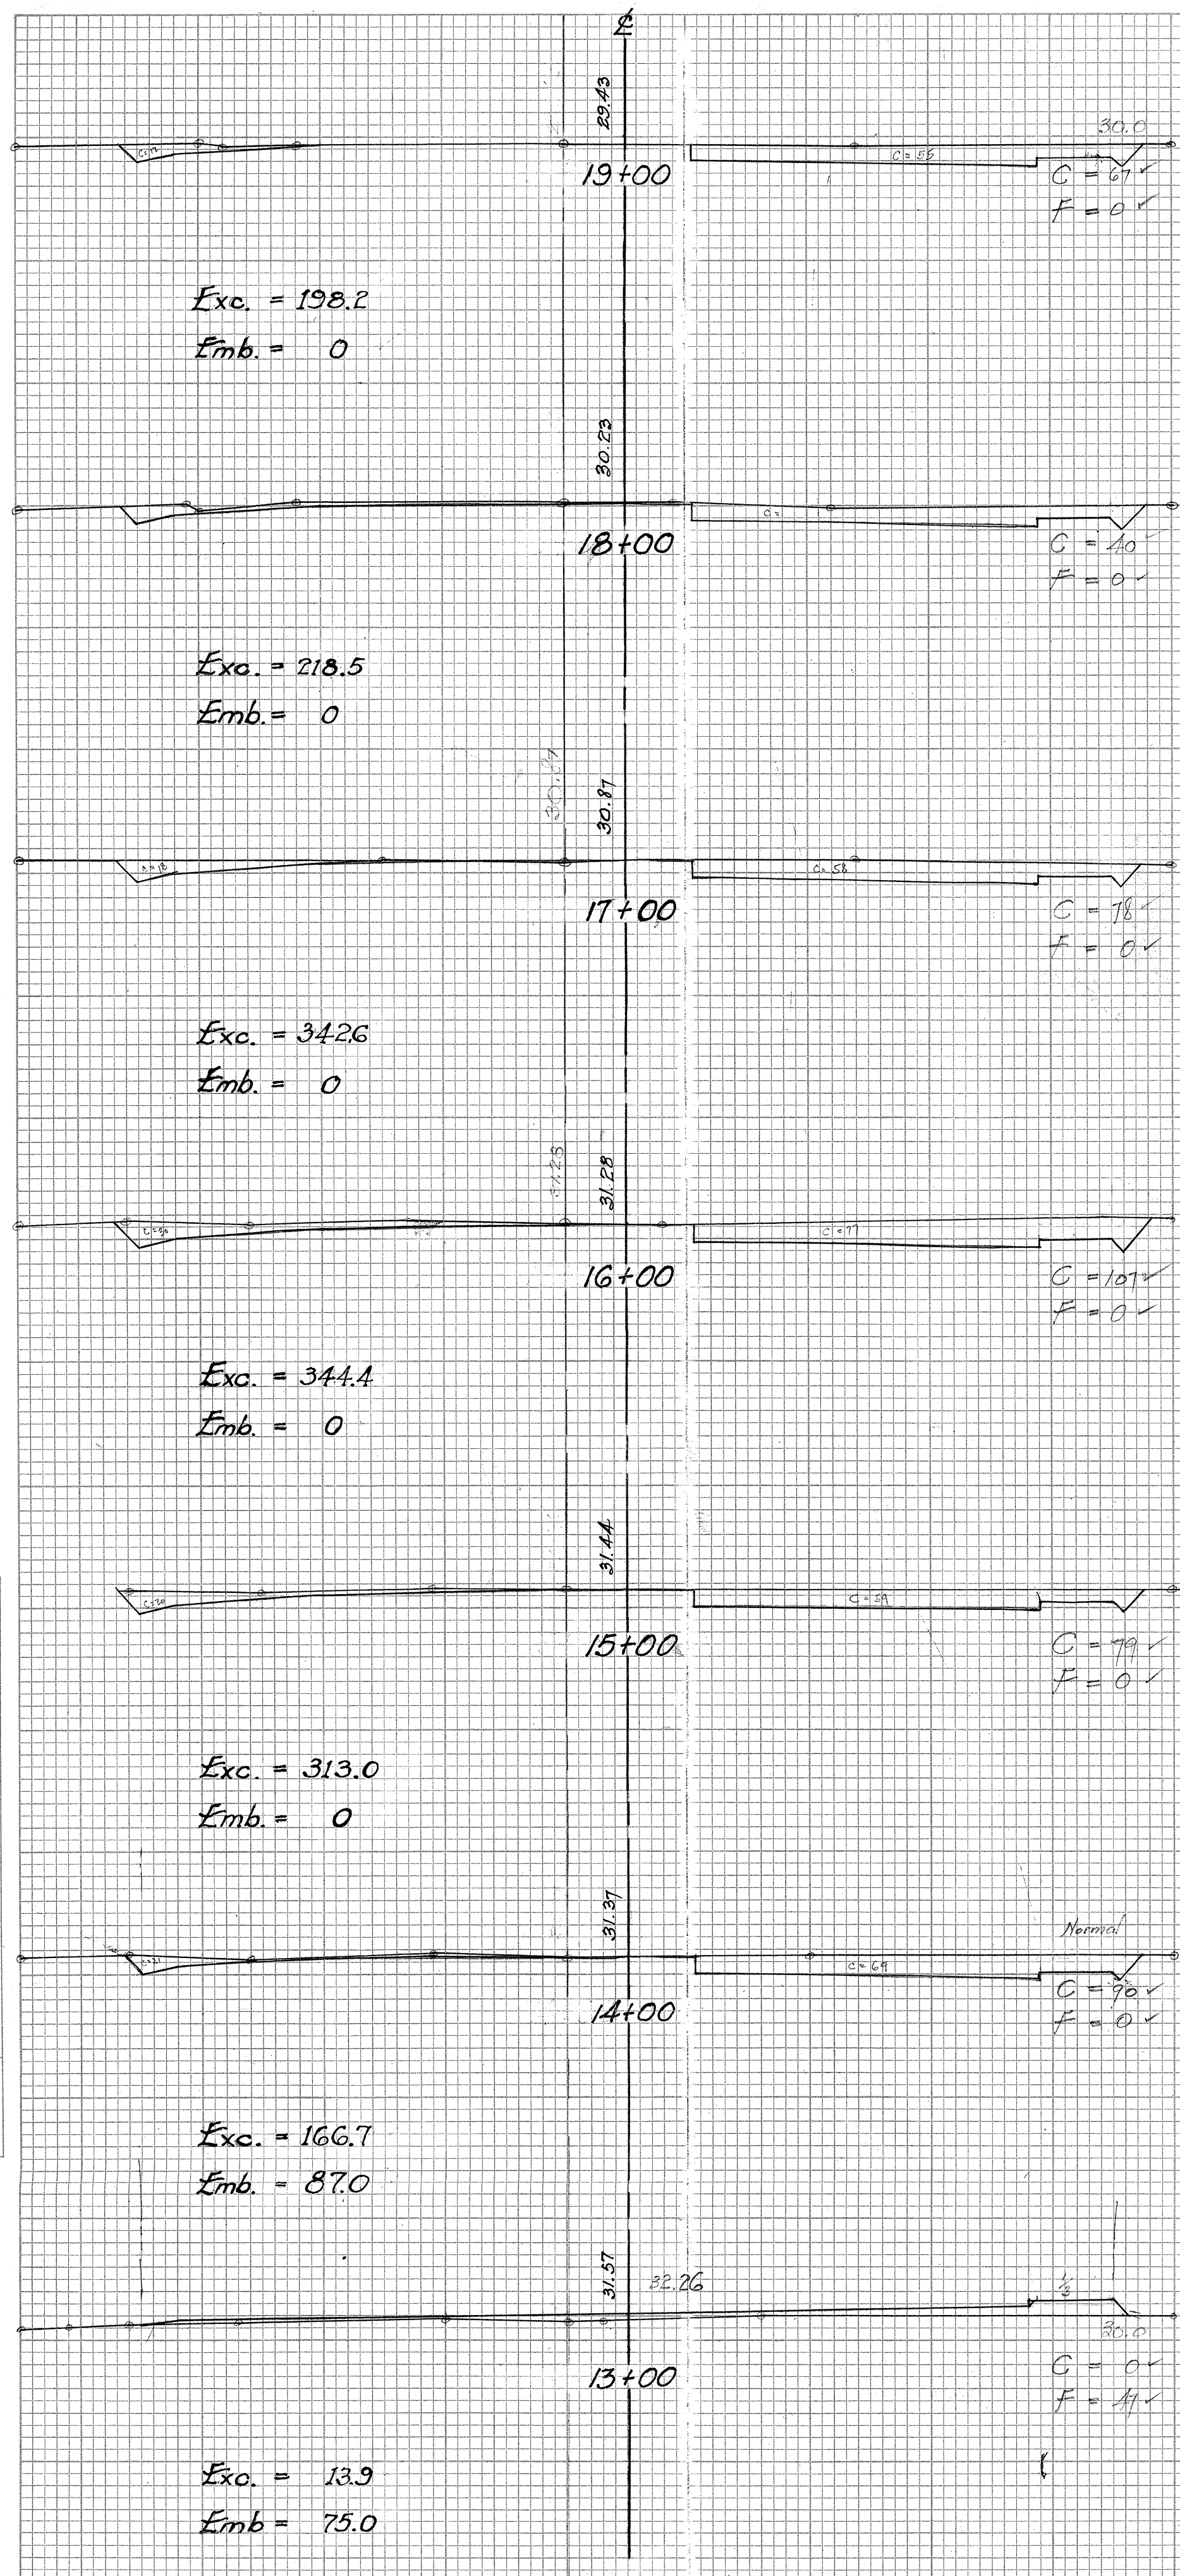

FINAL SURVEY	DATE	BY
NO.		


ORIGINAL SURVEY	DATE	BY
NO.		

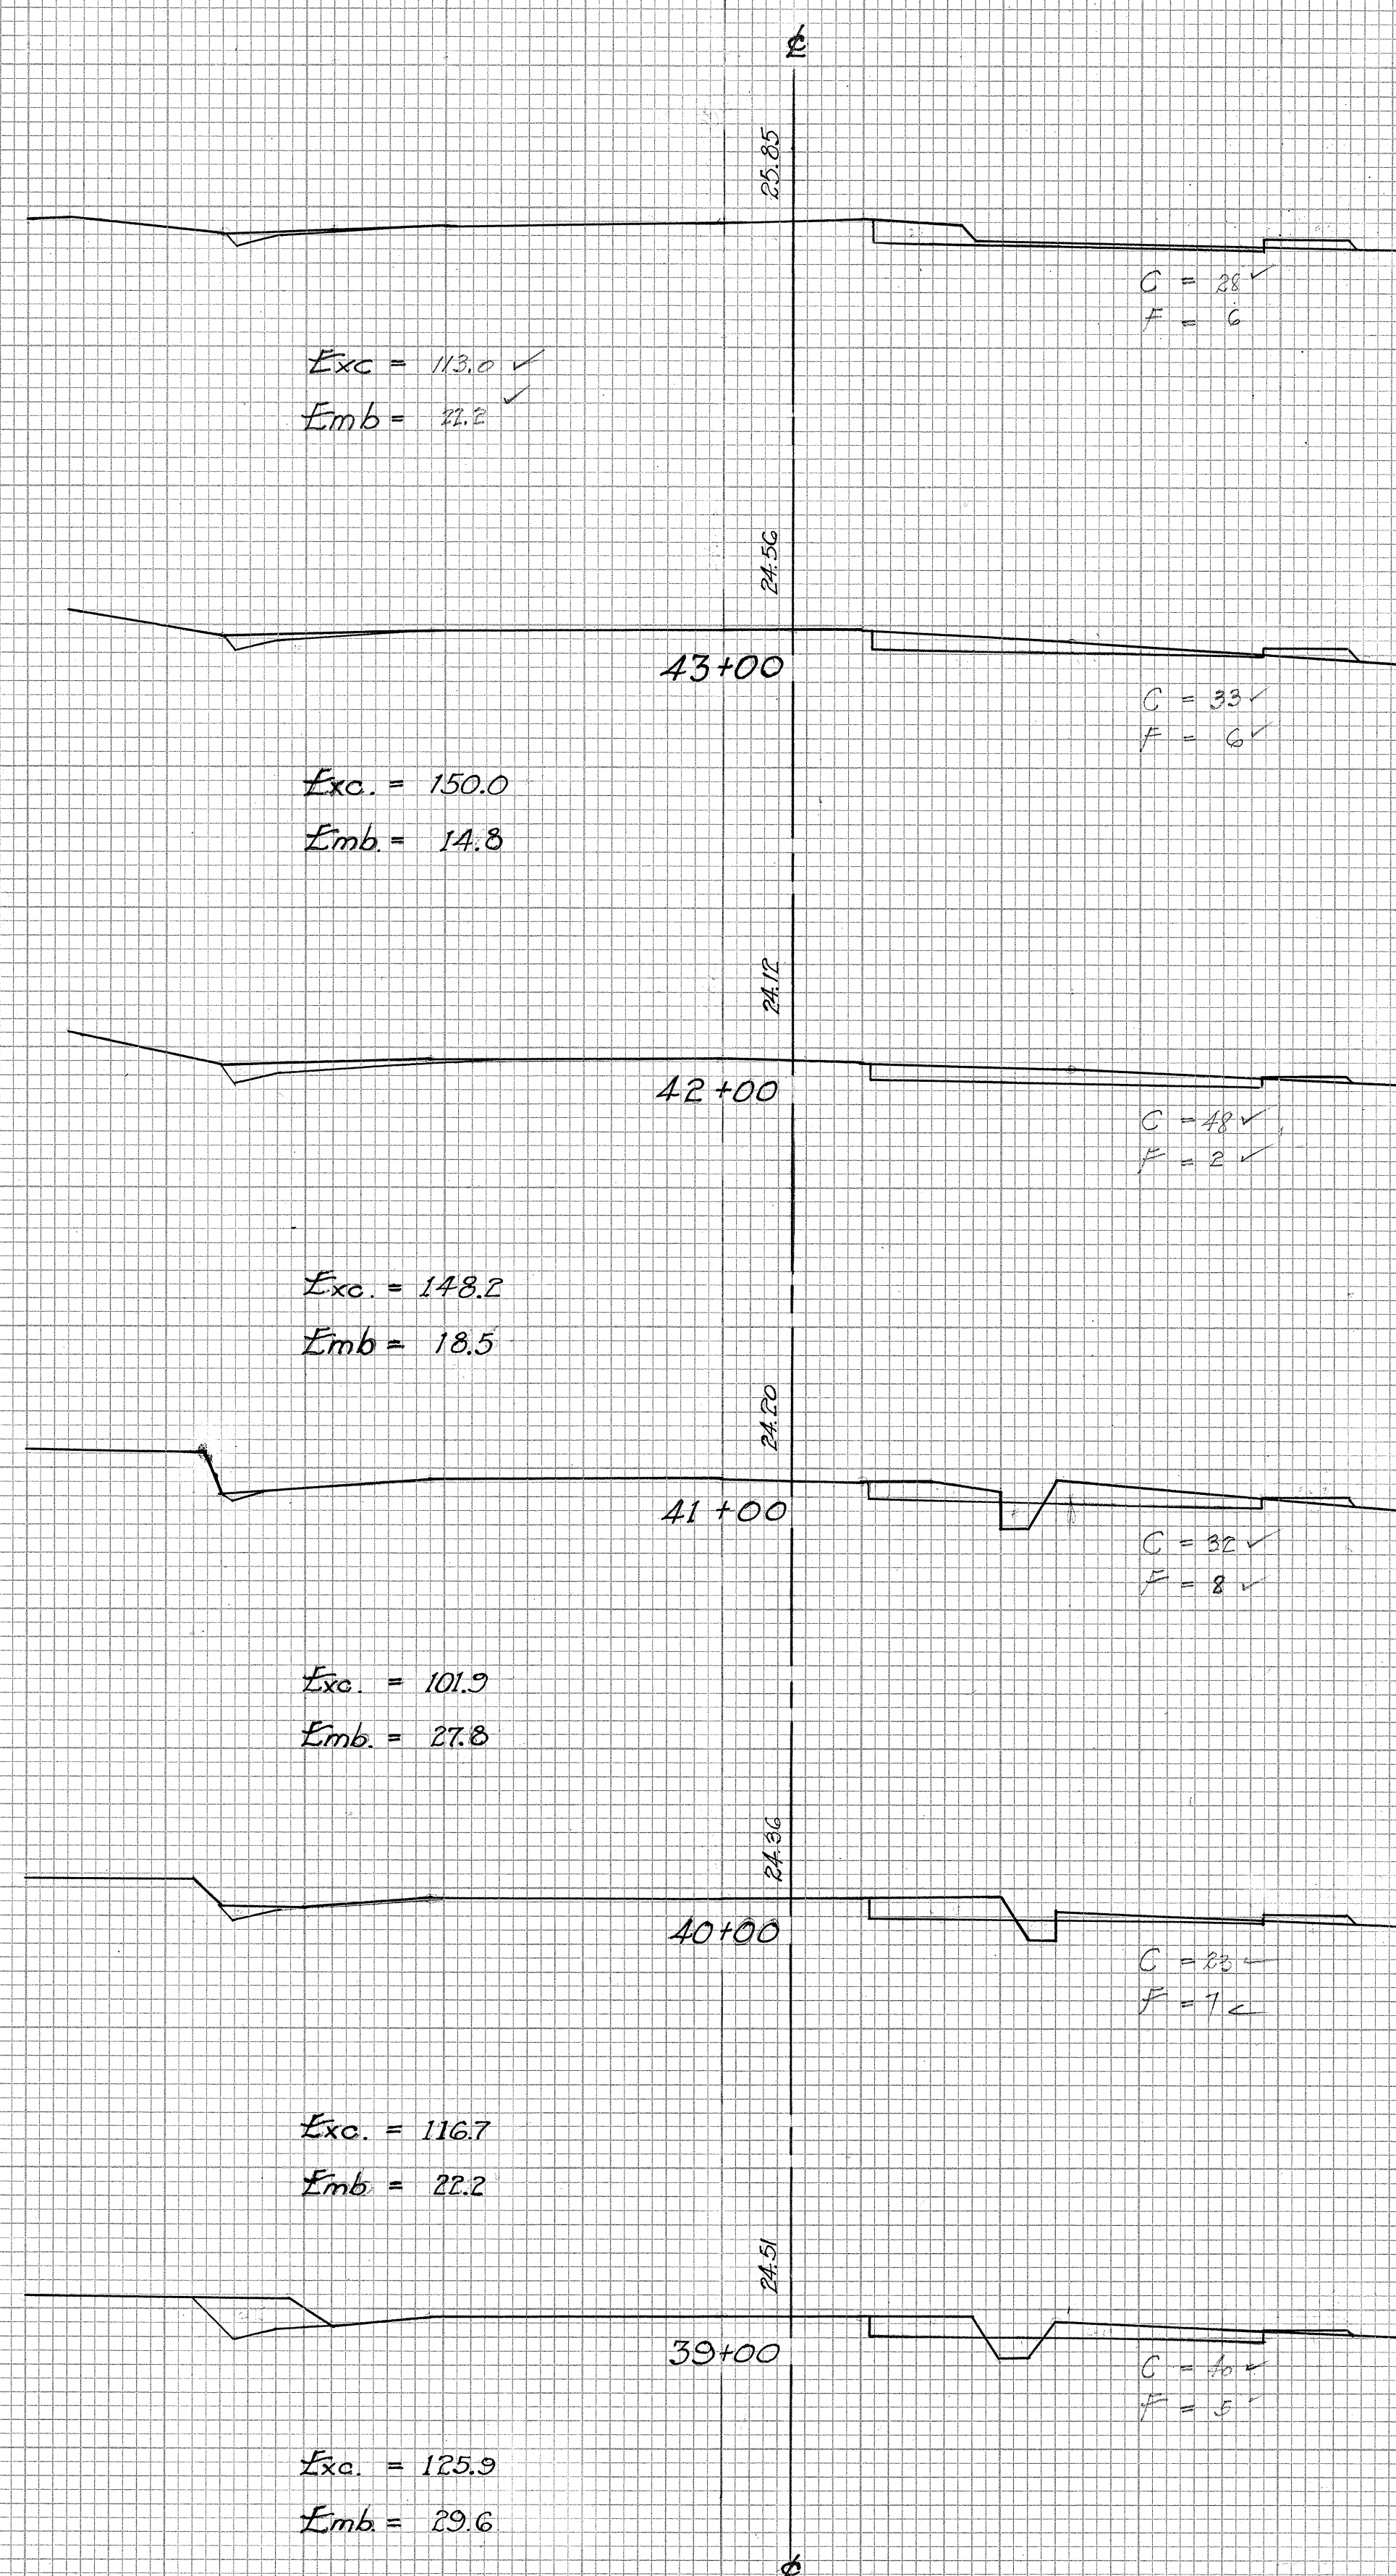

FINAL	SURVEYED	DATE
SURVEY	PLOTTED	BY
NOTE BOOK	REPLATE	
NO.	AREAS CHECKED	

ORIGINAL	SURVEYED	DATE
SURVEY	PLOTTED	BY
NOTE BOOK	REPLATE	
NO.	AREAS CHECKED	




FED. ROAD DIST. NO.	STATE	FED. AID PROJ. NO.	FISCAL YEAR	SHEET NO.	TOTAL SHEETS
HAWAII	HAW.	5N-PAP-3	1940	13	16

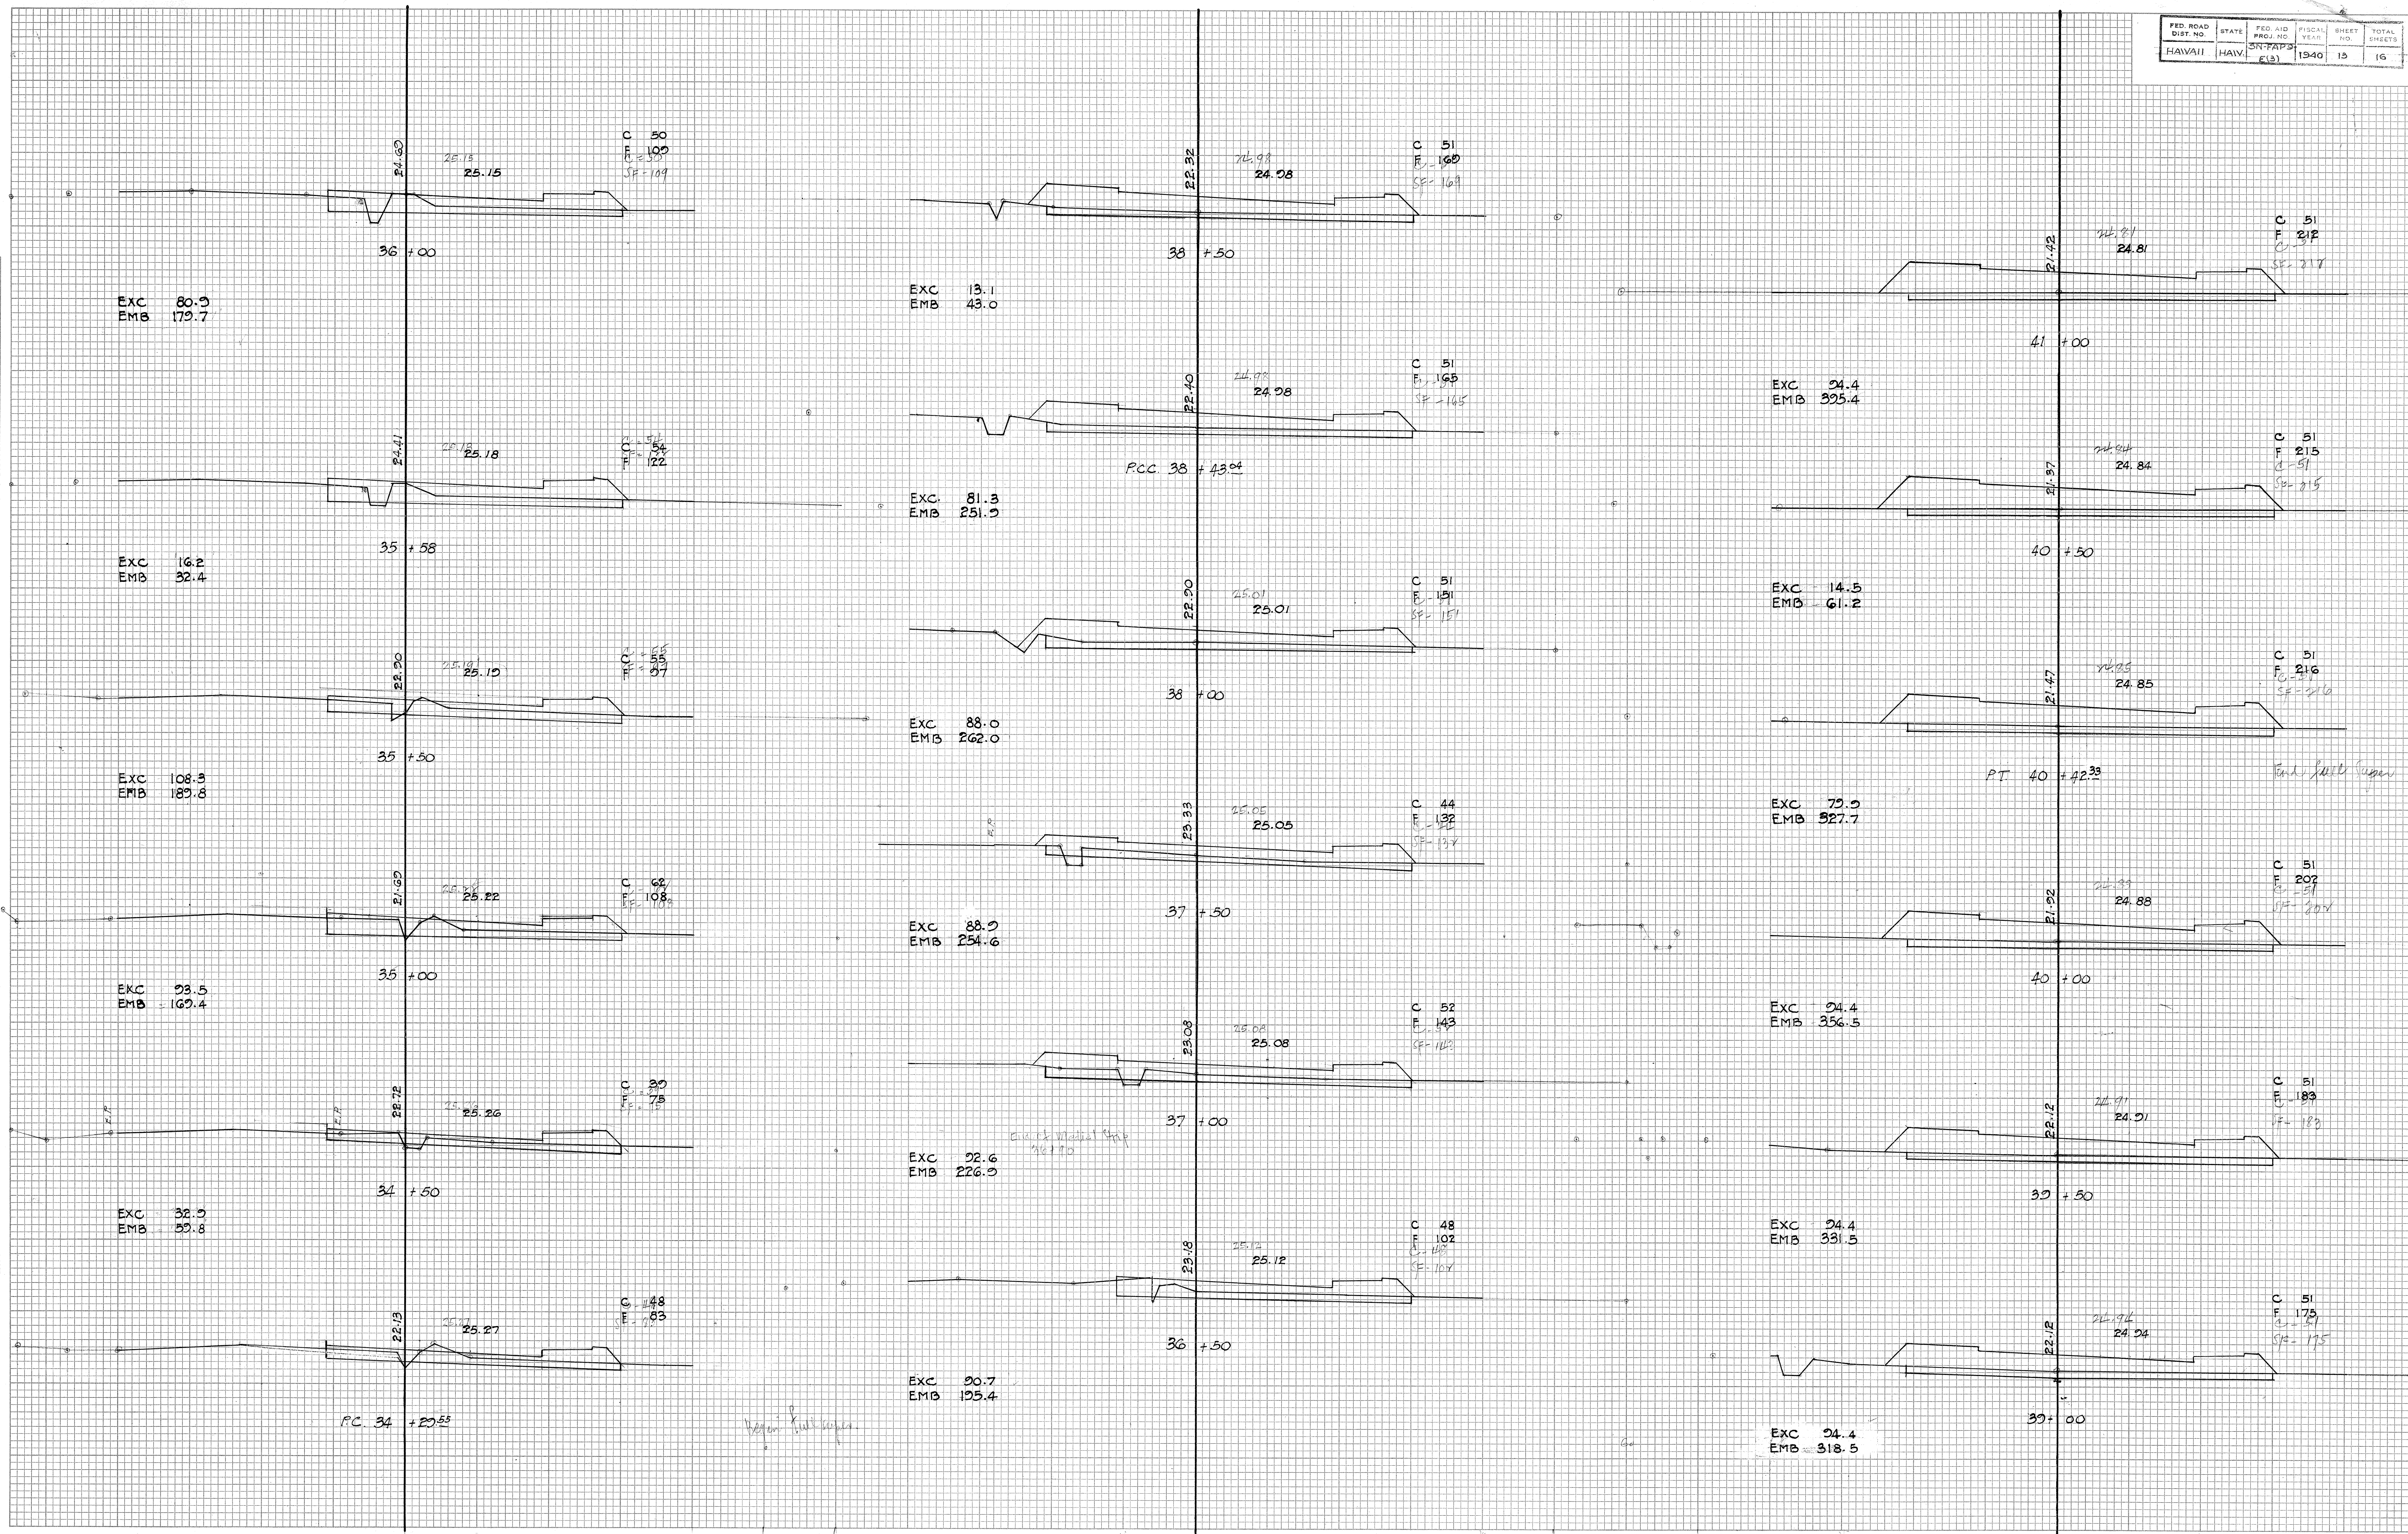


FINAL SURVEY	BY	DATE	NO.	SURVEYED PLOTTED NOTE BOOK AREA AREAS CHECKED

ORIGINAL SURVEY	BY	DATE	NO.	SURVEYED PLOTTED NOTE BOOK AREA AREAS CHECKED

FED. ROAD DIST. NO.	STATE	FED. AID PROJ. NO.	FISCAL YEAR	SHEET NO.	TOTAL SHEETS
HAWAII	HAW.	SN-AP-3-13	1940	14	16

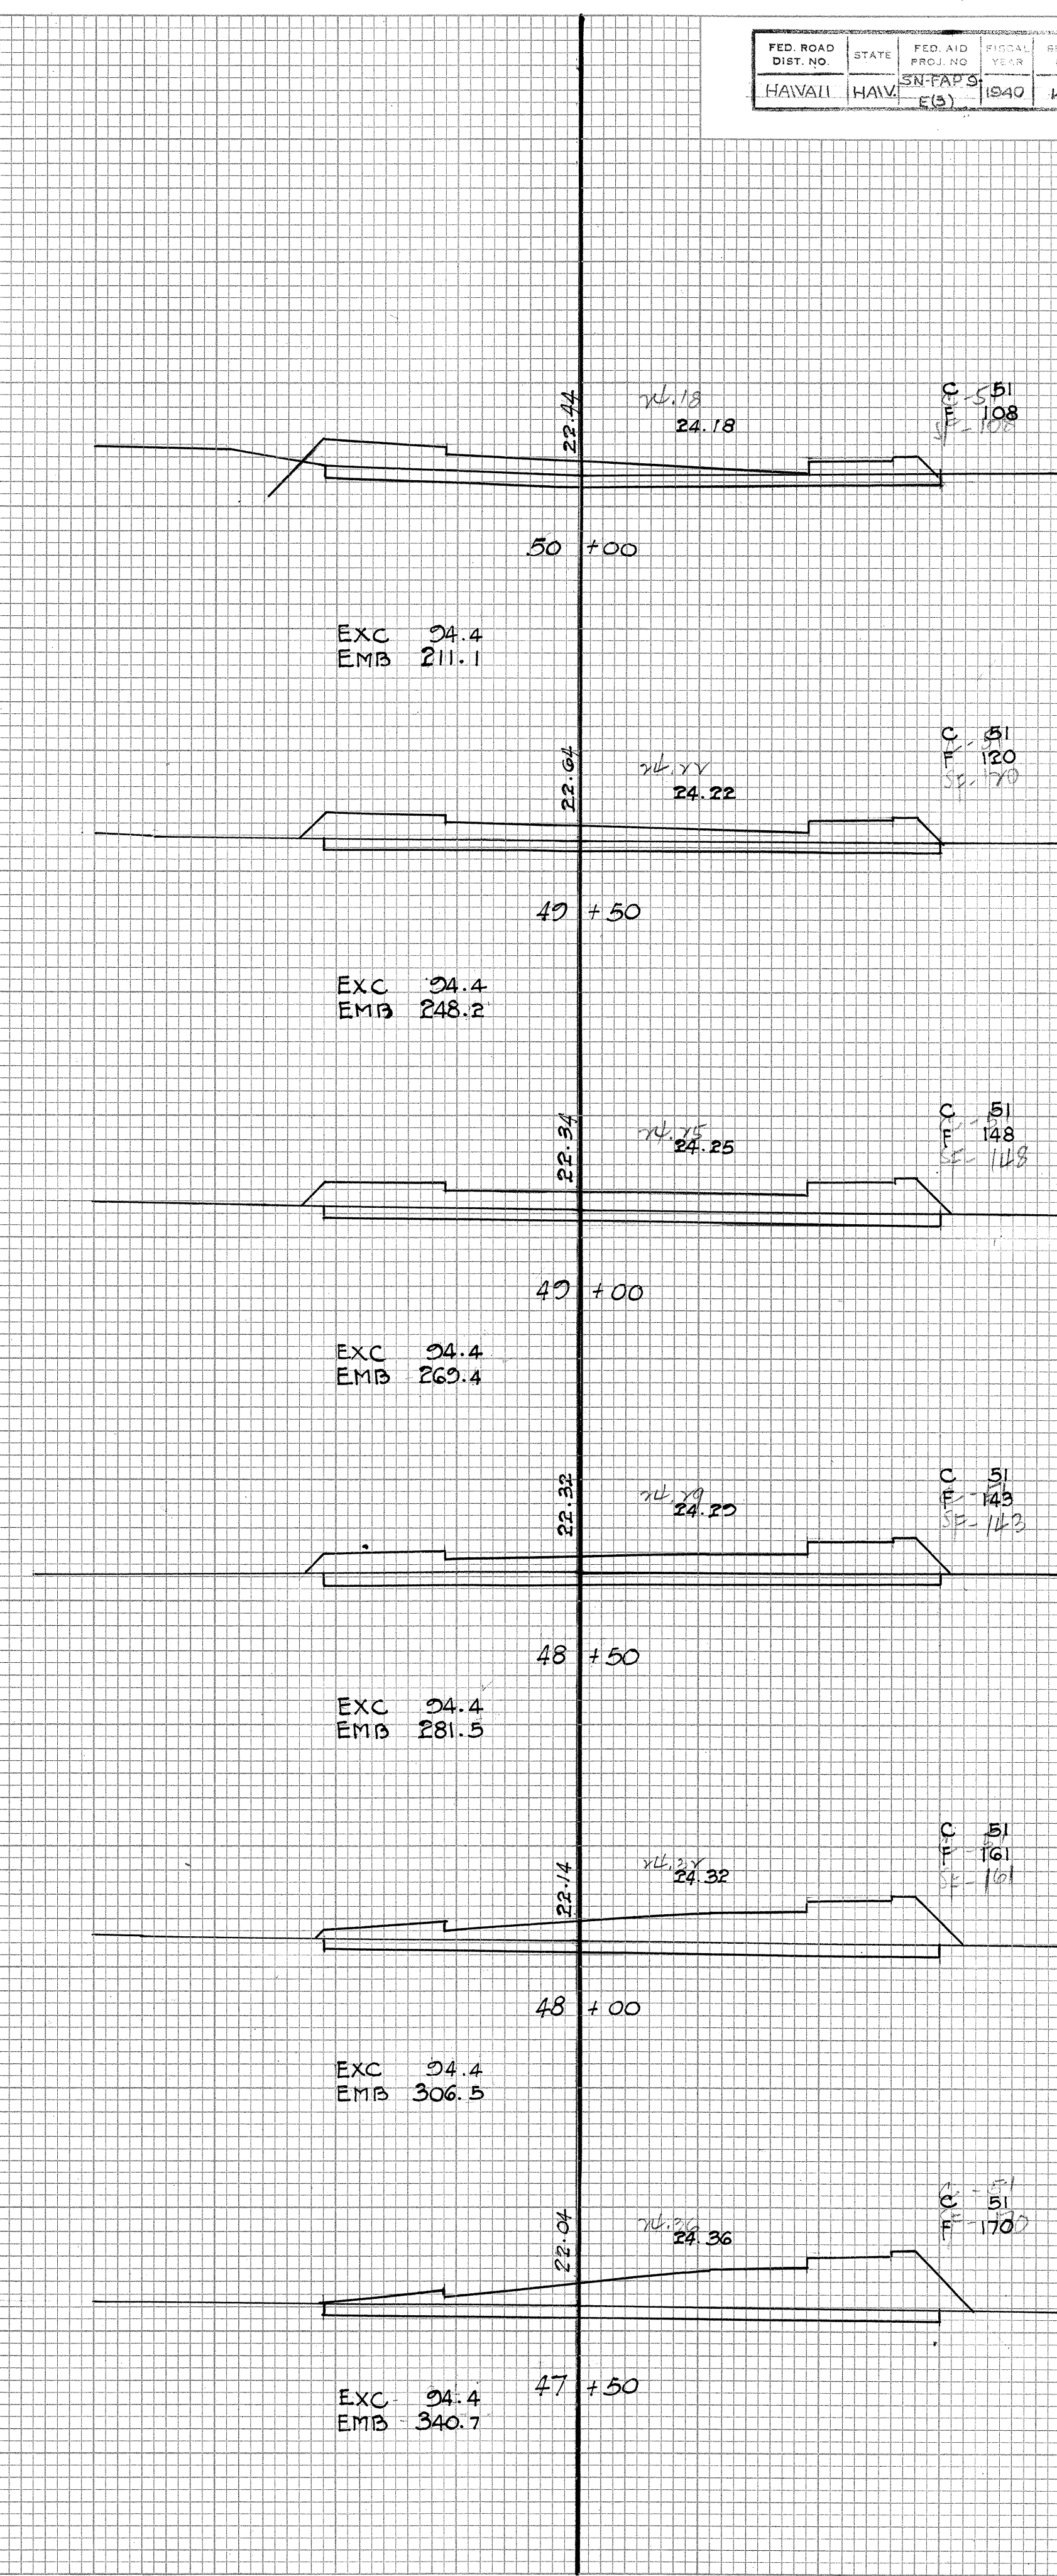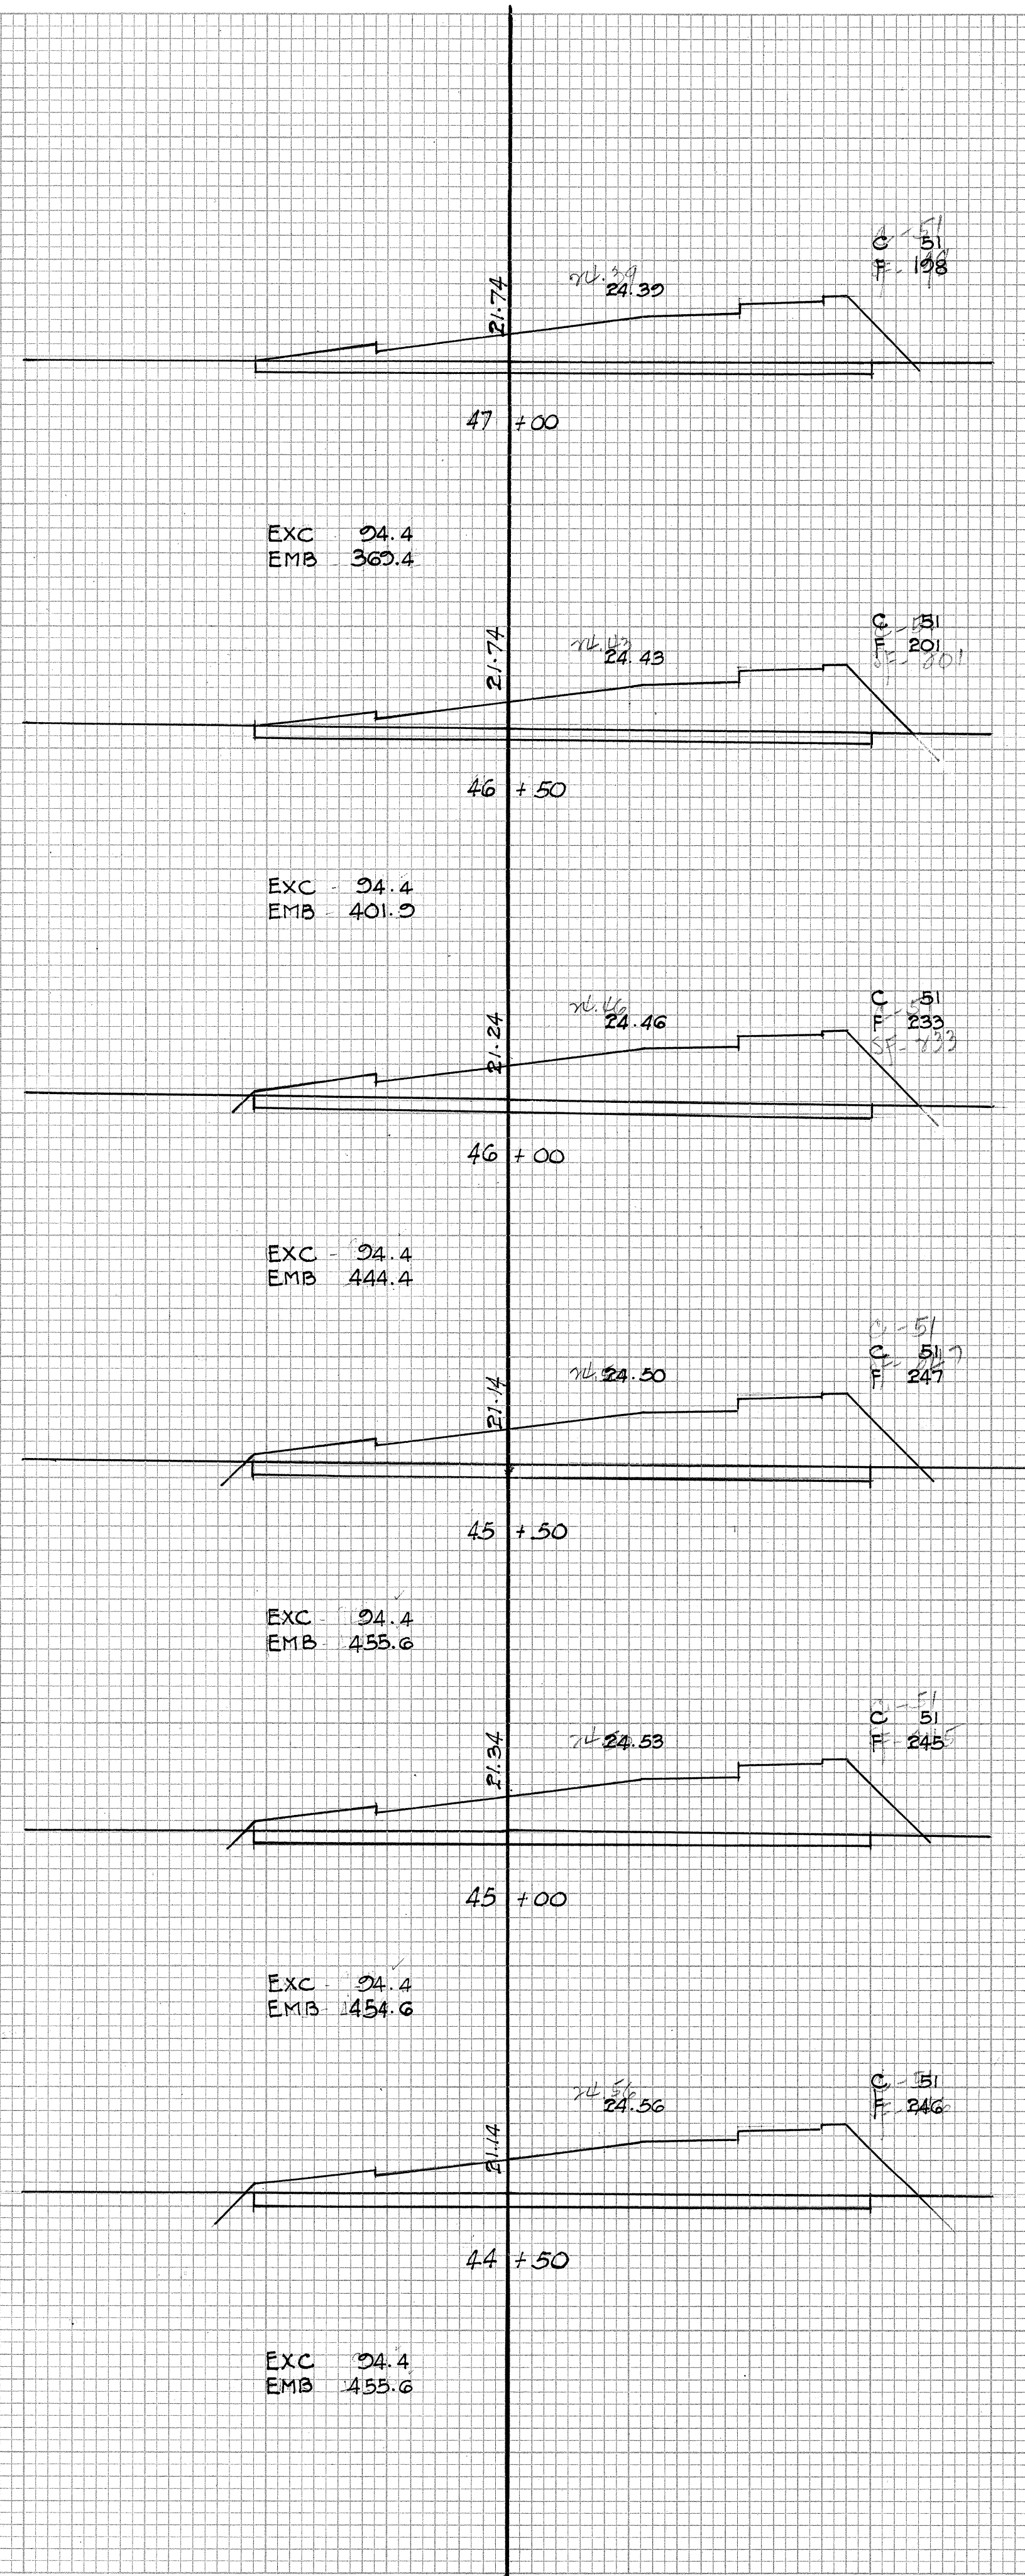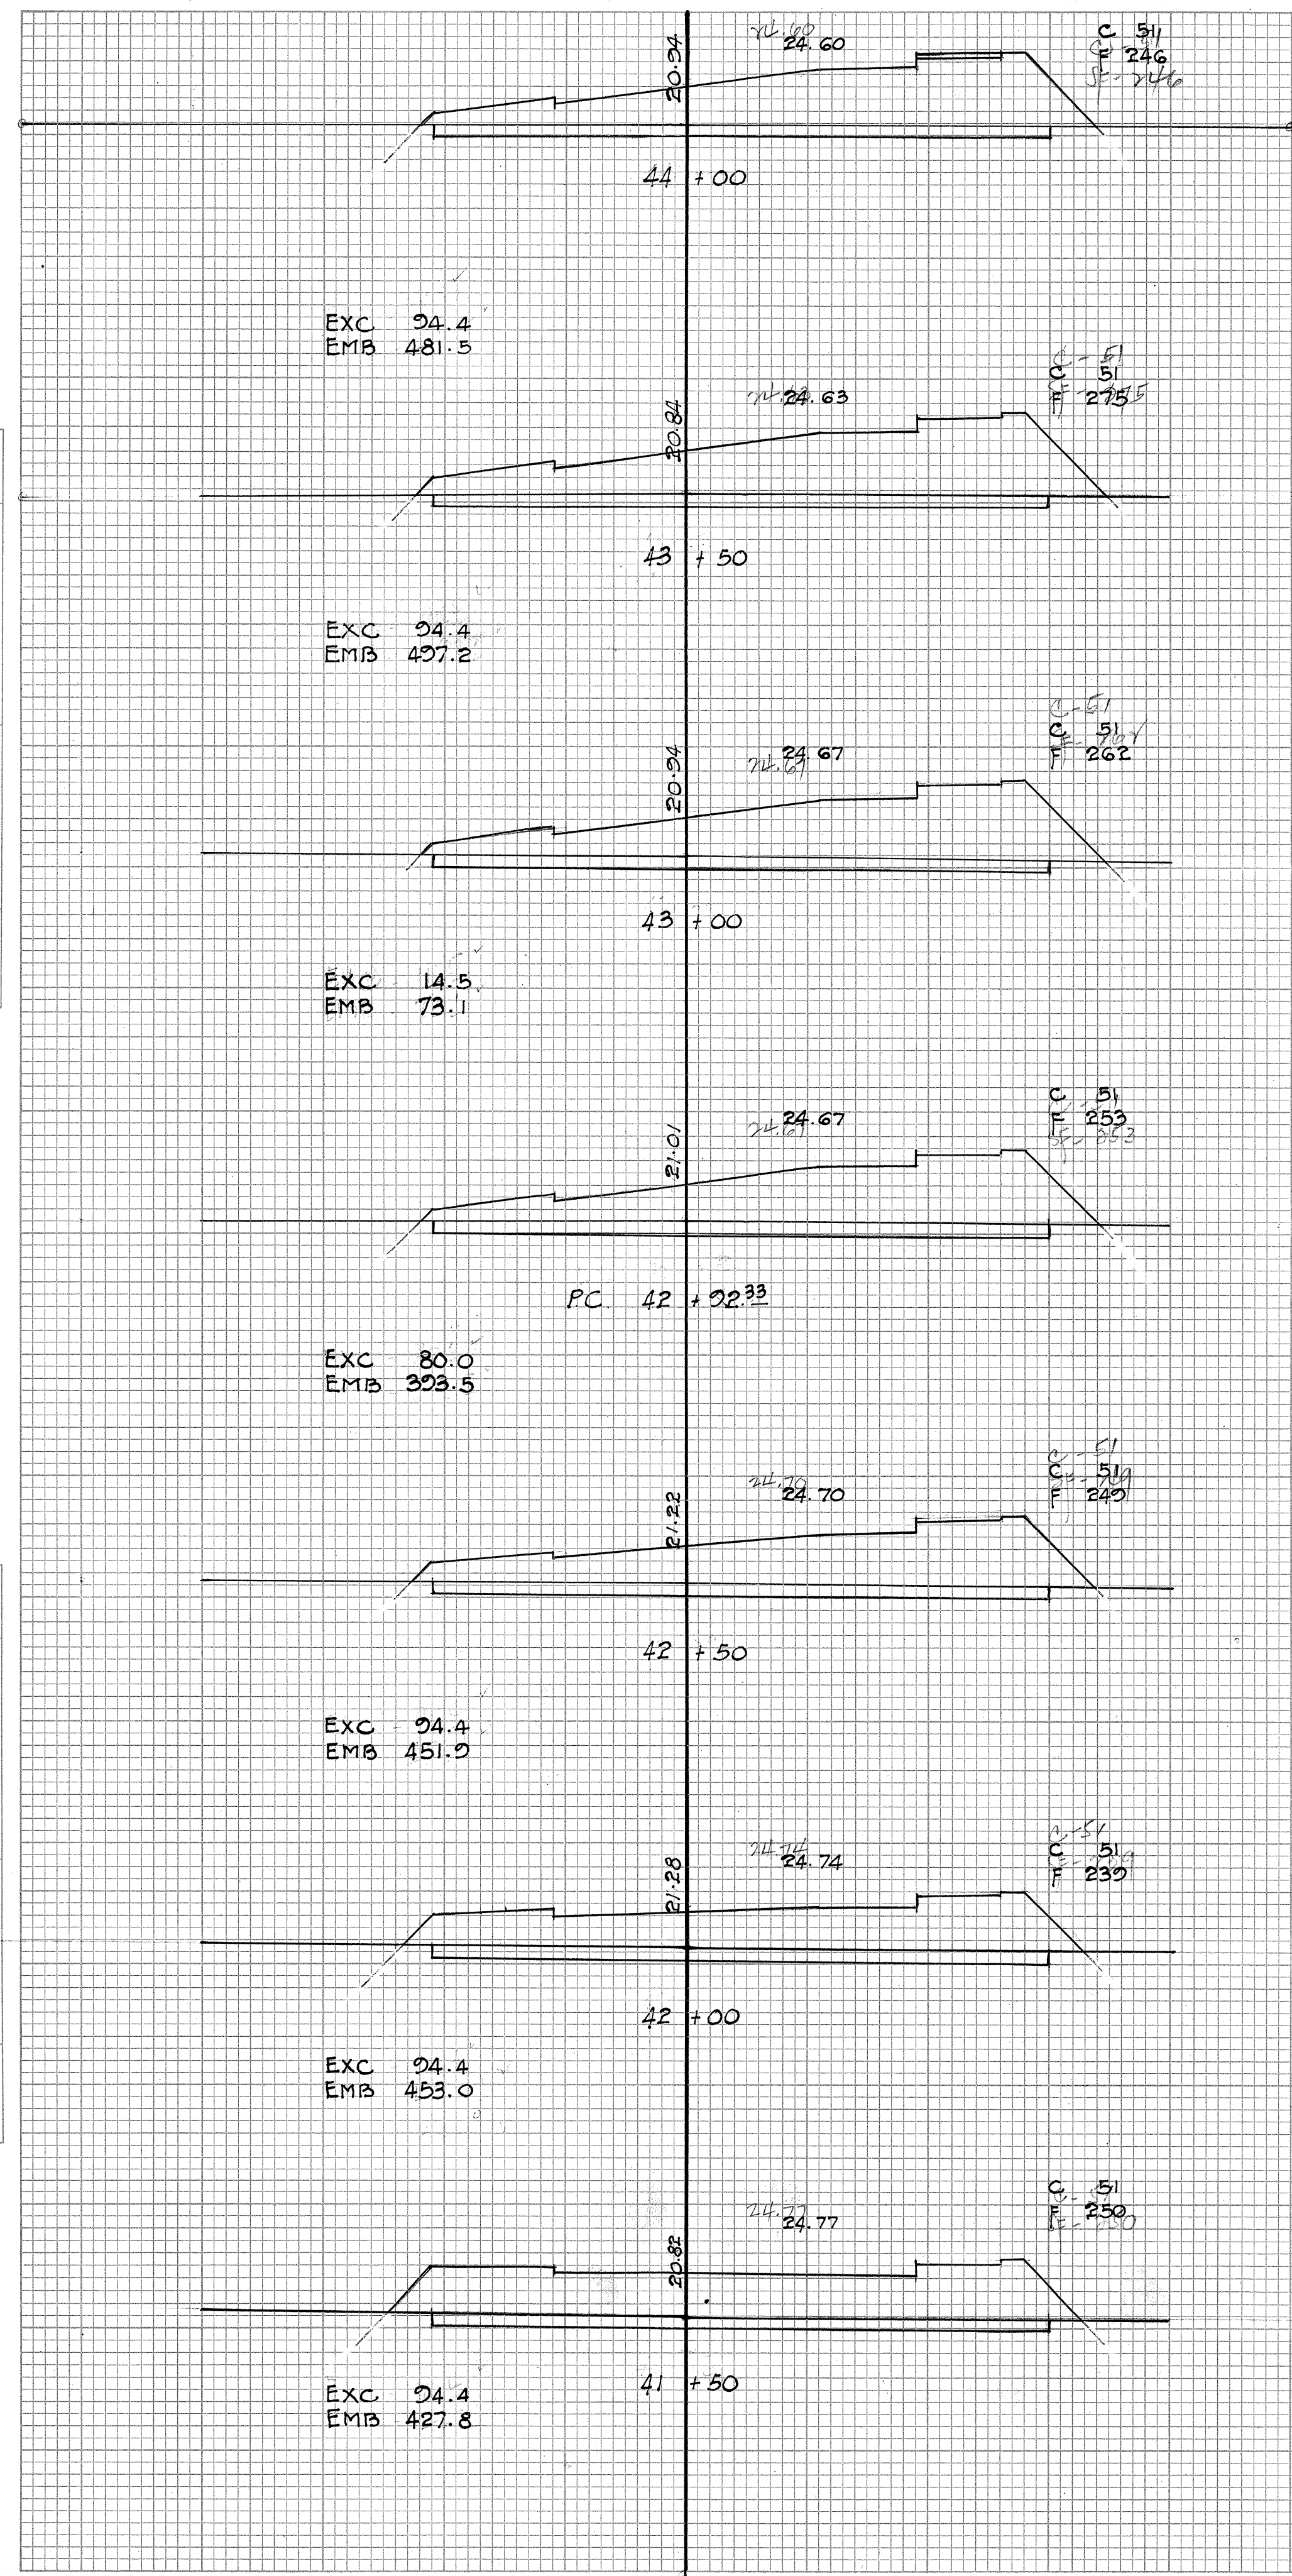

ORIGINAL SURVEY	SURVED		BY	DATE
PLOTTED				
NOTE BOOK				
AREAS				
NO.				
	AREAS CHECKED			

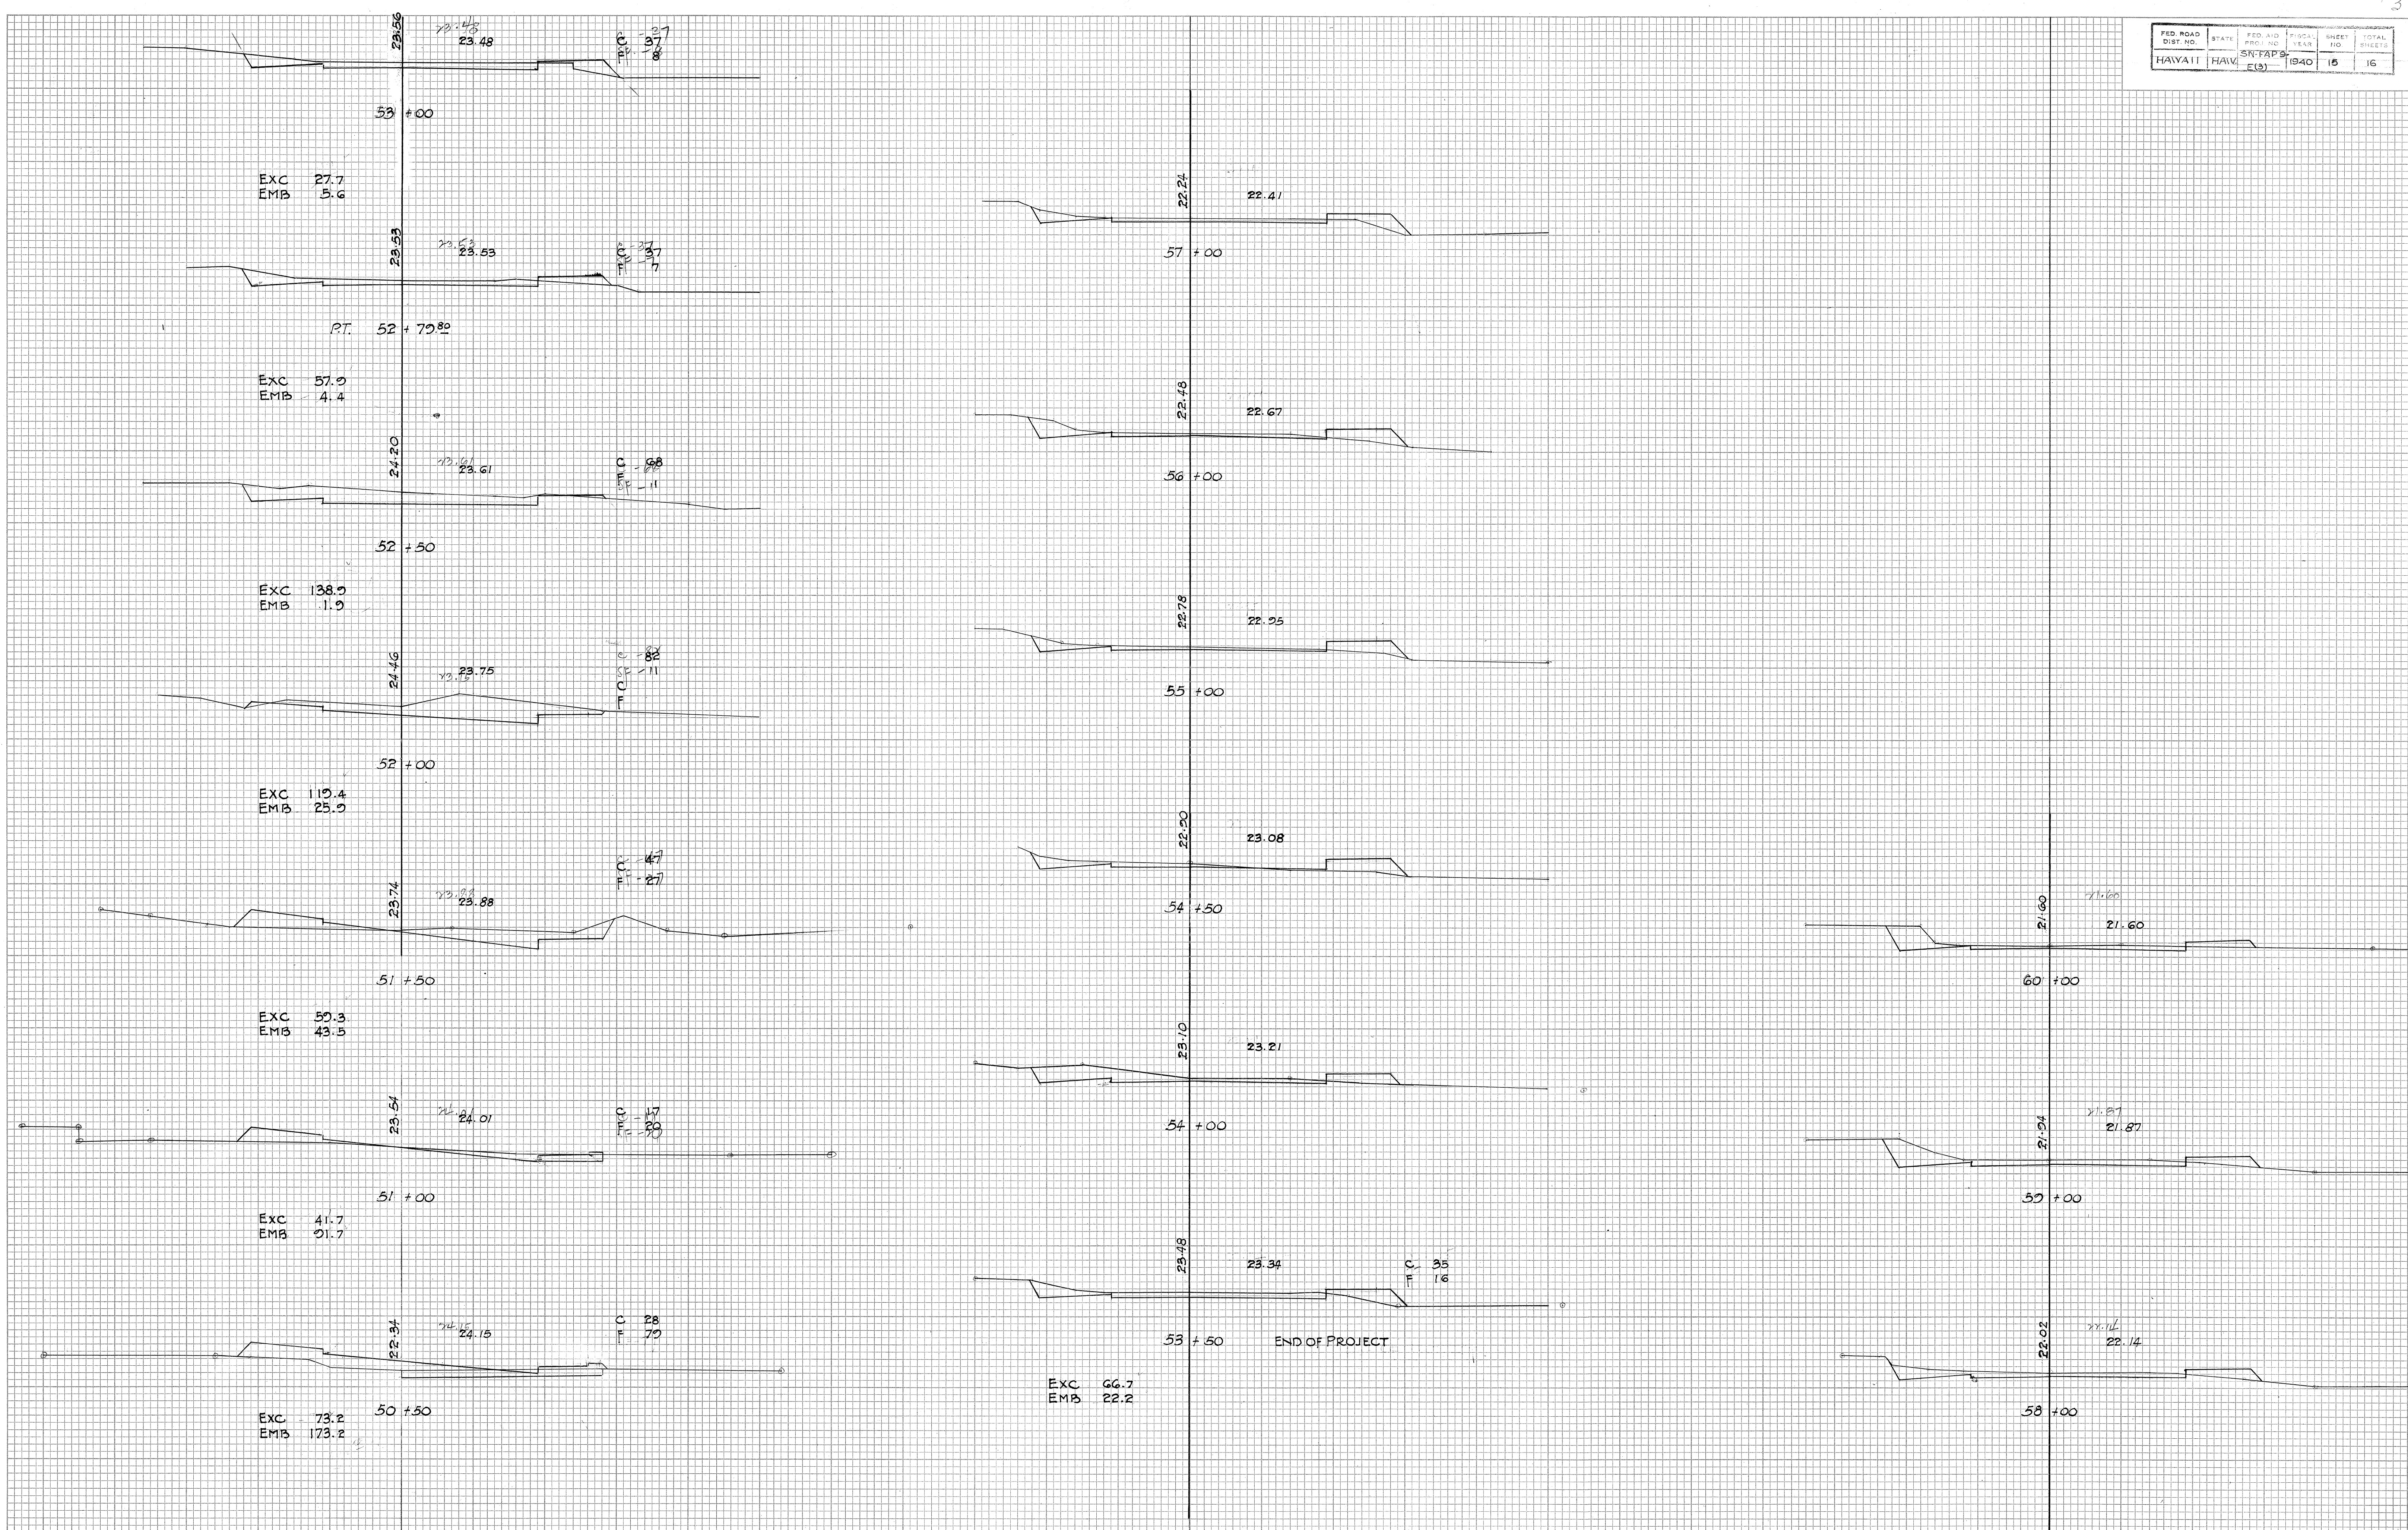

FINAL SURVEY	SURVEYED	BY	DATE
NO.	NO.		

ORIGINAL SURVEY	SURVEYED	BY	DATE
NO.	NO.		

EXC 102.8
EMB 438.0

24.02
C 56
F 227

3 +50

EXC 58.2
EMB 384.3

24.22
C 50
F 186

2 +00

EXC 67.6
EMB 244.4

21.5
C 23
F 78

+50

EXC 43.5
EMB 157.4

21.0
C 24
F 92

1 +00

21.5
C 24
F 92

+50

21.48
C 24
F 92

PC 0 +00
PT 40 +42.33

26.9

+50

27.28
C 8
F 17

5 +00

EXC 33.6
EMB 85.0

27.43
C 56
F 145

RT. 4 +71.87

EXC 44.0
EMB 33.6

27.42
C 56
F 120

+50

EXC 20.1
EMB 330.6

27.00
C 51
F 167

4 +00

EXC 28.2
EMB 324.4

26.31
C 55
F 252

+50

EXC 101.0
EMB 468.5

25.61
C 55
F 247

3 +00

26.7

PC 51 +73.36
PT 72 +73.36

SECTIONS FOR TEMPORARY CONNECTION AT JUNCTION