



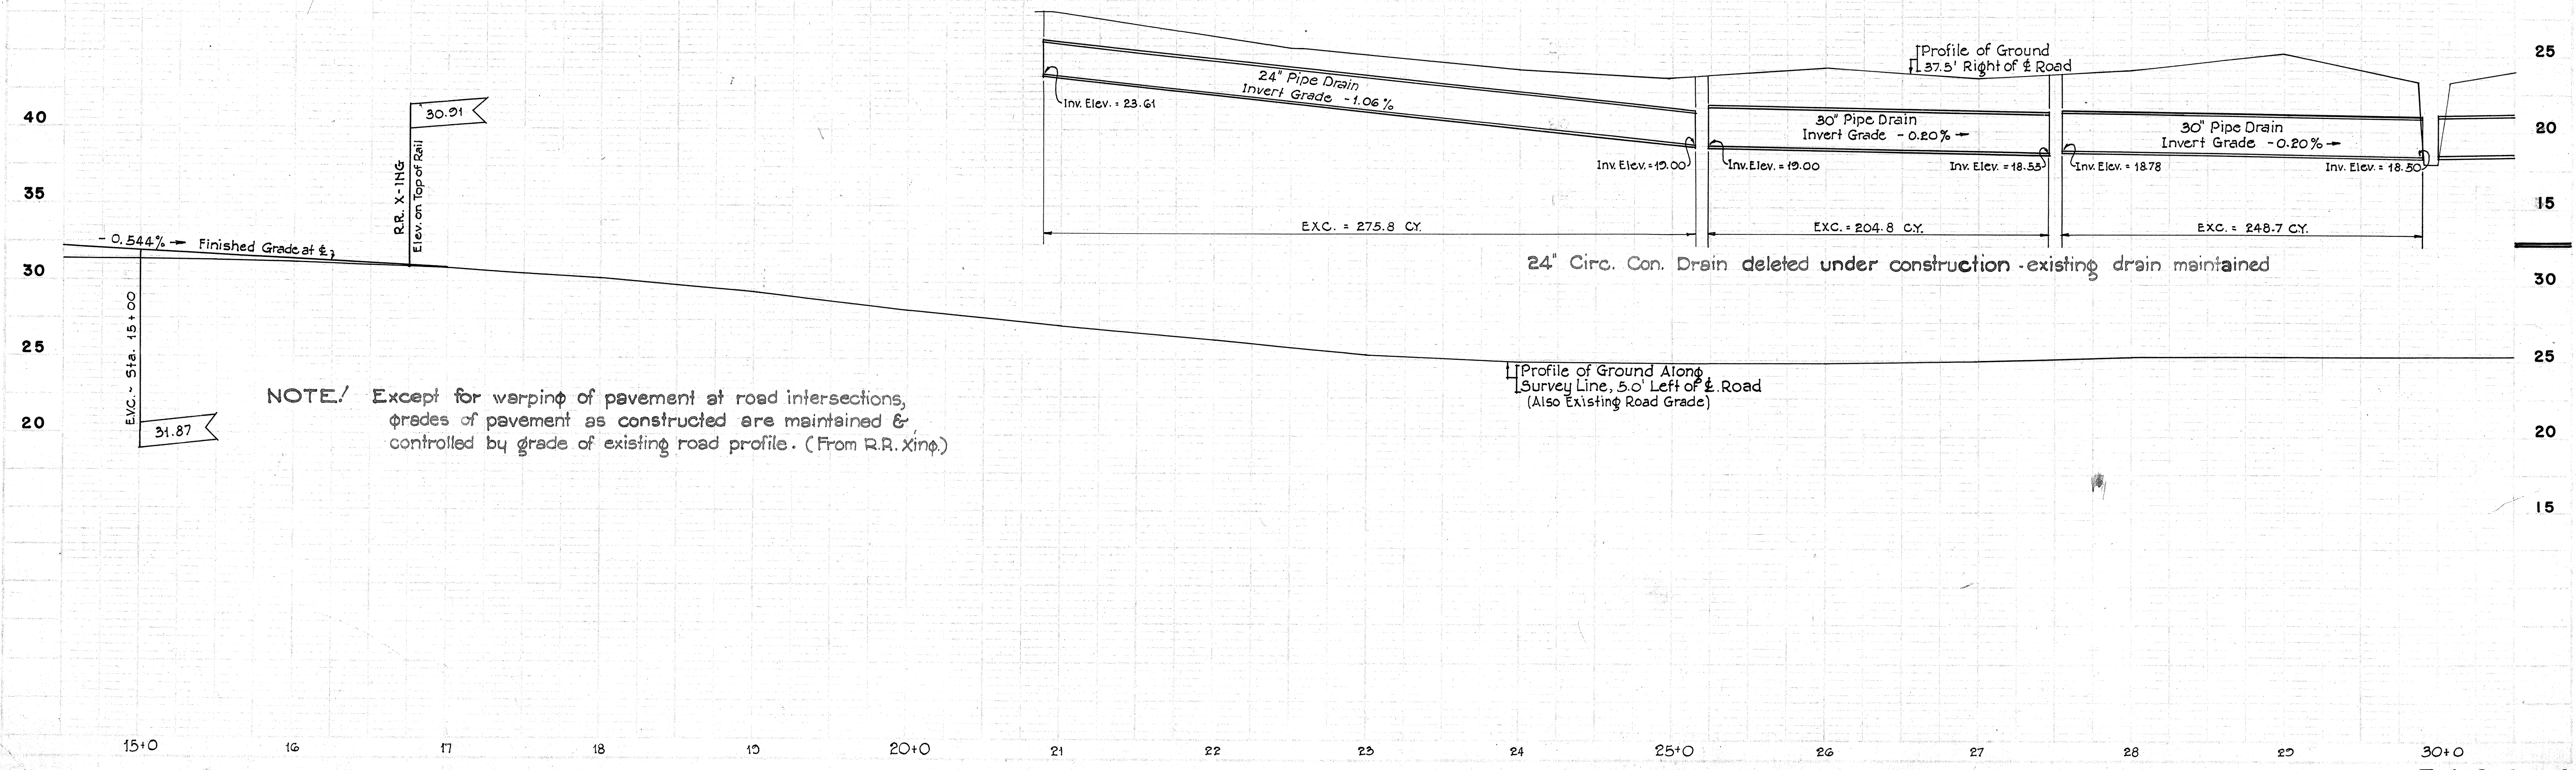

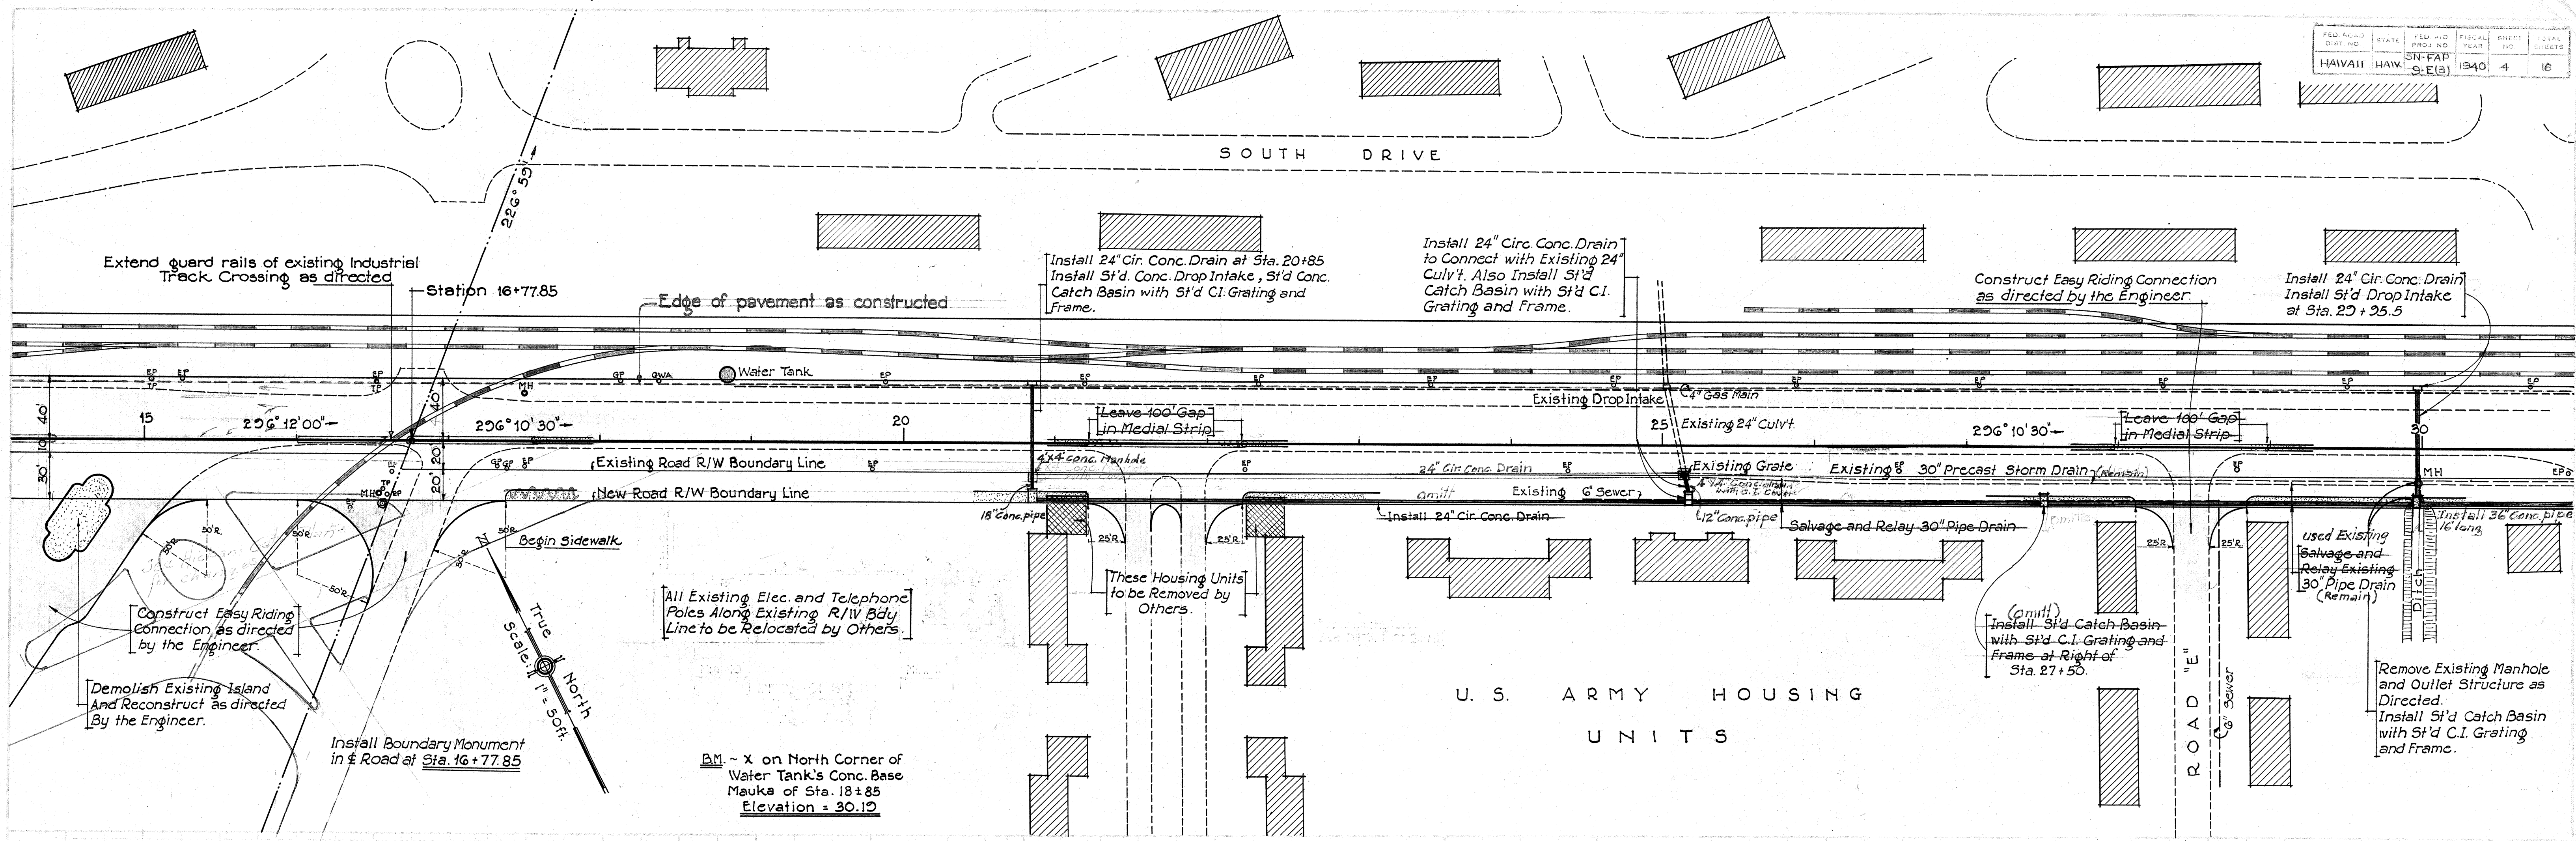

U. S. NAVAL HOUSING
UNIT 5

S O U T H D R I V E

STA. 34+29.55: End full Section 80' wide; begin
2 lane, one way traffic.

Sta. 34+29.55: Install 24" Circ. Conc. Culvt.
as detailed. Move Conc. E.P. if necessary

Edge of pavement as constructed

Sta. 41+00 To Sta. 43+00;
Make easy riding connection
to existing Pavement

END OF PROJ.
Sta. 42+88.28
See following sheet for
Station Equation.

Curve Data

$\Delta = 33^{\circ}00'$
 $R = 721.20$
 $T = 213.63$
 $L = 415.38$
 $SE = 0.125' \text{ PER FT.}$

PEARL HARBOR
JUNCTION

Existing R/W Boundary

End Medial Strip: Sta. 30+50

Construct easy riding Connection as directed
O.R. & L. 40 ft R/W

Storm Drain
New Road R/W Boundary Line
Install 30" Circular Concrete Drain

Construct 3rd. Conc. Catch Basin
as detailed. Right of Sta. 32+79

Salvage existing 18" Circular Conc. Drain.

Construct easy riding Connection
as directed by the Engineer

Begin Concrete Sidewalk

AREA RESERVED FOR
SCHOOLS & PLAYGROUNDS
PROPERTY OF U.S. NAVY

Curve Data

$\Delta = 8^{\circ}19'30''$
 $R = 2845.79$
 $T = 207.11$
 $L = 413.49$
 $SE = 0.050' \text{ PER FT.}$

Curve Data

$\Delta = 6^{\circ}00'$
 $R = 1903.11$
 $T = 99.74$
 $L = 199.29$

P.T.: Sta. 40+42.33
Sta. 0+00. Begin Connection


Sta. 41+16: Install 24" Circ.
Conc. Culvt. 80' long with
Std. Conc. C.B. Invert
Elevation of C.B. = 20.84

Sta. 41+67.33 End SE
Begin SE


Temporary Connection. See
following sheet for Data.


Temporary Connection constructed
& maintained during progress of
job. Deleted on completion.

B.M. ~ on Conc. Base of R.R.
Signal Tower No. 42
Left of Sta. 47+50
Elevation = 26.82

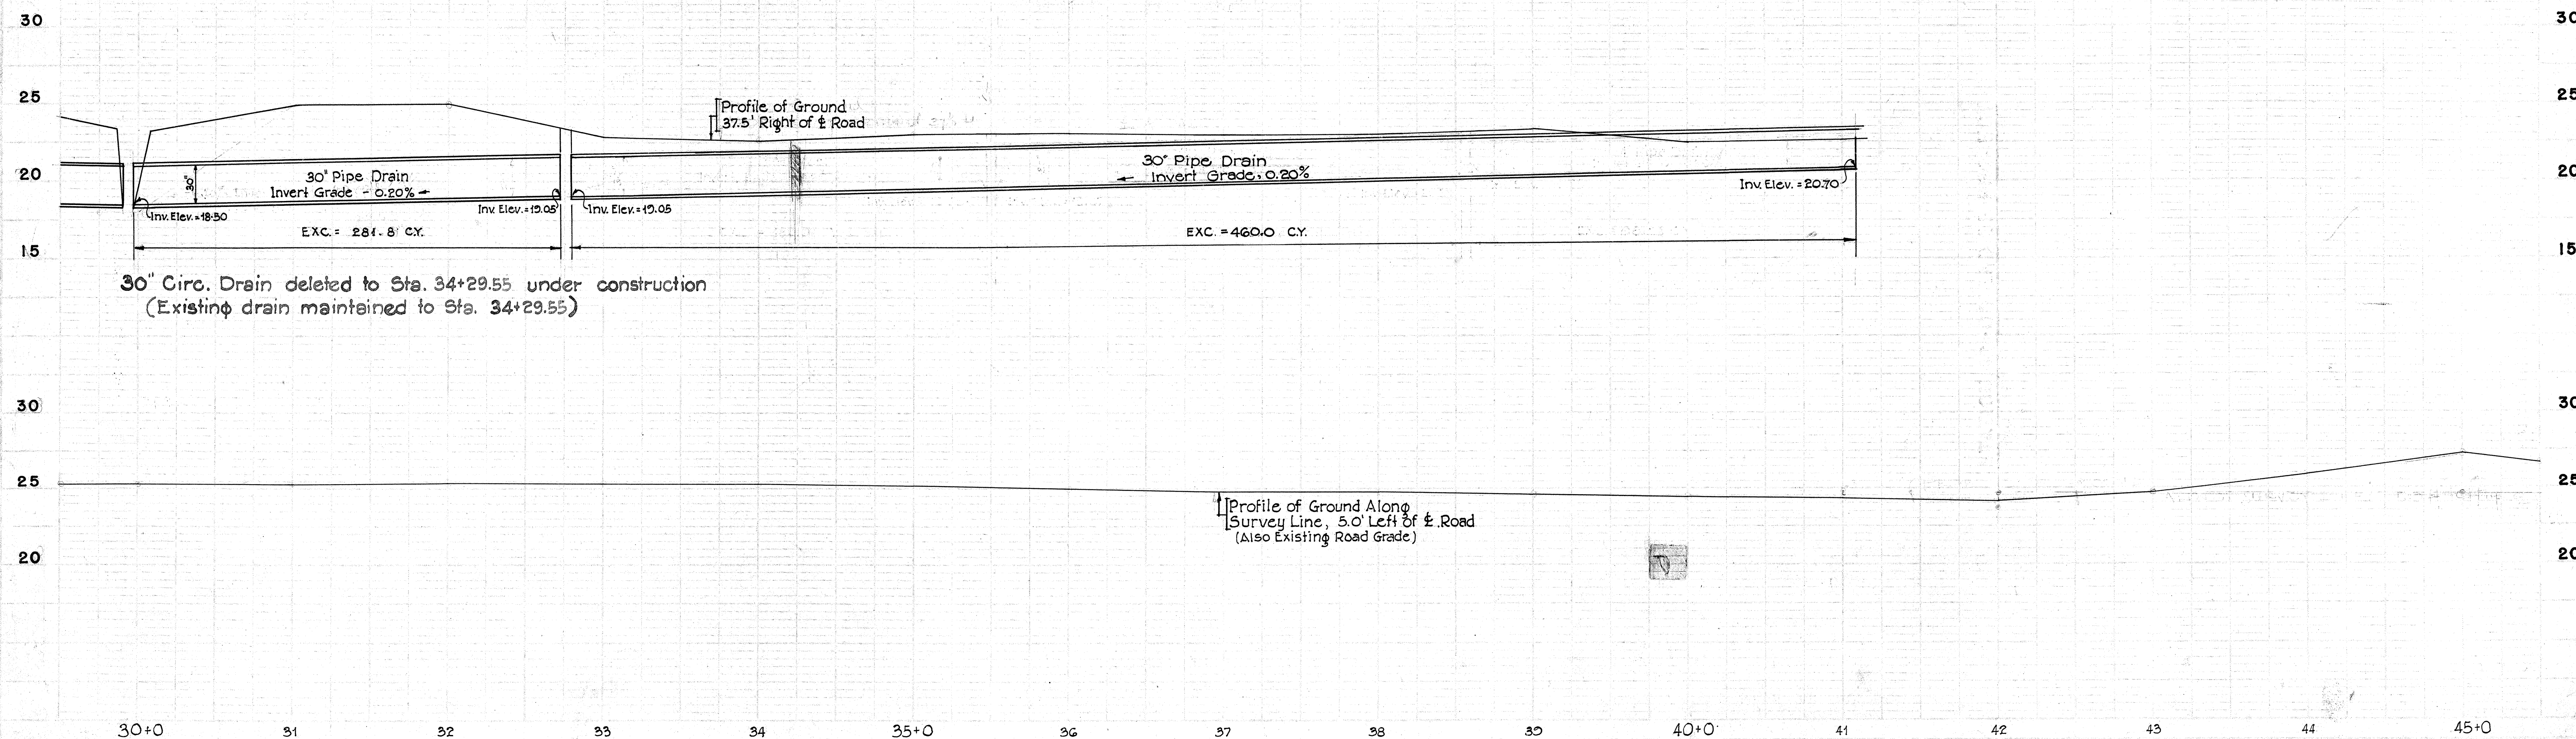

FED. ROAD DIST. NO.	STATE	FED AID PROJ. NO.	FISCAL YEAR	SHEET NO.	TOTAL SHEET
HAWAII	HAW.	SN-FAP-9 E(3)	1940	6	16

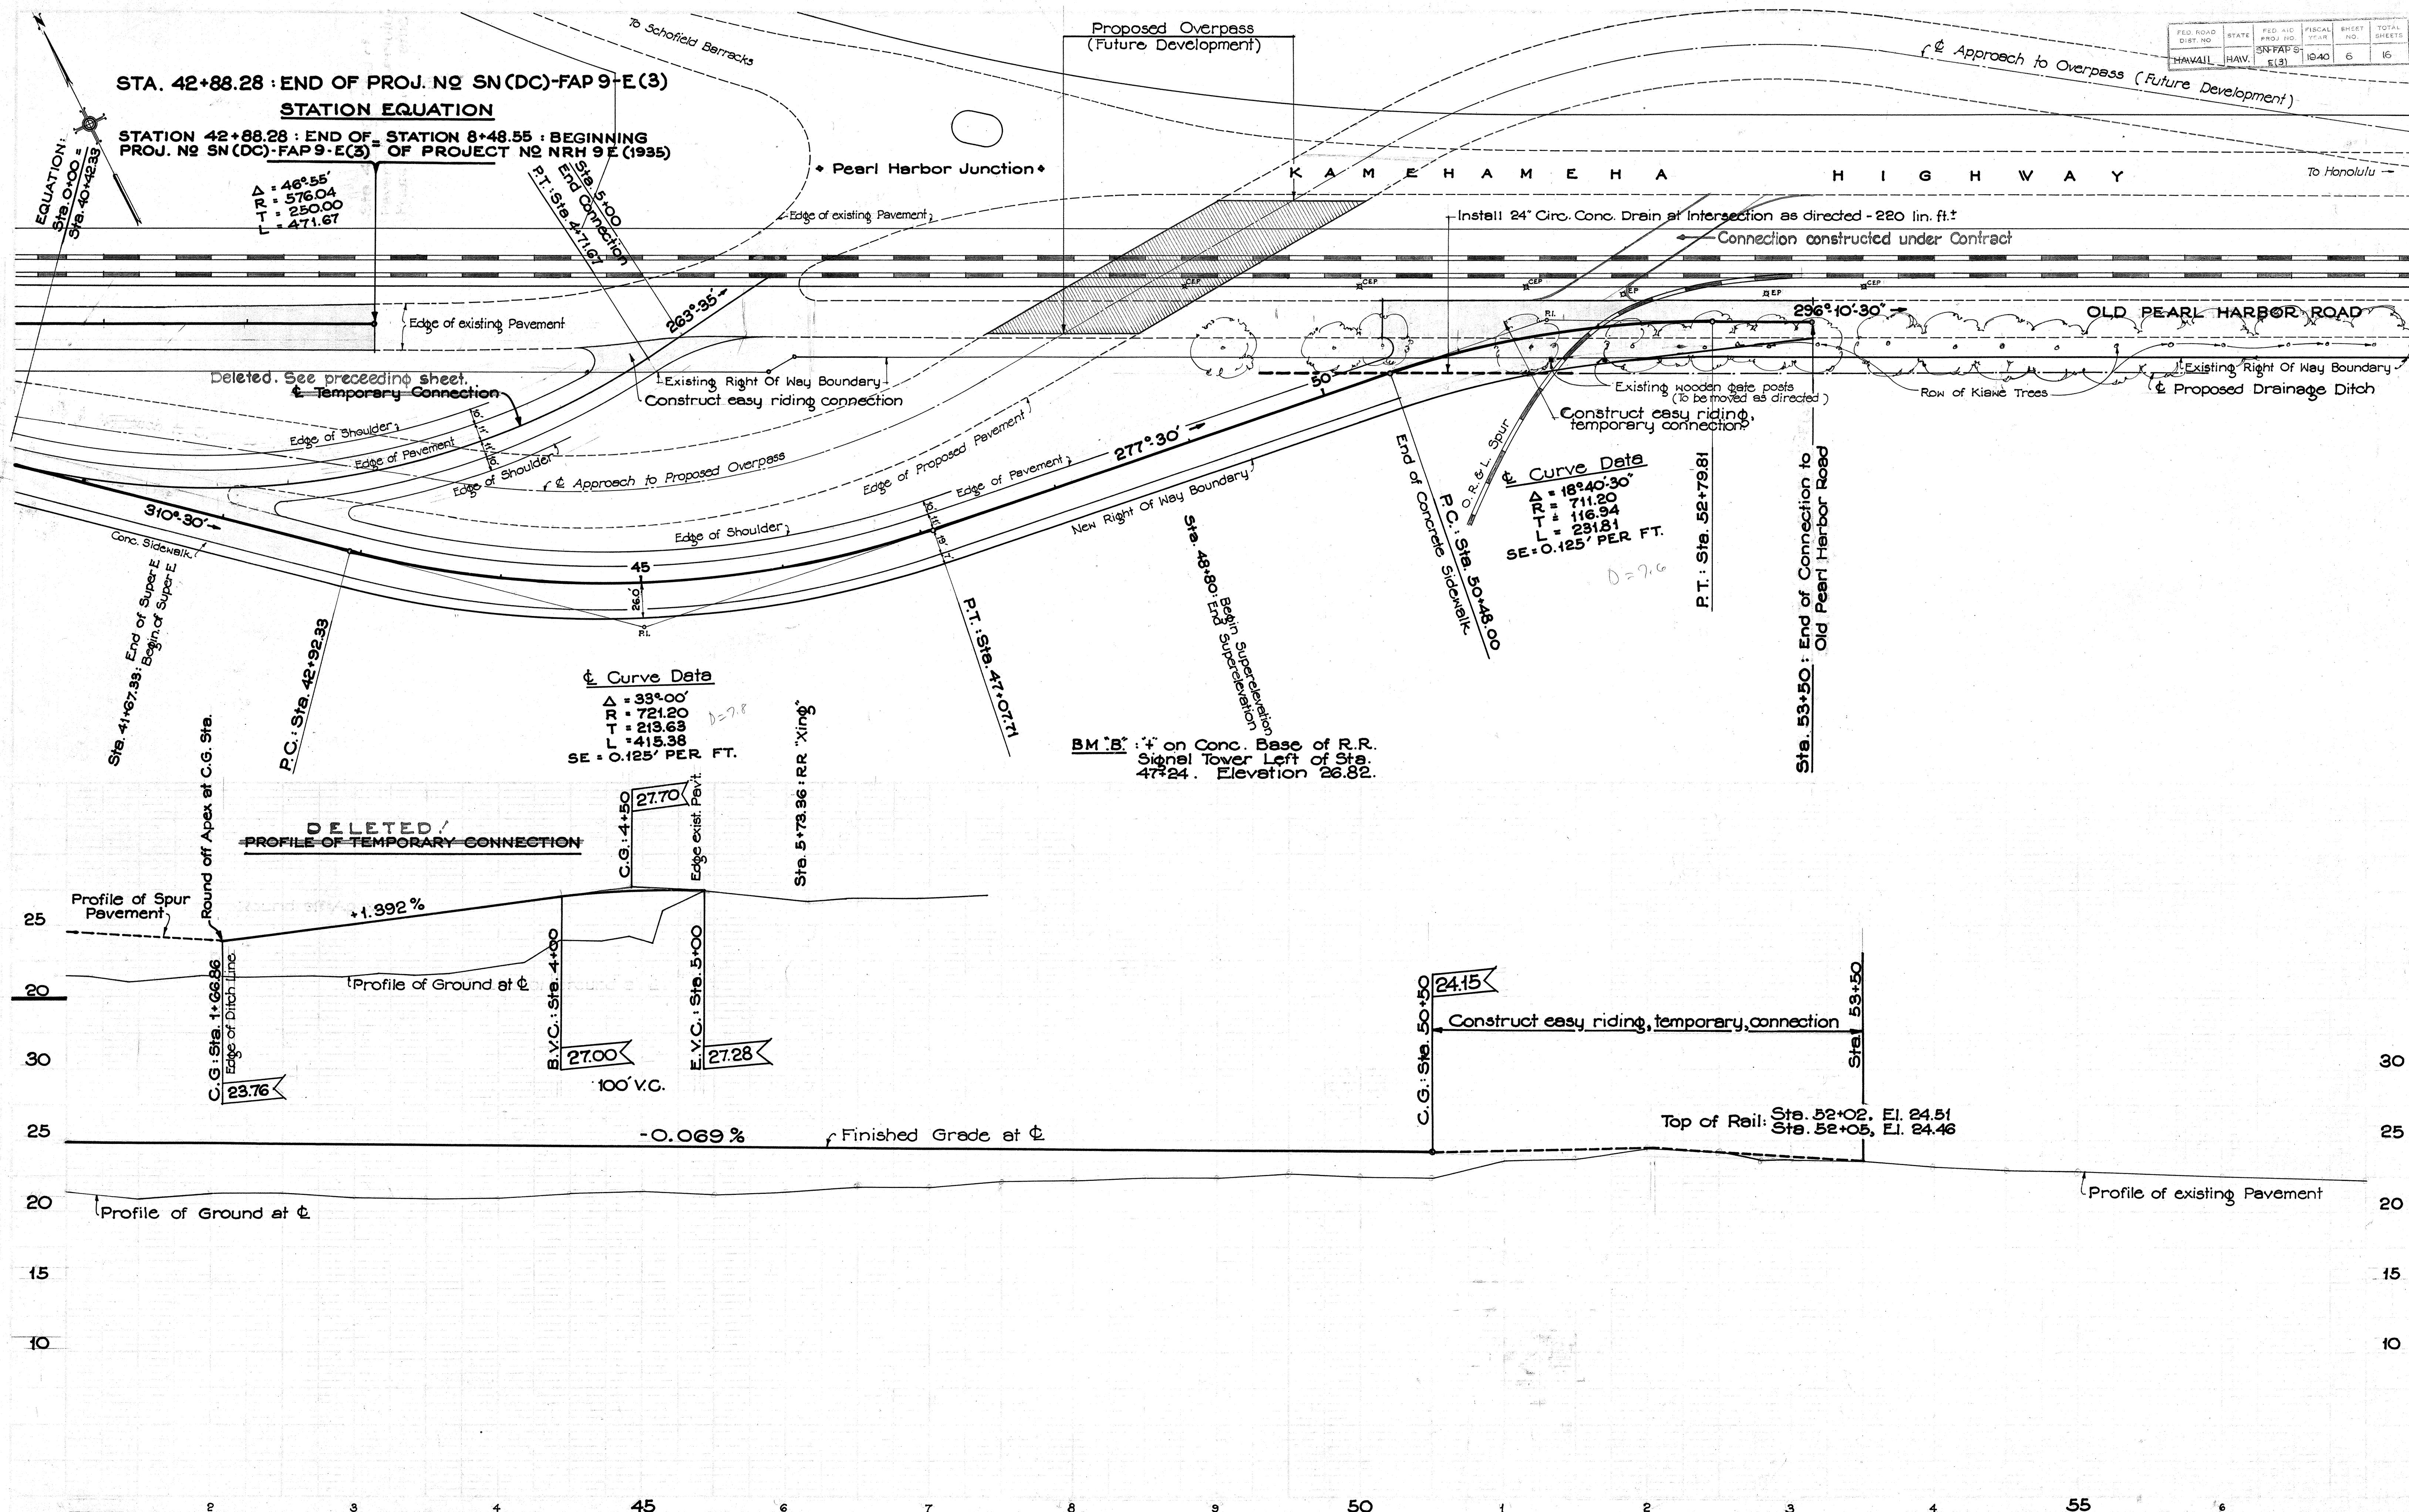

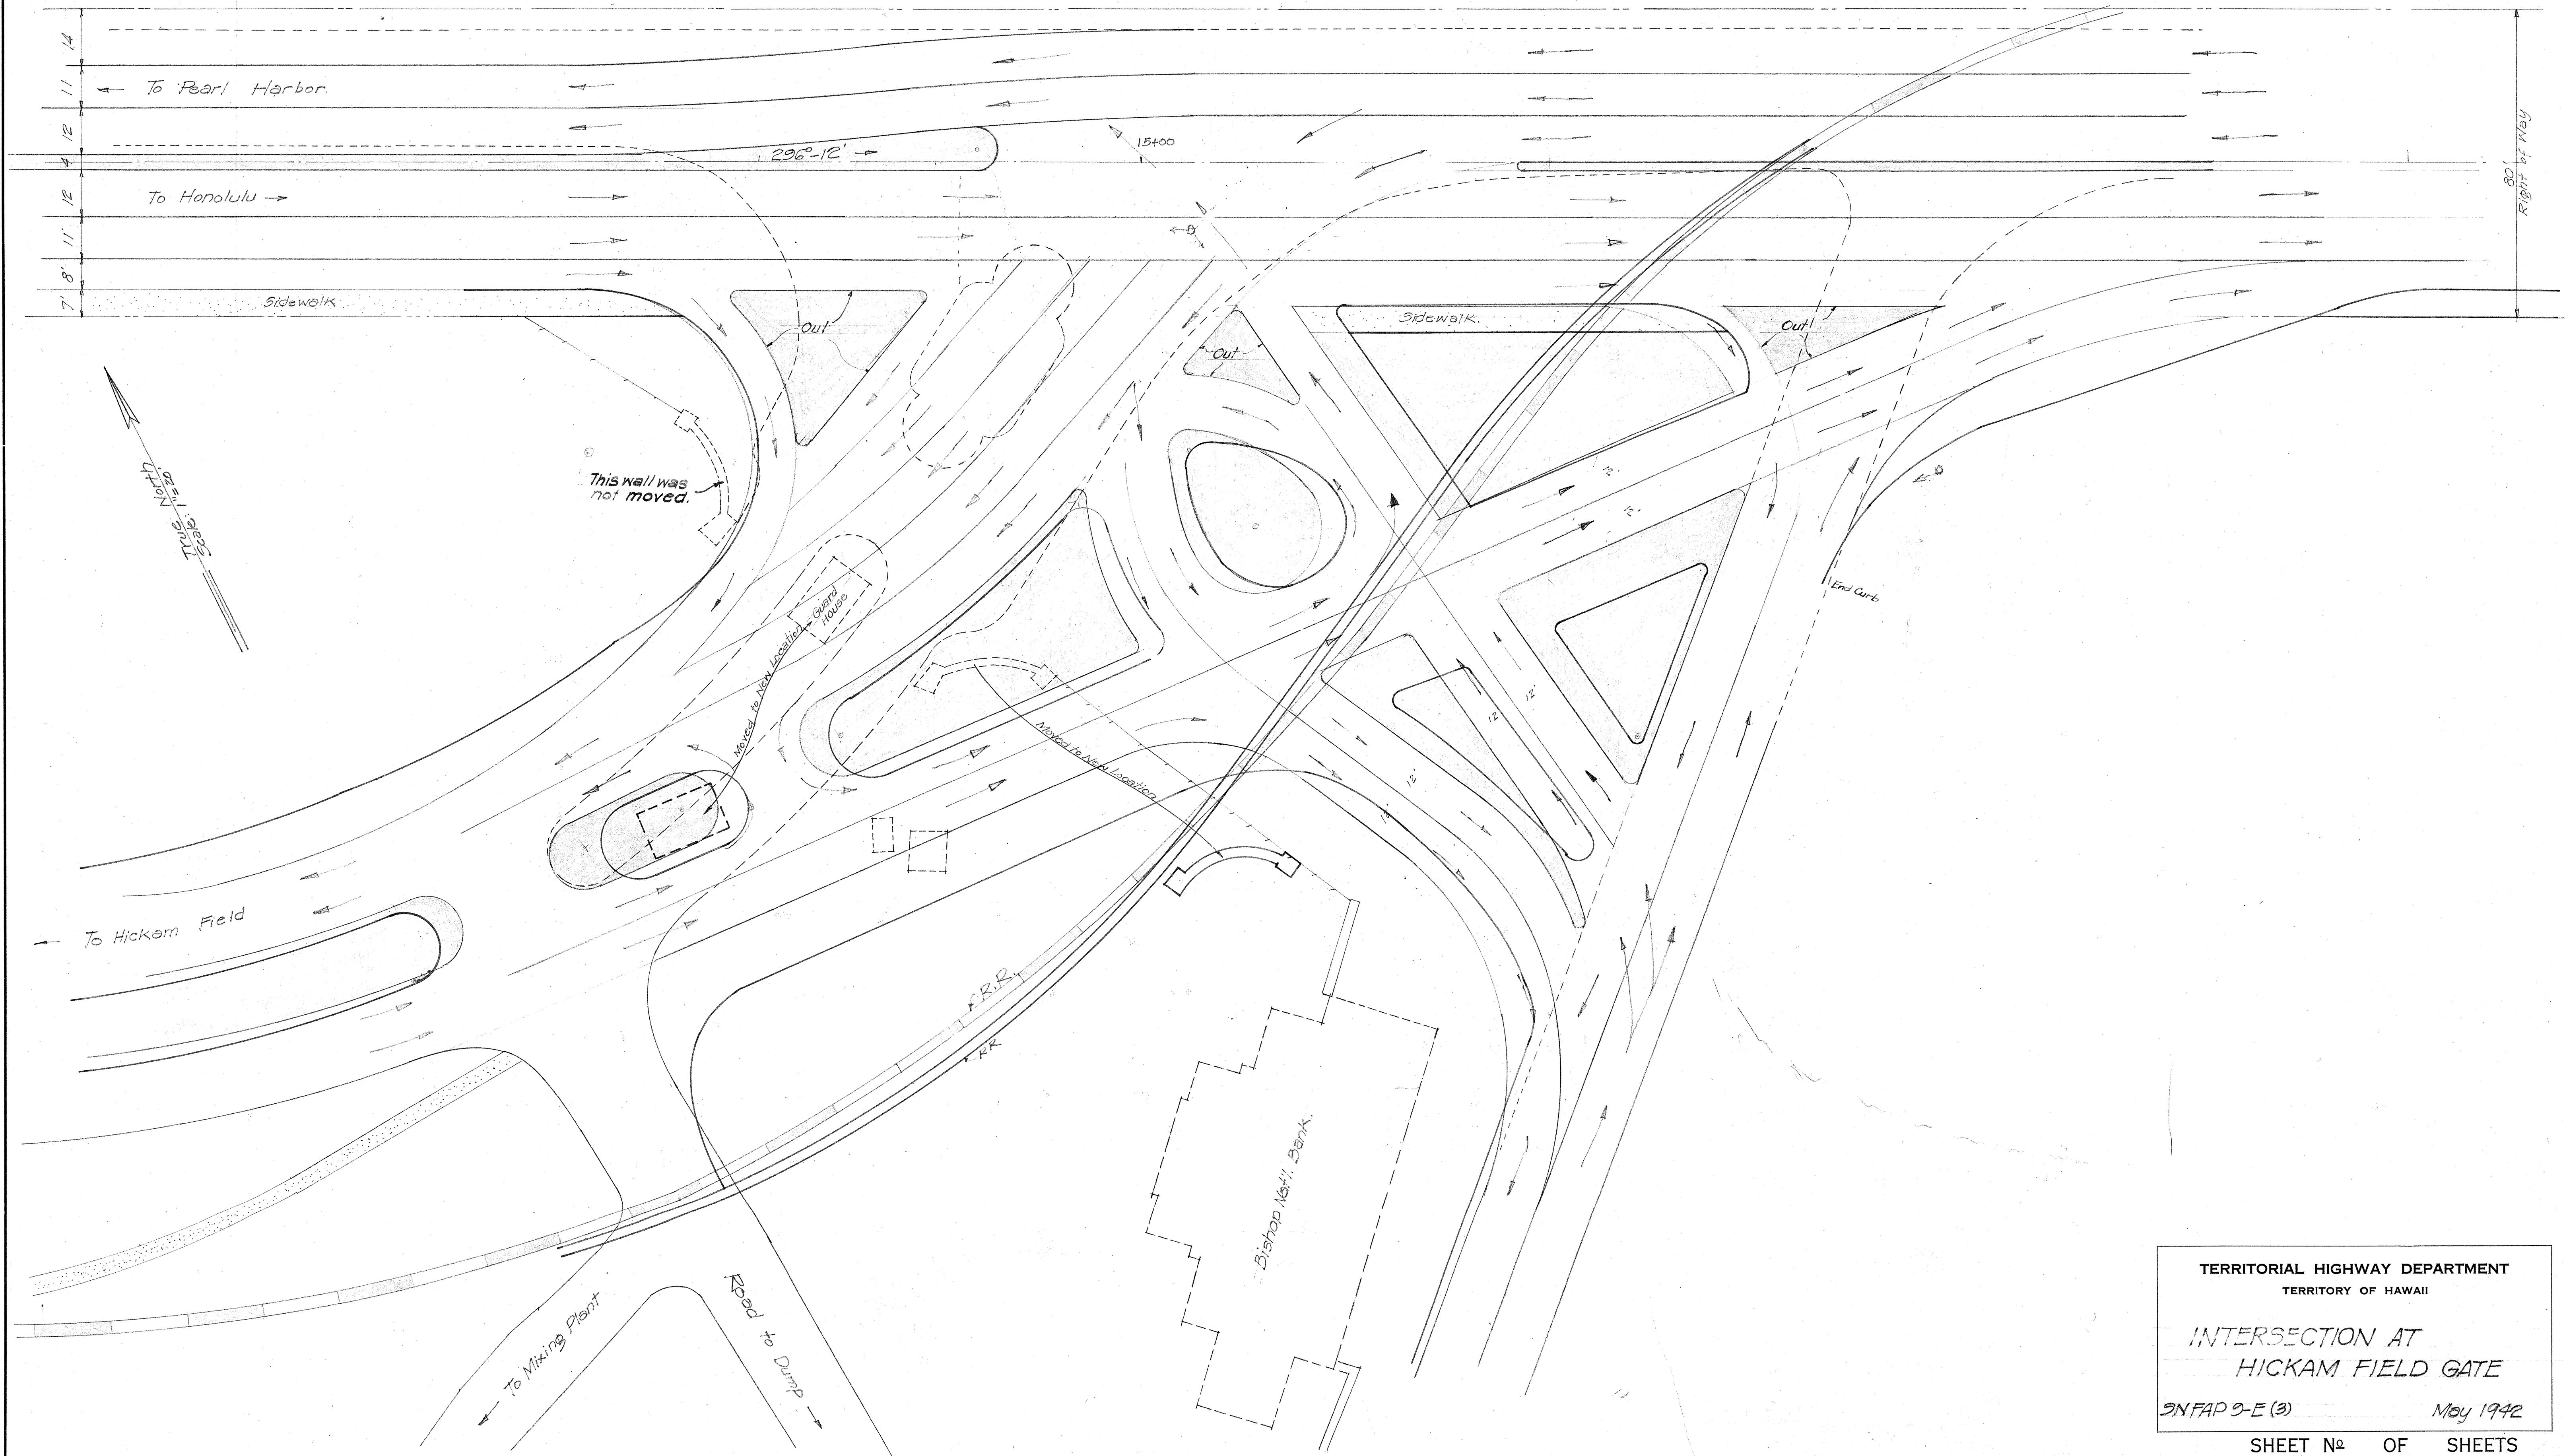

Corrections Made: 10-1-45
This sheet made a part of this project 10-1-45

ORIGINAL PLAN	DATE
DESIGNED BY	
DRAWN BY	
TRACED BY	
QUANTITIES BY	
CHECKED BY	
No.	

TERRITORIAL HIGHWAY DEPARTMENT
TERRITORY OF HAWAII

INTERSECTION AT
HICKAM FIELD GATE

SNFAP 9-E (3) May 1942

SHEET No OF SHEETS